

PUB. RD. DIV. NO.	STATE	FED. AID PROJ. NO.	FISCAL YEAR	SHEET NO.	TOTAL SHEETS
1	MASS	I-91(64)9	1967	77	353

**GENERAL NOTES:**

**DESIGN:**  
In accordance with the current specifications of the American Association of Highway Officials (1961 Edition) H20-44 Loading.

**DATE AND SEAL:**

To be placed on the inside face of the Northeast and Southwest End Posts. A sheet showing the size and character of the numerals will be furnished. The seal will be furnished by the State and shall be set by the Contractor.

**FOUNDATIONS:**

May be altered, if necessary, to suit conditions encountered during construction.

**UNSUITABLE MATERIAL:**

Shall be removed within the limits of the foundations of the structure.

**BRIDGE RAILINGS:**

See Department Standard Metal Railing Plans, dated Oct. 1966 for Details of Bridge Railings.

**REINFORCEMENT:**

All bars shall have deformations conforming to A.S.T.M. designation A-305. Unless otherwise noted on the Plans, Reinforcing Bars shall be lapped 20 diameters to make a splice except that Main Reinforcing Bars near the top of the slabs and beams having more than 12 inches of concrete under the bars shall be lapped 35 diameters to make a splice.

**ANCHOR BOLTS:**

Shall be set by template and placed before concrete is poured, except at the Abutments where drilling and grouting may be used at the Contractor's option.

**SCALE:**

Scales noted on Plans are not applicable to reduced size Prints. Divide Scales by 2 for 1/4 size Prints.


**FIELD BOOK:**

**BENCH MARK:** MEAN SEA LEVEL DATUM OF 1929 (U.S.C. & G.S.), B.M.#7-NUT on side of High Tension Tower #51D4, N.E. Leg (Nut with Ground Wire) Brush Hill Ave. El. 195.49


**ESTIMATED QUANTITIES**  
(Not Guaranteed)

Class B Rock Excavation	10 C.Y.
Bridge Excavation	1,900 C.Y.
Gravel Borrow	1,490 C.Y.
Crushed Stone for Bridge Foundation	475 C.Y.
Class I Bituminous Concrete Pavement Type I-1	90 C.Y.
Class I Dense Protective Bottom Course for Bridges	74 Tons
Metal Bridge Railing (3-Rail) Option	531 L.F.
8 Inch Subdrain Option	125 L.F.
Bridge Structure (No. W-21-36)	1 L.S.
(Estimated Weight of Reinforcing Steel)	172,050 LBS.
(Estimated Weight of Structural Steel (A.S.T.M. A36))	362,000 LBS.


These quantities are part of Item 995.01 Bridge Structure (Bridge No. W-21-36) and are not guaranteed.

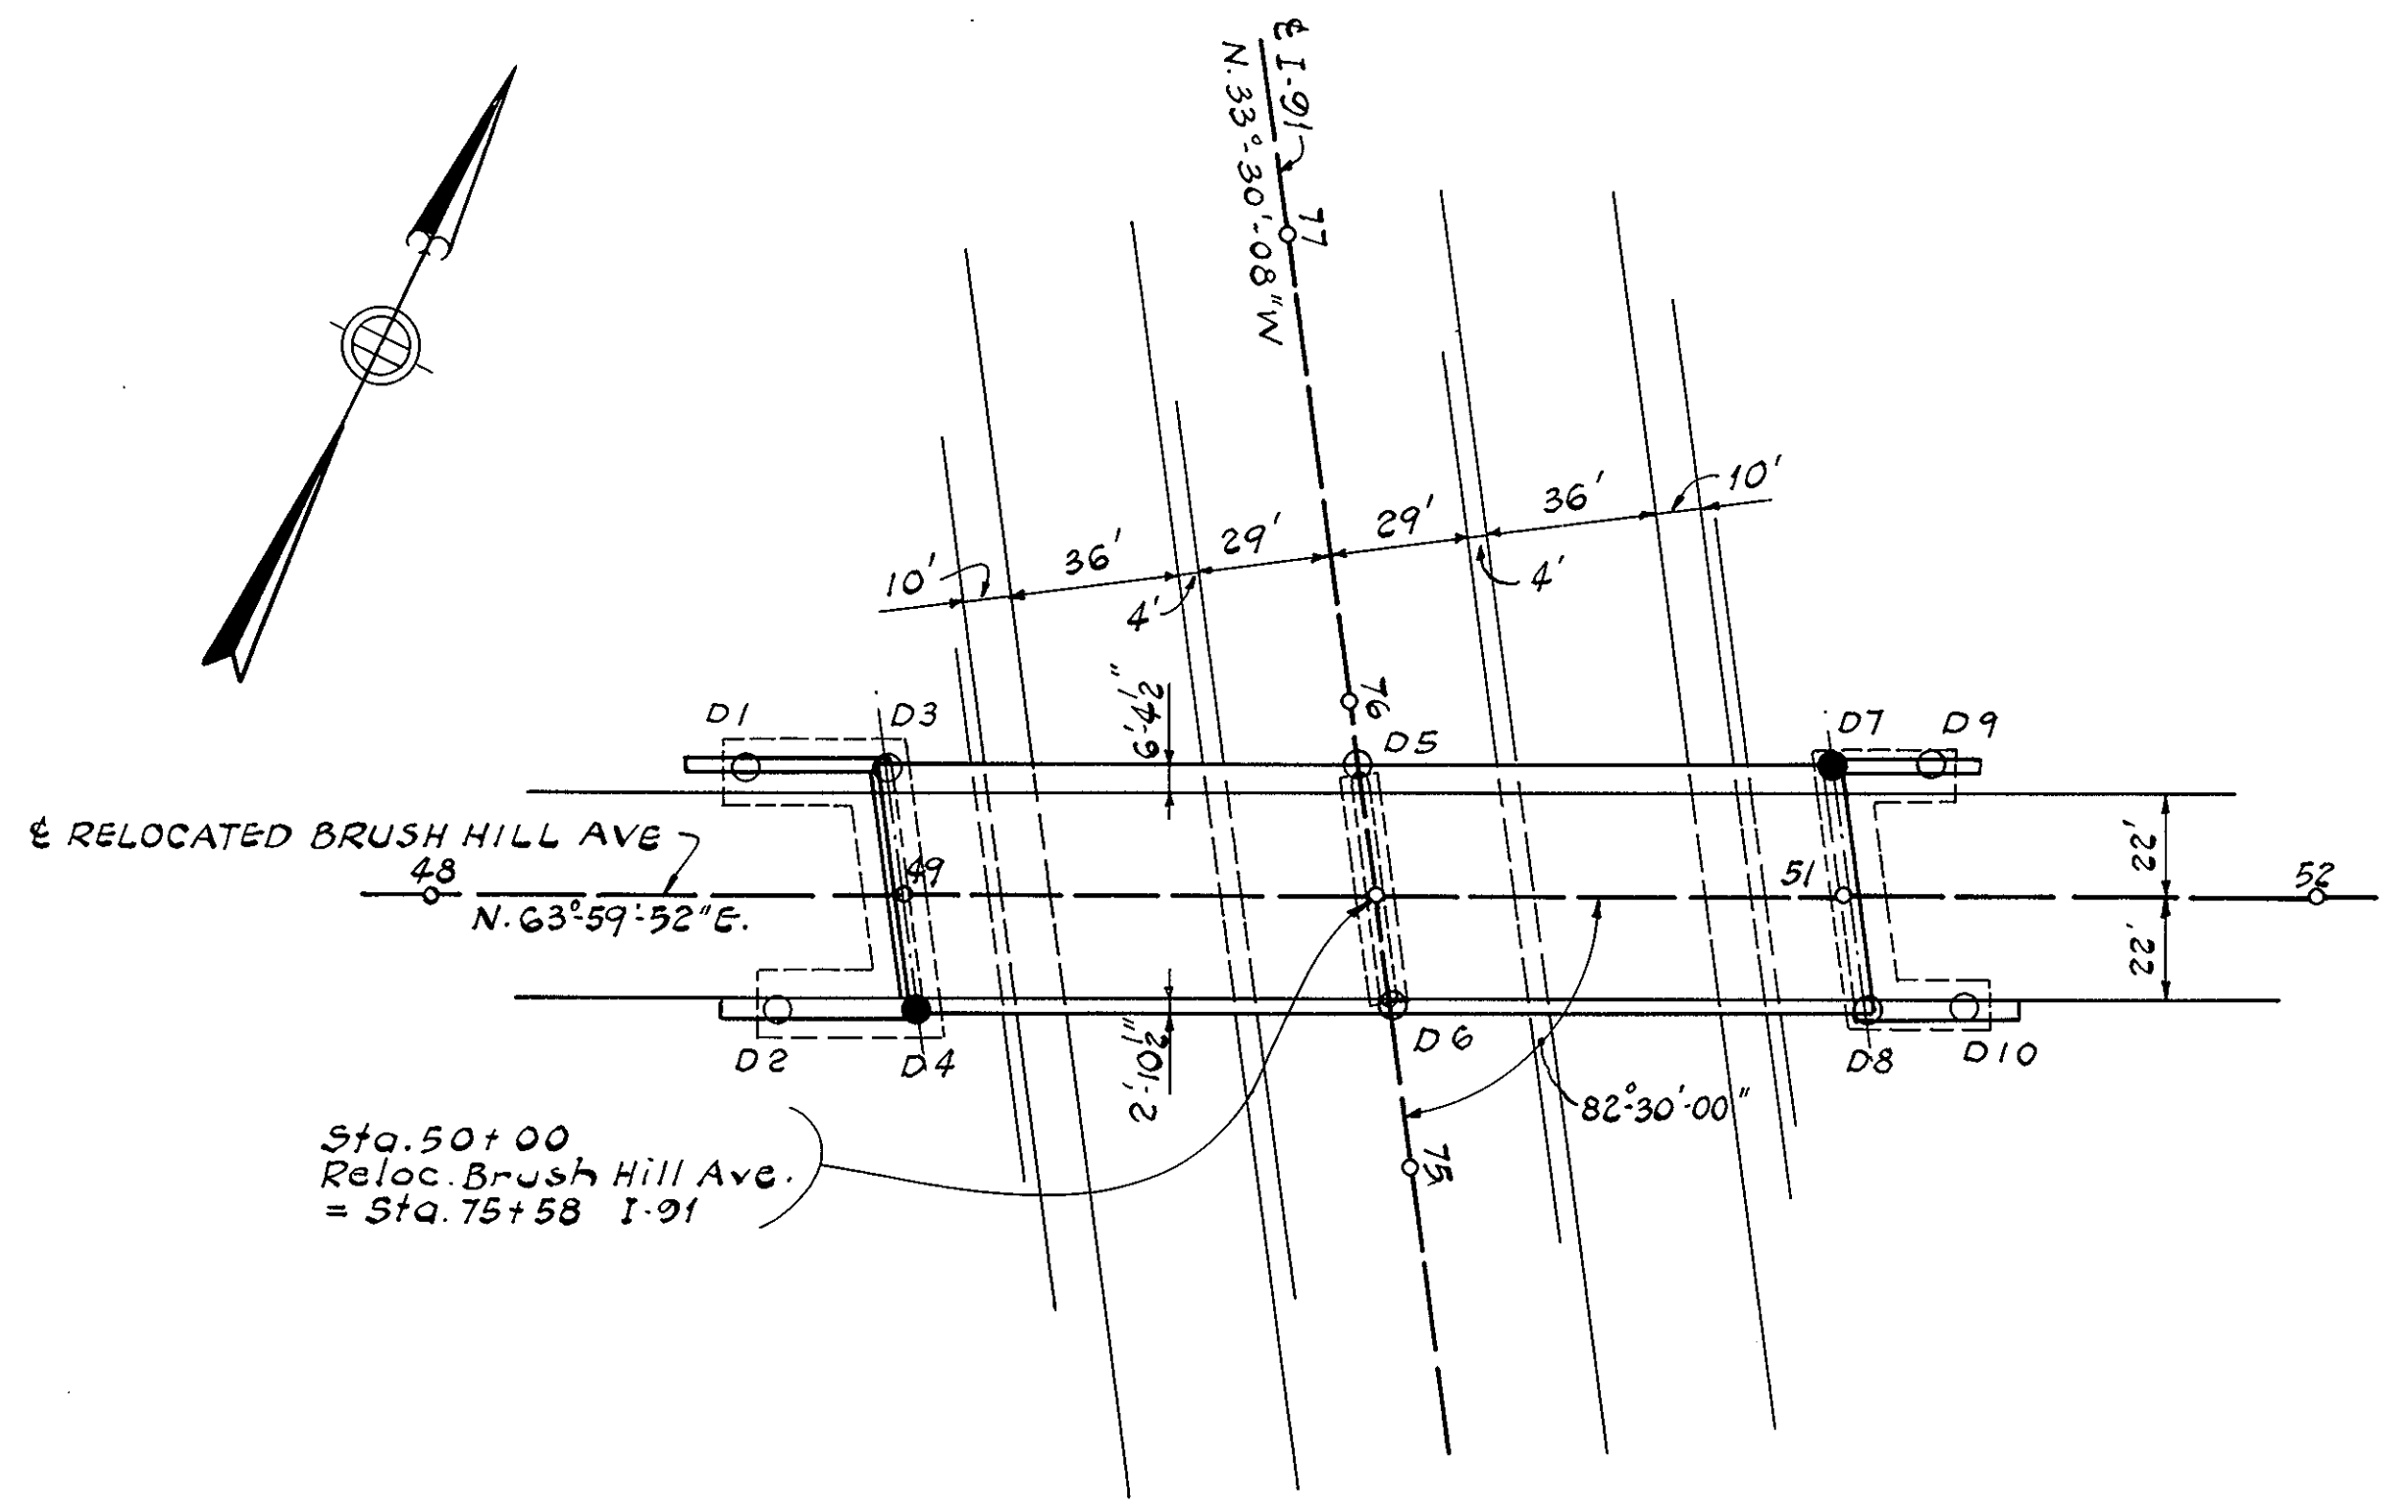


**KEY PLAN**  
Scale: 1" = 40'

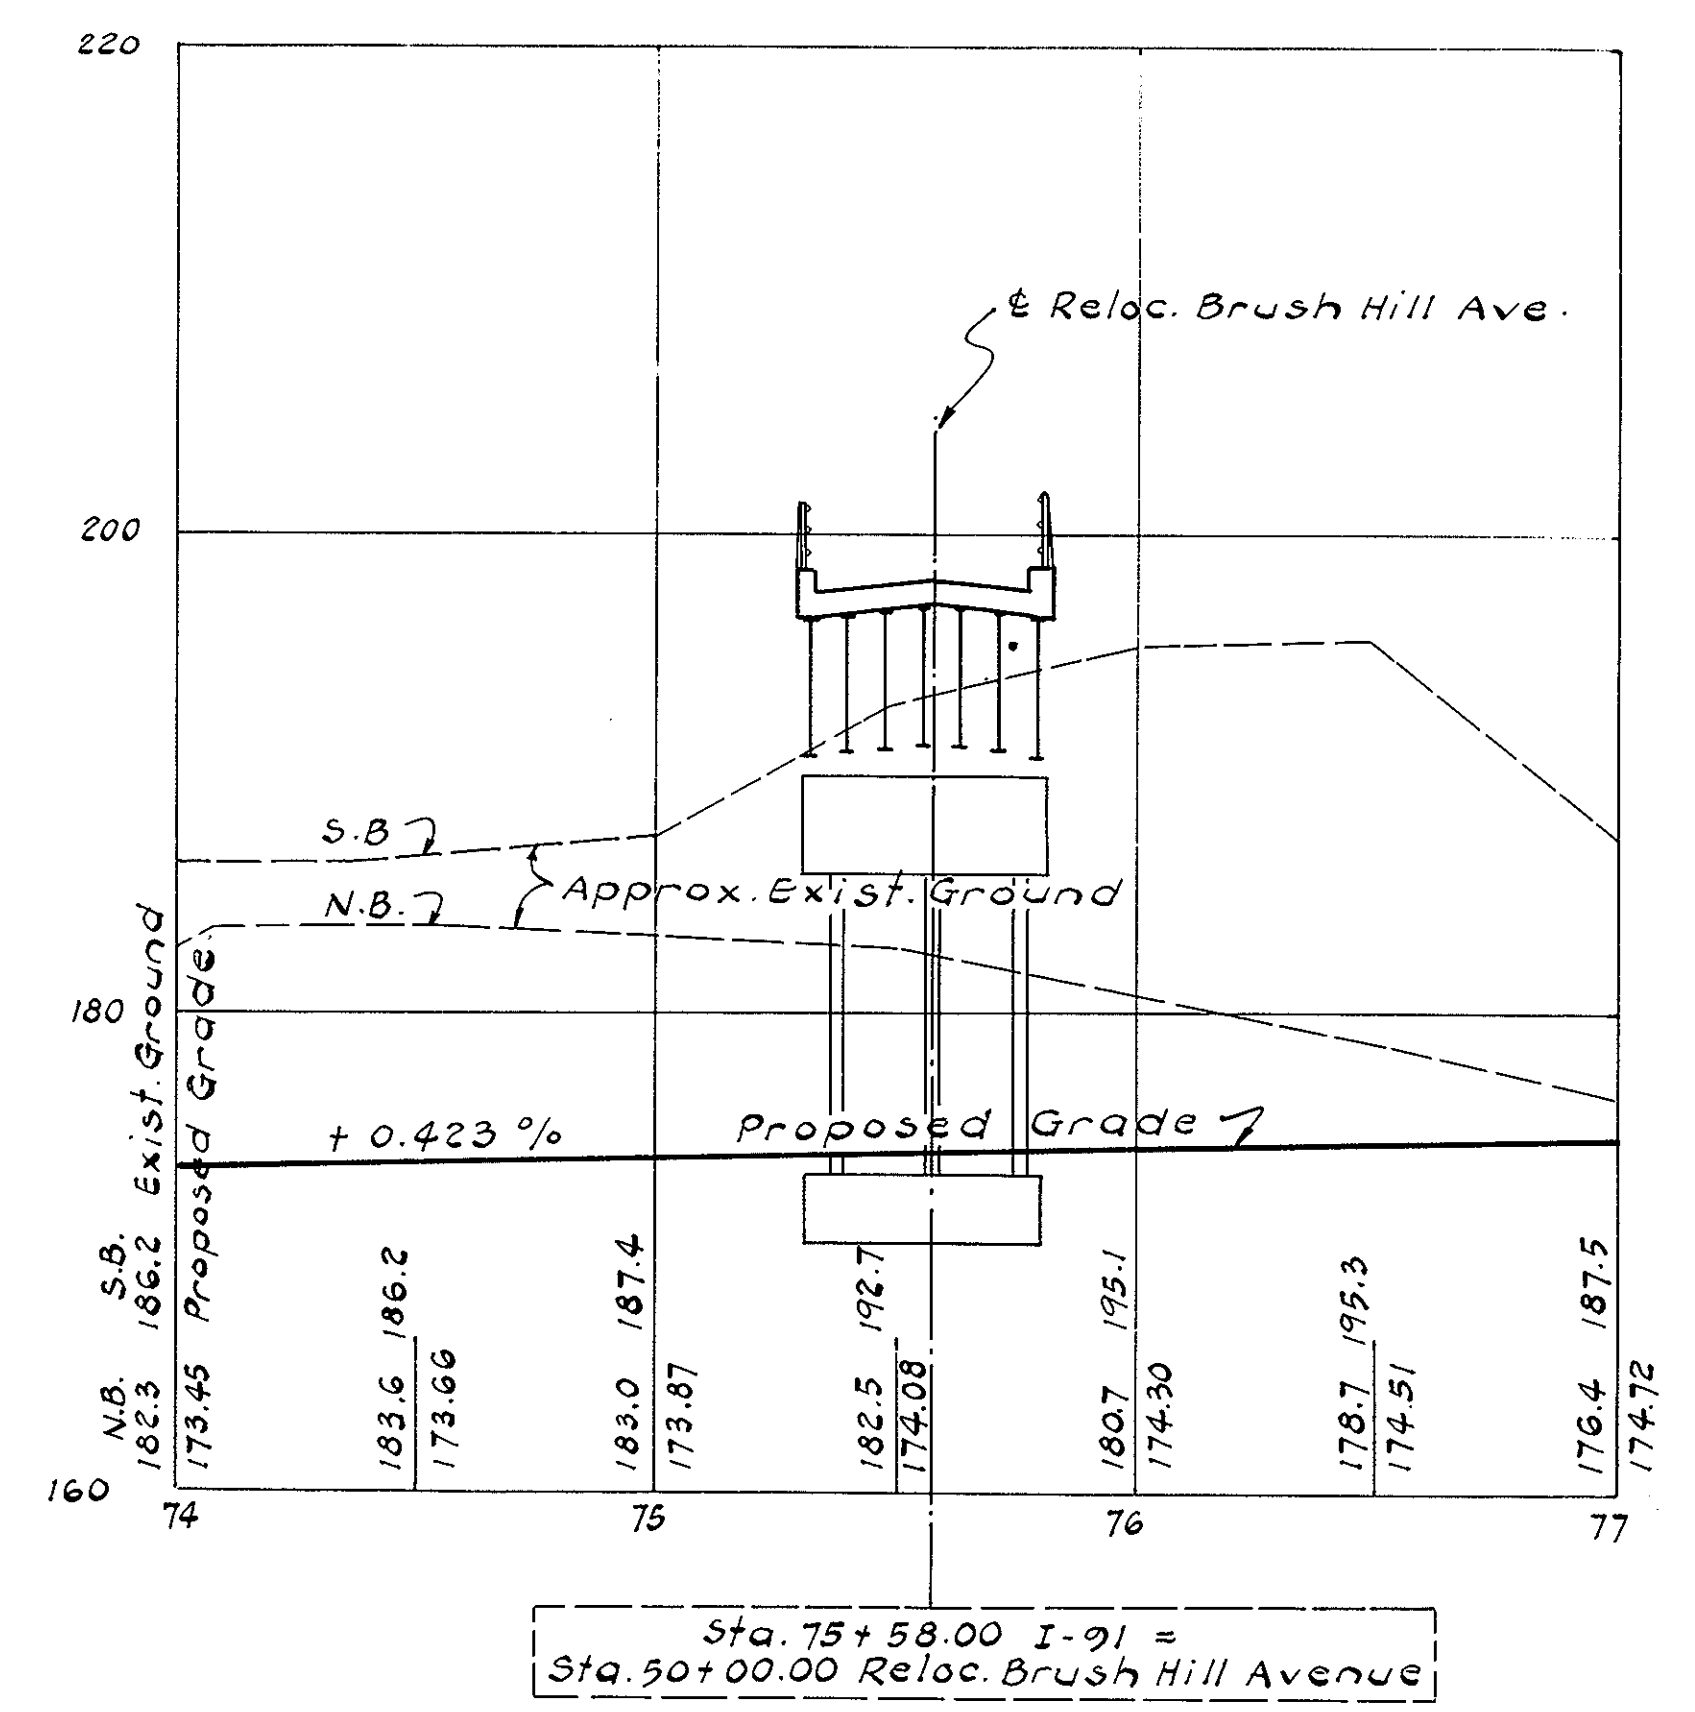

**PROFILE OF I-91**  
Scales: 1" = 8' Vert.; 1" = 40' Horiz.

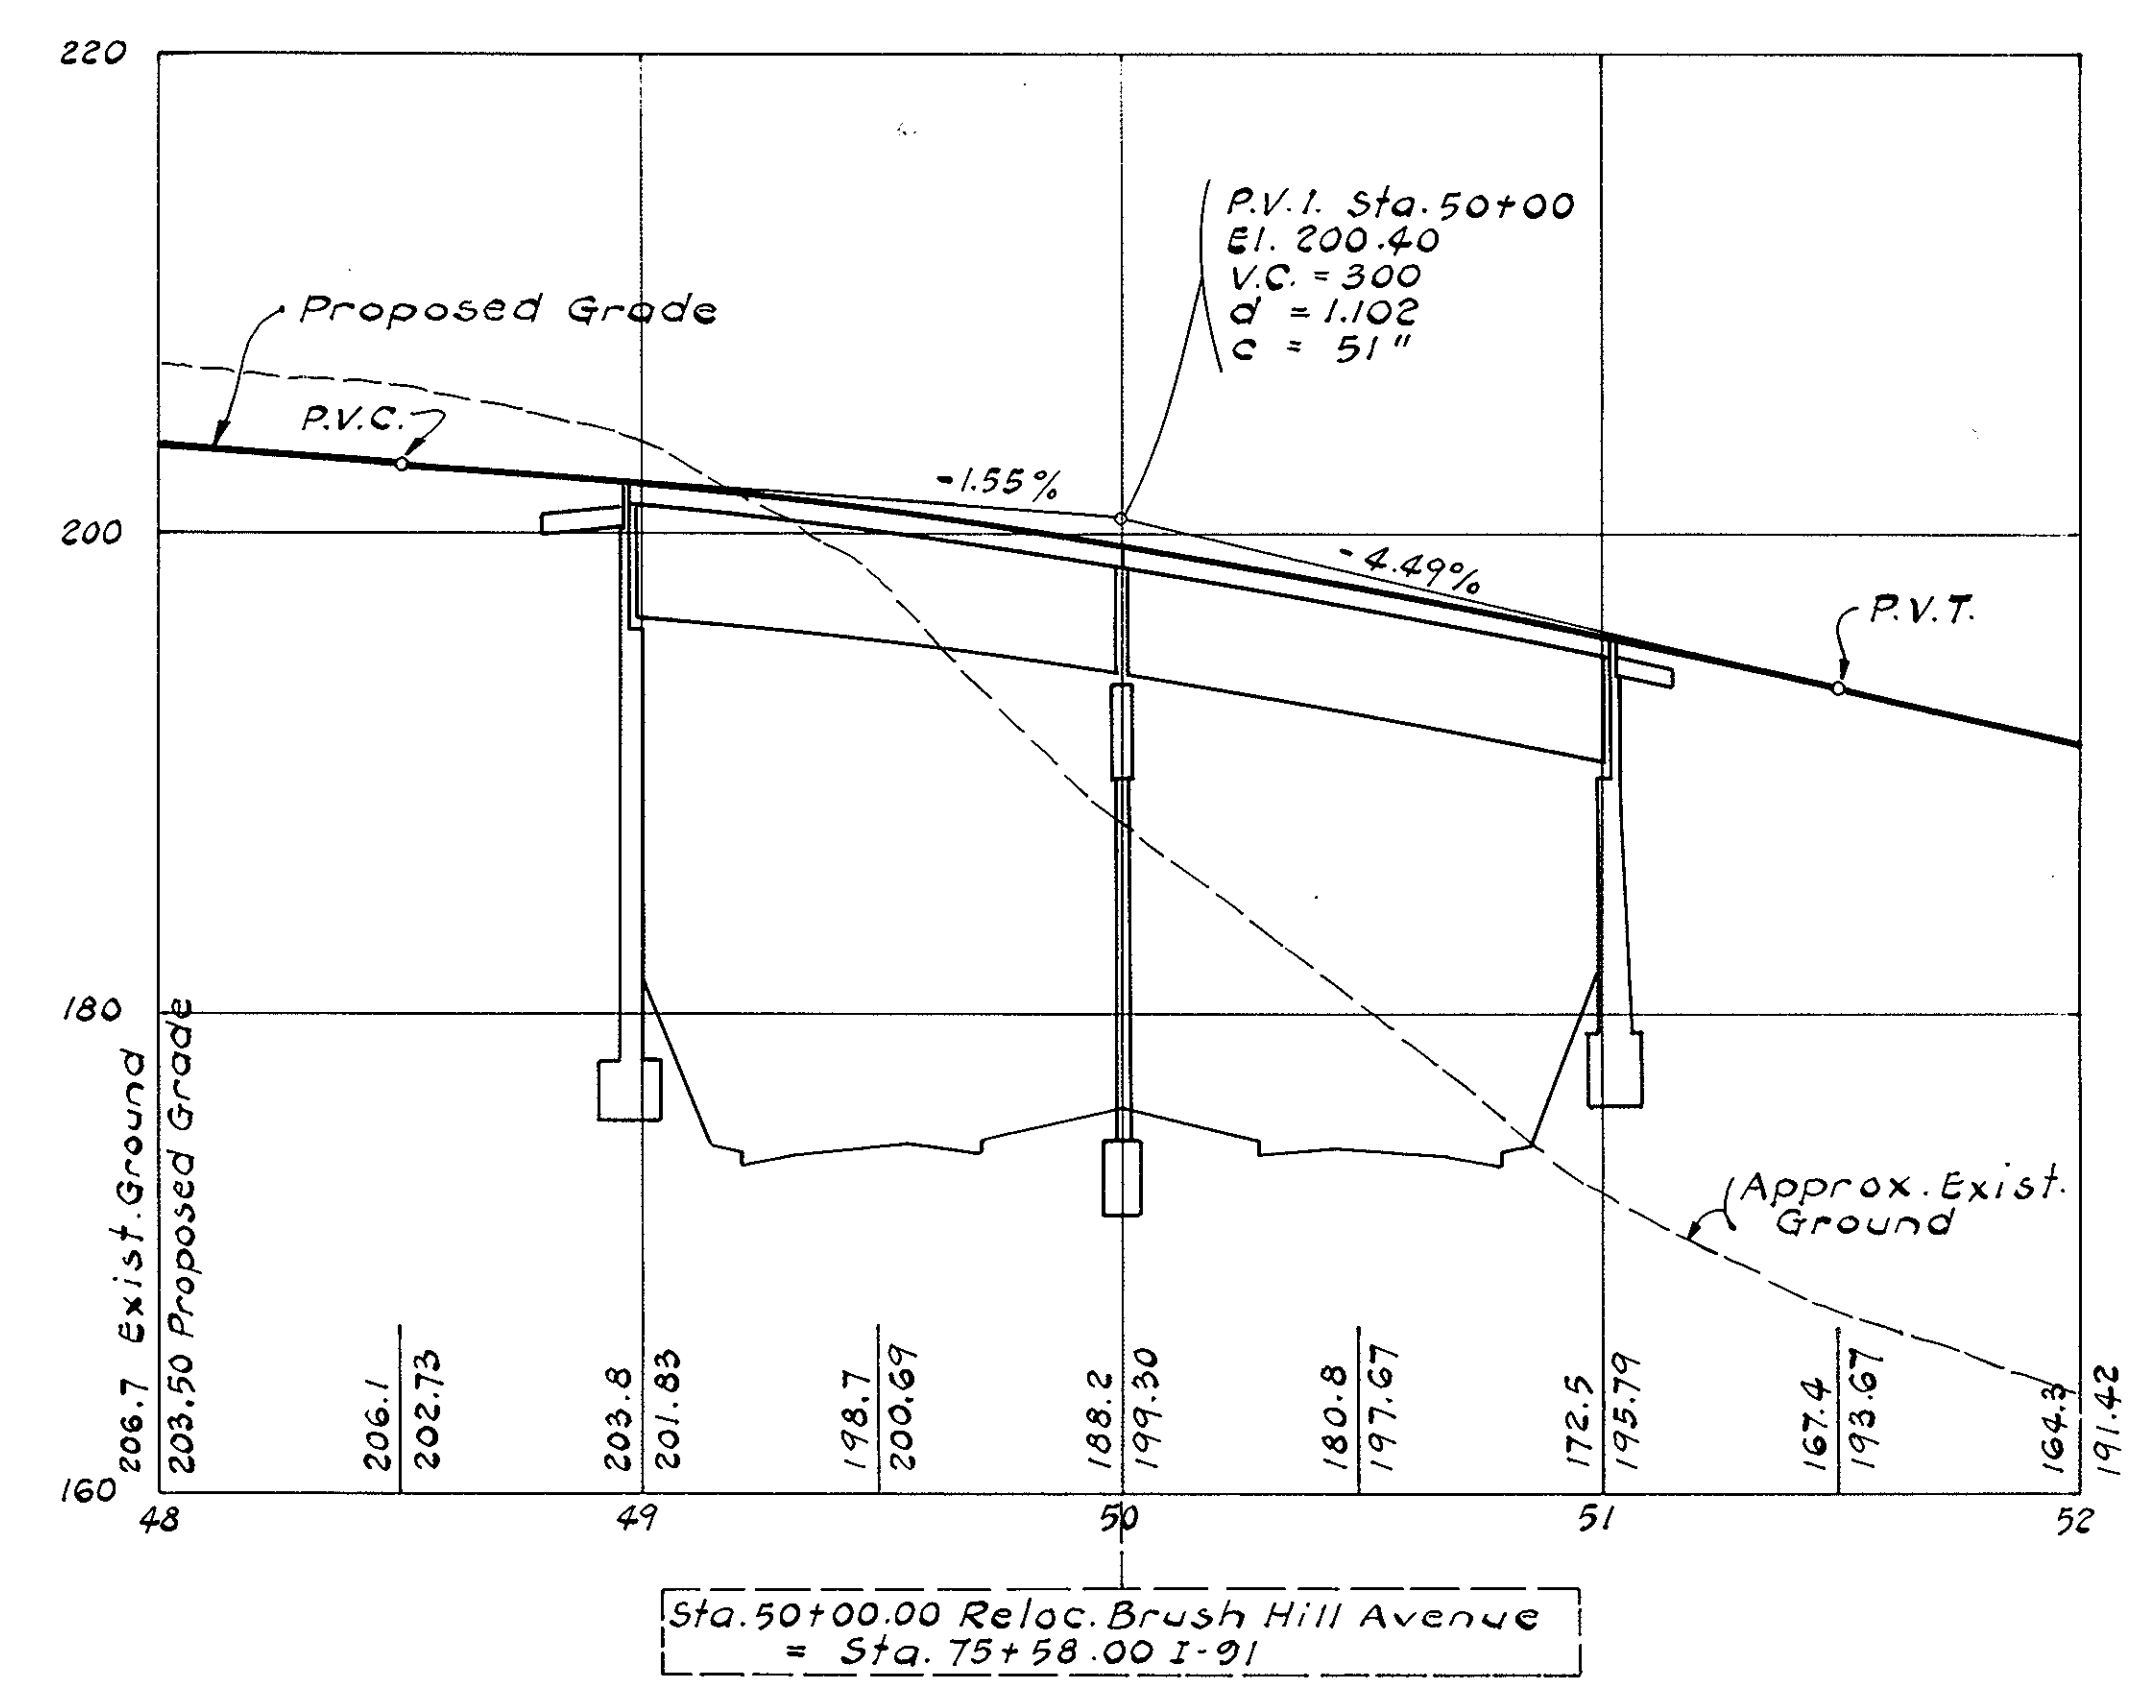

**PROFILE OF RELOCATED BRUSH HILL AVE.**  
Scales: 1" = 8' Vert.; 1" = 40' Horiz.

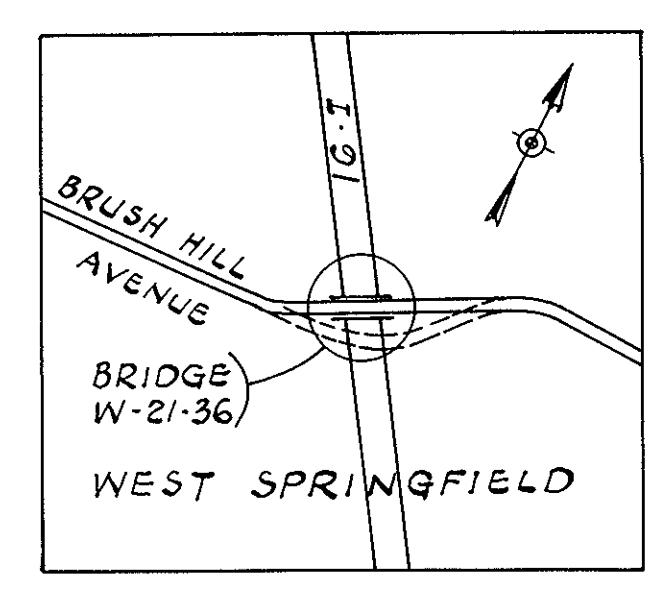


**LOCUS**  
Scale: 1" = 800'


BARSTOW & MULLIGAN  
CONSULTING ENGINEERS  
566 ATLANTIC AVE.  
BOSTON, MASS.

DESIGNED BY	MARCH 25, 1967	ISSUED FOR CONSTRUCTION
DRAWN BY	THE COMMONWEALTH OF MASSACHUSETTS PROPOSED BRIDGE	
CHECKED BY	<b>WEST SPRINGFIELD</b>	
APPROVED FOR	BRUSH HILL AVENUE RELOCATED OVER INTERSTATE ROUTE 91	
DESIGN	SCALES AS NOTED OFFICE OF	
SPECS.	DEPARTMENT OF PUBLIC WORKS 100 NASHUA ST. BOSTON, MASS.	
	BRIDGE ENGINEER	CHIEF ENGINEER


PUB. RD. DIV. NO.	STATE	FED. AID PROJ. NO.	FISCAL YEAR	SHEET NO.	TOTAL SHEETS
1	MASS	I-91-I(64)9	1967	82	393

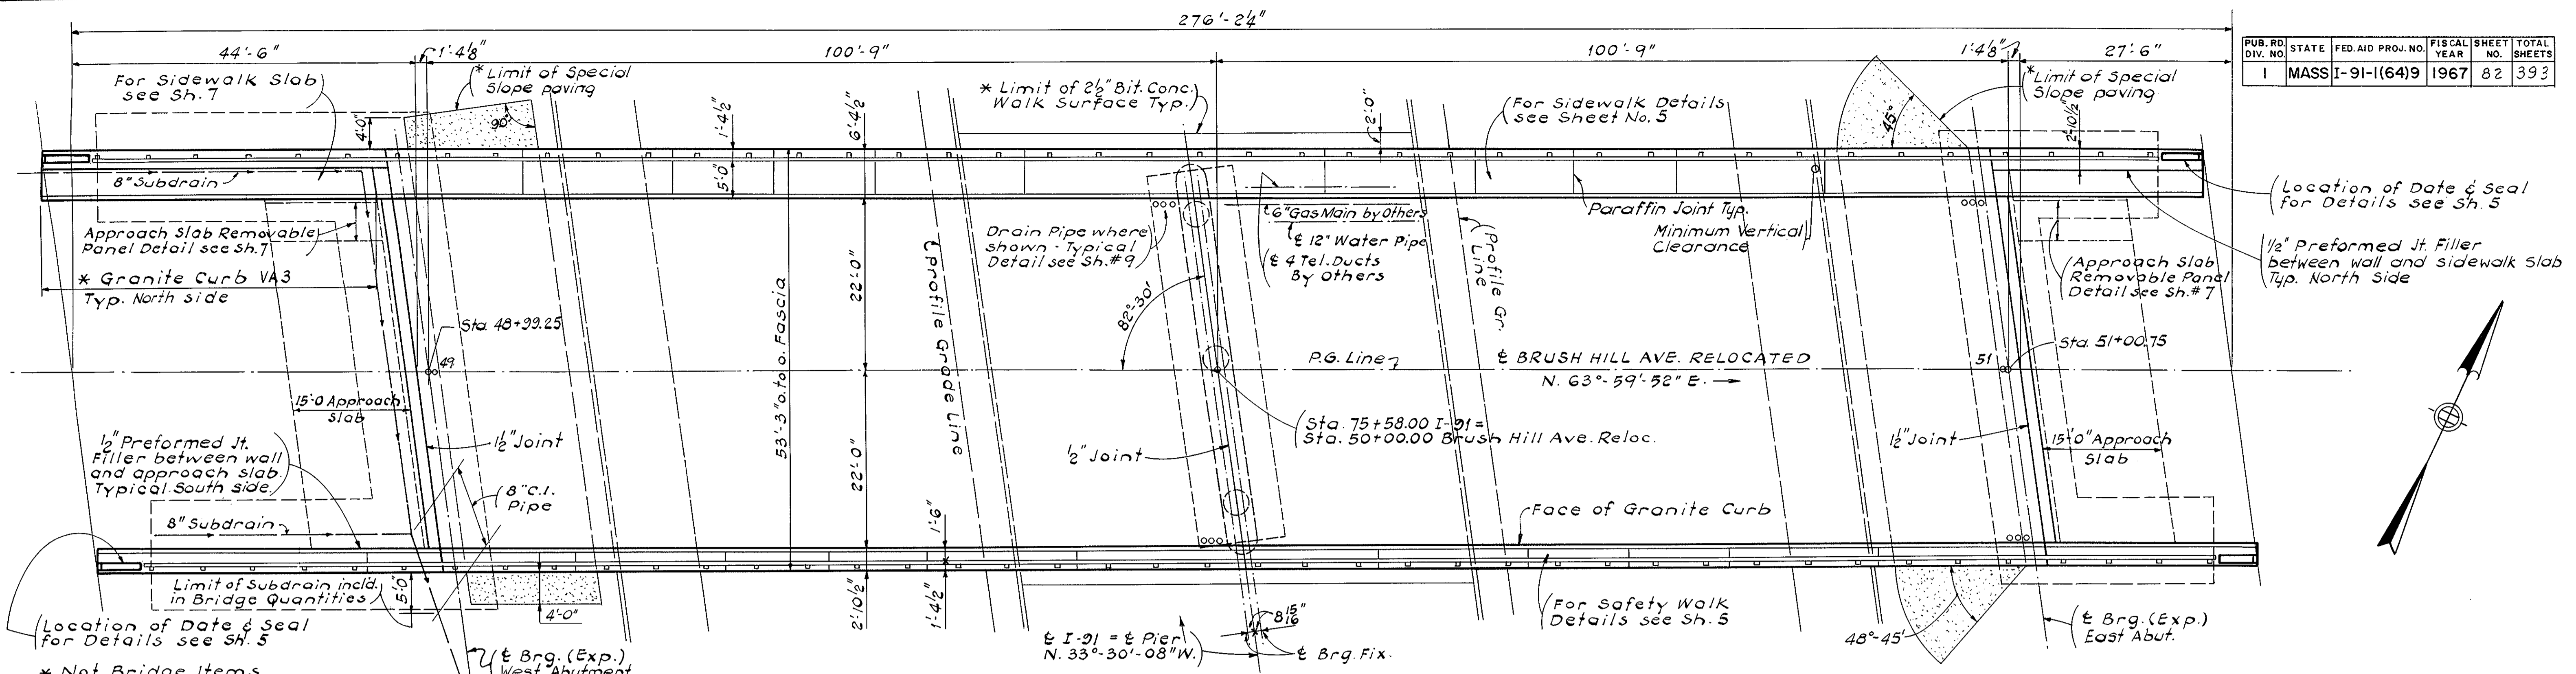


**PLAN**  
Scale: 1"=10'

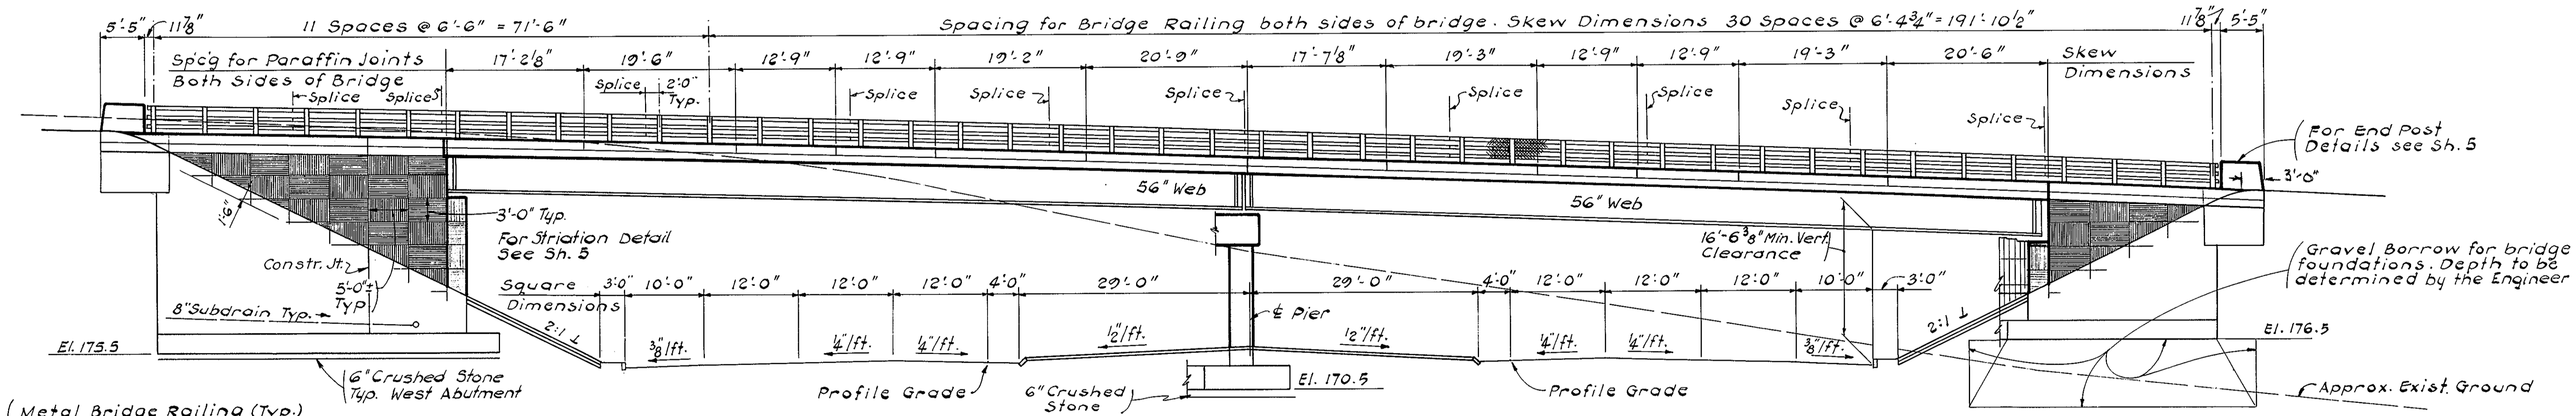


**ELEVATION**  
Scale: 1"=10'

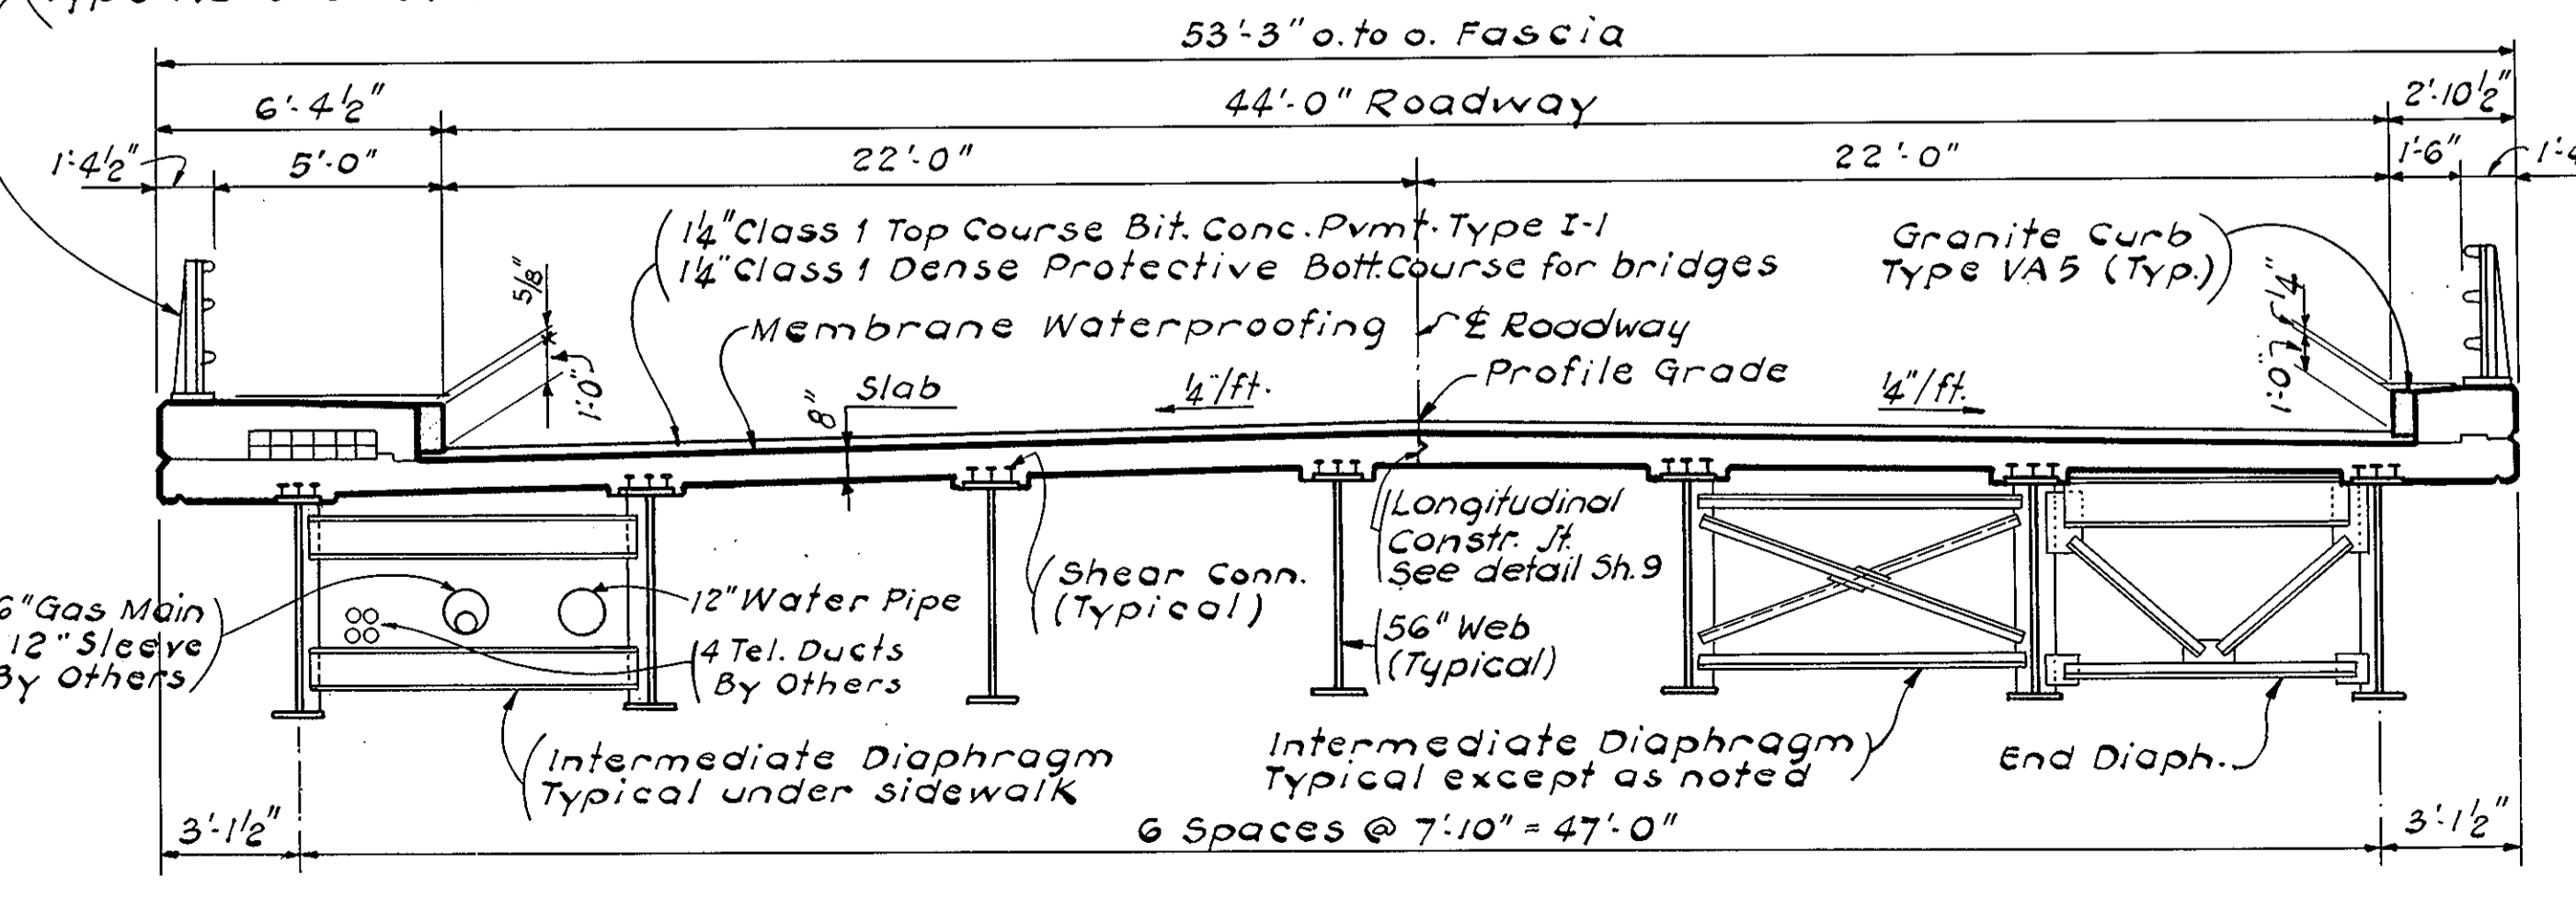

**TYPICAL CROSS SECTION**  
Scale: 1/4"=1'-0"

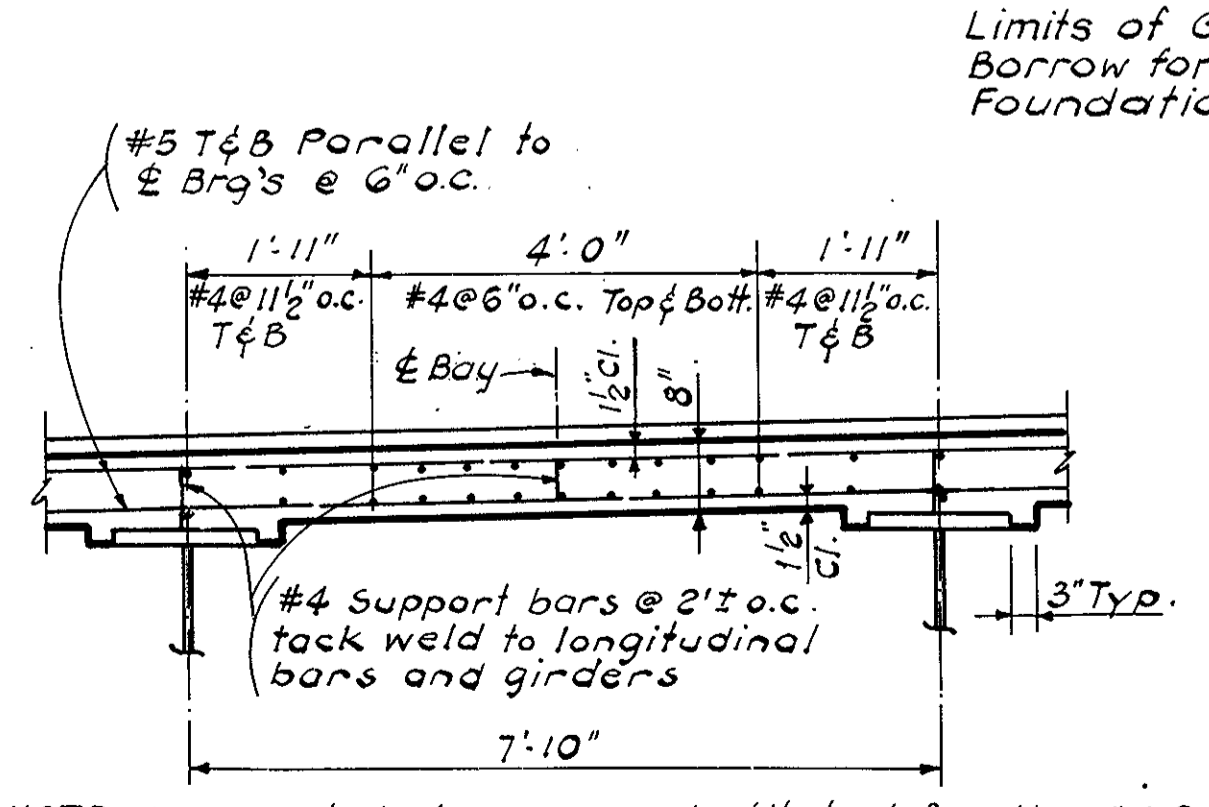

**TYPICAL SLAB REINFORCEMENT**  
Scale: 1/2"=1'-0"

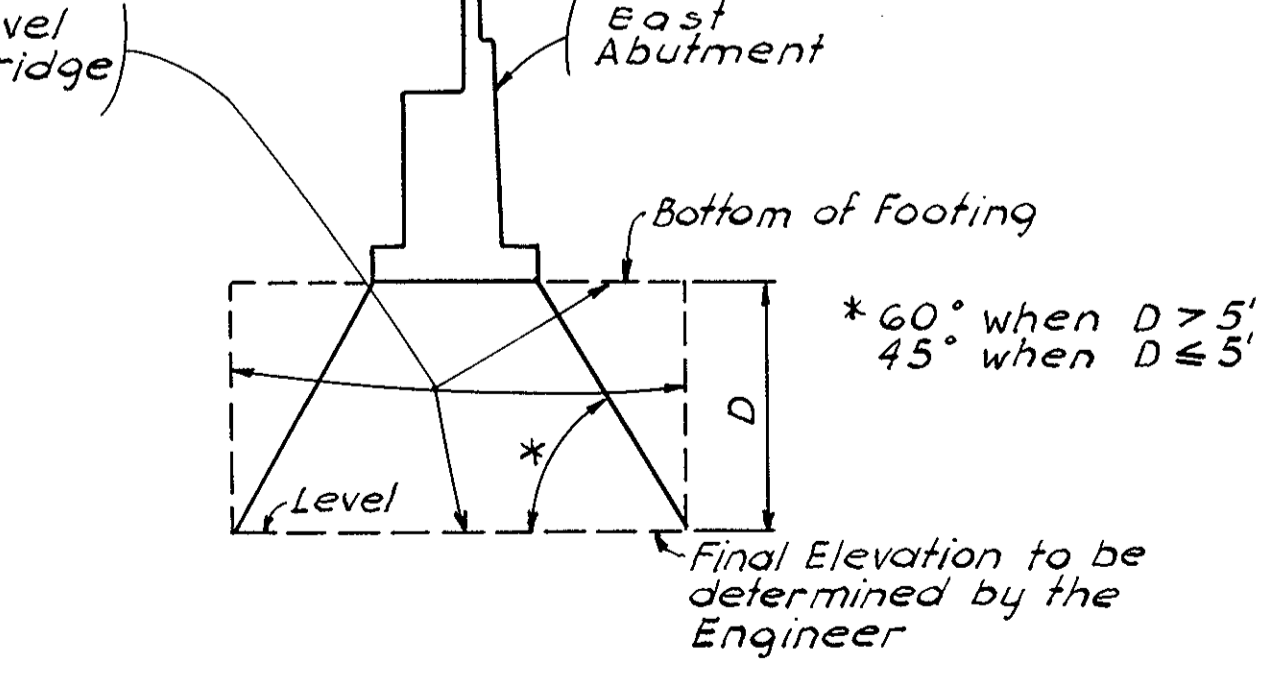

**GRAVEL BORROW FOR BRIDGE FOUNDATION**  
Not to Scale


NOTE: An equal device may be substituted for the #4 Bar upon written approval of the Engineer

NOTES: Some Treatment is to be used at Ends. Unsuitable Material to be removed before Gravel Borrow for Bridge Foundation is placed.


MARCH 25, 1967	ISSUED FOR CONSTRUCTION
DATE	DESCRIPTION
USE ONLY PRINTS OF LATEST DATE	

PUB. DIV. NO.	STATE	FED. AID PROJ. NO.	FISCAL YEAR	SHEET NO.	TOTAL SHEETS
1	MASS	I-91-(64)9	1967	83	393

NOTE: For missing details of Deck See "Typical Slab Reinforcement" Sh. 4.

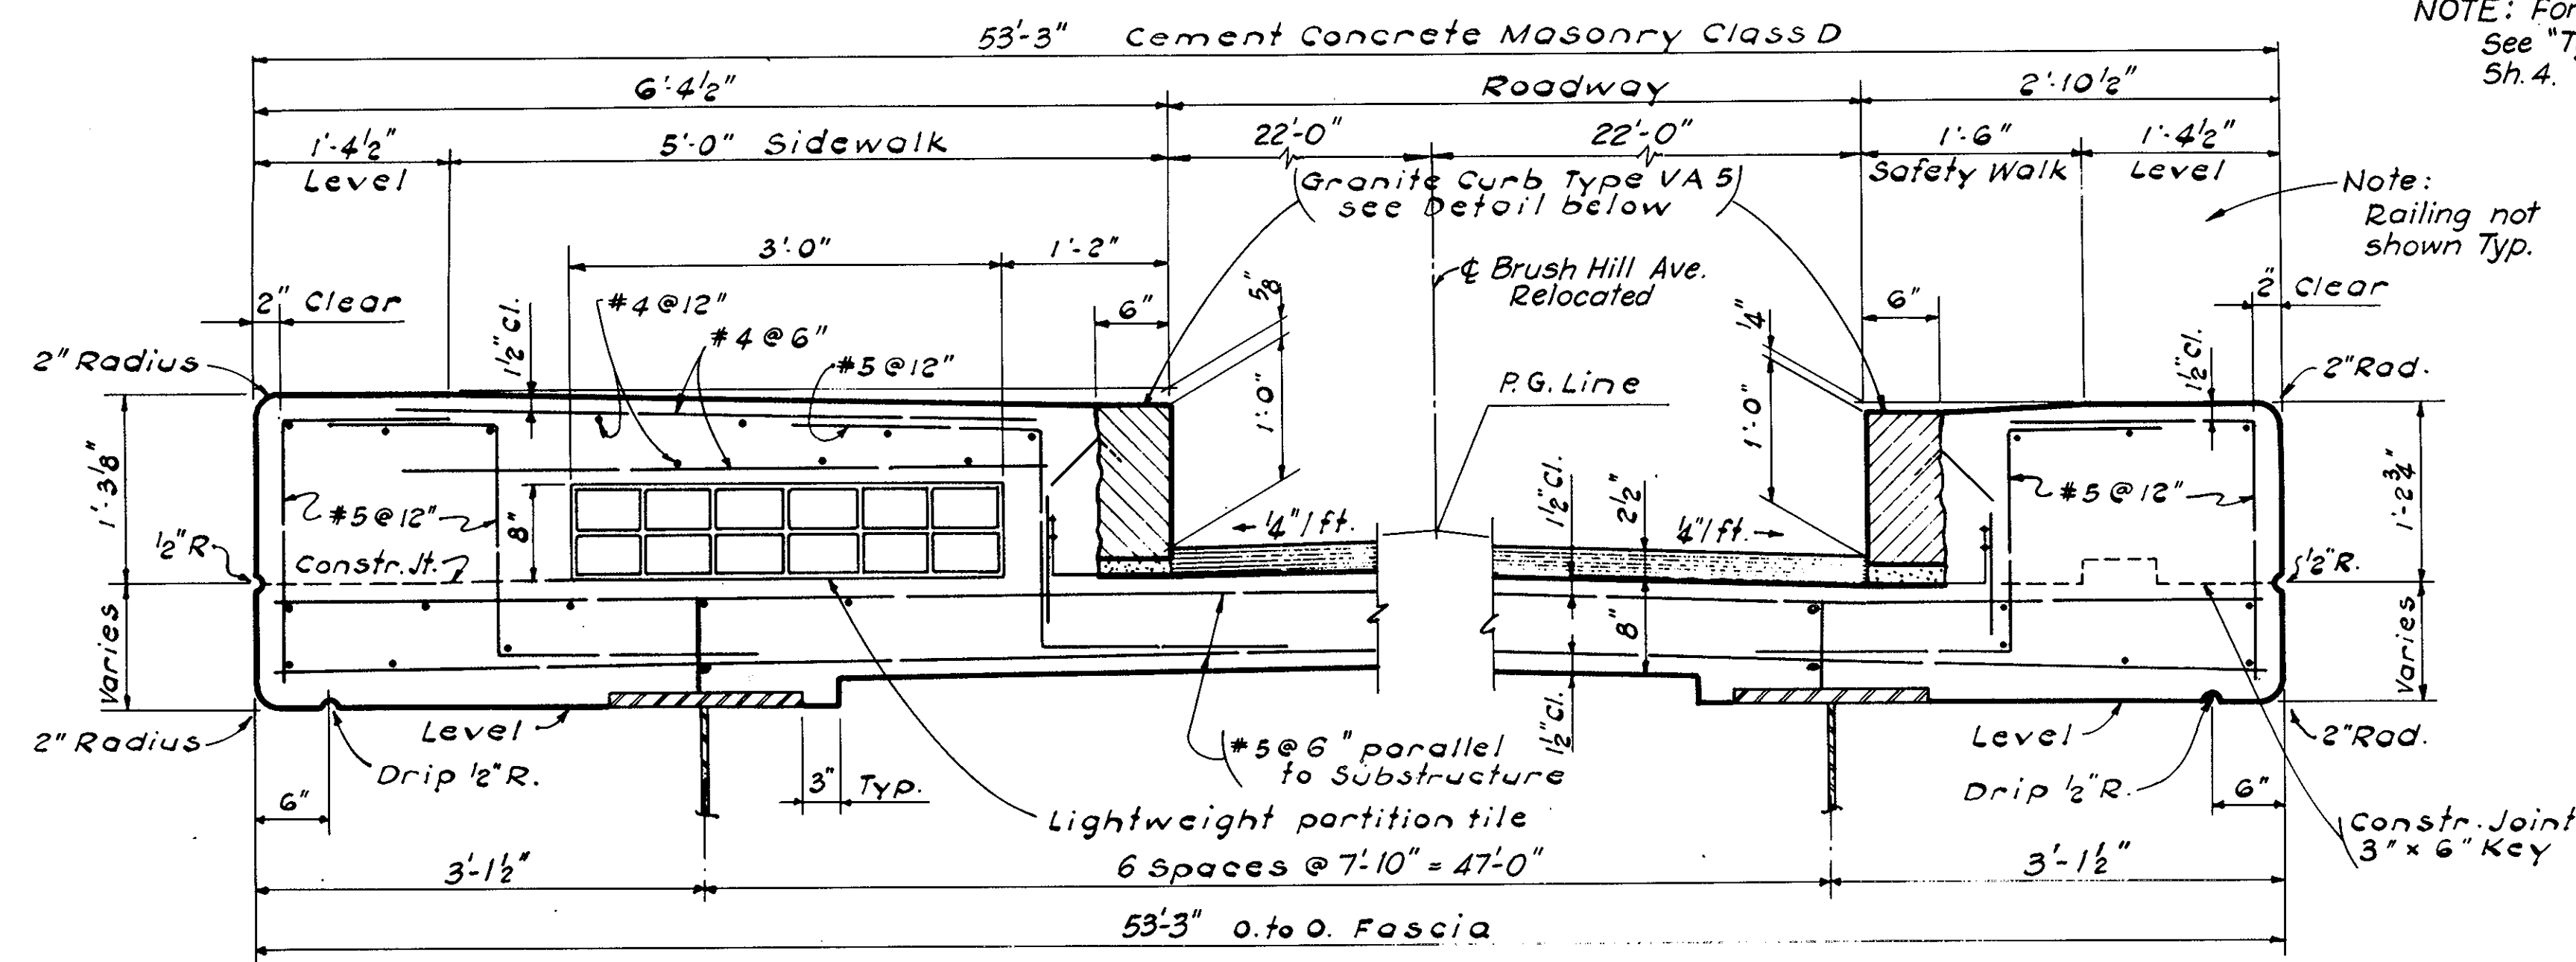


**TYPICAL DECK SECTION**  
Scale: 1" = 1'-0"

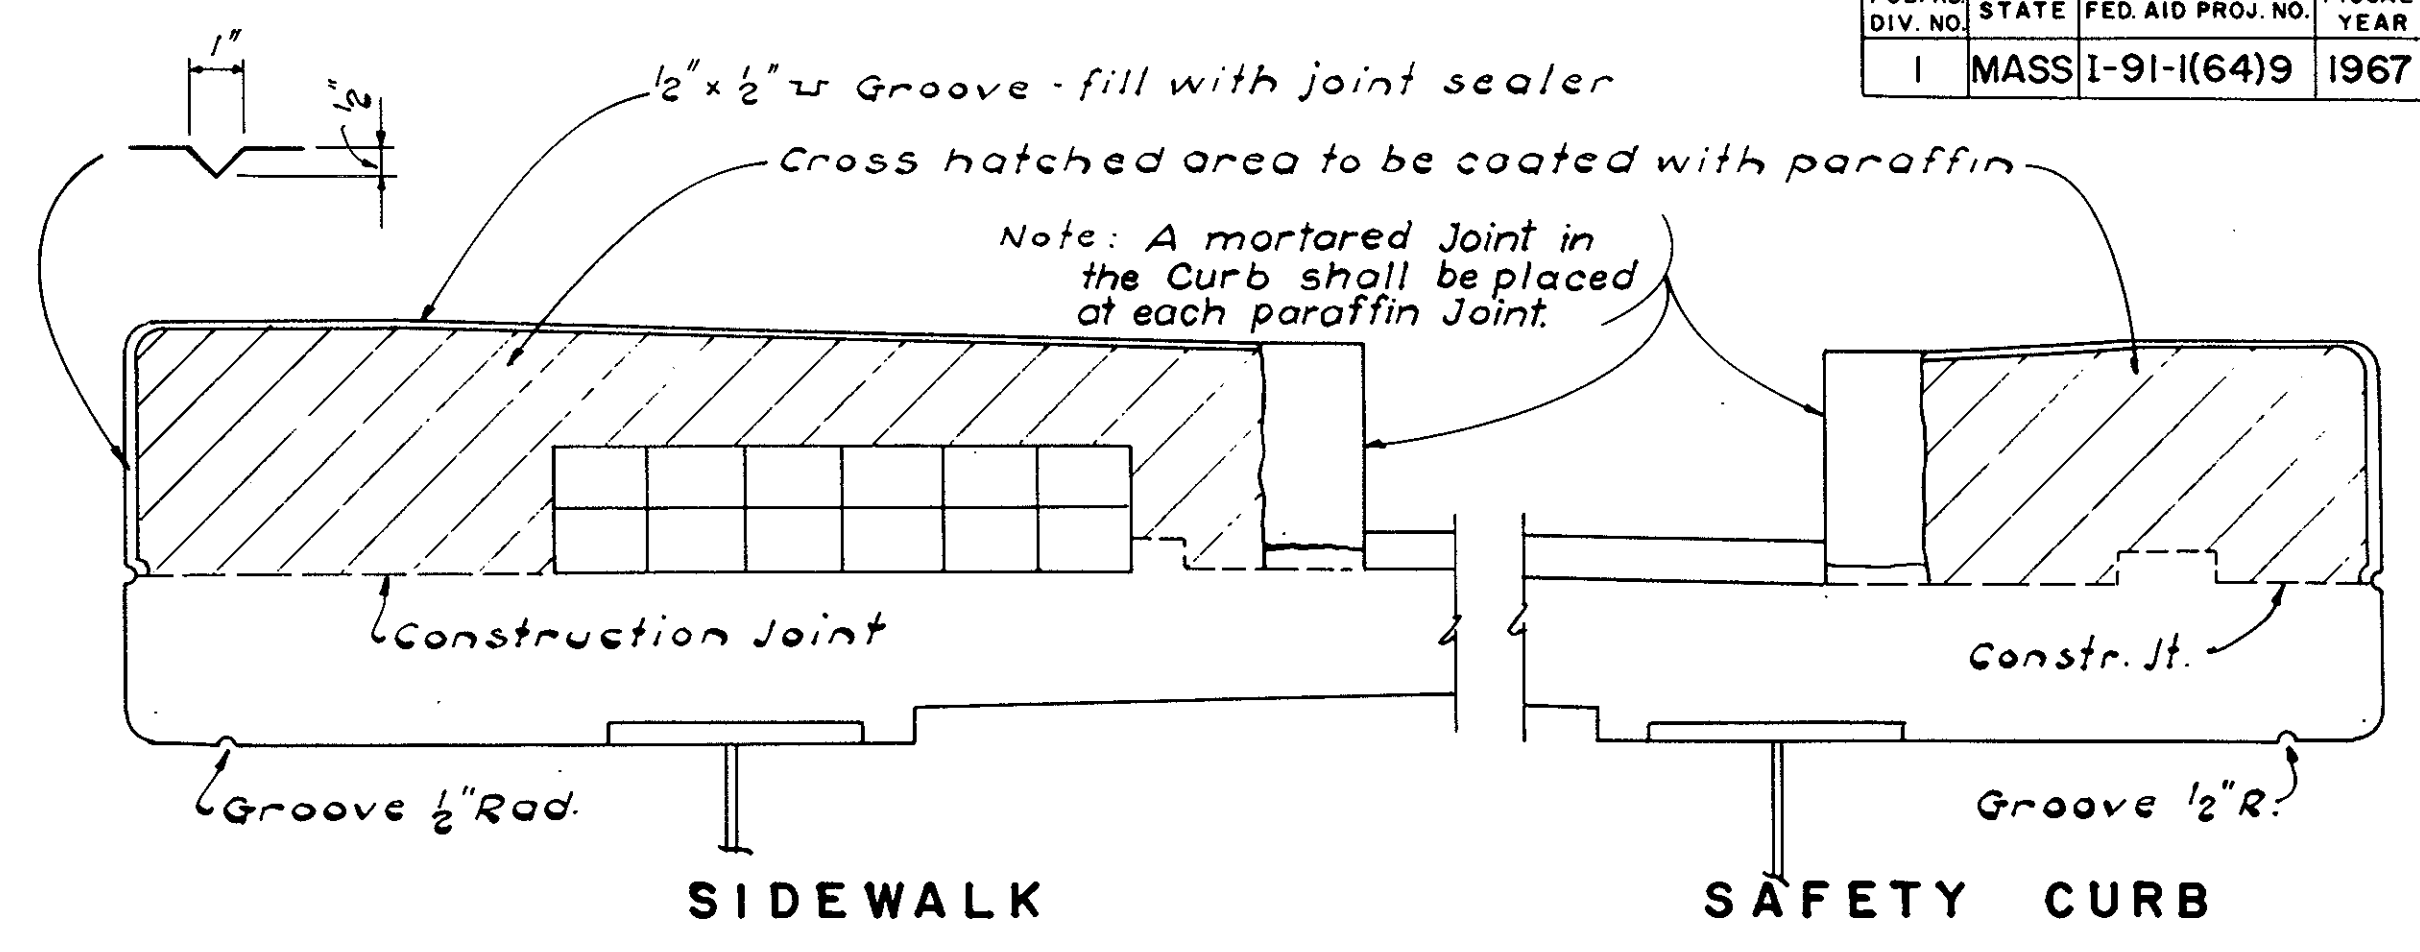


**PARAFFIN JOINT DETAIL**  
Scale: 1" = 1'-0"


**Notes**  
Sidewalk and Safety Curb shall be poured in alternate section and shall have a curing period of not less than 5 days between pours.  
For location of joints see Sheet 4.  
End of bars to be 2" clear of joint.  
Do not carry longitudinal bars in sidewalk and safety curb through joints.  
Joint sealer to be same color as concrete.  
Joints shall be square to face of curb.  
Joint in curb shall be mortared no sooner than 5 days after concrete in sidewalk has been poured.

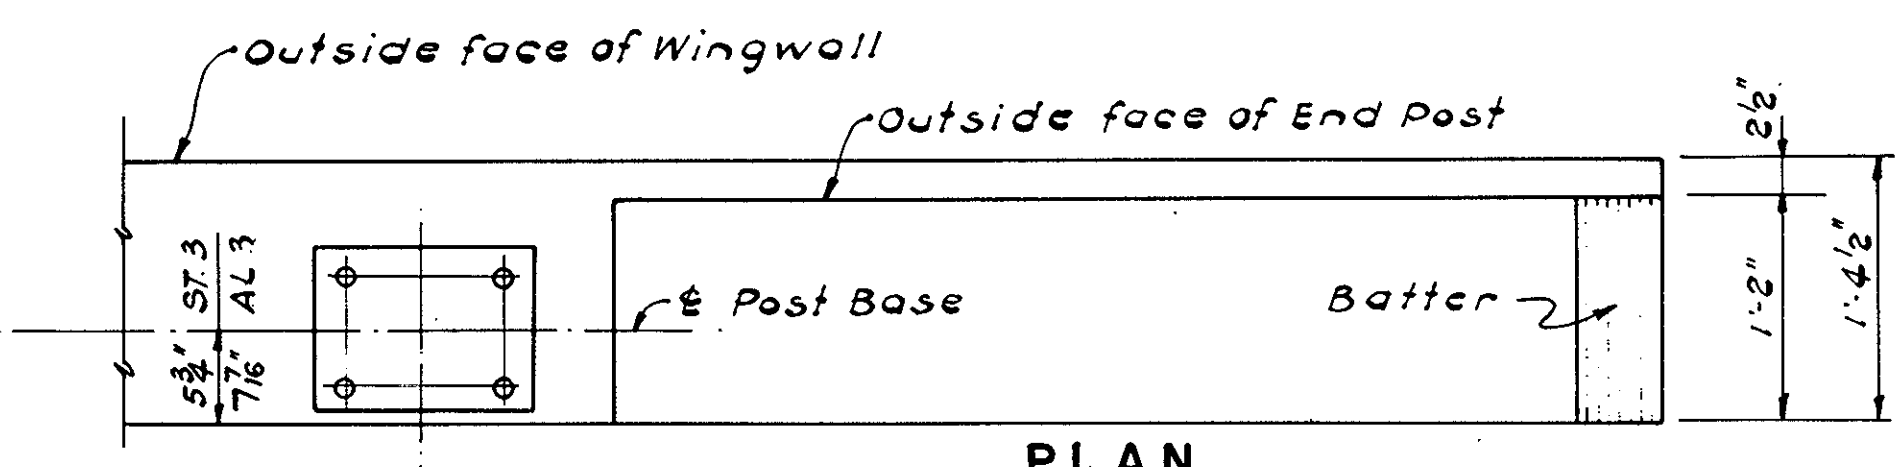

**PLAN**

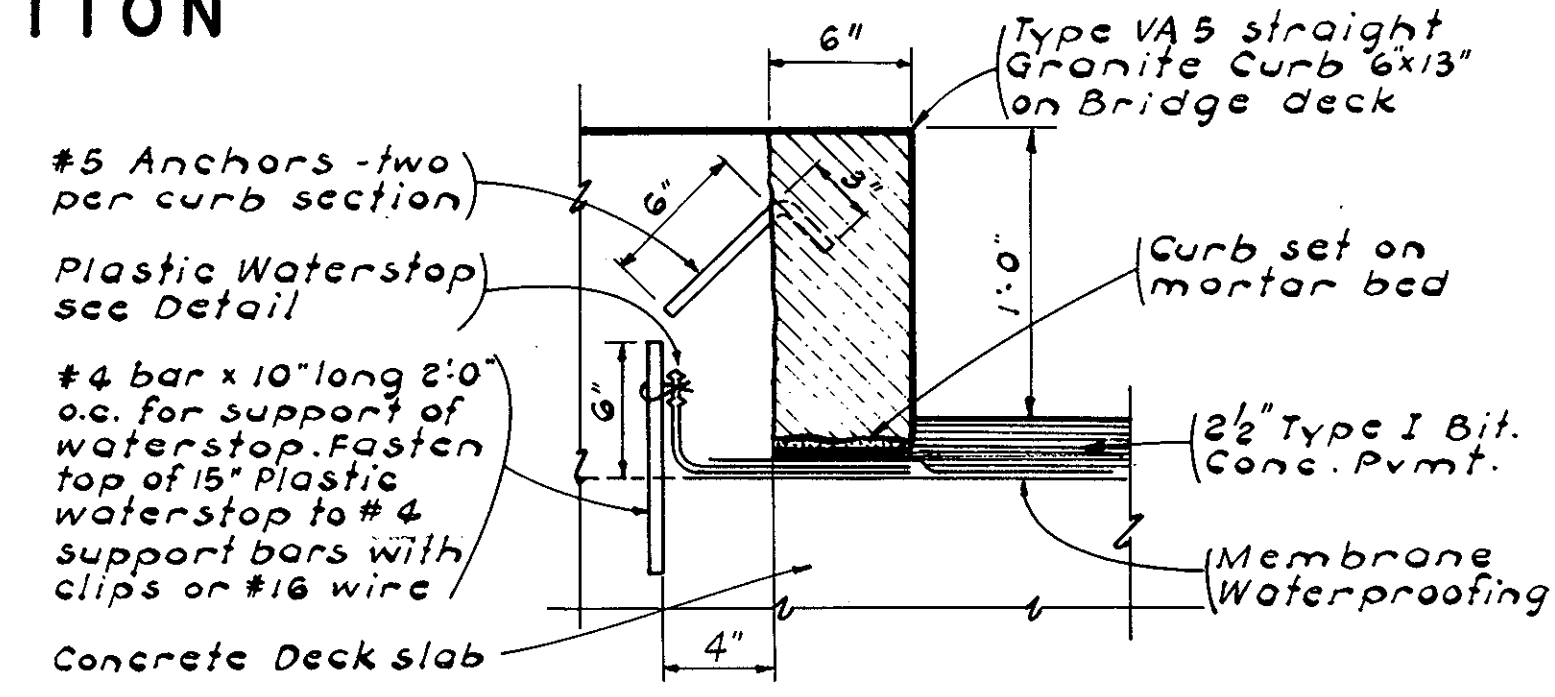


**DETAIL AT CURB**  
Scale: 1/2" = 1'-0"

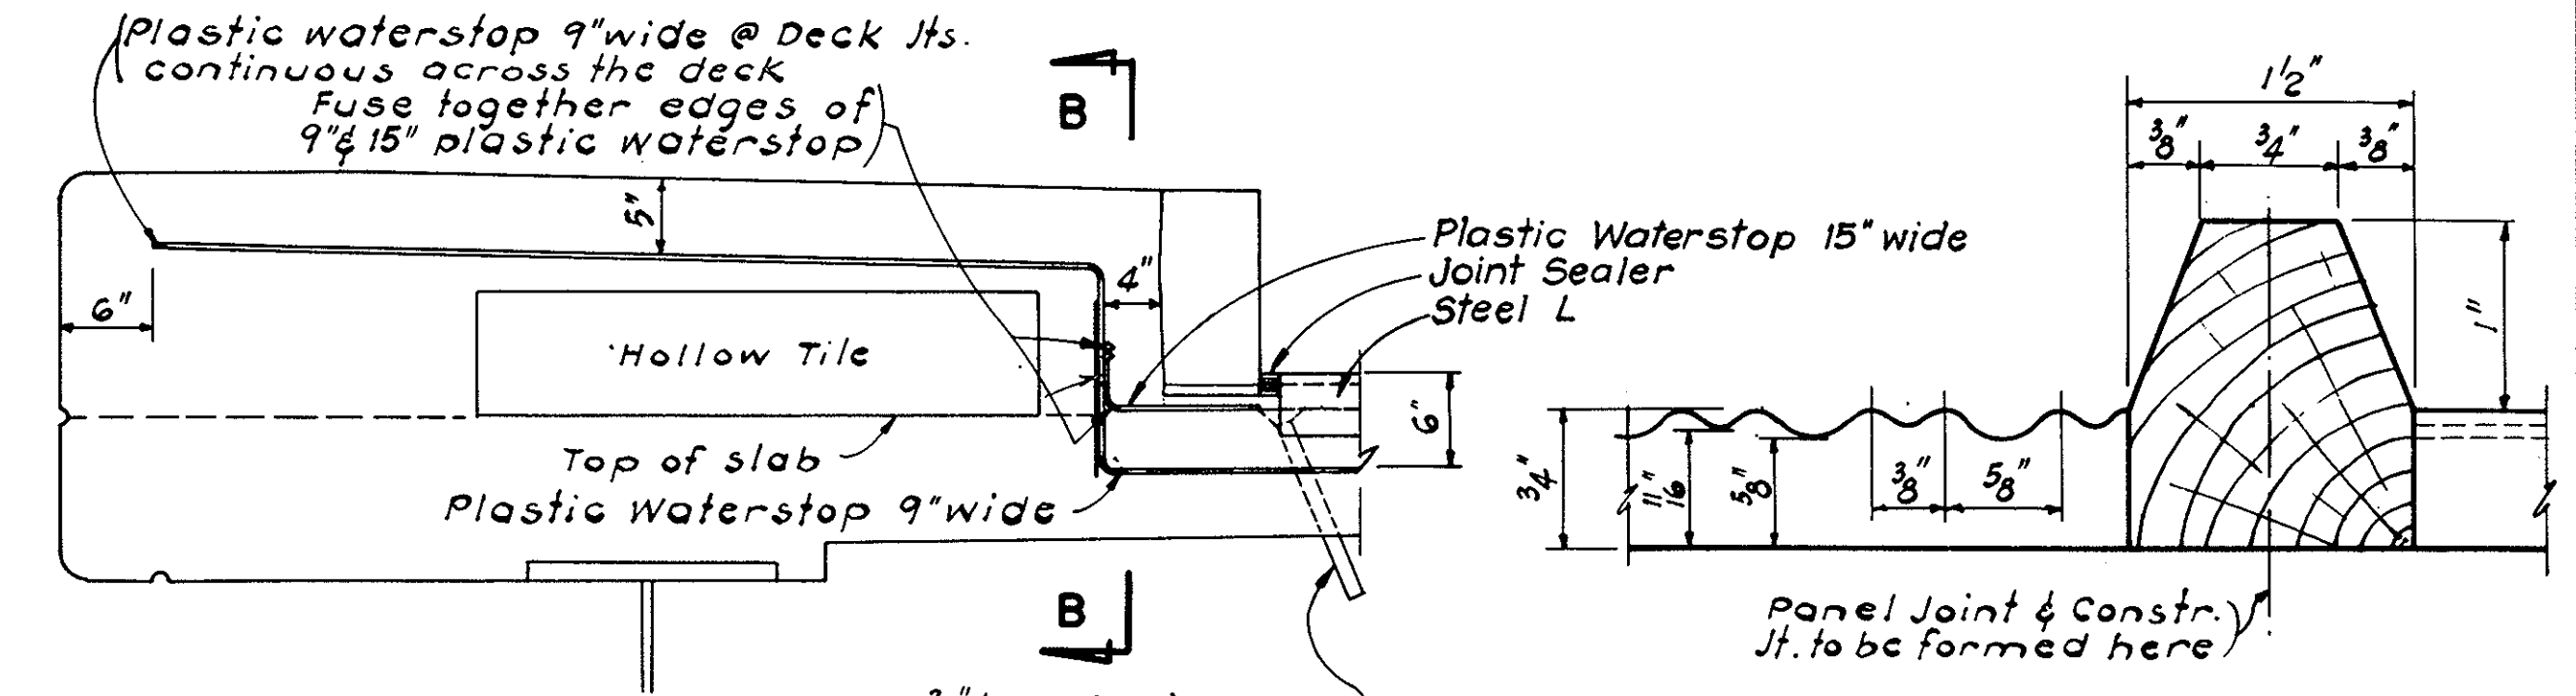


**SECTION THRU JOINT**  
Scale: 1" = 1'-0"

**STRIATION DETAIL**  
Scale: Full Size

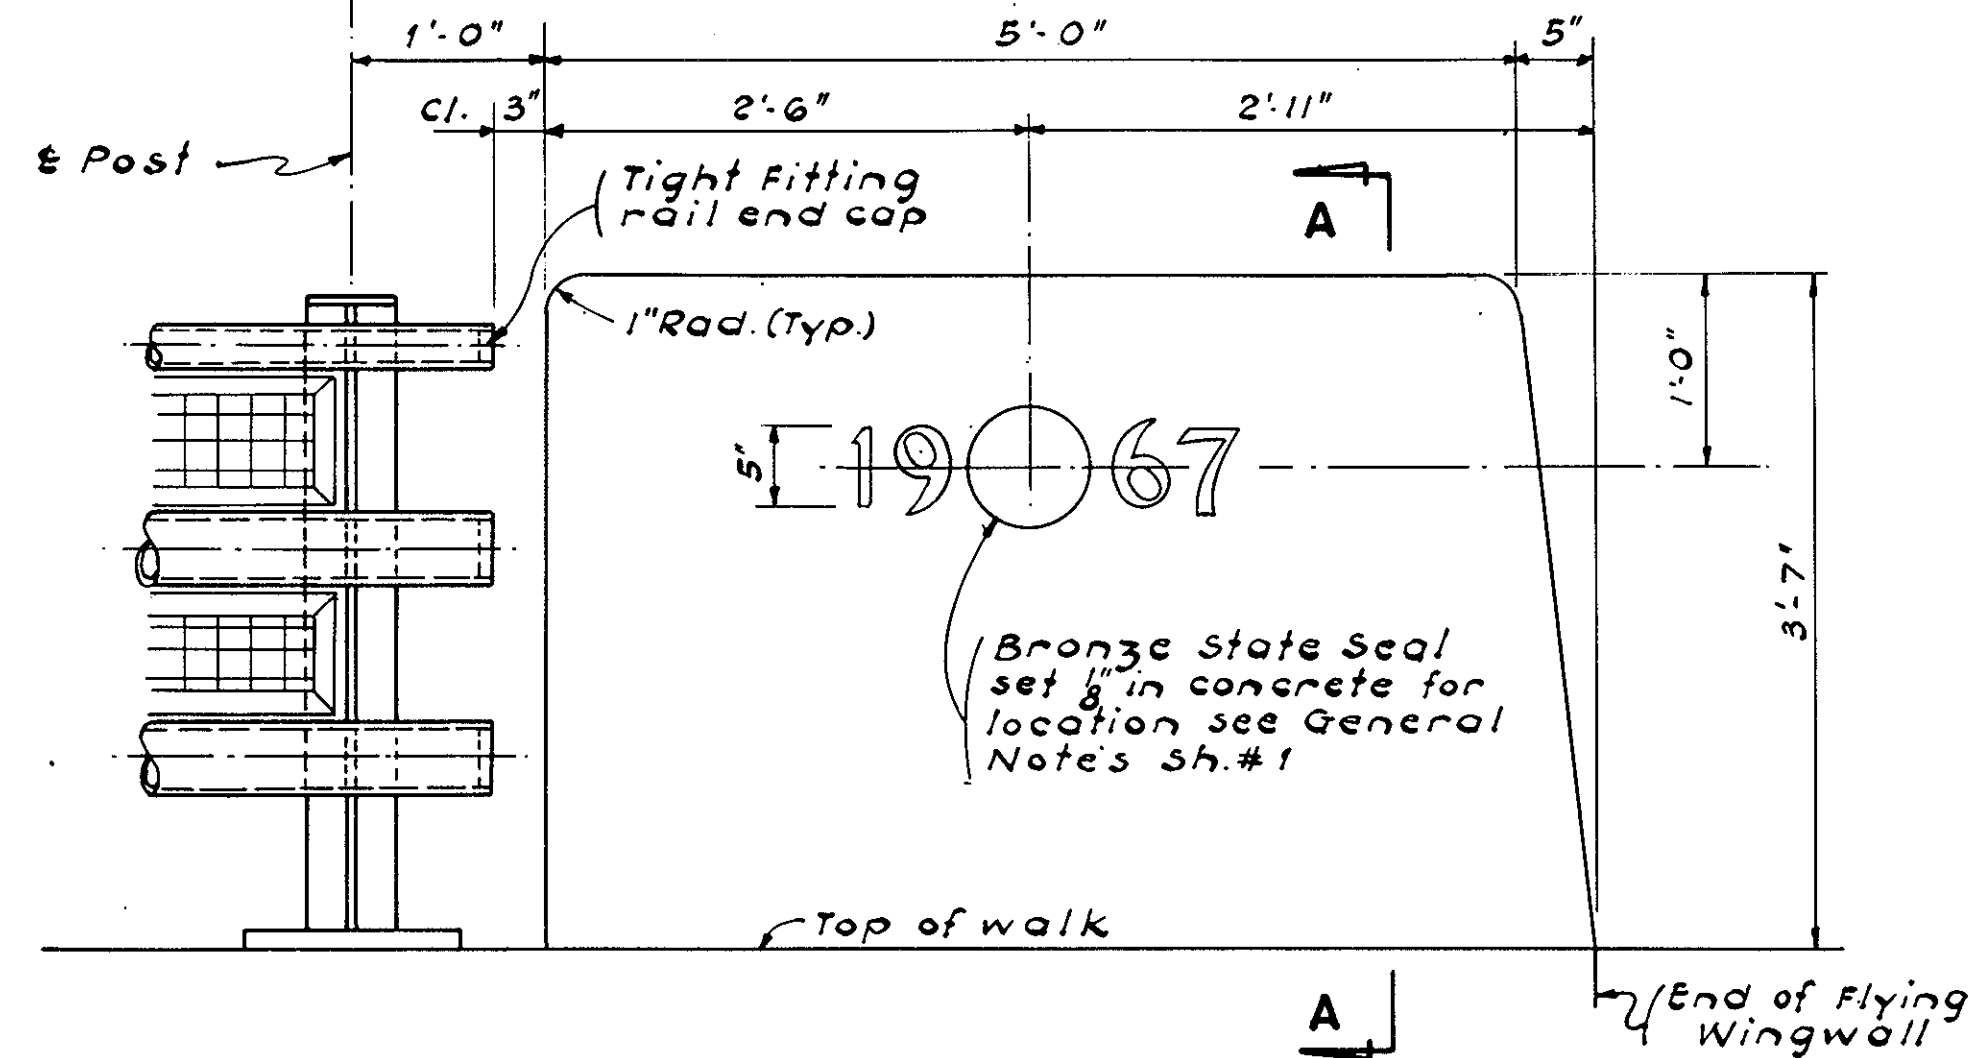


**ELEVATION**  
**END POST DETAIL**  
Scale: 1" = 1'-0"


Note:  
Bridge Railing Type ST-3 shown; Alternate Type AL-3 may be used.  
Railing anchor bolts to be set by template and placed before concrete is poured.  
For location of Date & Seal see General Notes Sheet #1.

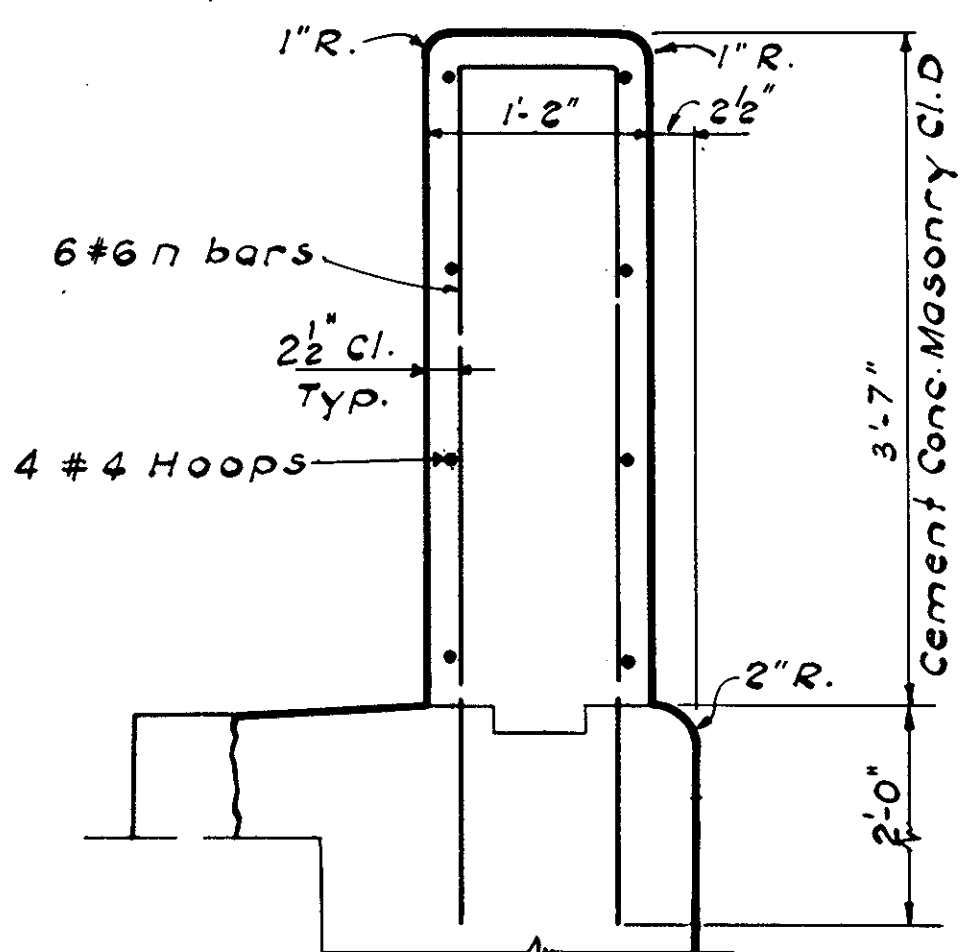


**SECTION A-A**  
Scale: 1" = 1'-0"

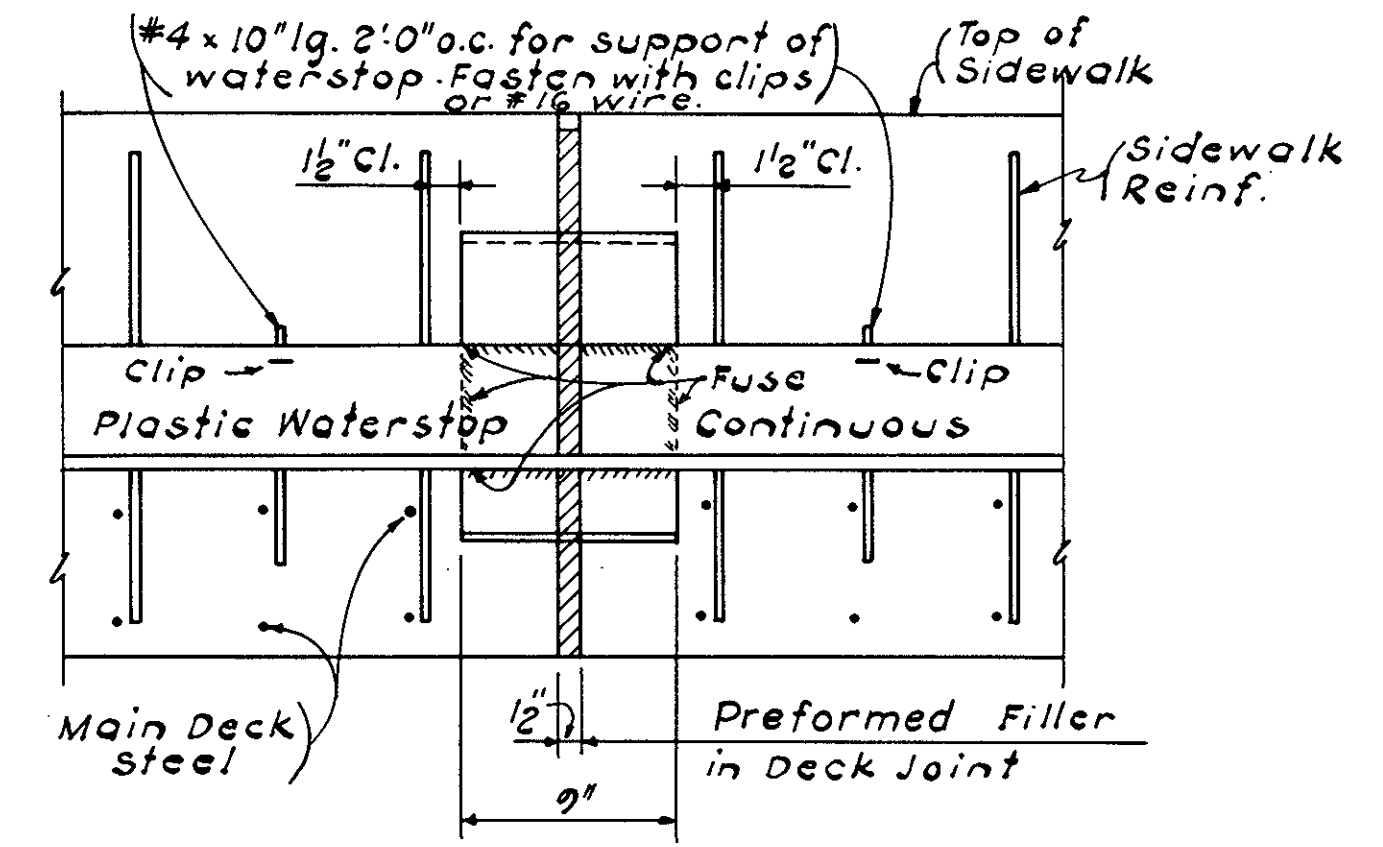

**SECTION B-B**  
**CURB DETAIL AT DECK JOINT**  
Scale: 1/2" = 1'-0"

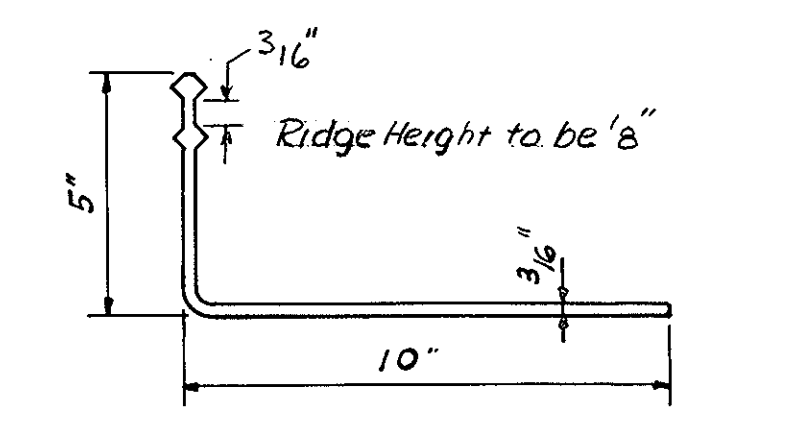


**PLASTIC WATERSTOP**  
Scale: 3" = 1'-0"

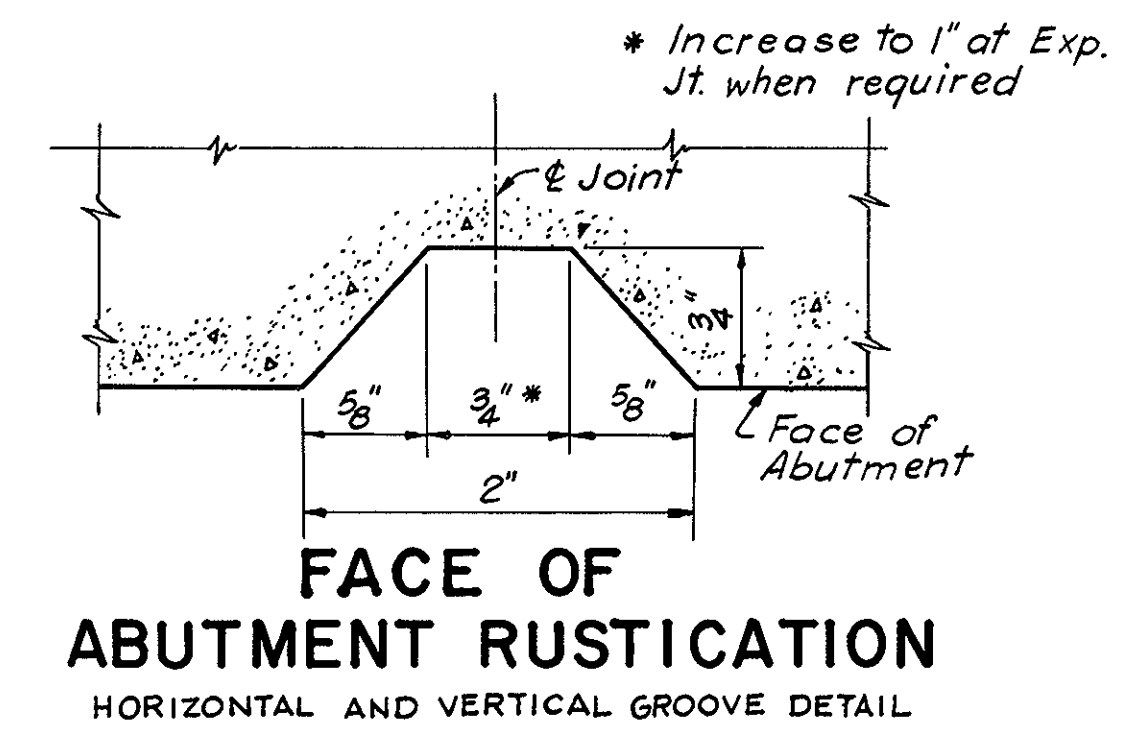


**FACE OF ABUTMENT RUSTICATION**  
HORIZONTAL AND VERTICAL GROOVE DETAIL

DATE	ISSUED FOR CONSTRUCTION
MARCH 25 1967	ISSUED FOR CONSTRUCTION
DATE	DESCRIPTION
	USE ONLY PRINTS OF LATEST DATE


PUB. RD. DIV. NO.	STATE	FED. AID PROJ. NO.	FISCAL YEAR	SHEET NO.	TOTAL SHEETS
1	MASS	I-91-(64)9	1967	84	393

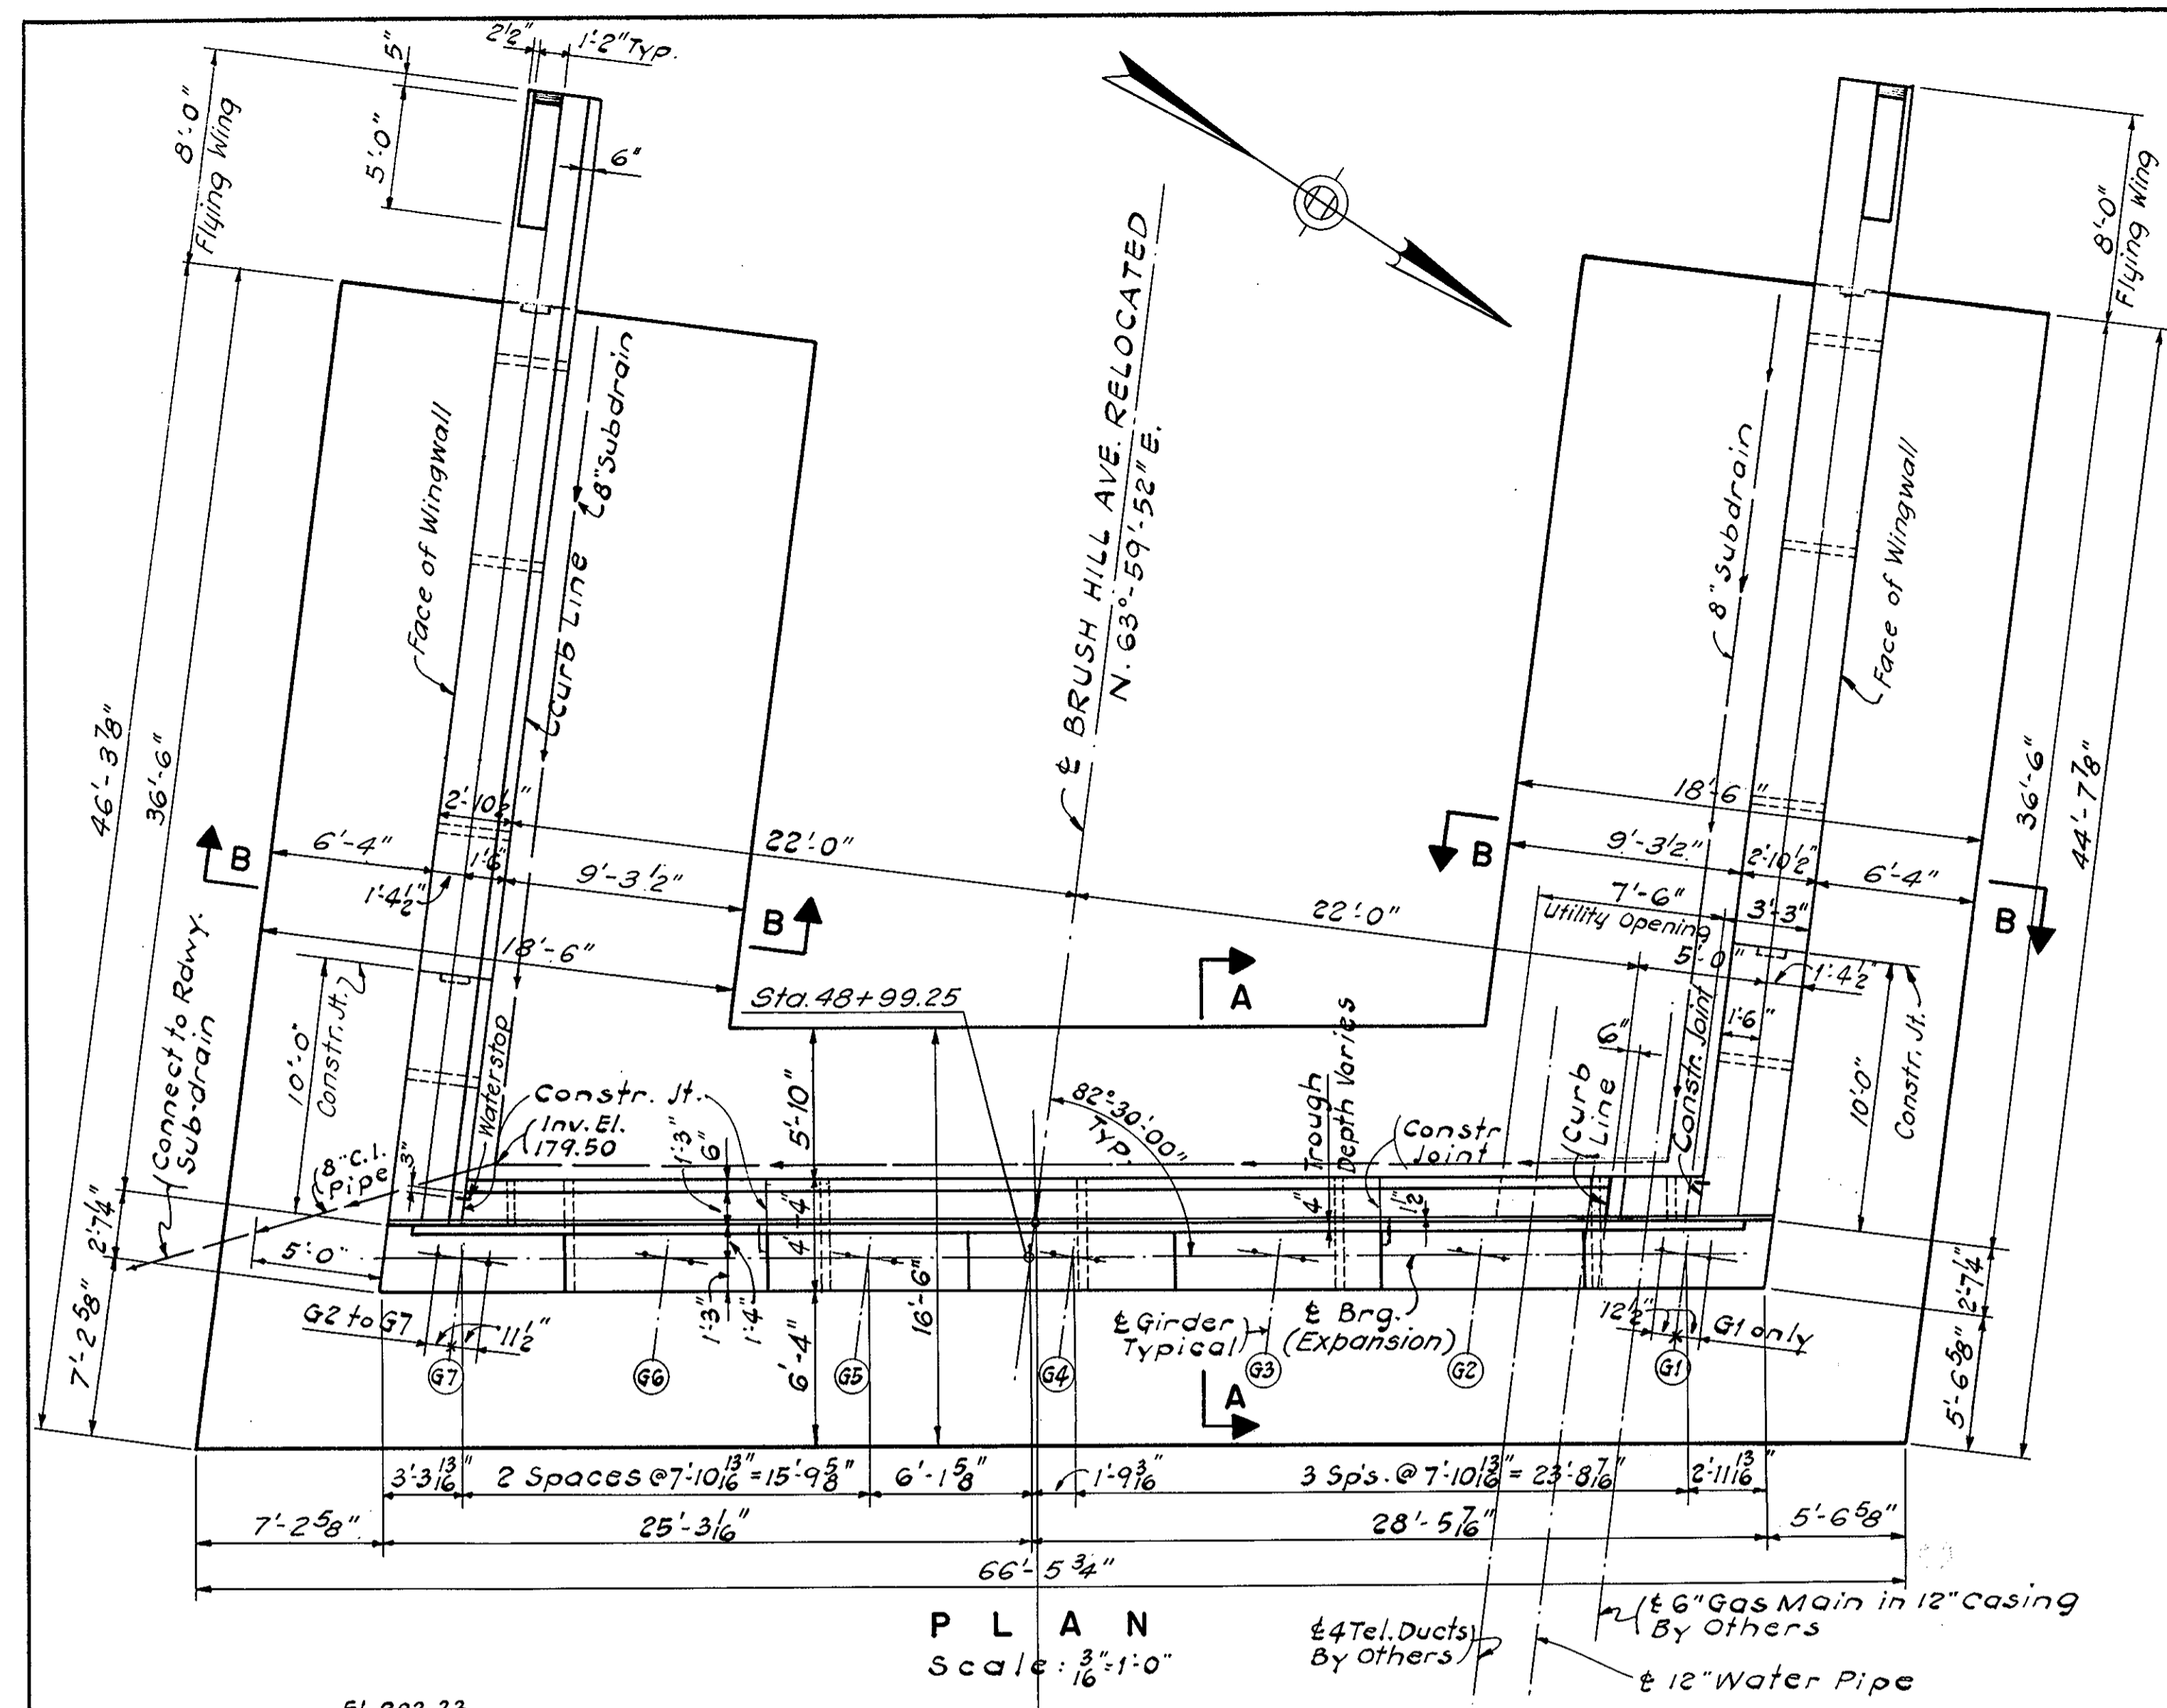


**PLAN**  
Scale:  $\frac{3}{16}'' = 1'-0''$

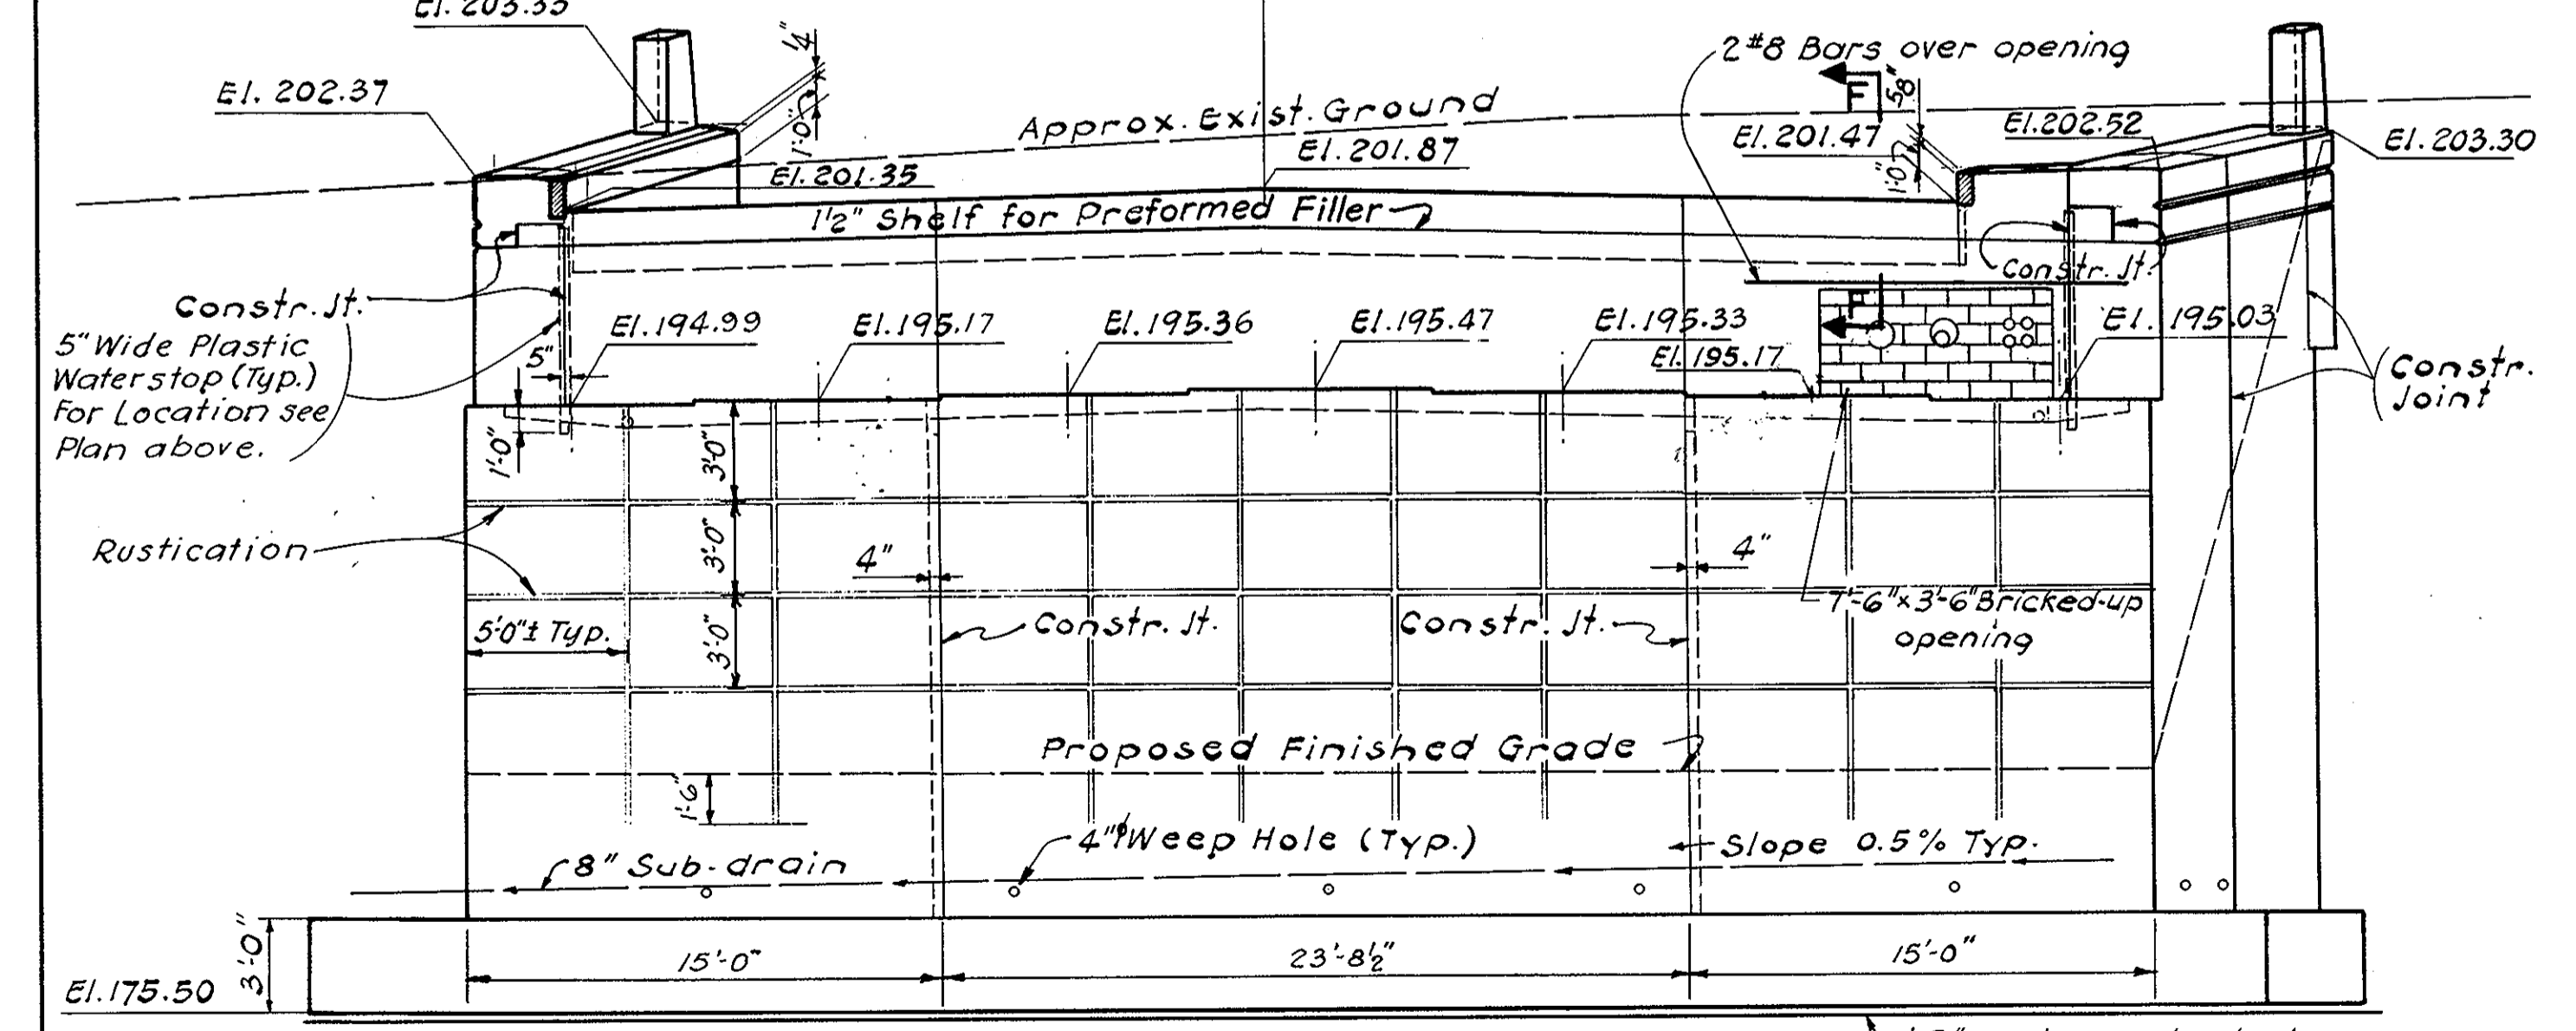

**ELEVATION WEST ABUTMENT**  
Scale:  $\frac{3}{16}'' = 1'-0''$

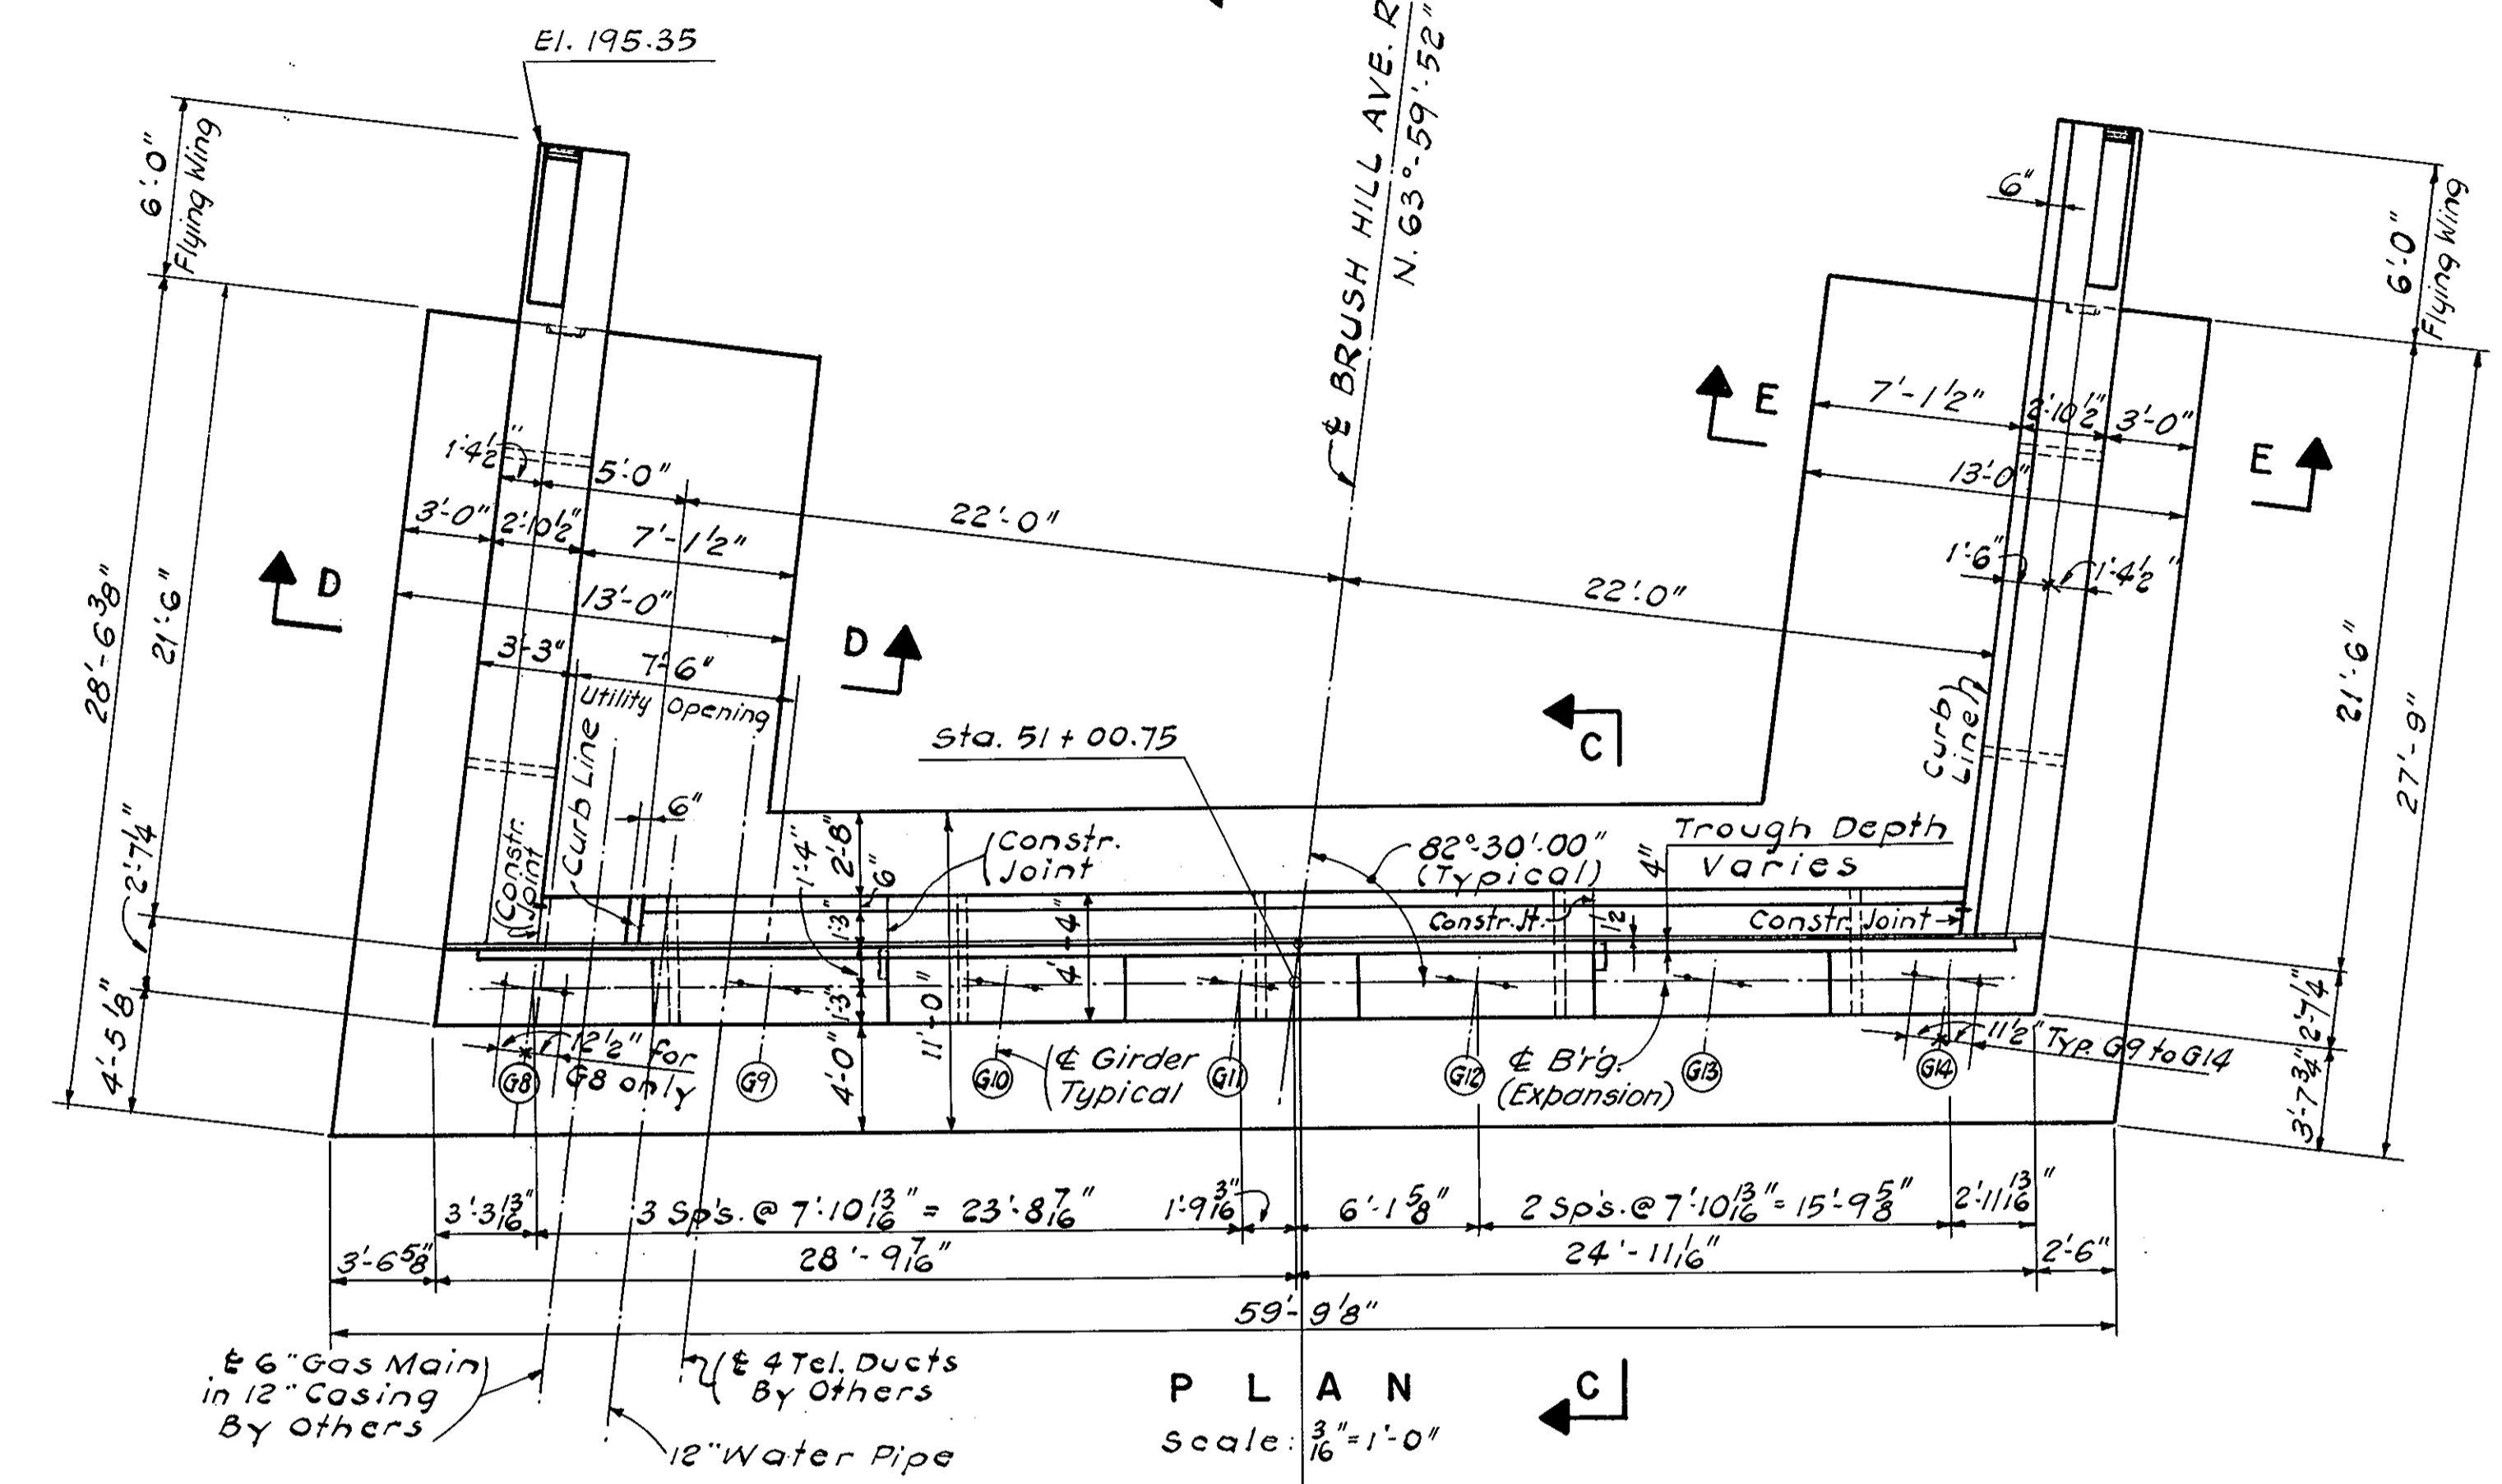



**PLAN**  
Scale:  $\frac{3}{16}'' = 1'-0''$

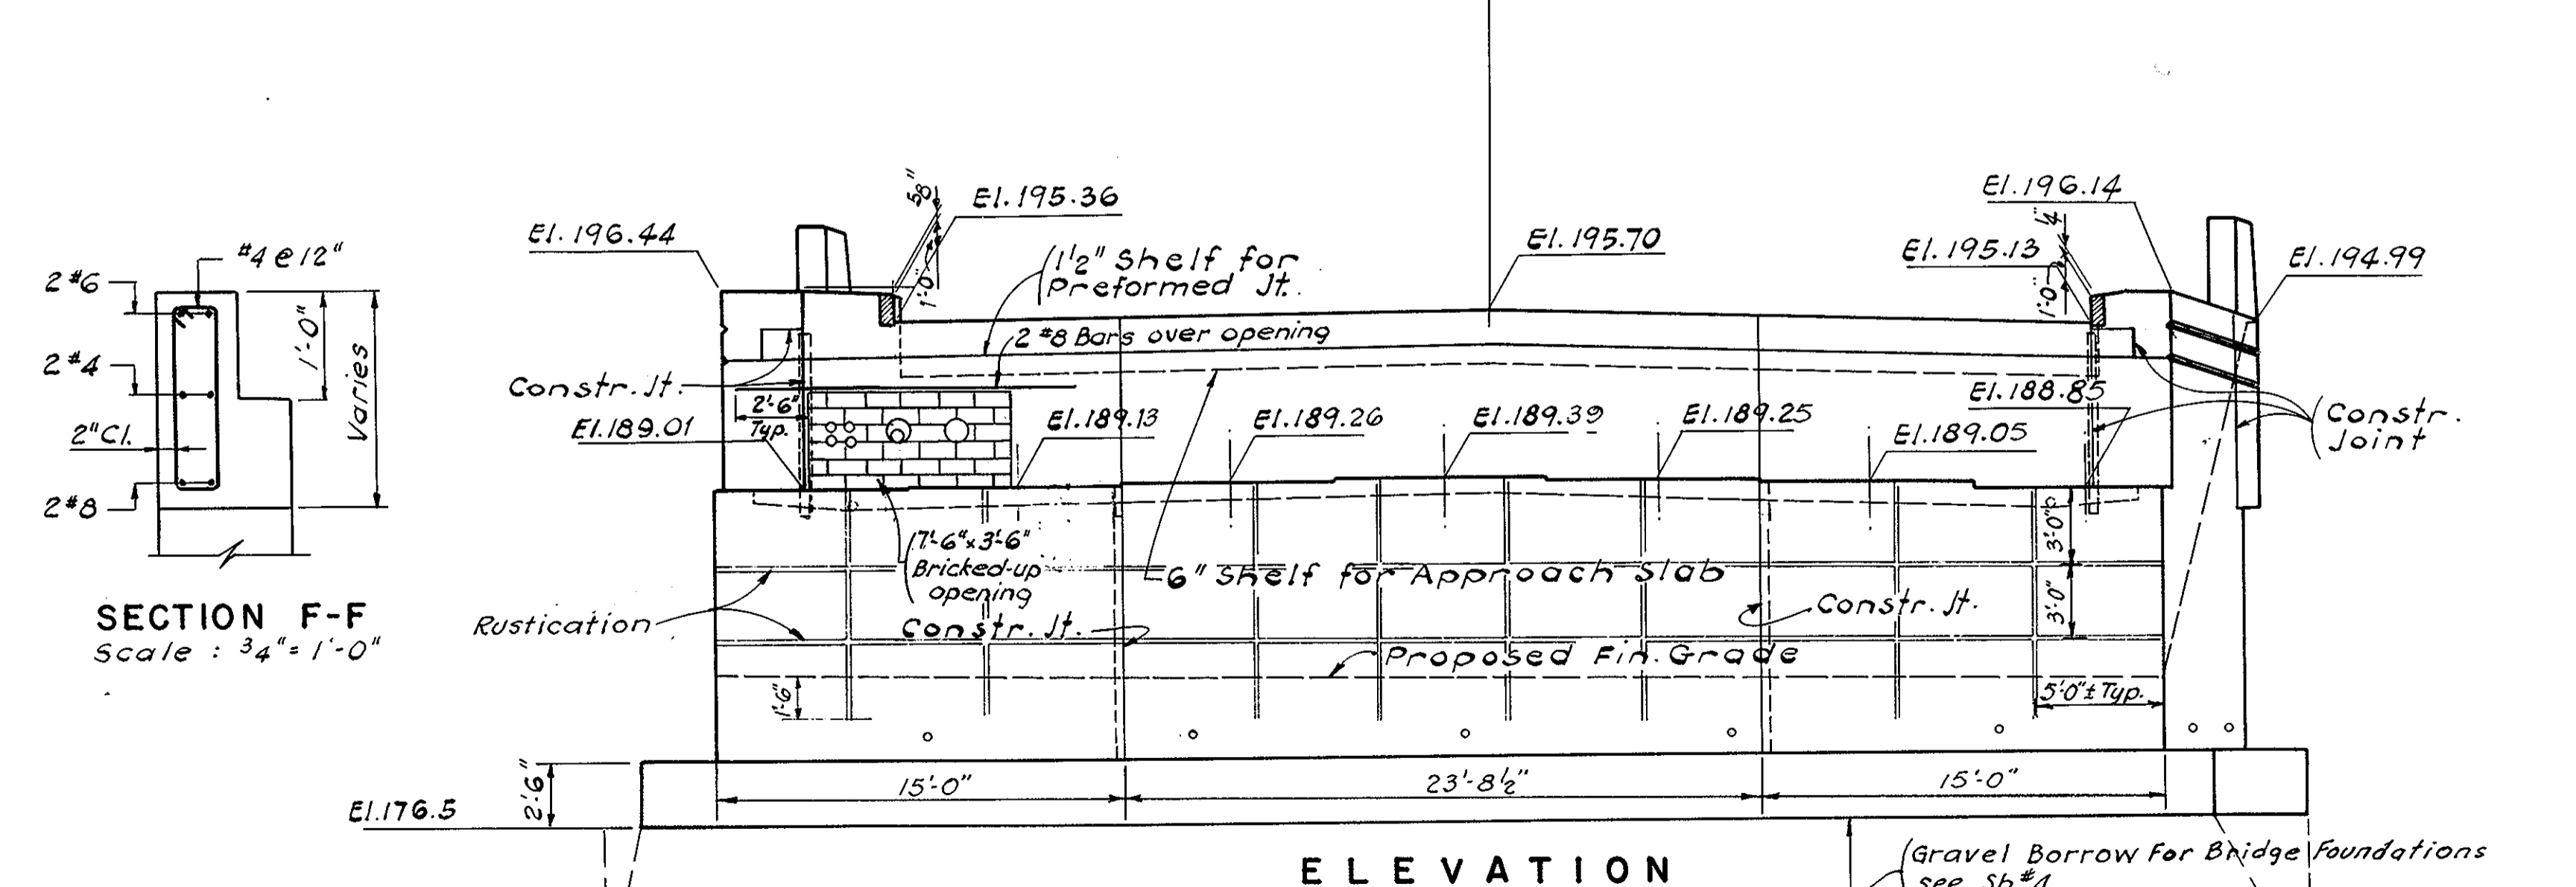








**ELEVATION EAST ABUTMENT**  
Scale:  $\frac{3}{16}'' = 1'-0''$

MARCH 25, 1967	ISSUED FOR CONSTRUCTION
DATE	DESCRIPTION
USE ONLY PRINTS OF LATEST DATE	

PUB. RD. DIV. NO.	STATE	FED. AID PROJ. NO.	FISCAL YEAR	SHEET NO.	TOTAL SHEETS
1	MASS.	I-91-1(64)9	1967	85	393

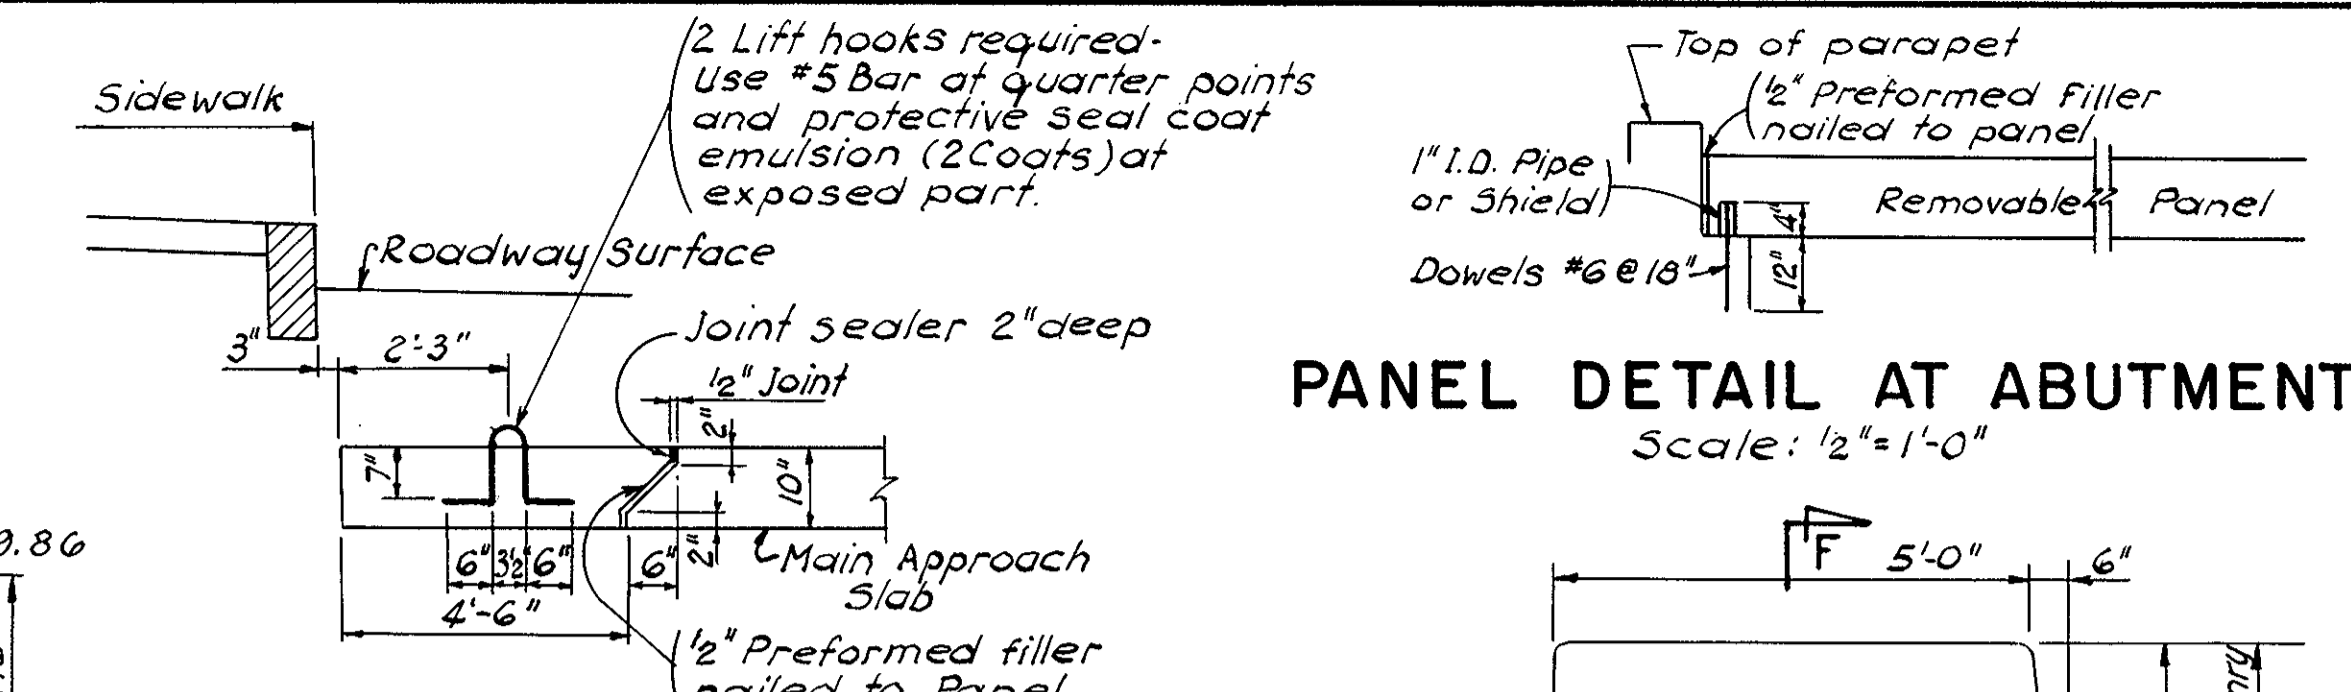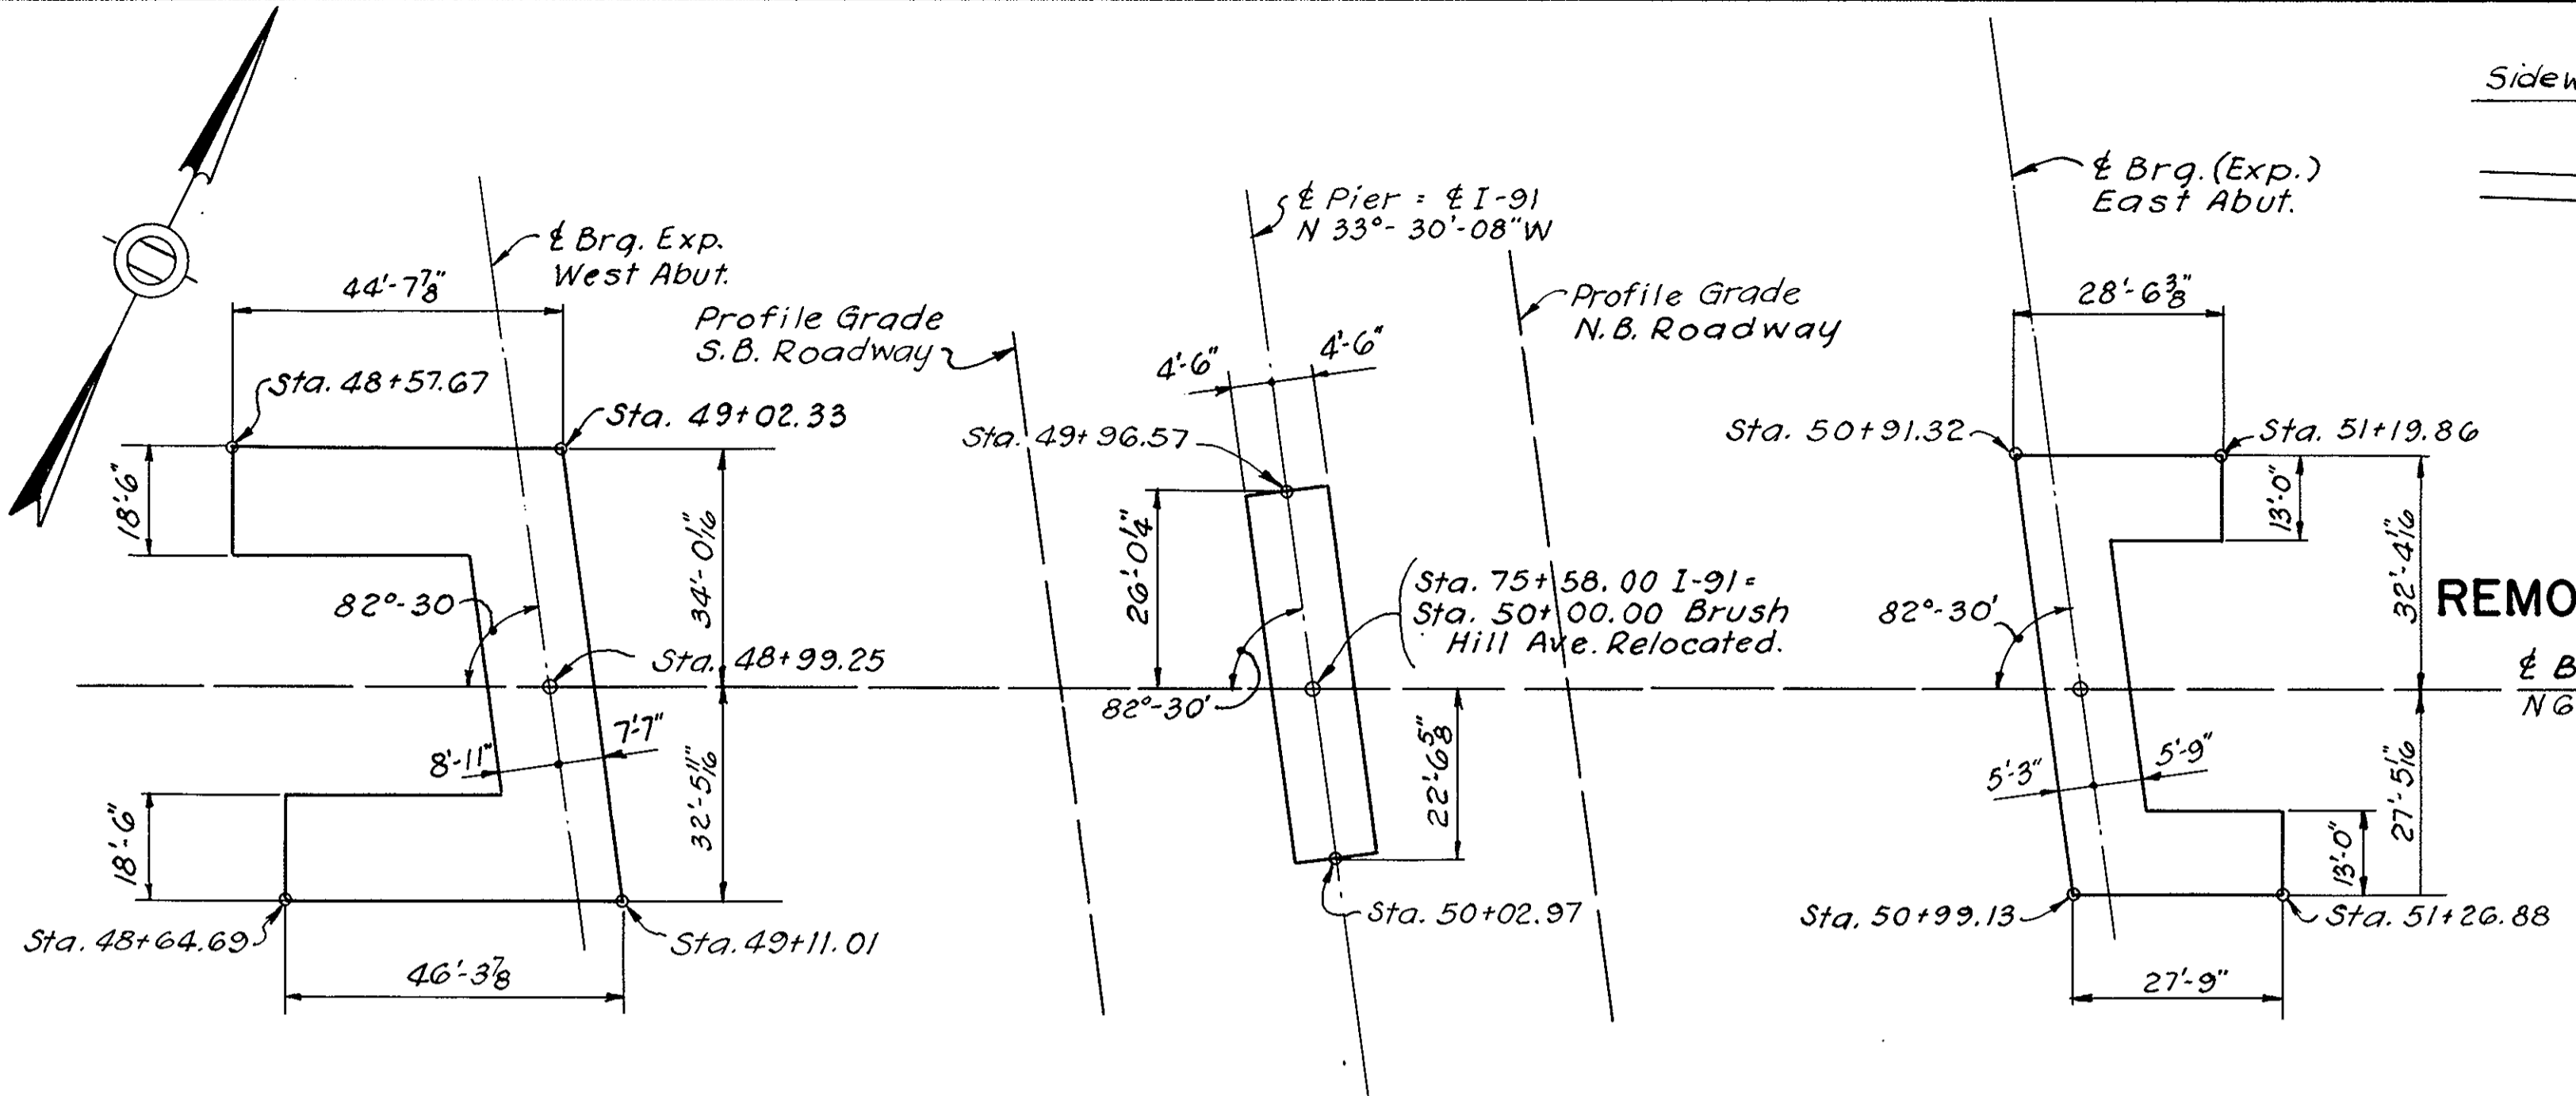


**PANEL DETAIL AT ABUTMENT**  
Scale: 1/2" = 1'-0"

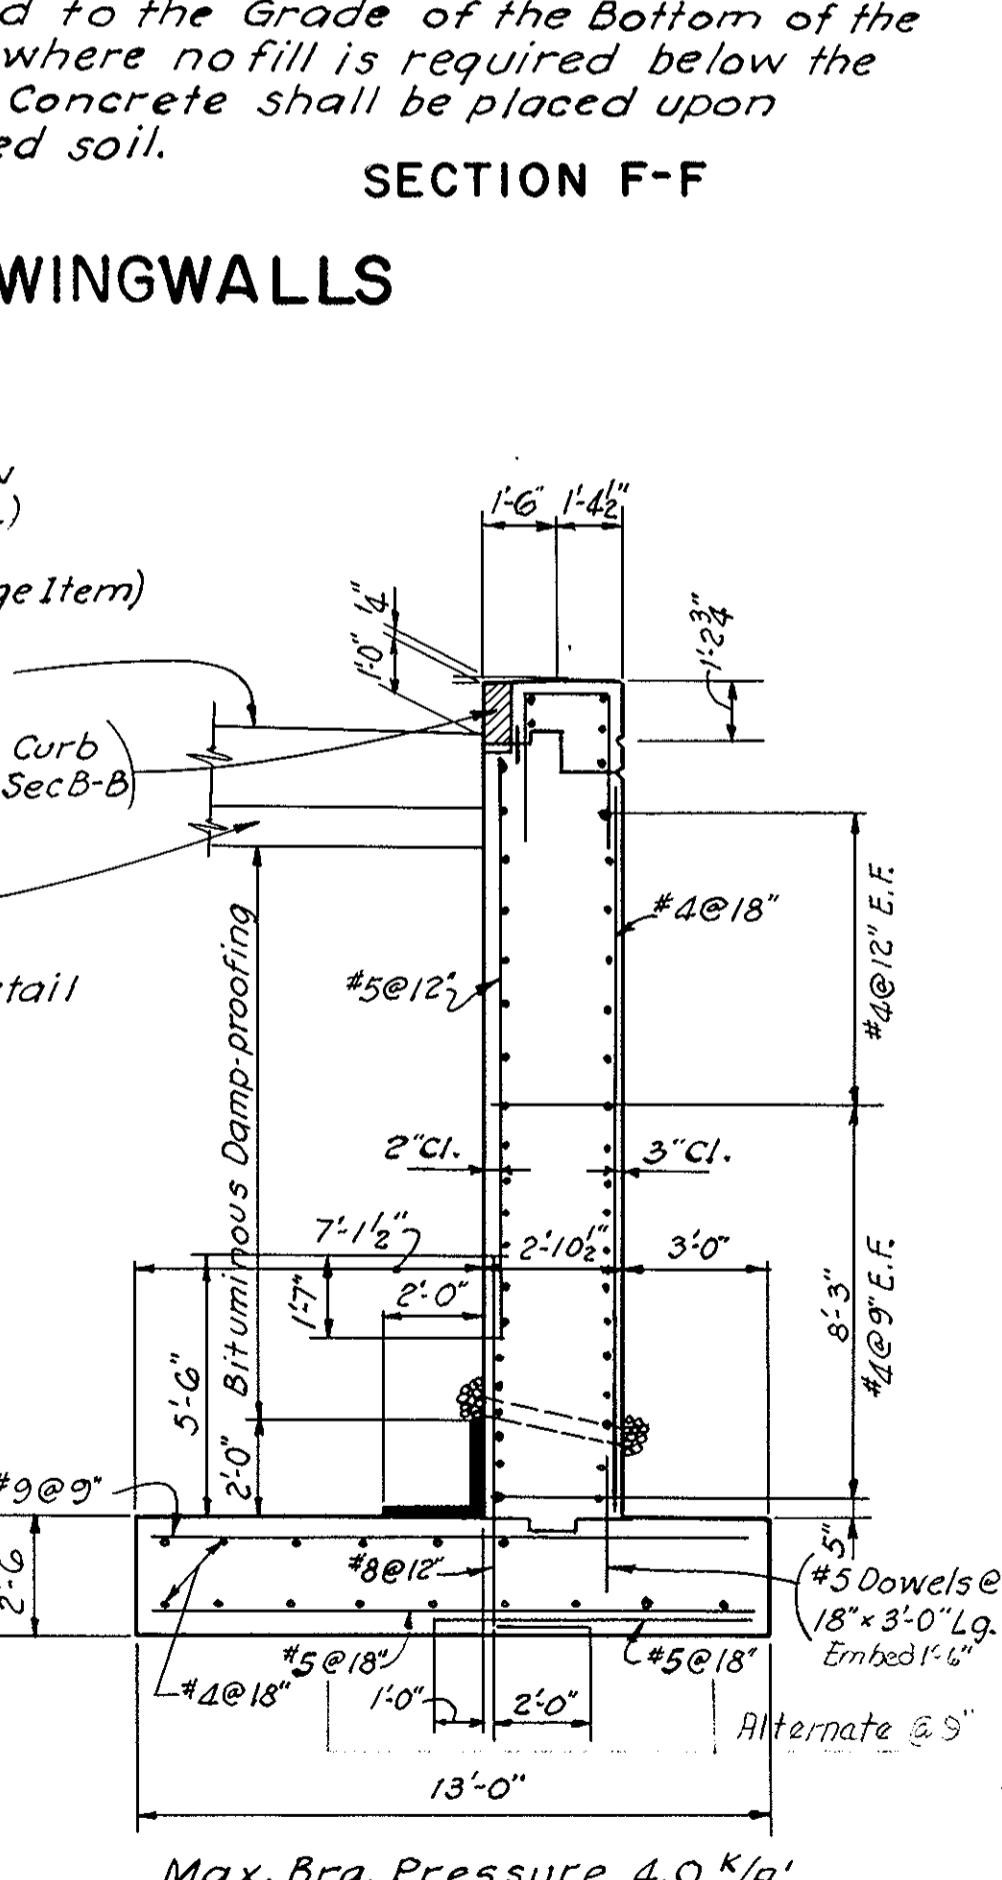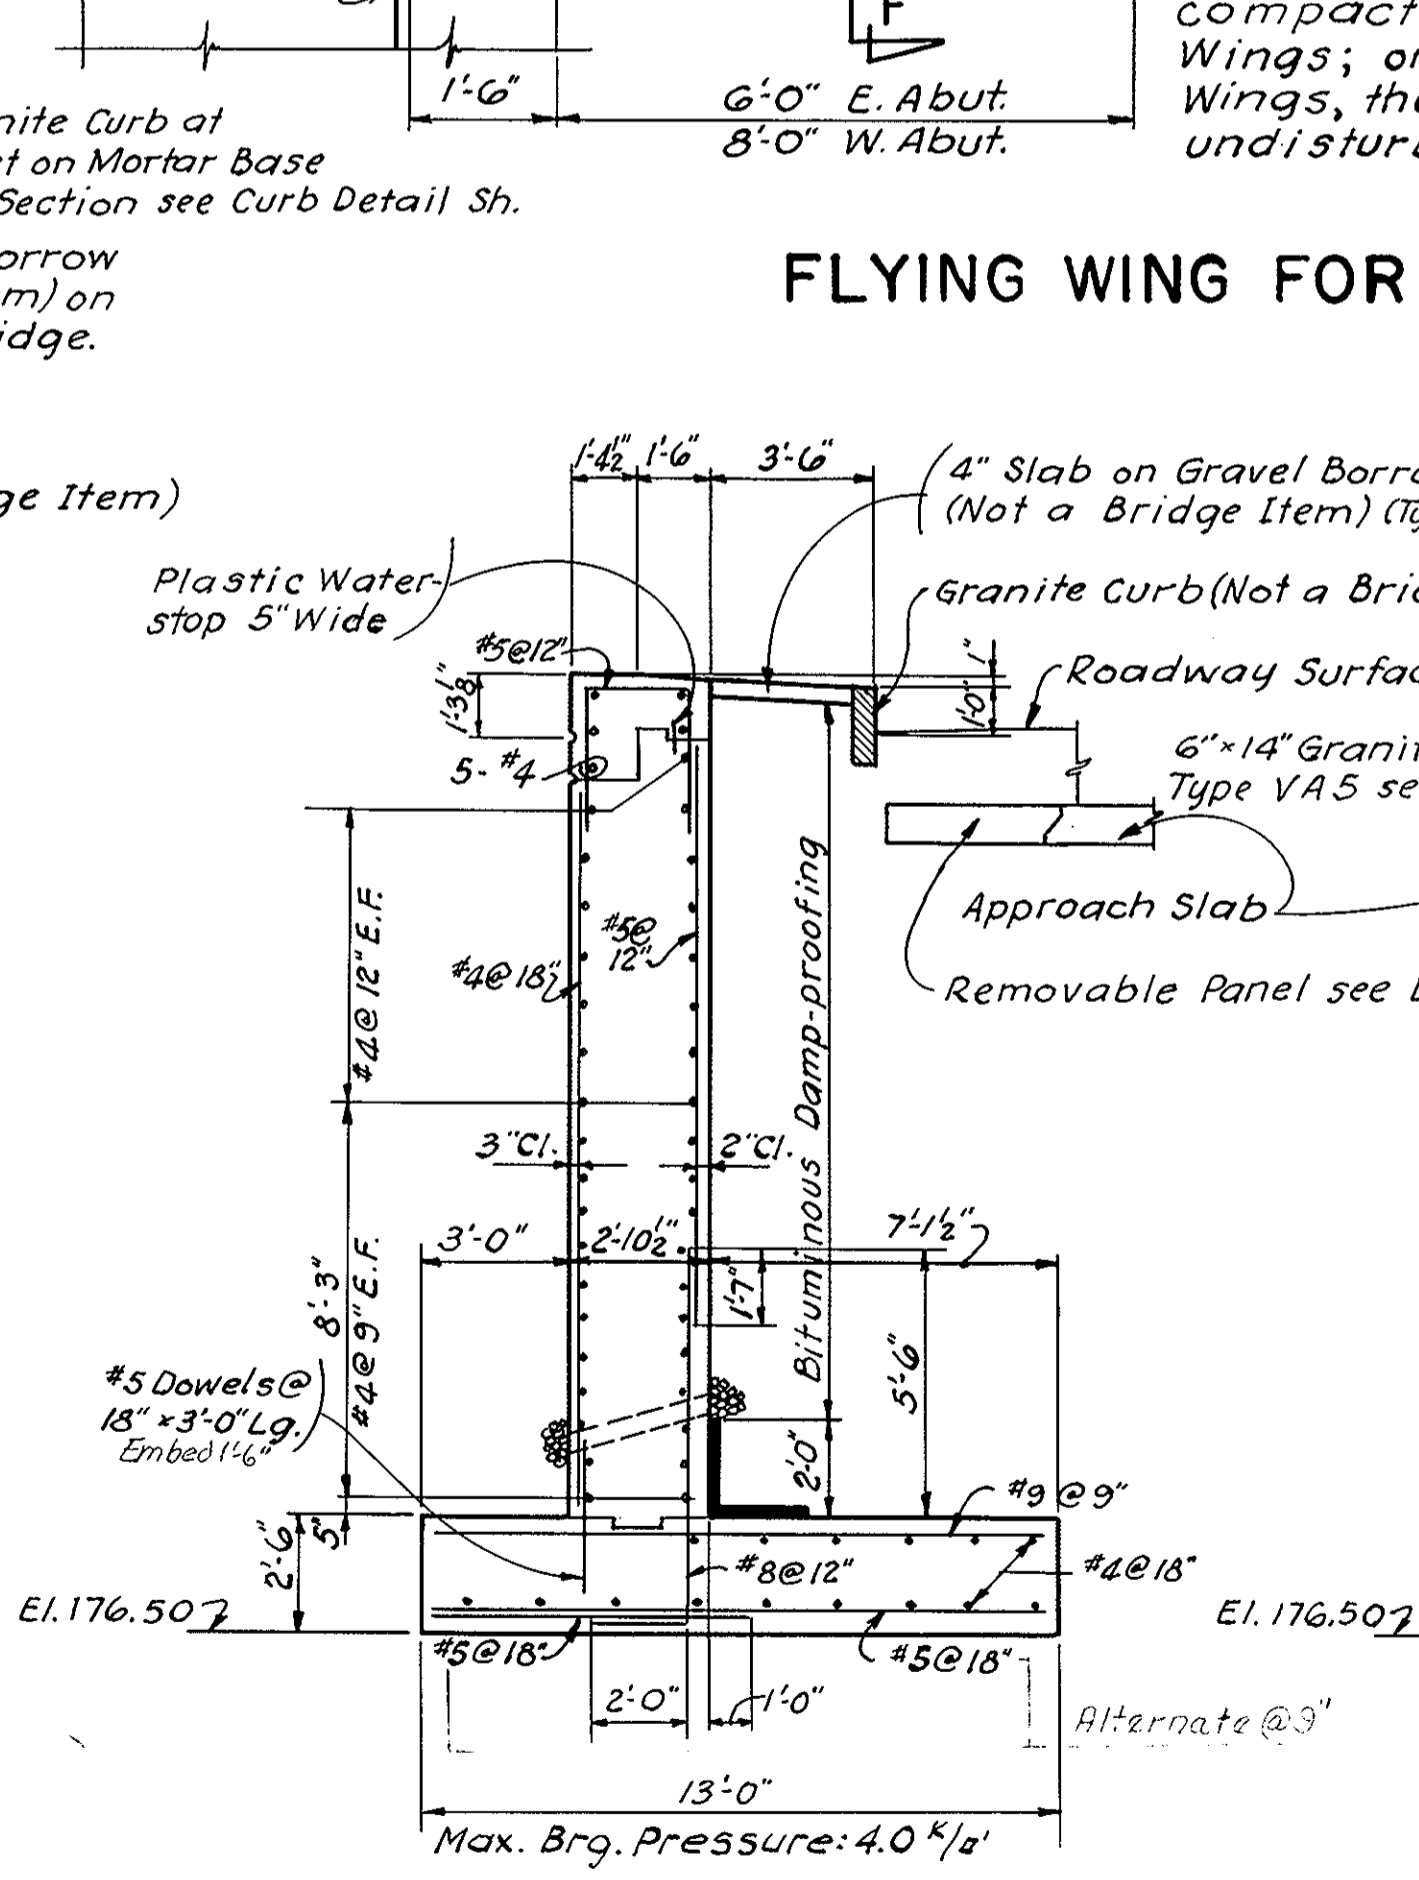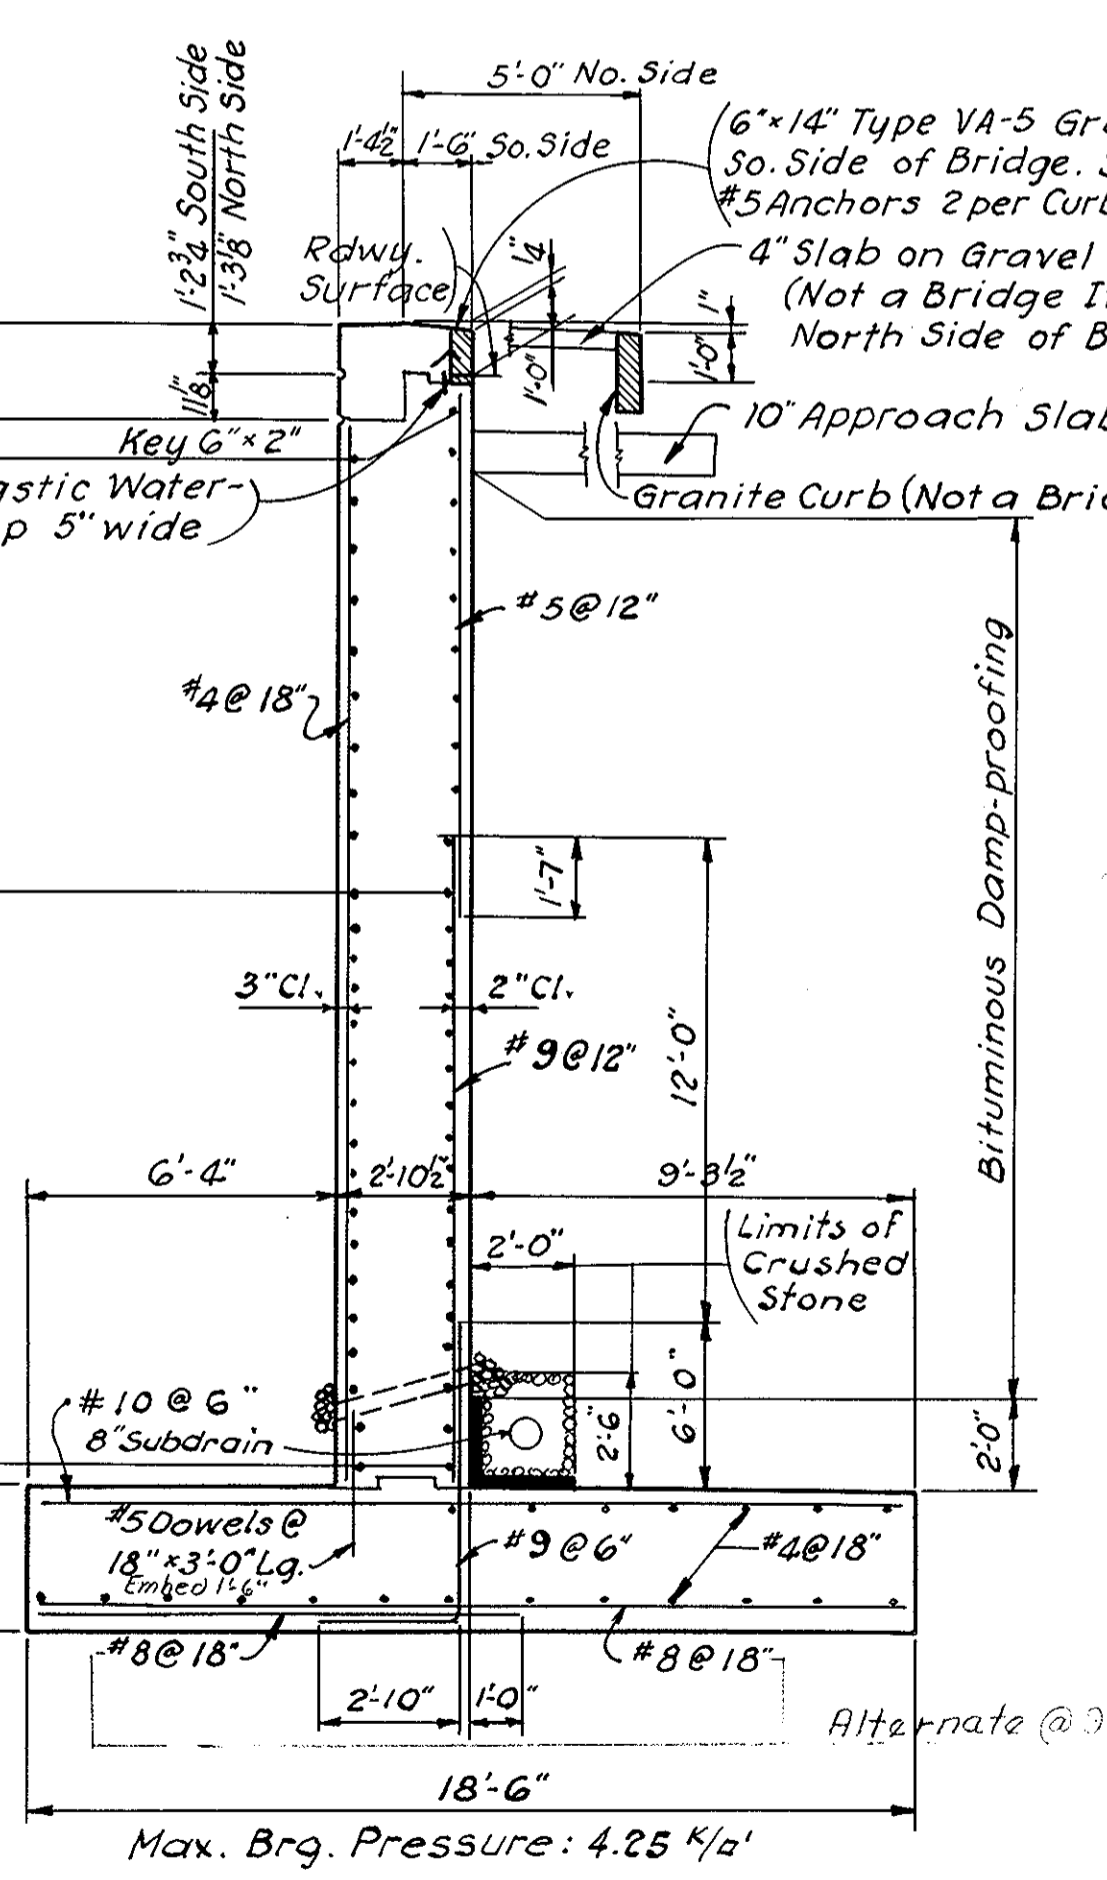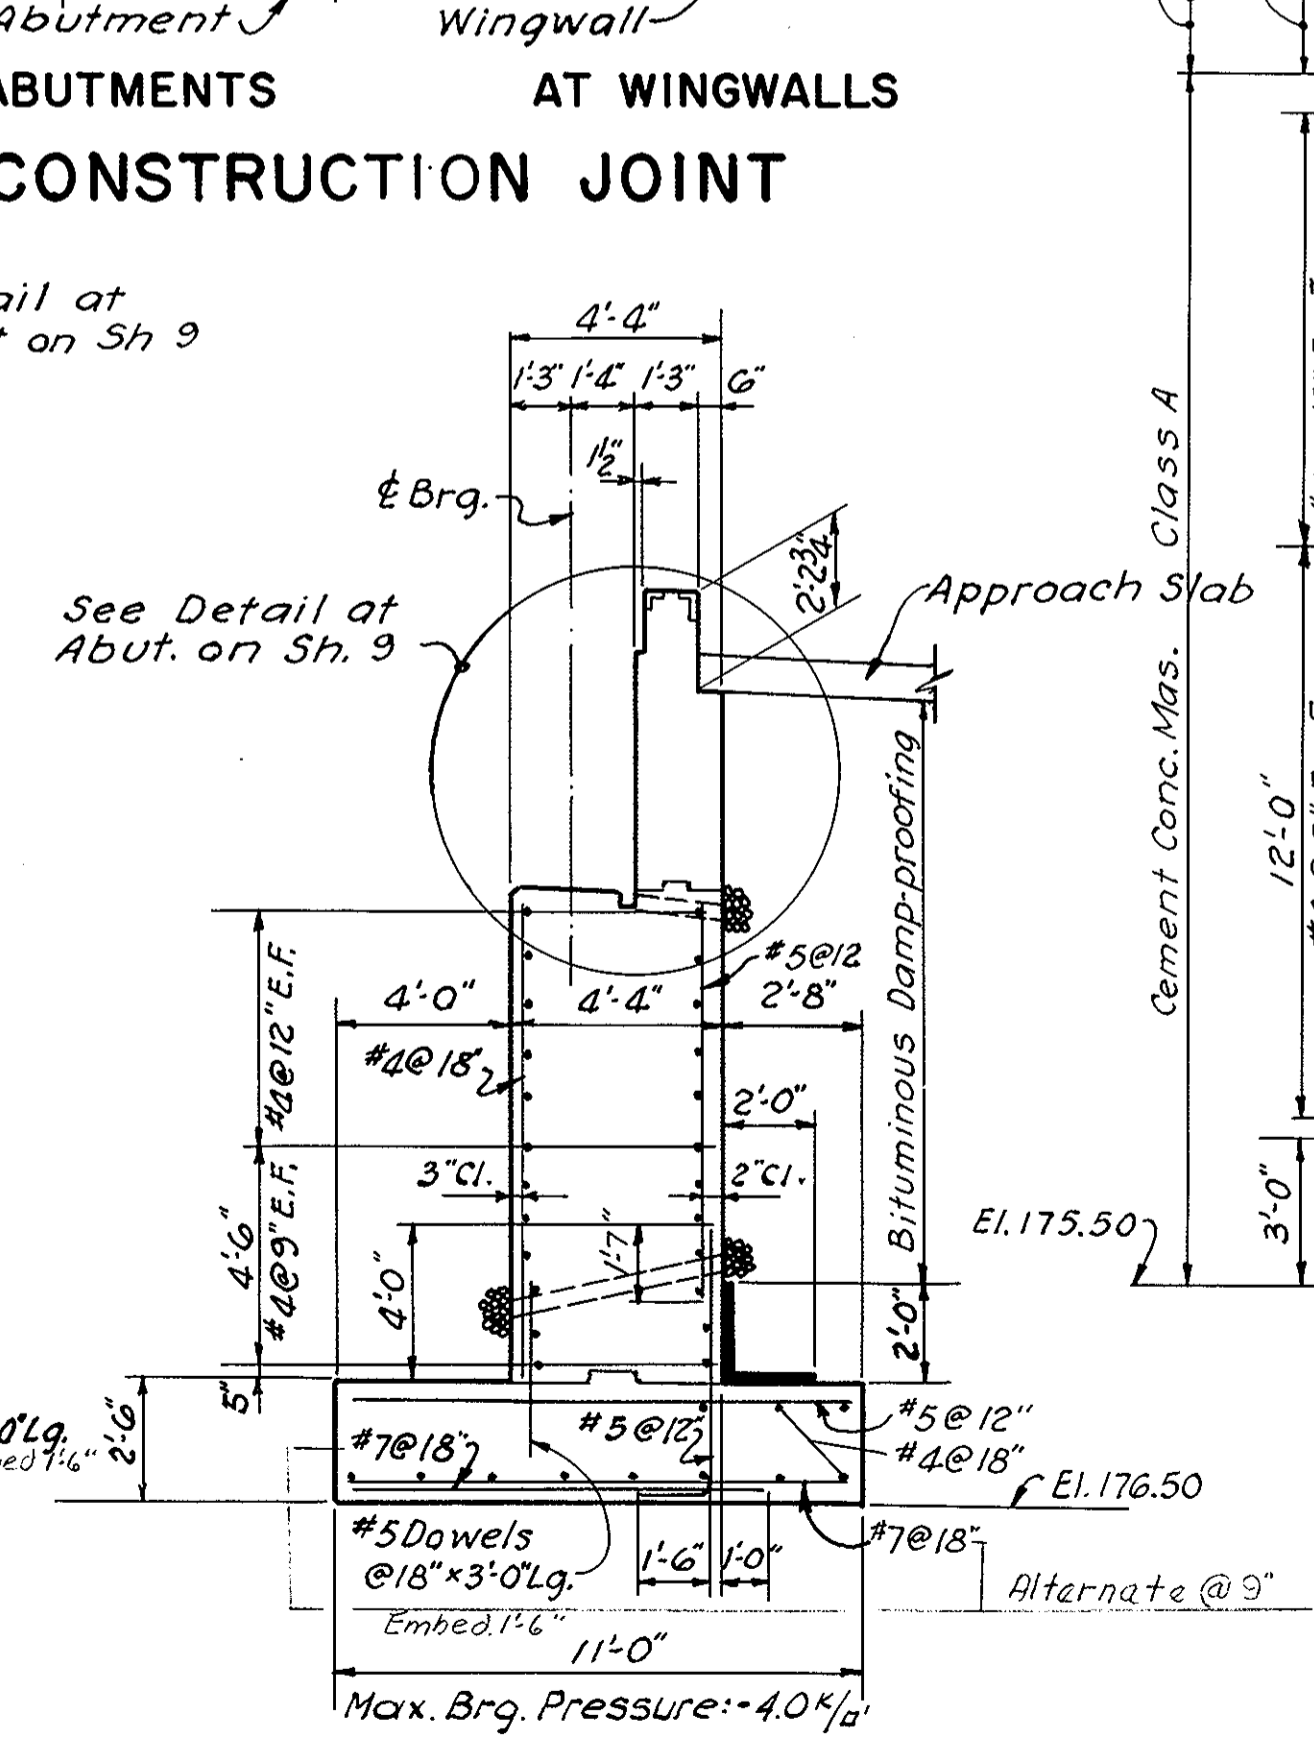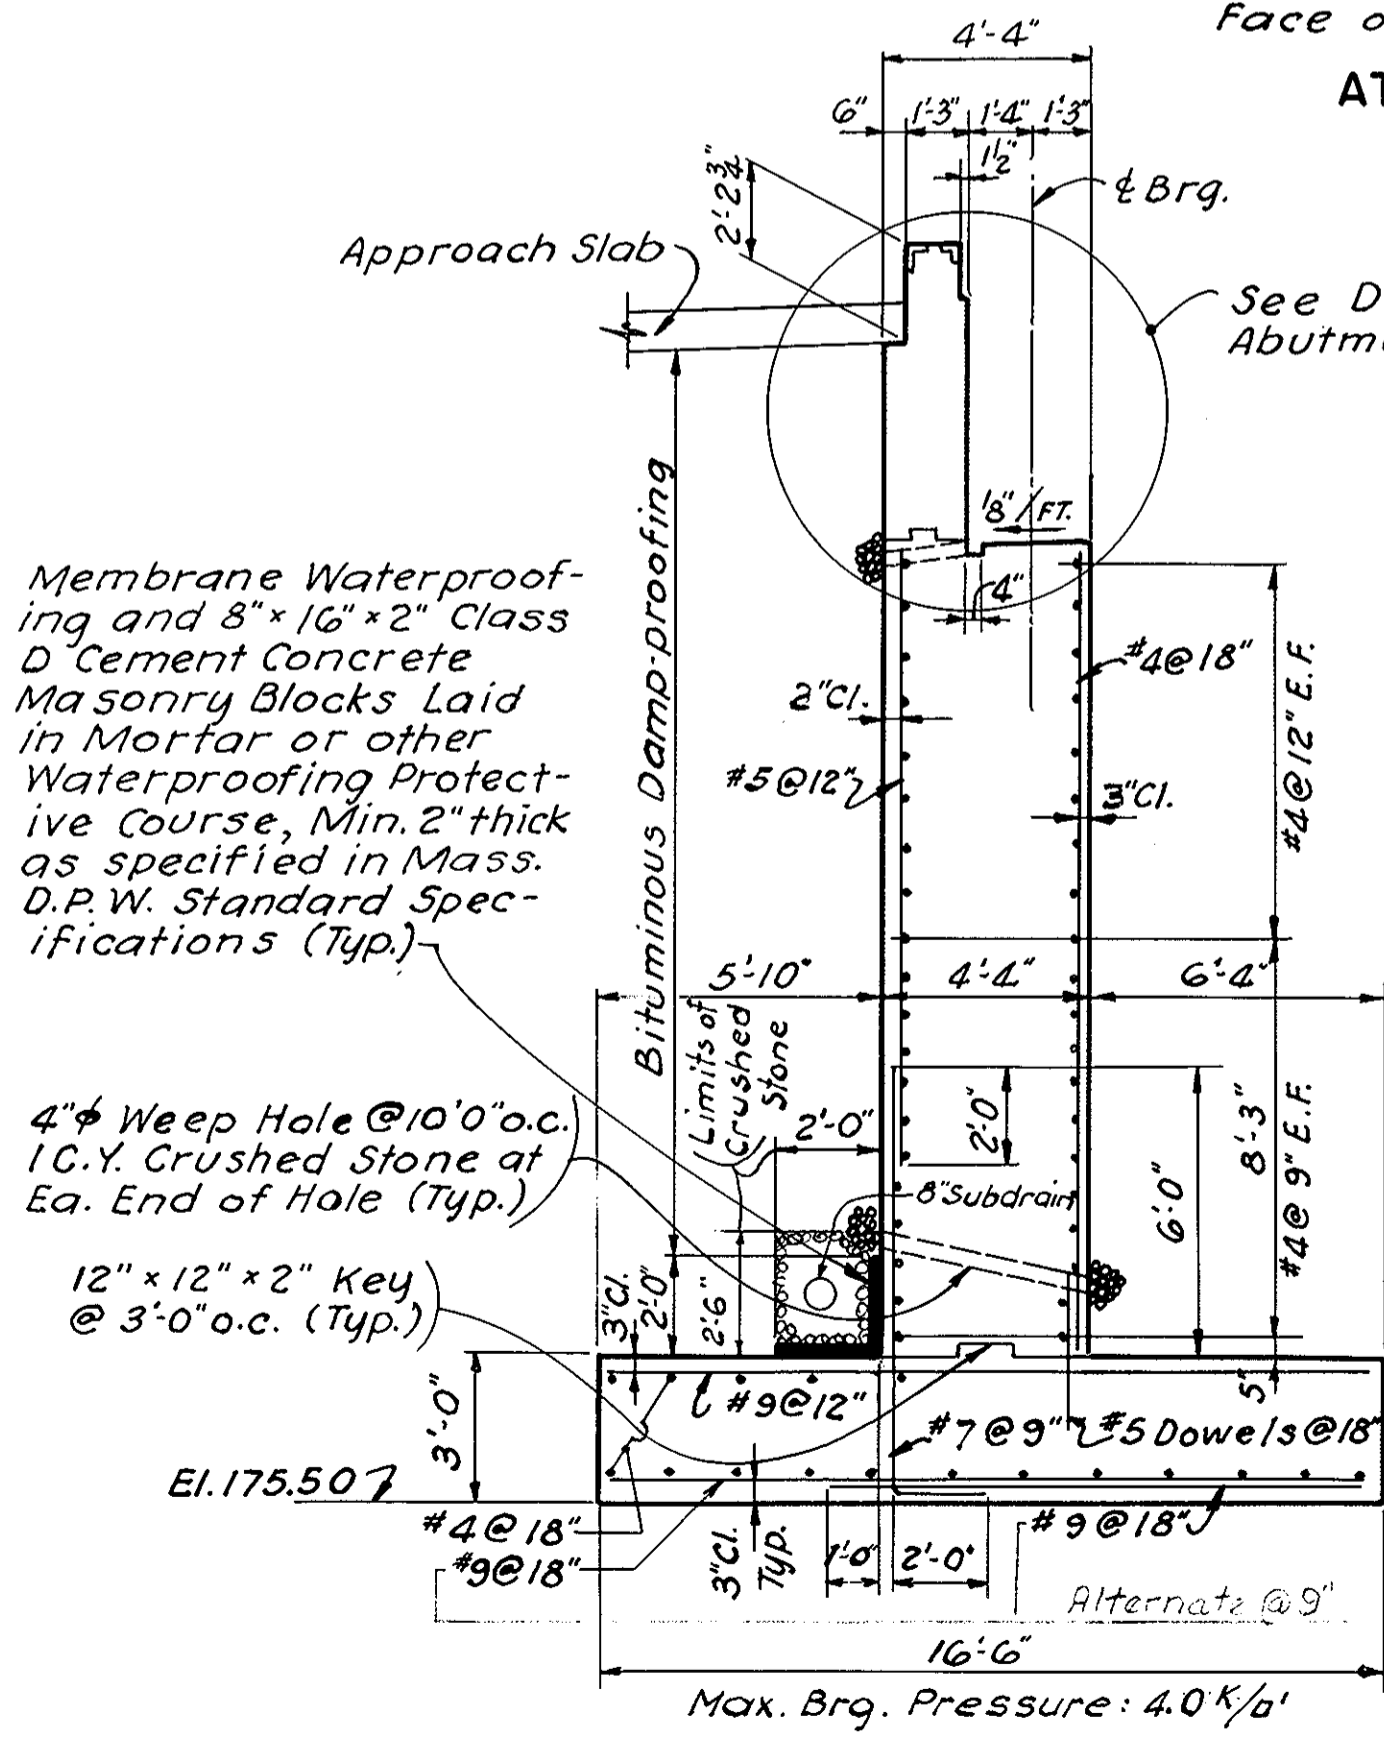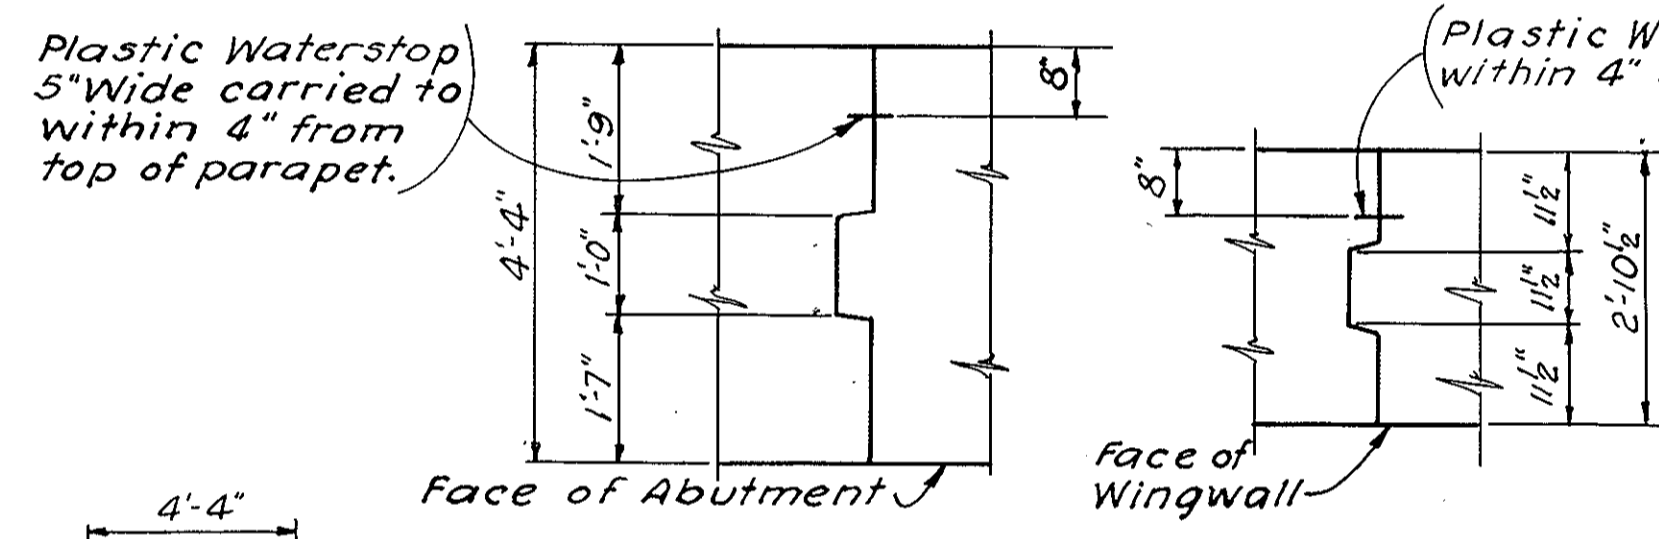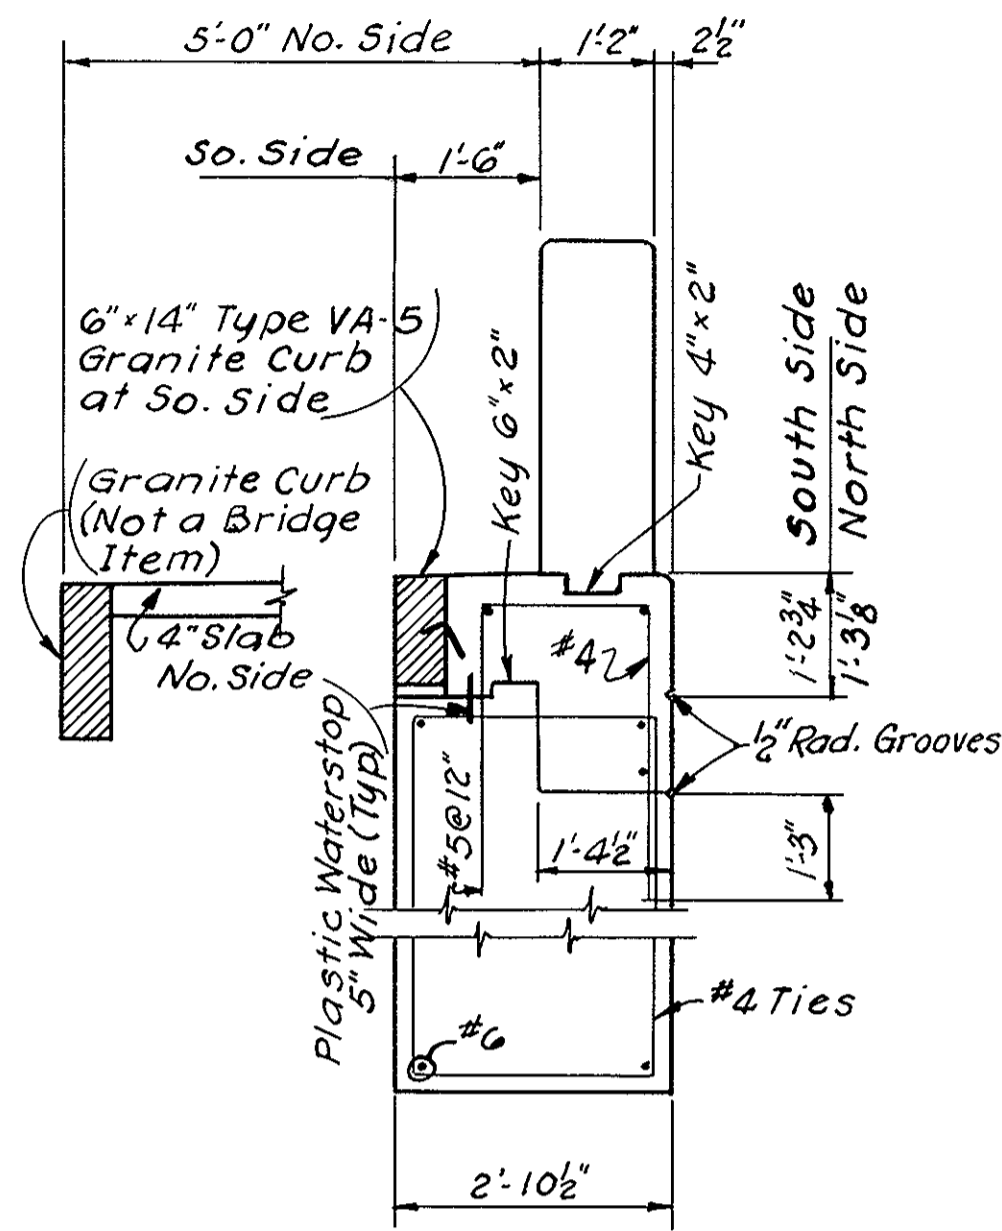


NOTE:  
All concrete shall be cement concrete masonry Class A except as otherwise noted

MARCH 25 1967	ISSUED FOR CONSTRUCTION
DATE	DESCRIPTION
USE ONLY PRINTS OF LATEST DATE	


PUB. NO.	STATE	FED. AID PROJ. NO.	FISCAL YEAR	SHEET NO.	TOTAL SHEETS
1	MASS	I-91-(64)9	1967	86	393

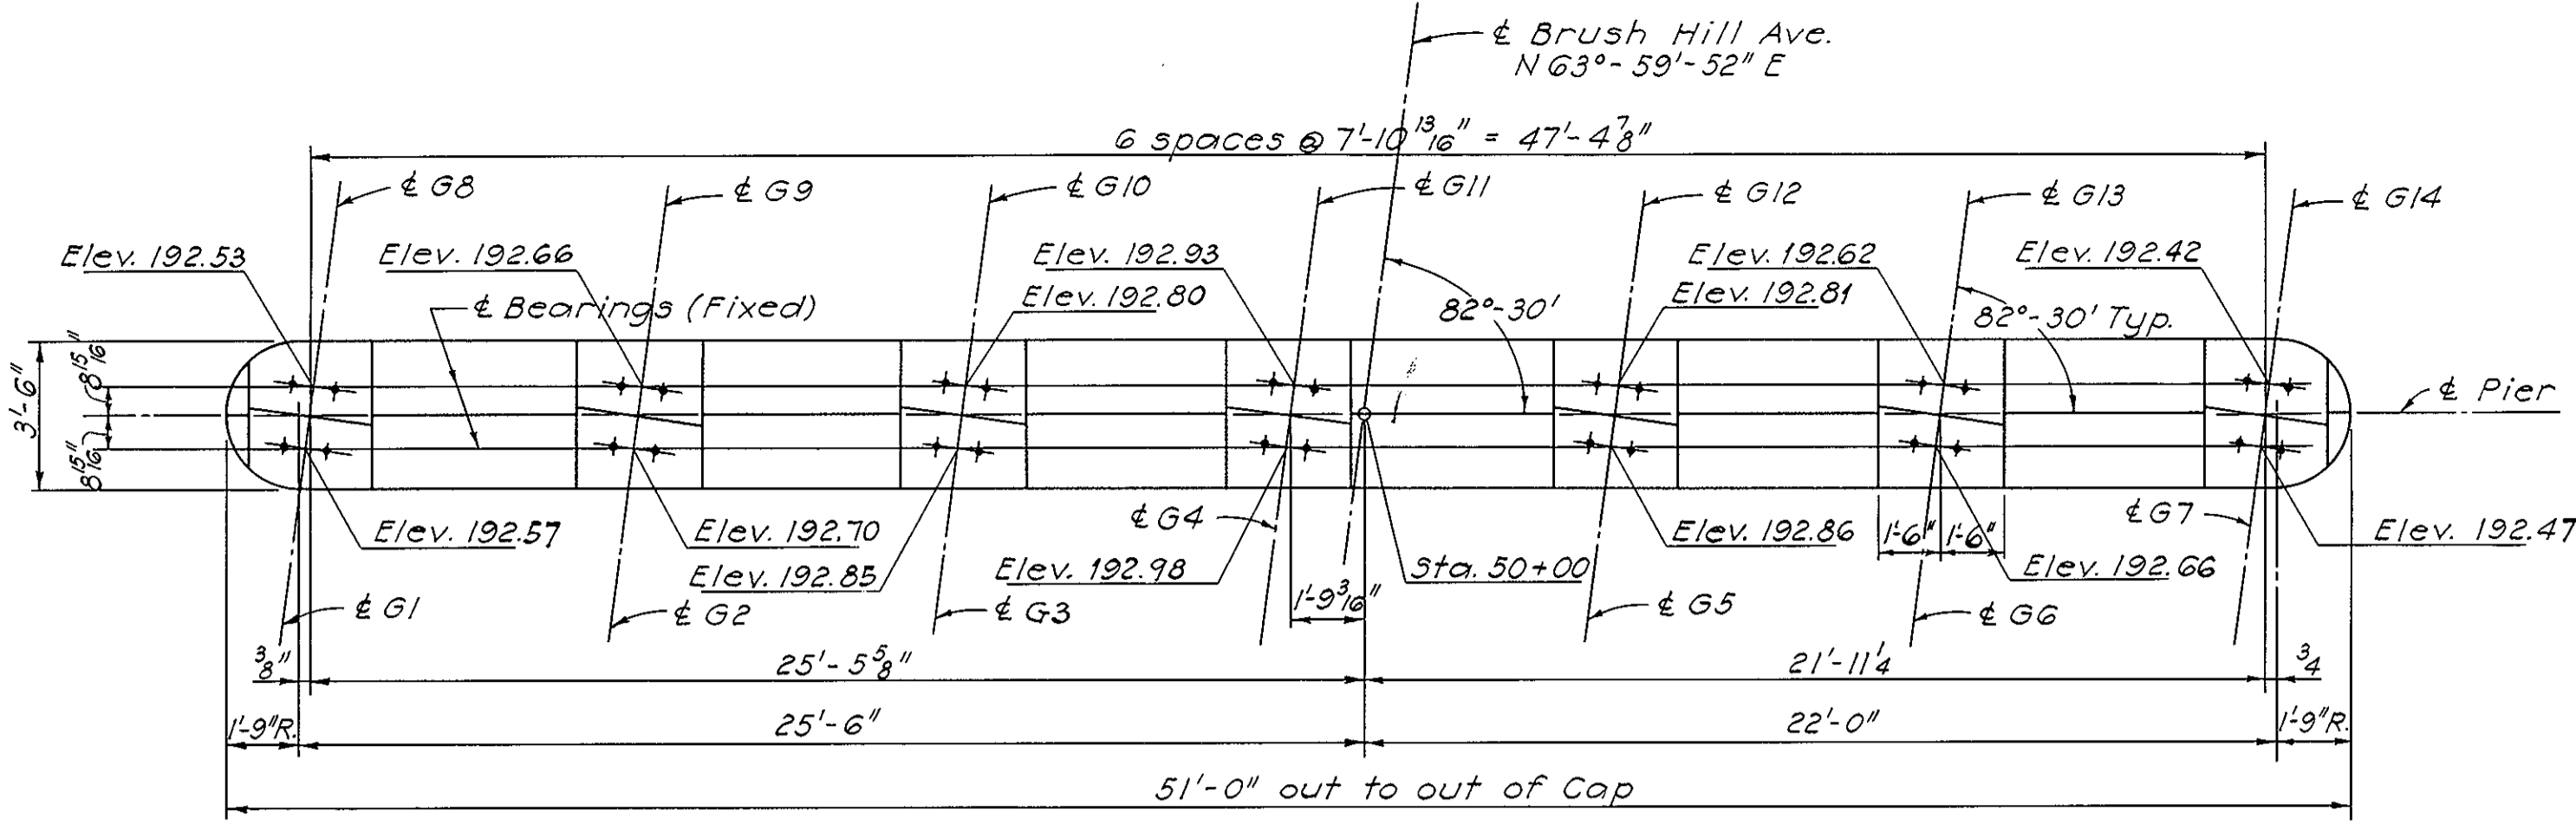

**PIER CAP PLAN**

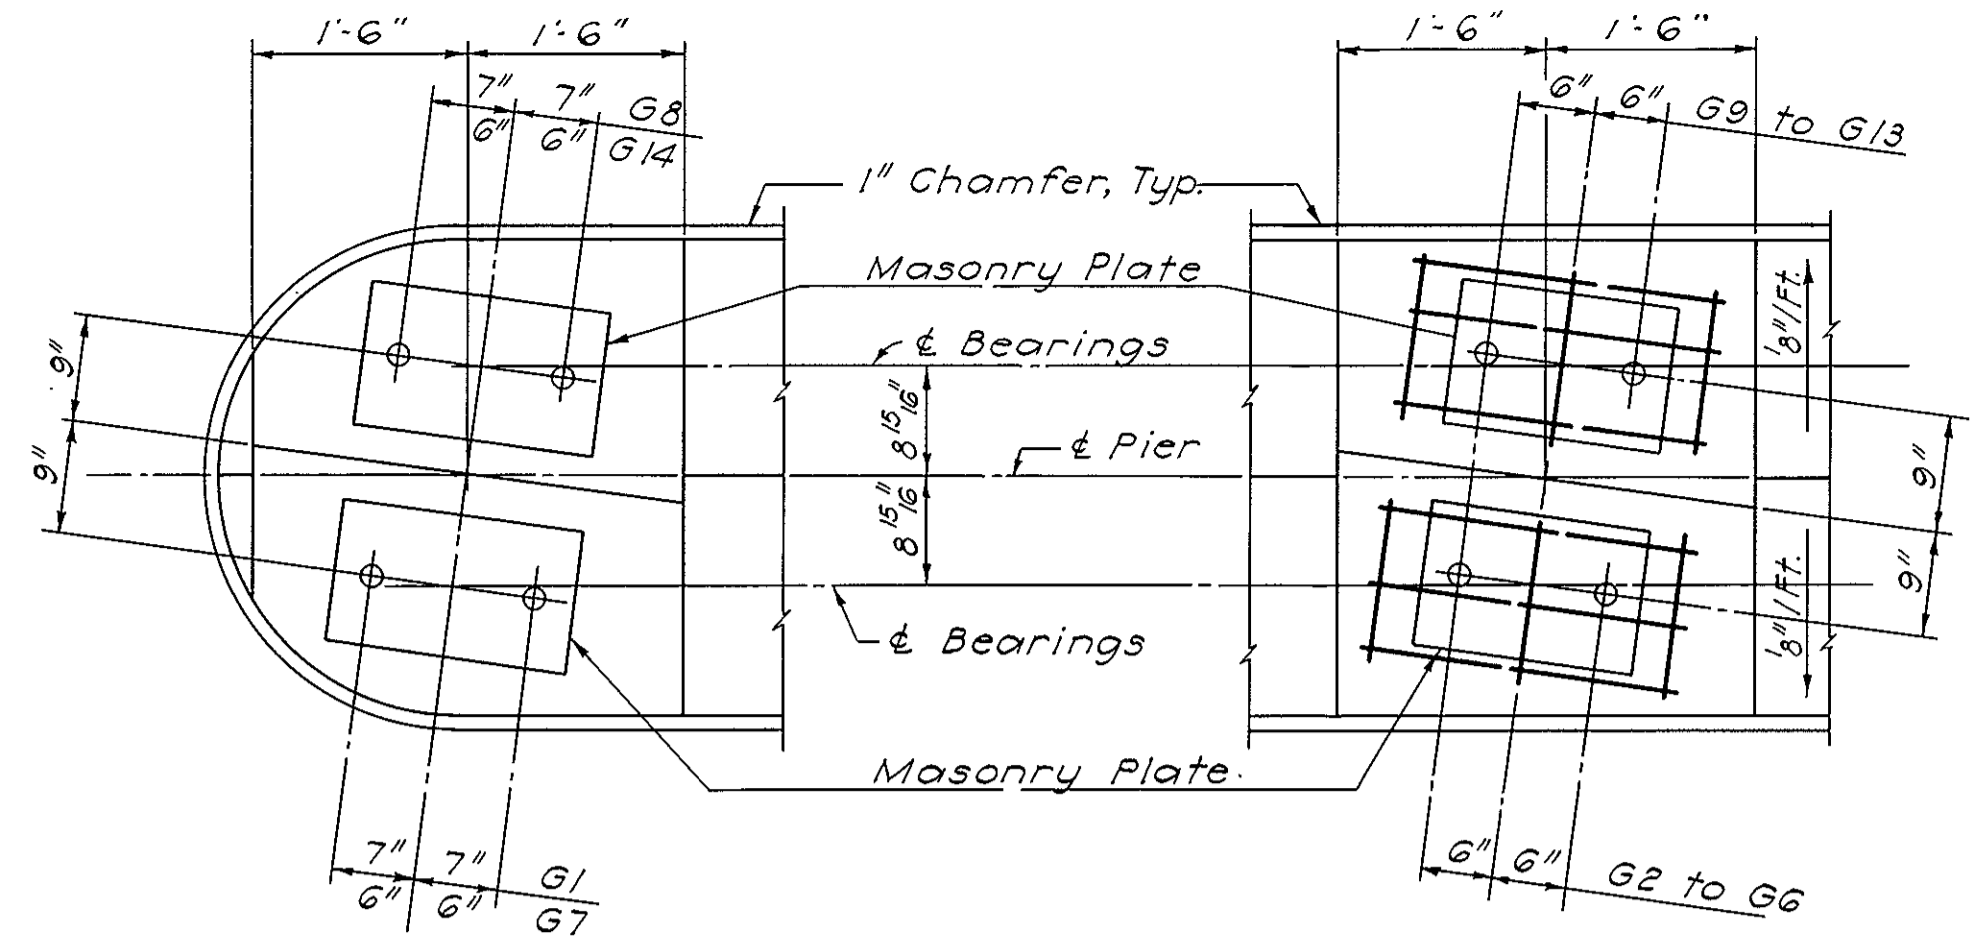


**FASCIA GIRDERS INTERIOR GIRDERS**

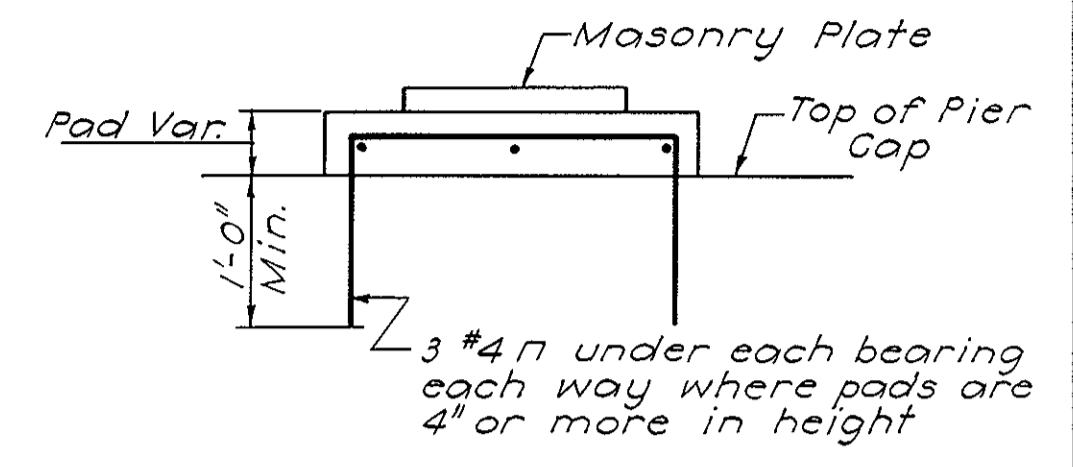

**PAD ELEVATION**

**PAD DETAILS**  
Scale: 3/4" = 1'-0"

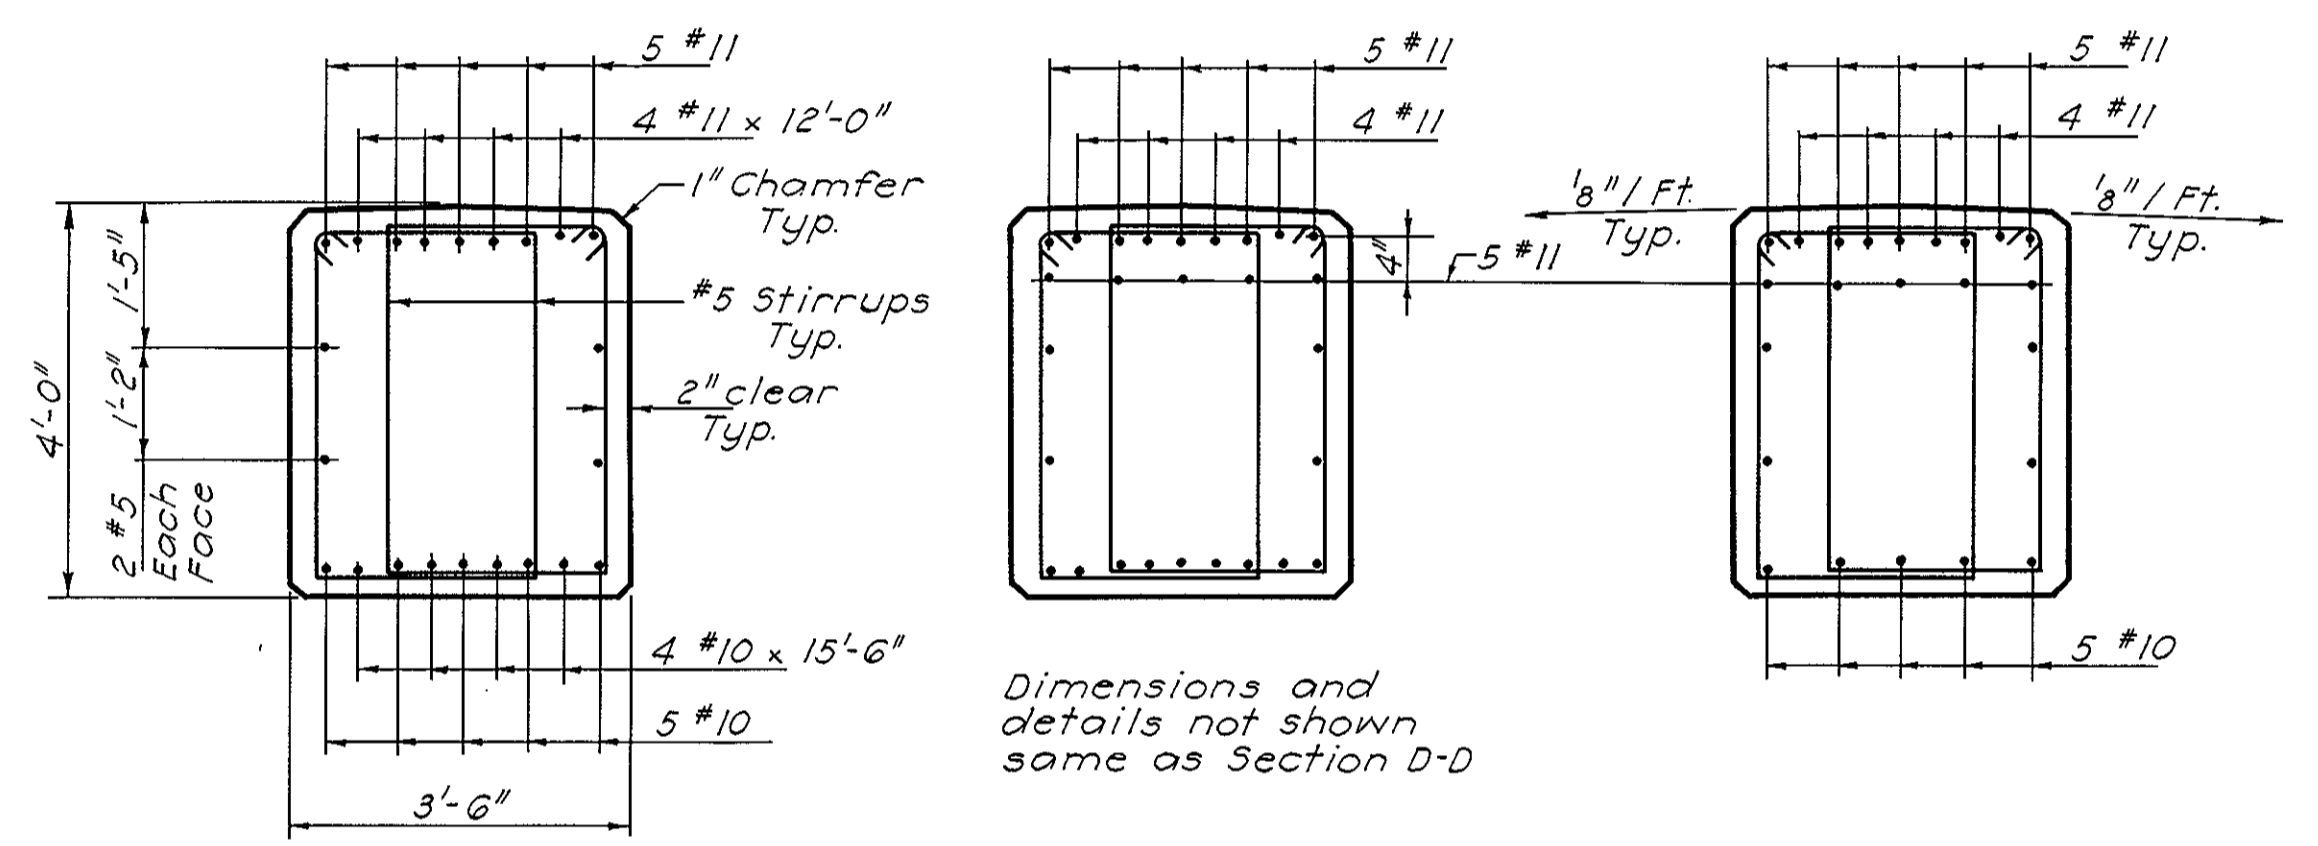


**SECTION D-D**

**SECTION E-E**


**SECTION F-F**

Scale: 1/2" = 1'-0"  
Top of Pier Cap to be sloped 1/8"/Ft from center to face between pads.

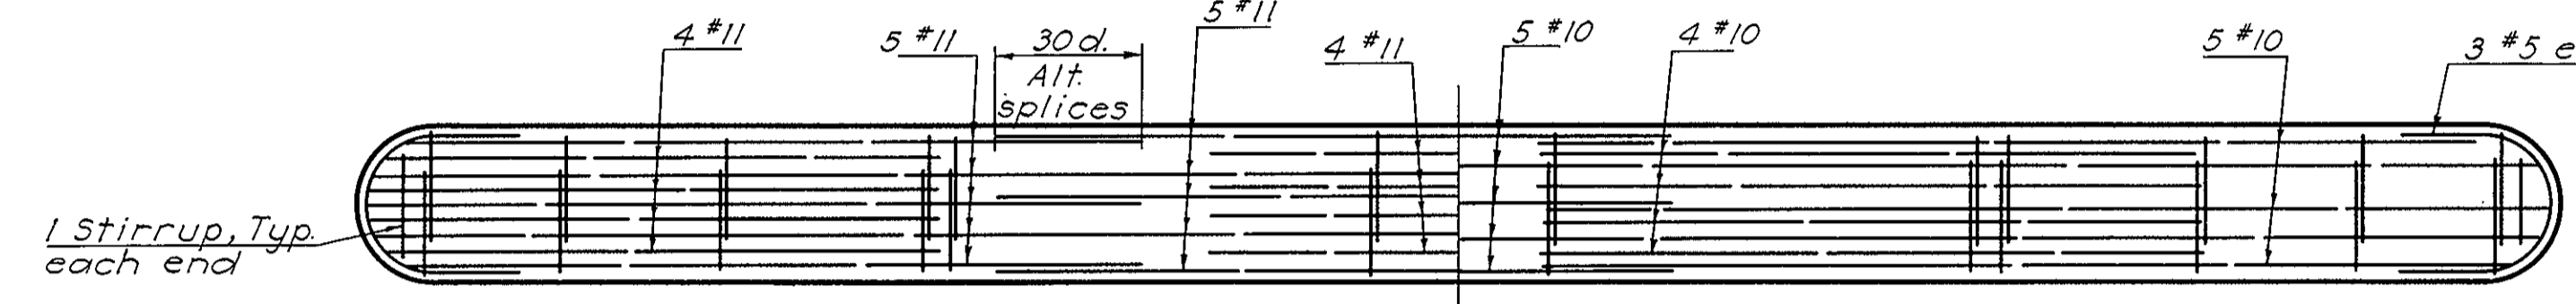


**SECTION A-A**

Note: At all columns, tie some of these bars loosely to permit insertion of vibrator. Secure fast after vibration is complete & before concrete is level with reinforcement.

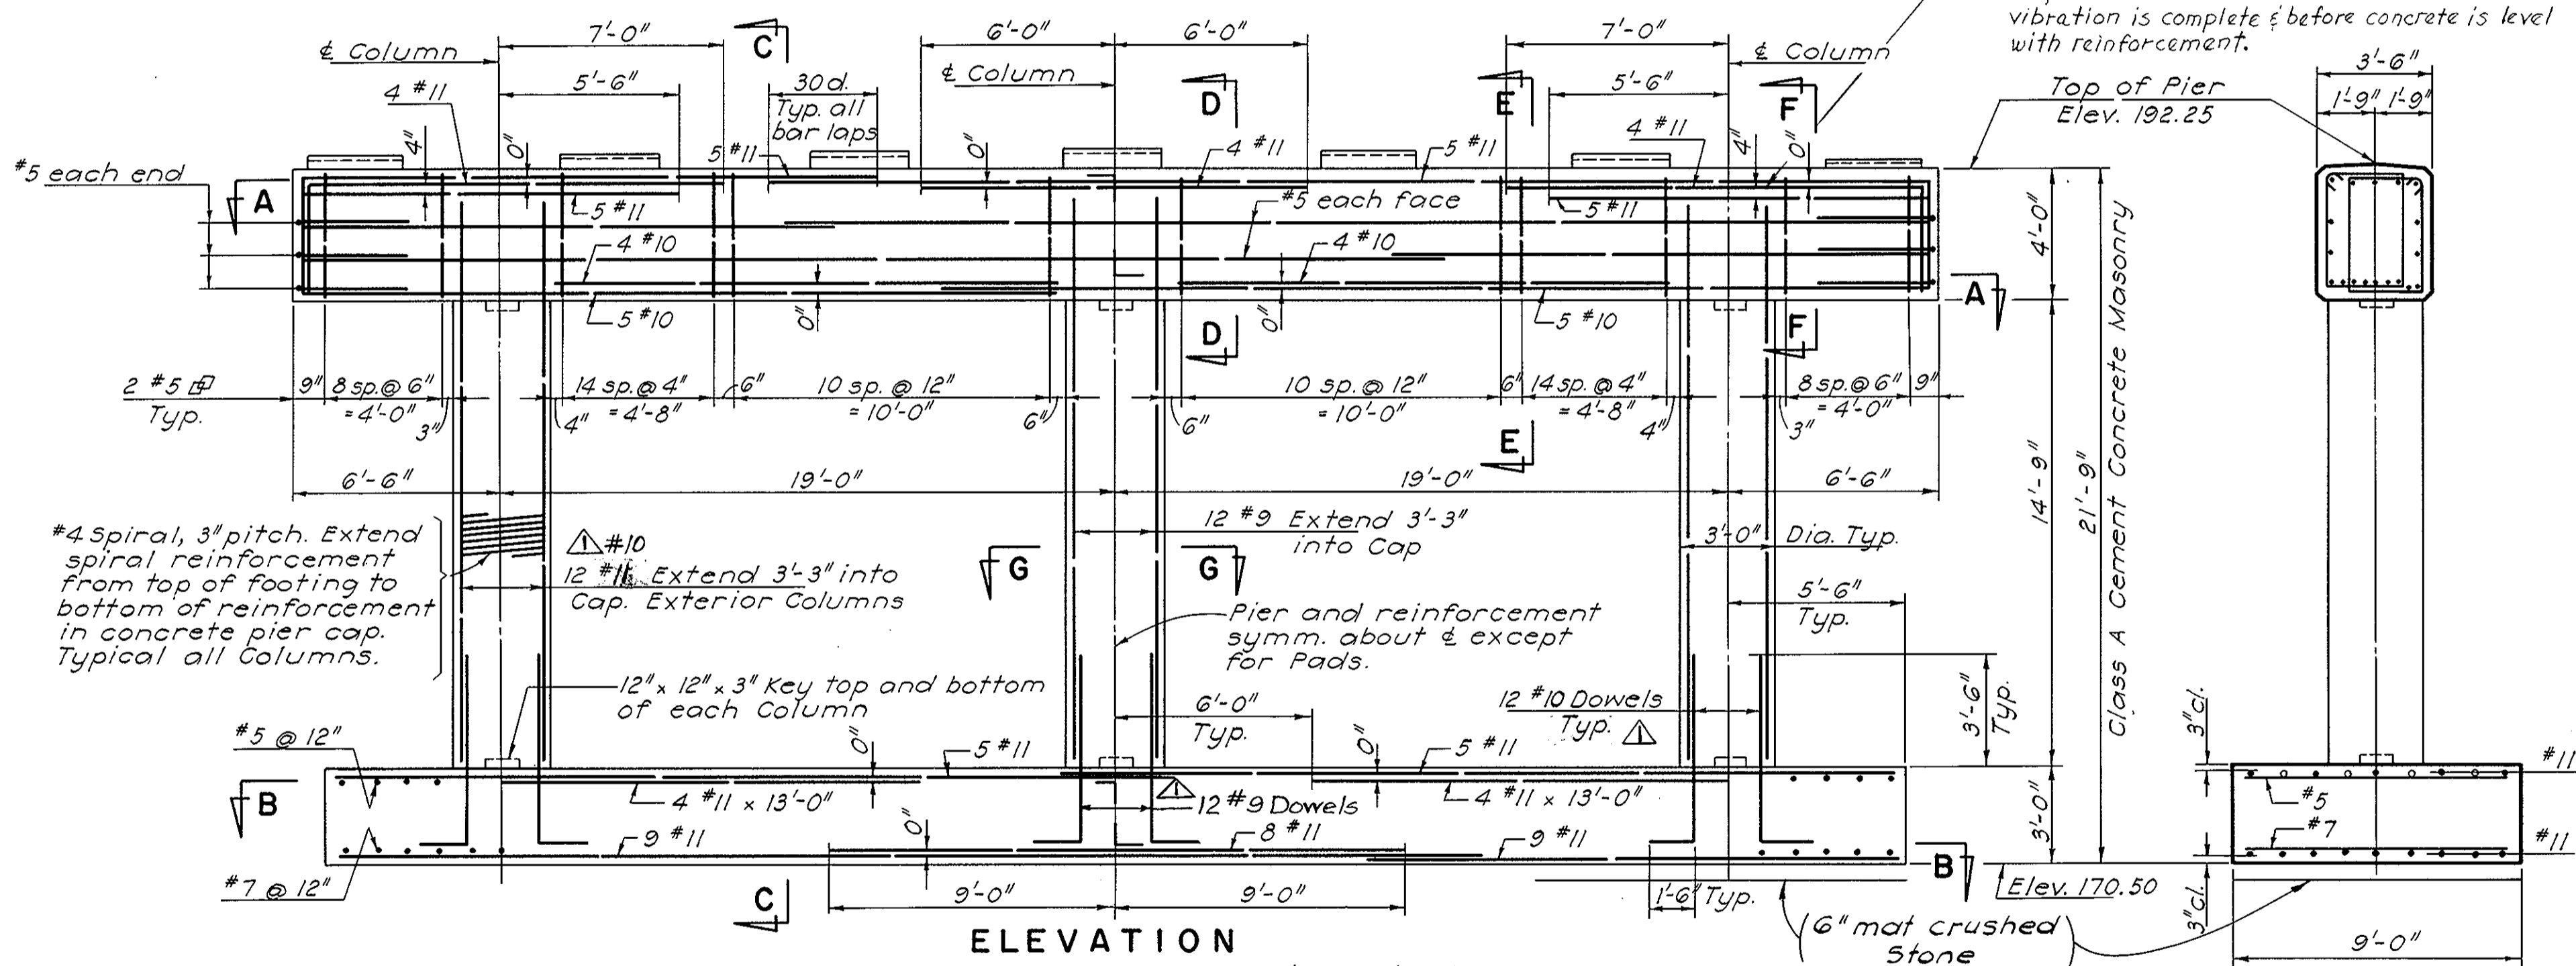


**ELEVATION**

**SECTION C-C**

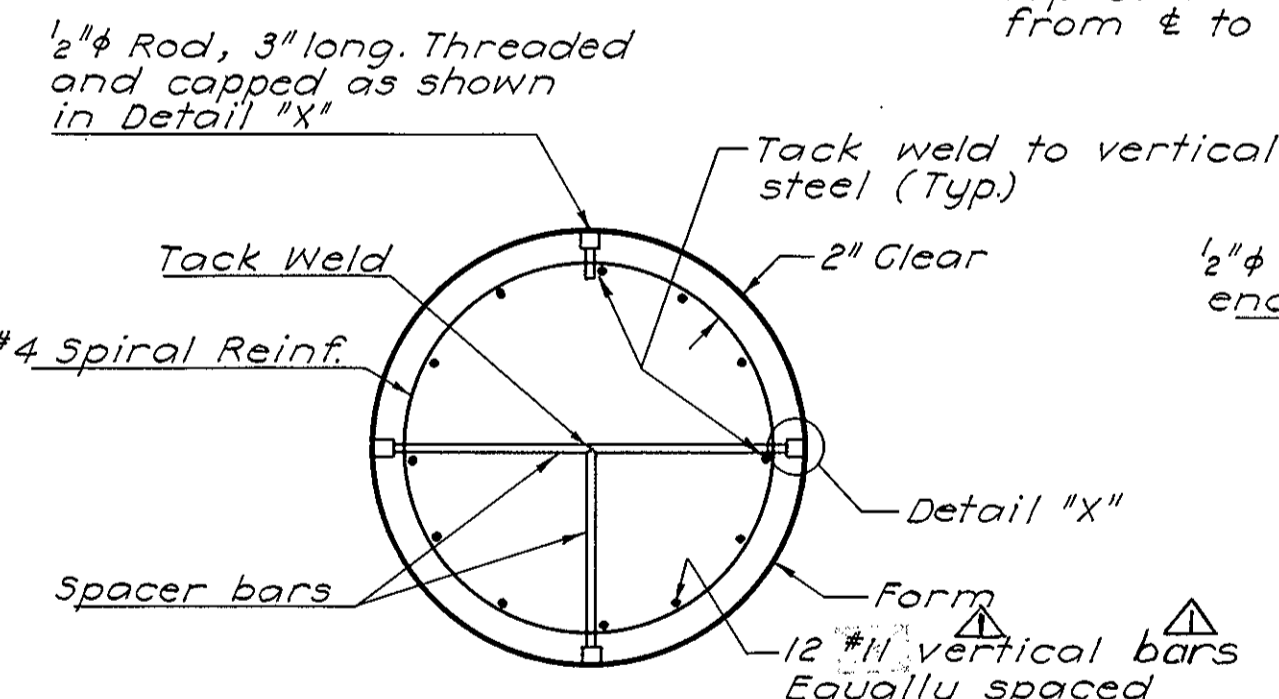


**SECTION G-G**  
Scale: 3/4" = 1'-0"

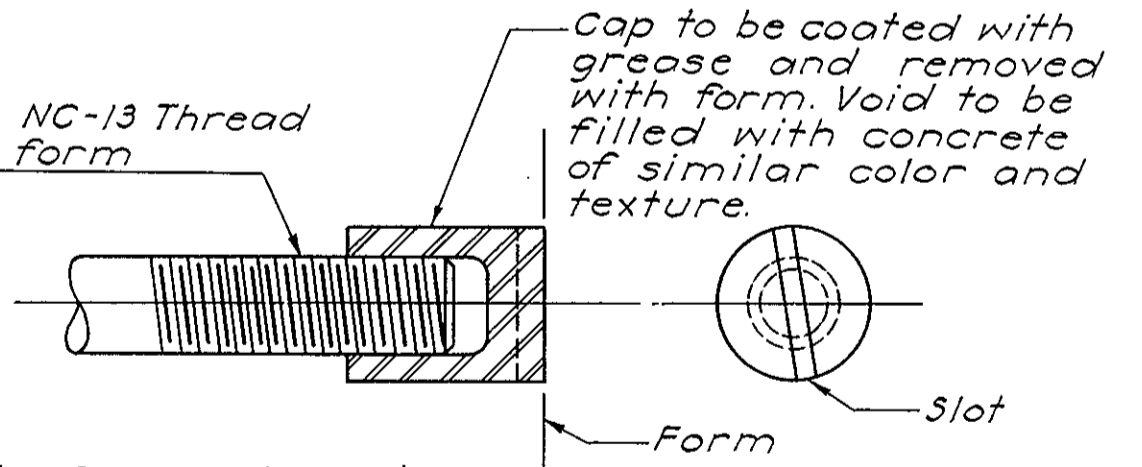

**END OF CAP**

**DETAIL X**  
N.T.S.

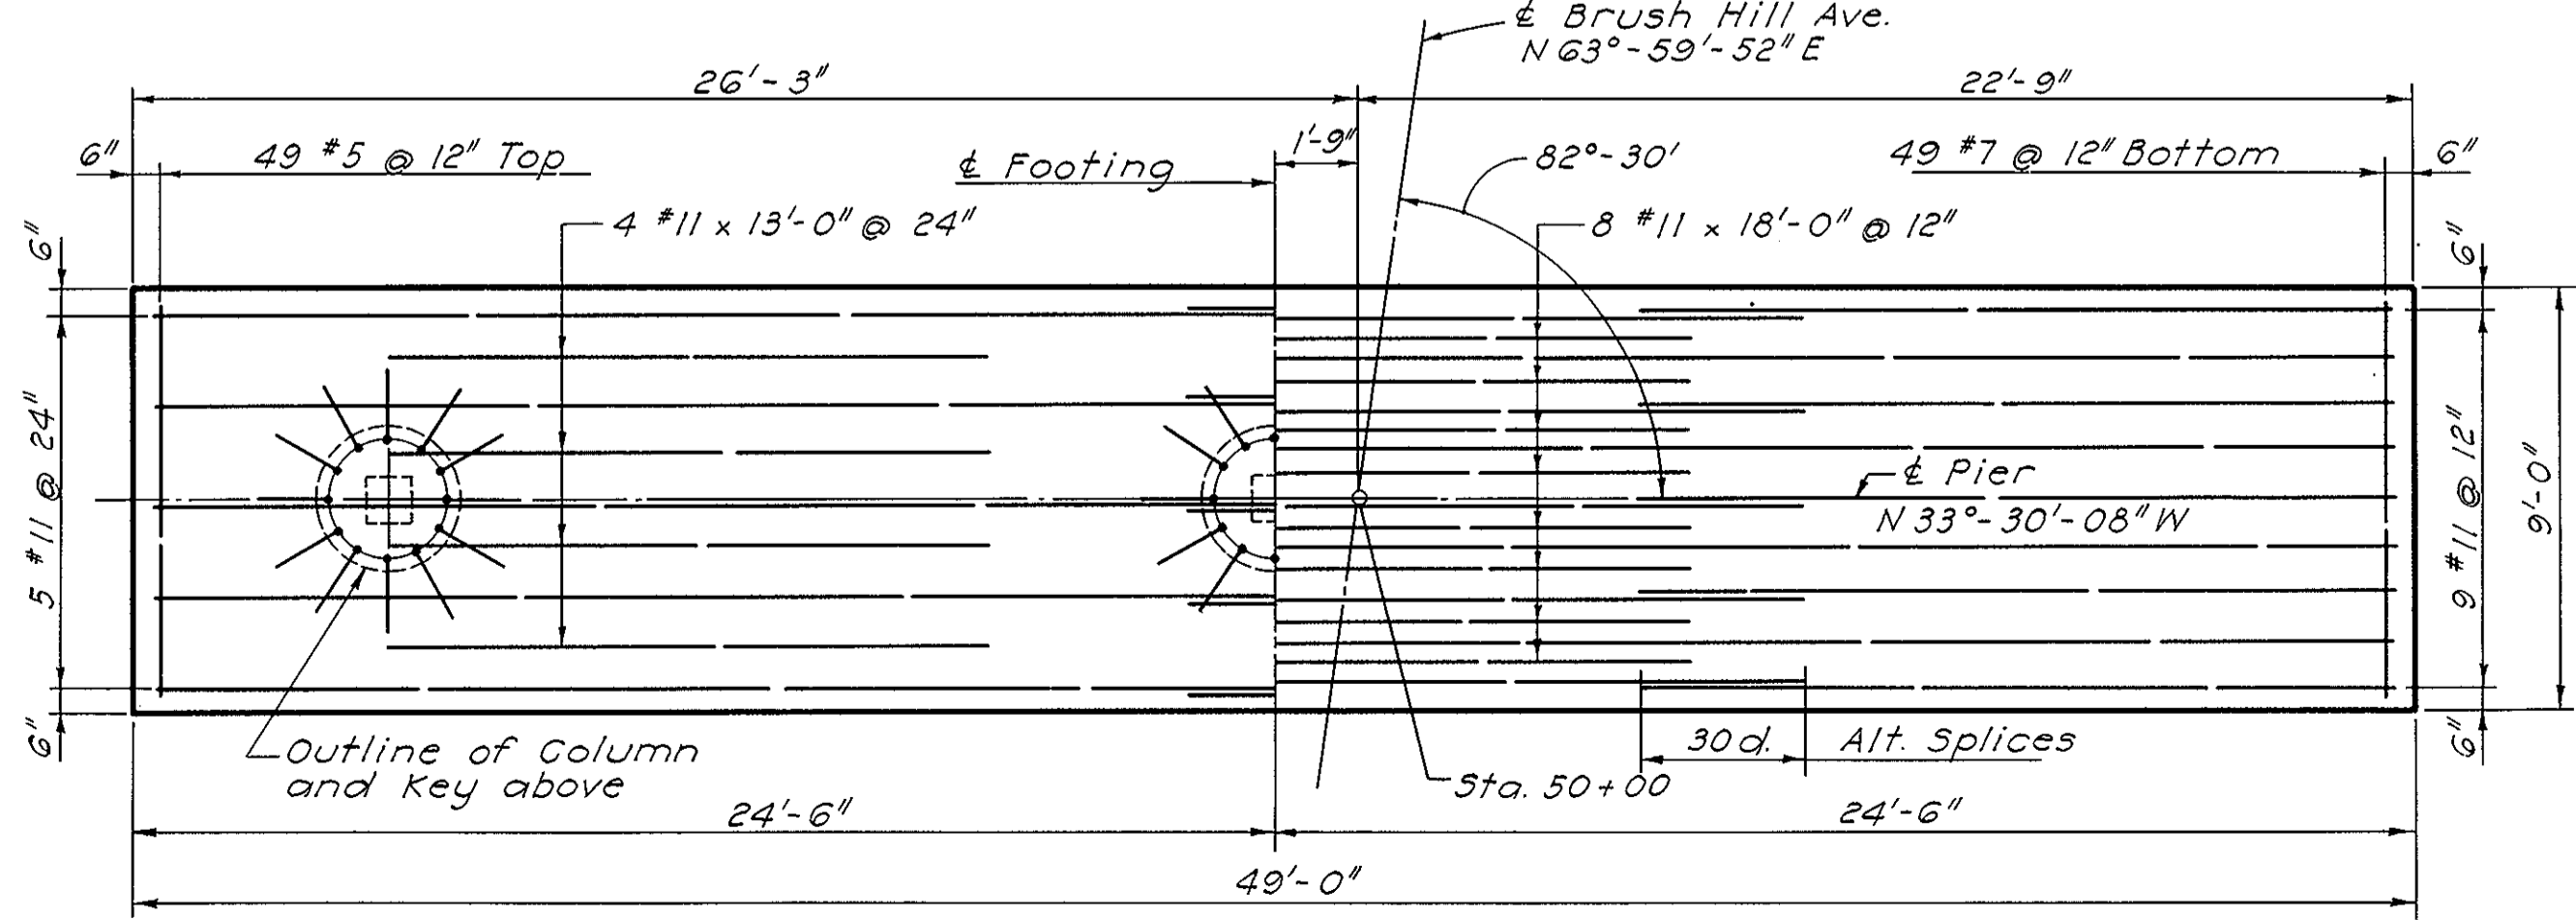


**SECTION B-B**  
Scale: 1/4" = 1'-0"

Notes:  
For bearing and anchor bolt details see Sheet 10.  
Contractor shall place reinforcement to clear all anchor bolts.  
All exposed edges of concrete to have a 1" chamfer unless otherwise shown.  
All keys to be slightly tapered.  
All forms to be stripped as prescribed in the Specifications.  
Maximum Design Bearing Pressure = 4.24 Kips/Sq. Ft.  
Tie some of the top bars in the pier cap loosely to permit insertion of vibrator. Fasten securely after vibrating & before conc. is level with reinf.


DATE	DESCRIPTION
JULY 13, 1967	Reinf. bar changes, lettering added & deleted
MARCH 25, 1967	ISSUED FOR CONSTRUCTION
DATE	DESCRIPTION
USE ONLY PRINTS OF LATEST DATE	

PUB. RD. DIV. NO.	STATE	FED. AID PROJ. NO.	FISCAL YEAR	SHEET NO.	TOTAL SHEETS
1	MASS	I-91-(64)9	1967	87	393

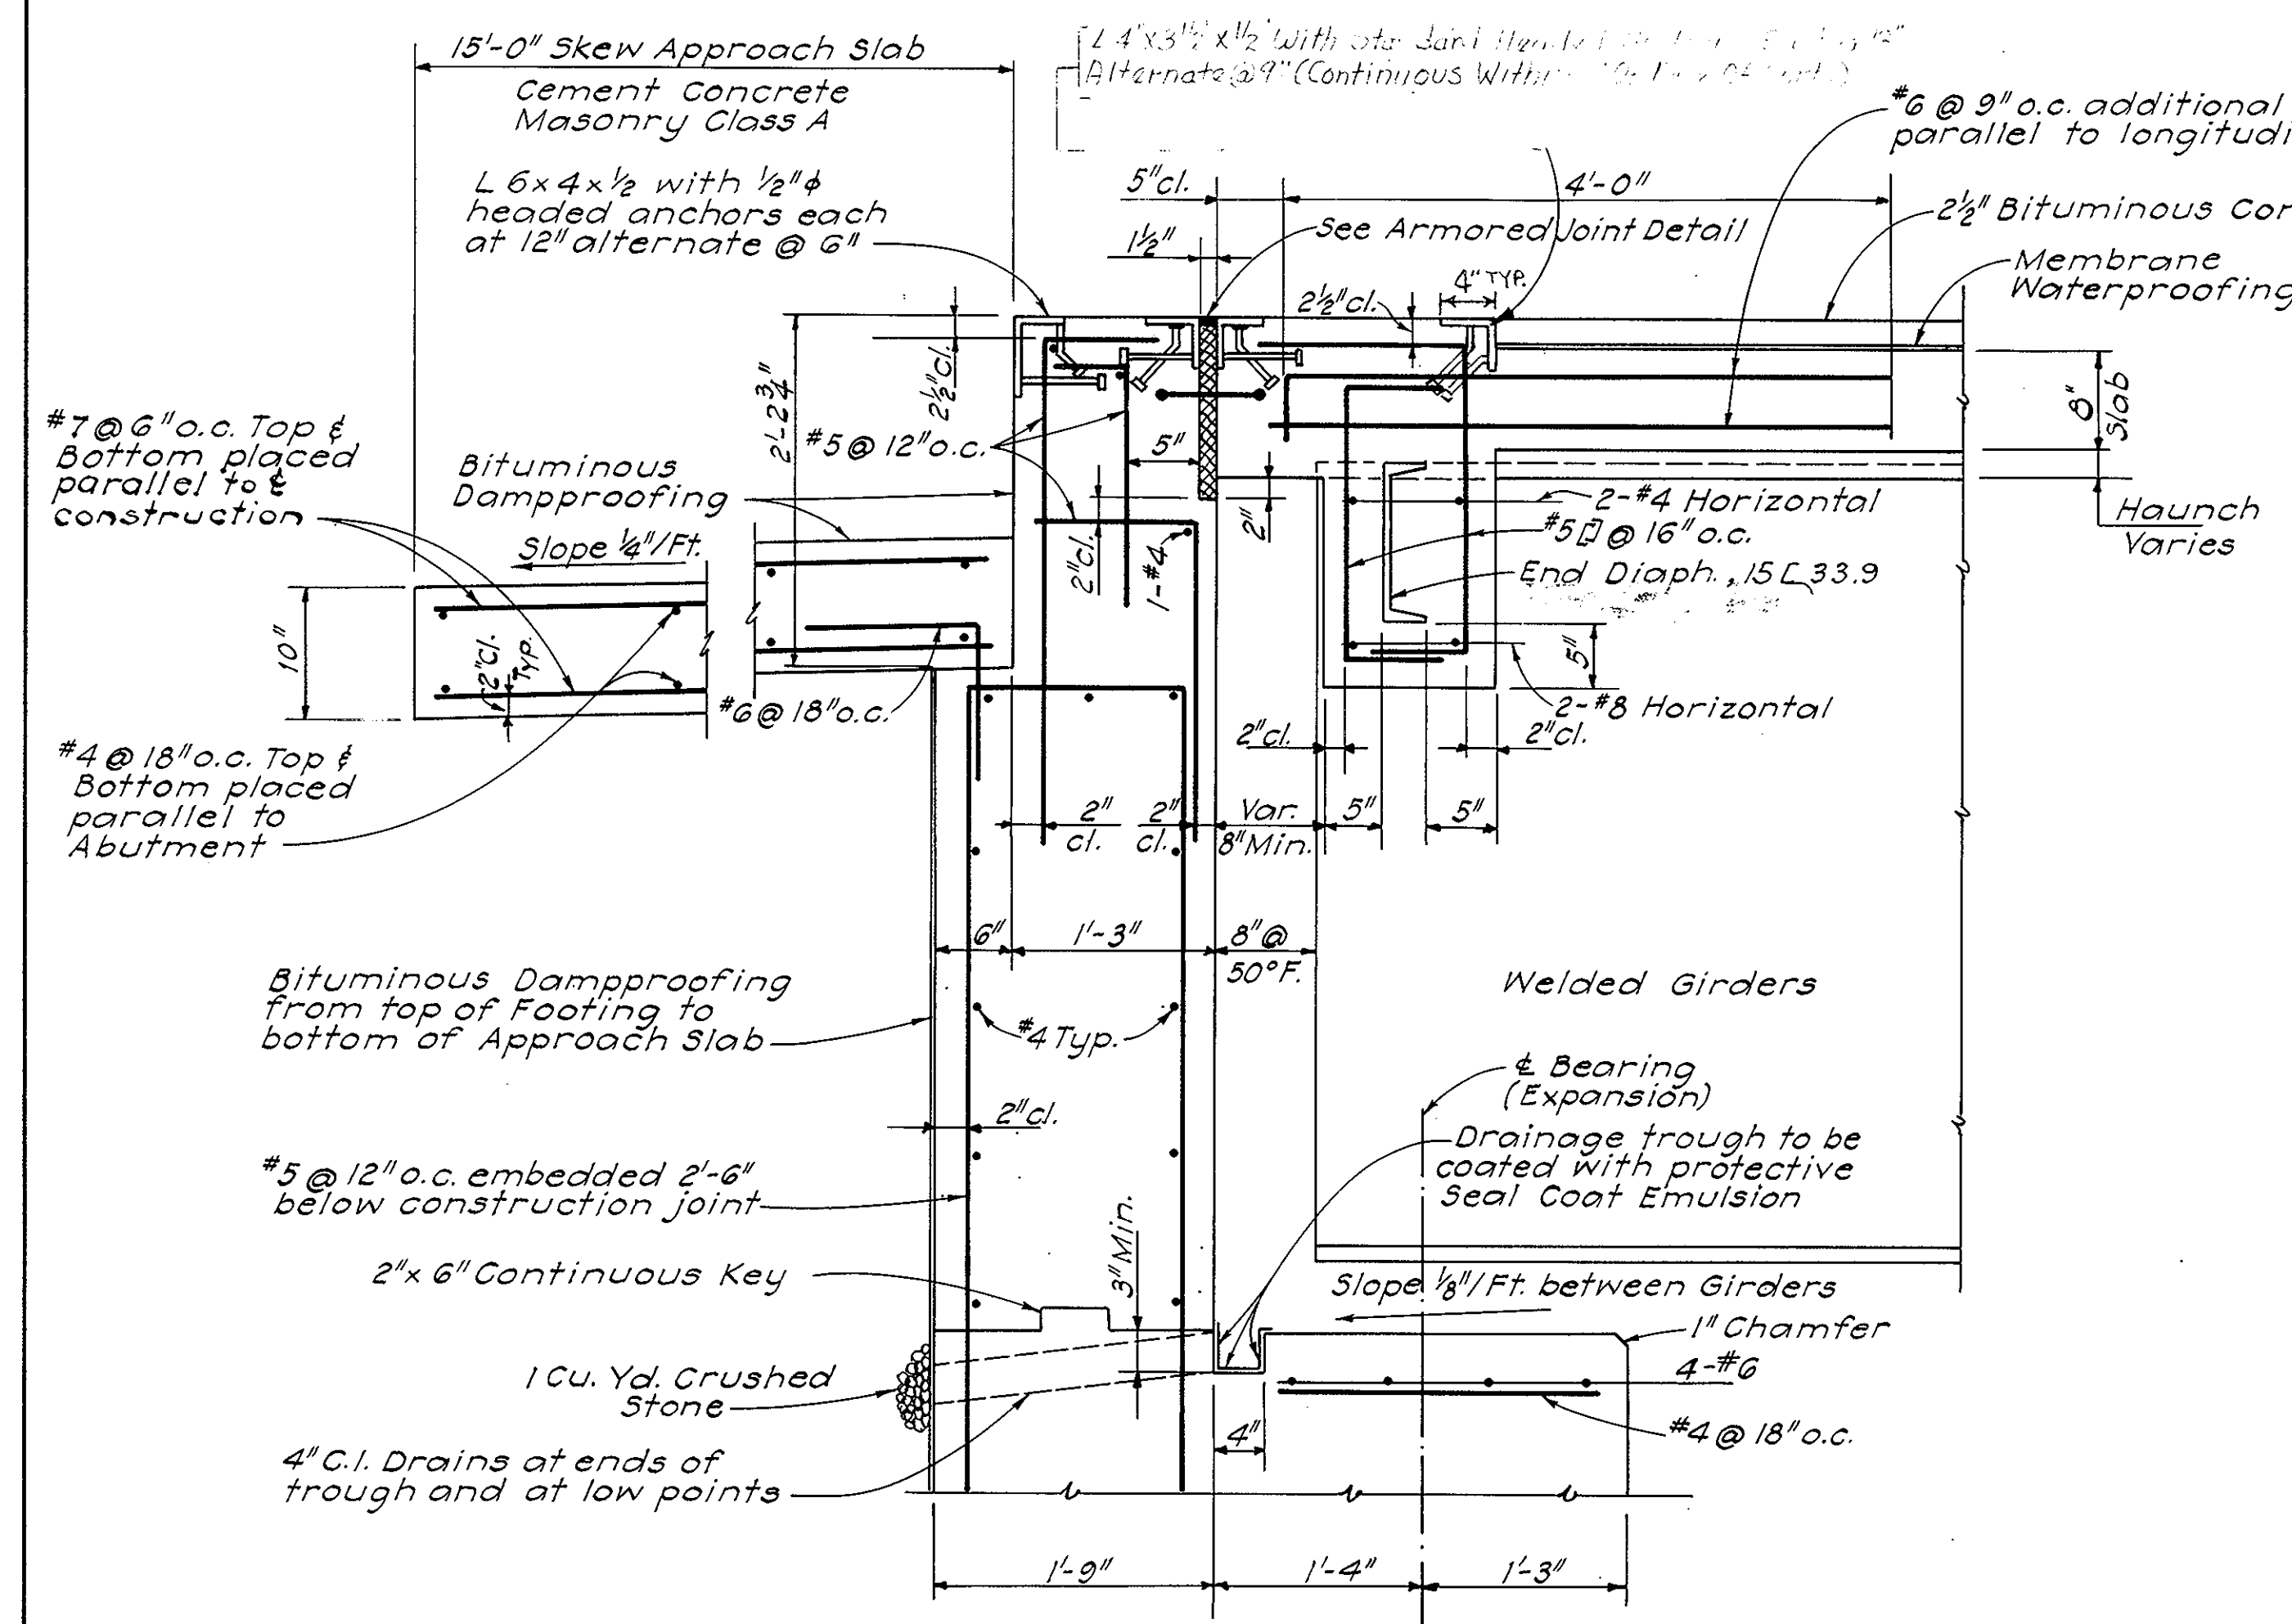


**DETAIL AT ABUTMENTS**  
Scale: 1" = 1'-0"

Note: All dimensions shown are square distances except as noted. For Abutment Details see Sheets 5 and 6.

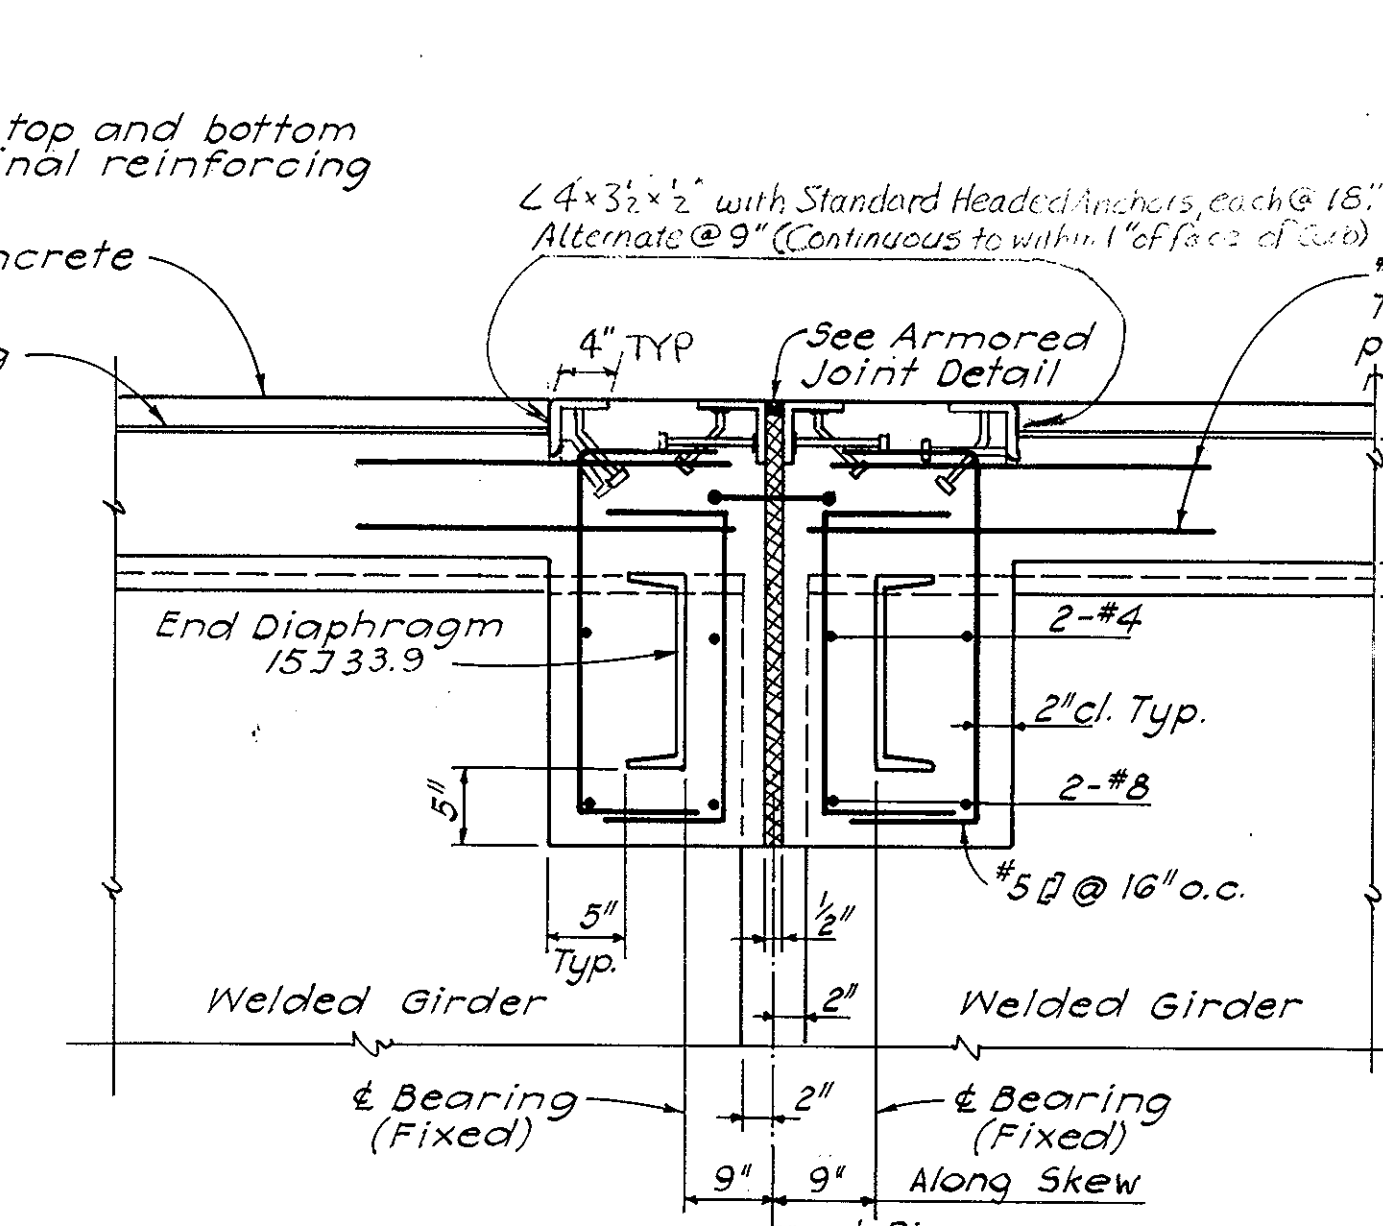


**DETAIL AT PIER**  
Scale: 1" = 1'-0"

All dimensions shown are square distances, except as noted.

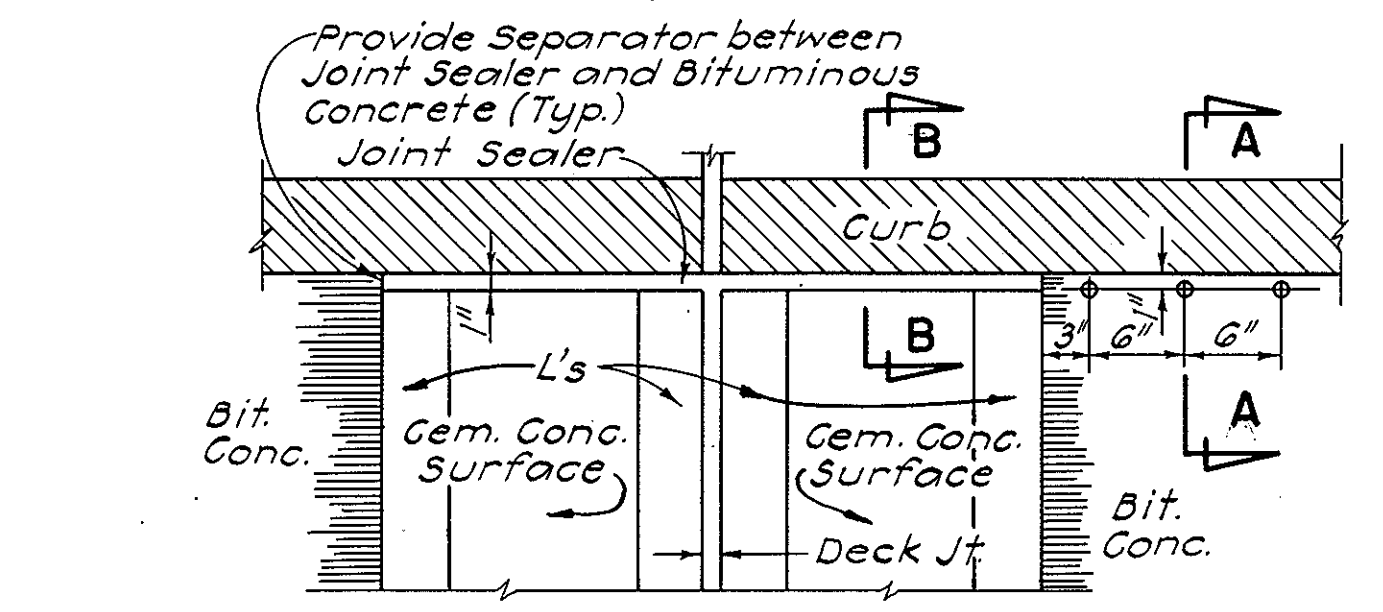


**PLAN**

Provide Separator between Joint Sealer and Bituminous Concrete (Typ.)

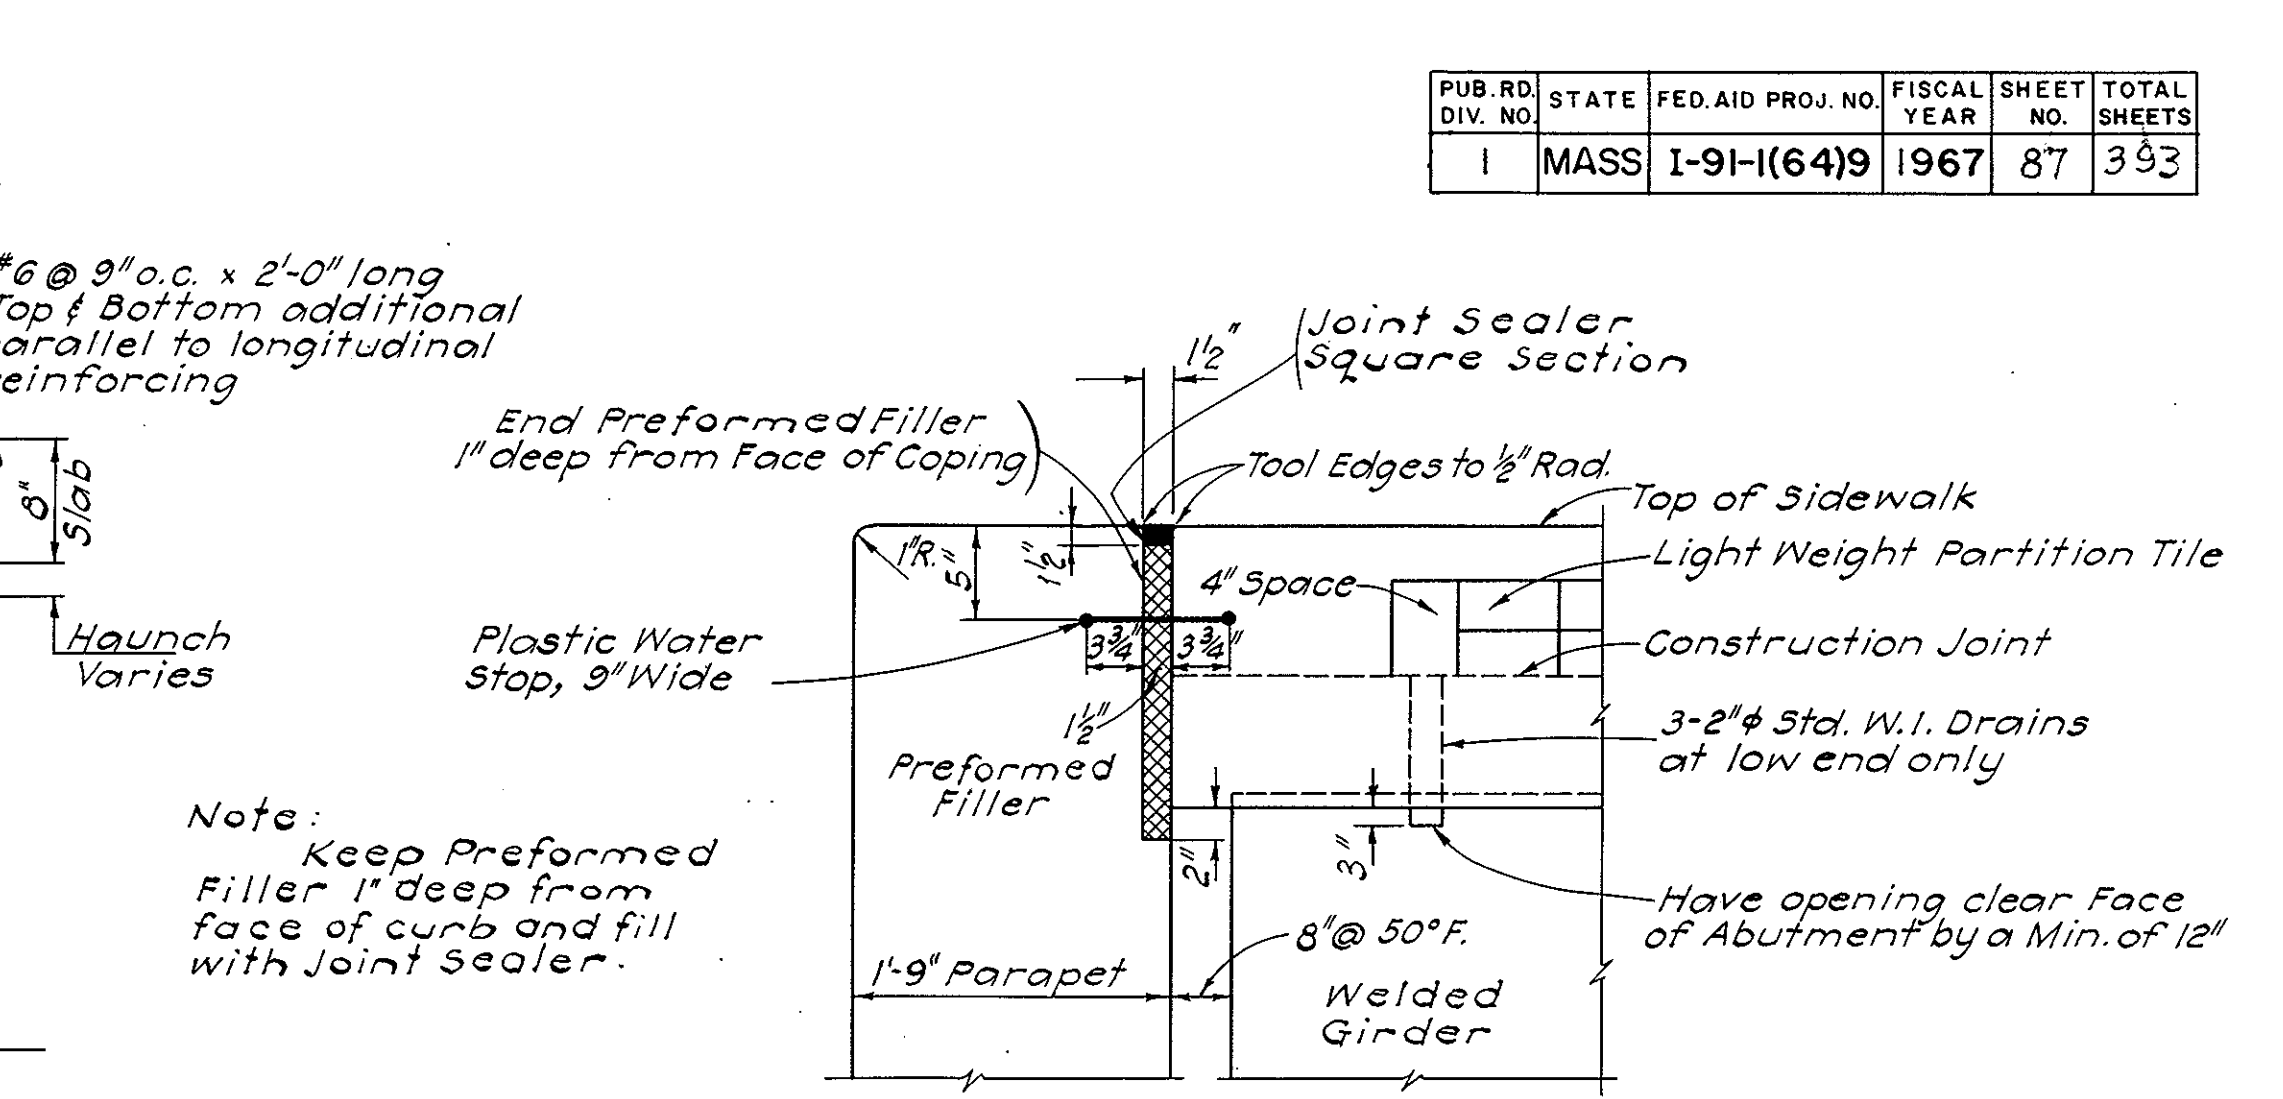


**SIDEWALK SECTION AT ABUTMENT**  
Scale: 1" = 1'-0"

Note: Keep Preformed Filler 1" deep from face of coping and fill with Joint Sealer.

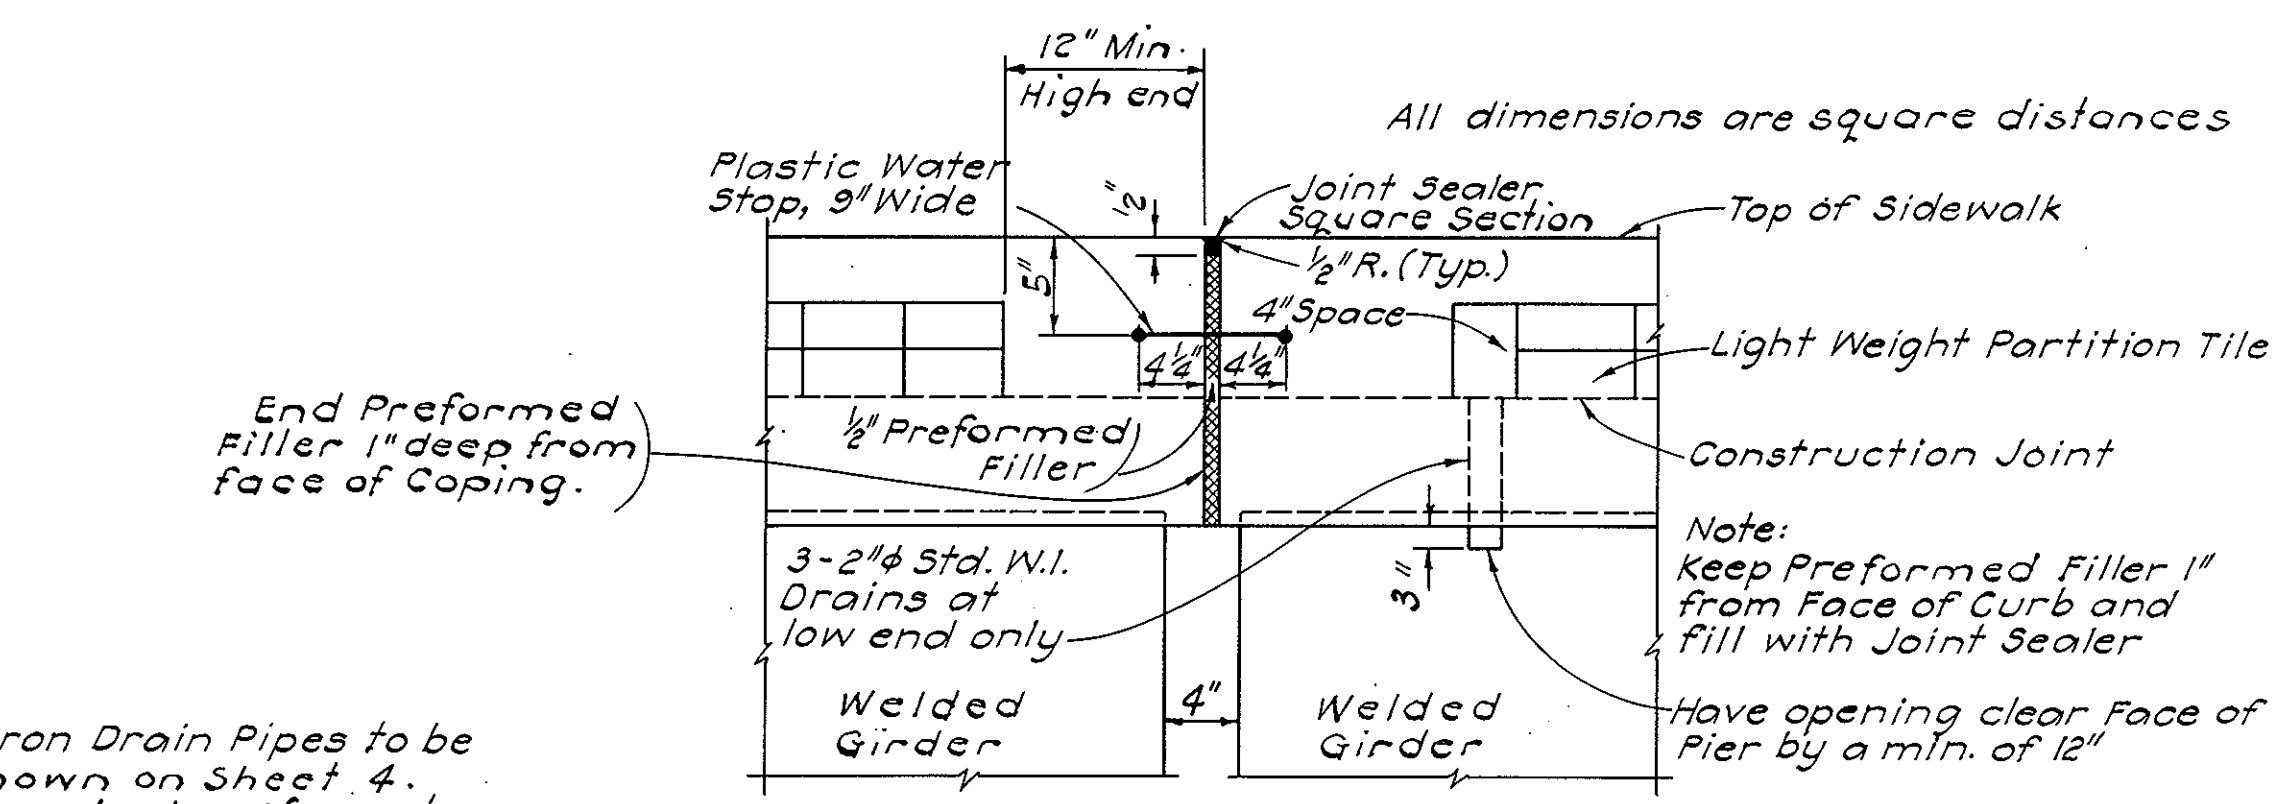


**SIDEWALK SECTION OVER PIER**  
Scale: 1" = 1'-0"

Note: Keep Preformed Filler 1" from Face of Curb and fill with Joint Sealer. Have opening clear Face of Pier by a min. of 12"

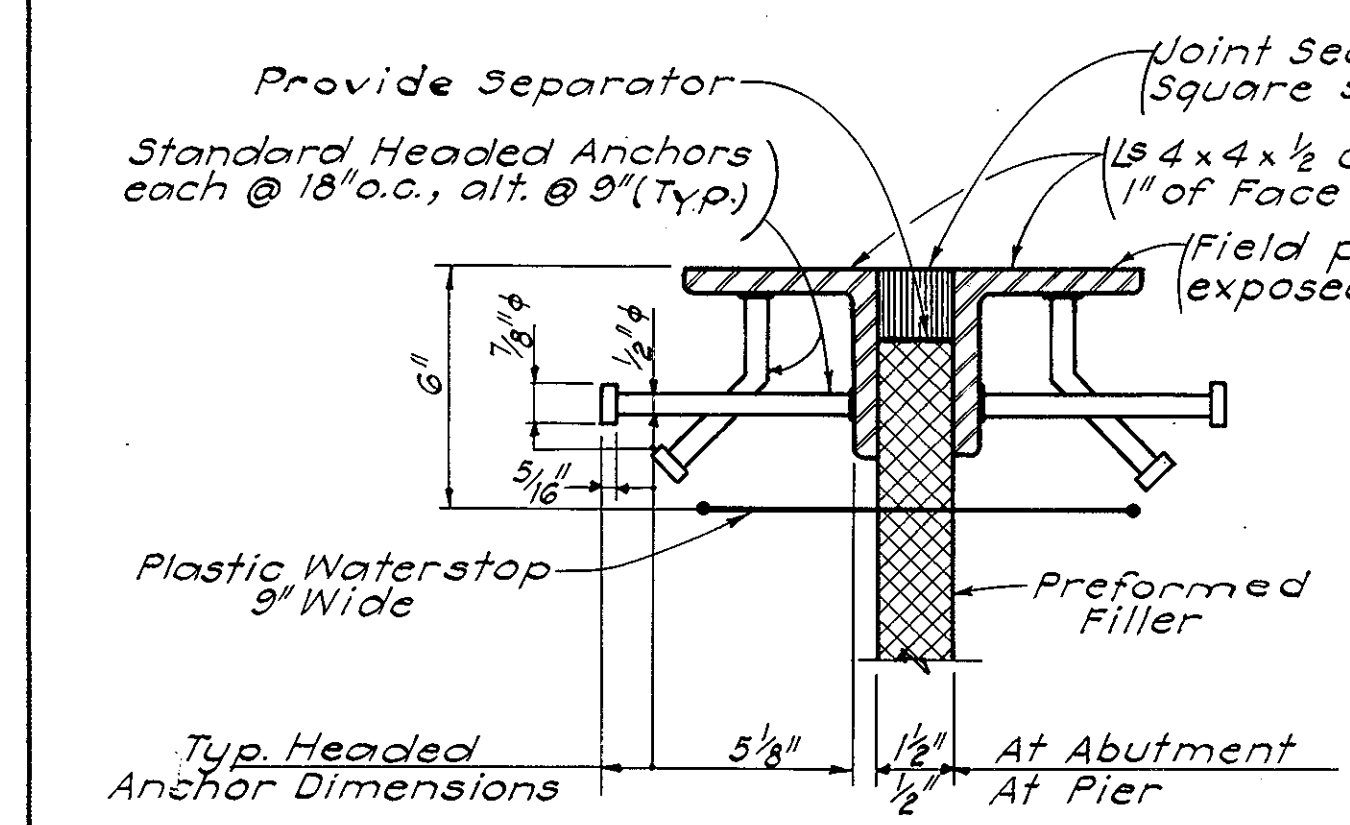


**ARMORED JOINT DETAIL**  
Scale: 3" = 1'-0"

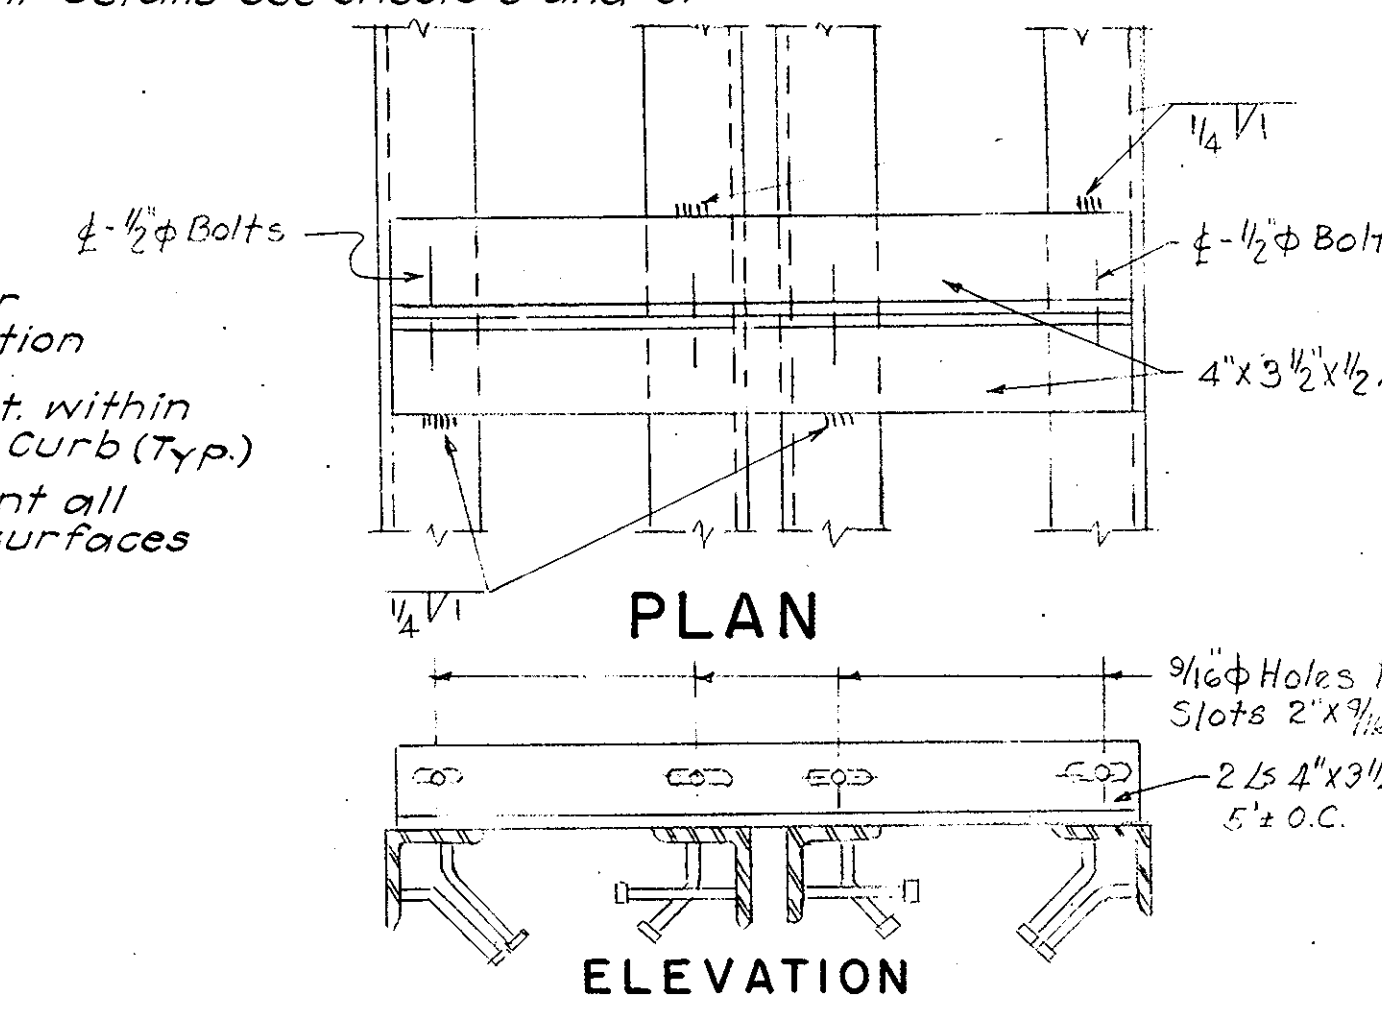


**SHIPPING DEVICE FOR ARMORED JOINT ASSEMBLY**  
Scale: 1 1/2" = 1'-0"

Notes:  
(A) All Armored Joint Assemblies must be properly fitted in shop and shipped with device for maintaining proper spacing and fit.  
(B) Bolts on shipping device must be loosened within one hour after concrete is placed so that movement may take place. Device shall be removed after concrete has set on both sides of assembly.  
(C) Grind Armored Joint Surface to A Smooth Finish After Removal of Shipping Device.  
(D) All Exposed Surface of A Joint Shall Be Field Painted After Grinding.

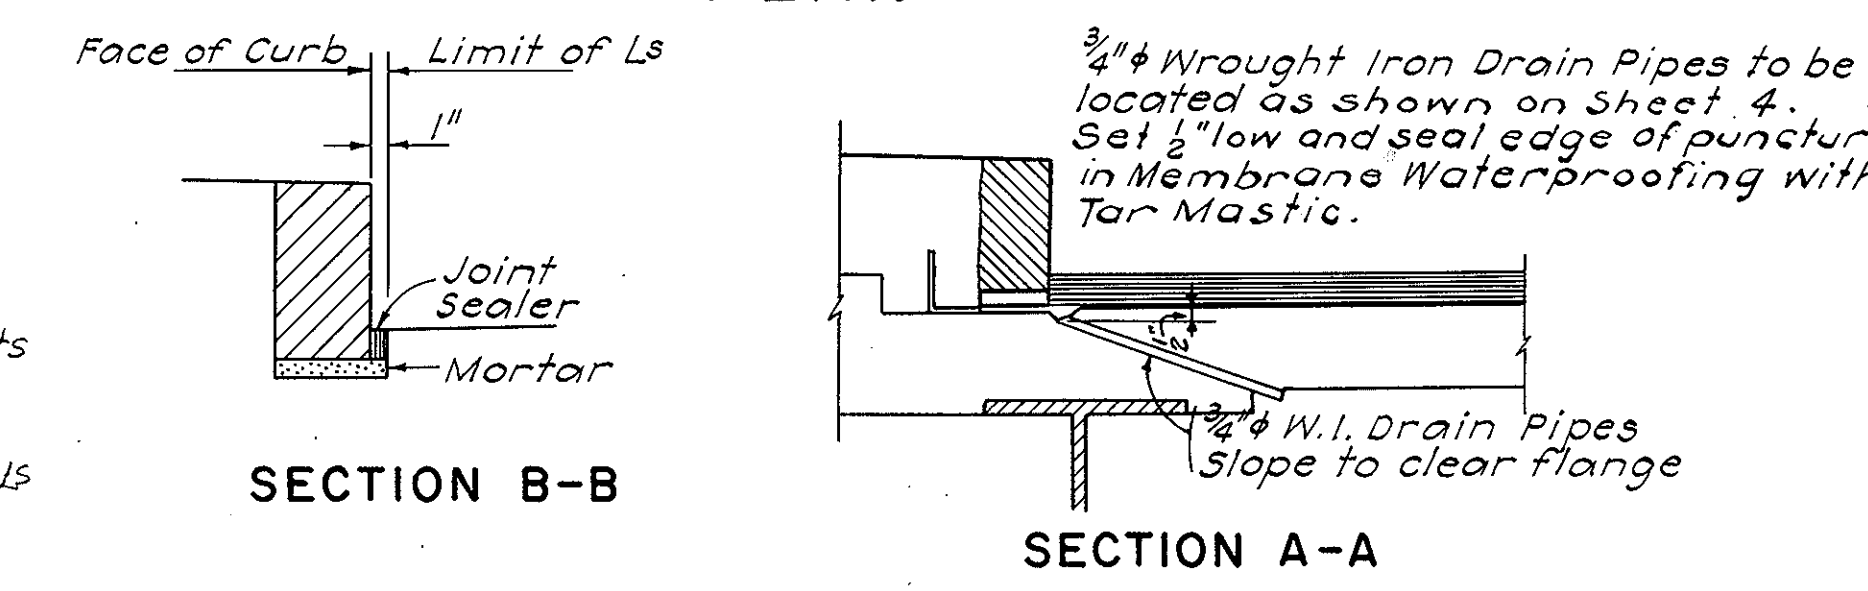

**DETAILS OF JOINT AT FACE OF CURB**


Detail as shown is at safety curb; for Detail at Sidewalk see Sheet # 5

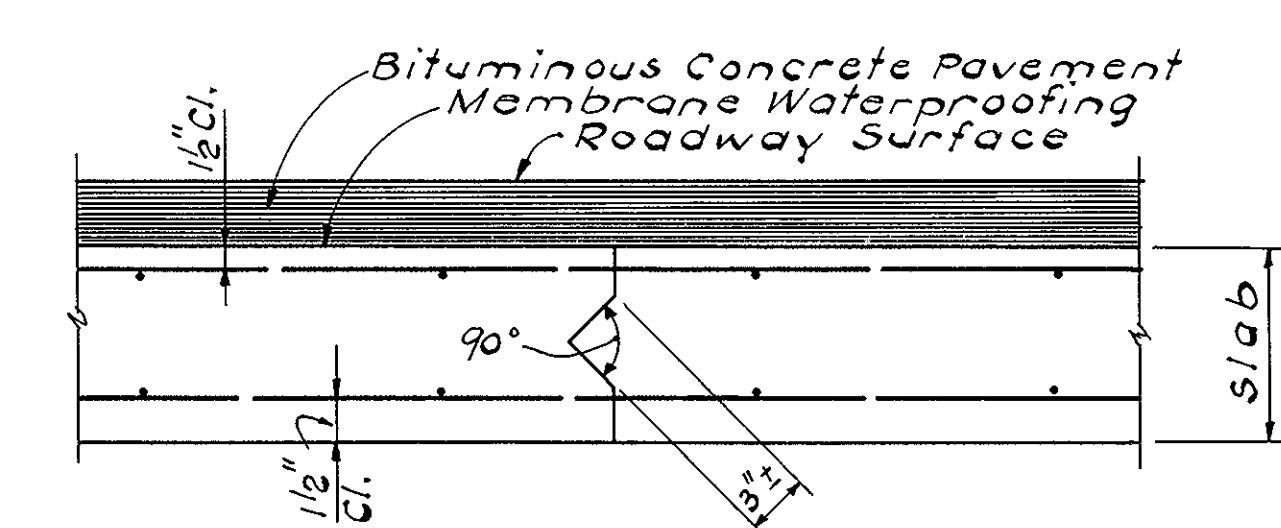

**LONGITUDINAL CONSTRUCTION JOINT DETAILS IN SLAB**  
Scale: 1 1/2" = 1'-0"



Note: Longitudinal Construction Joints in Bridge Deck slabs may be omitted when the Contractor's proposed method of construction is approved by the Engineer in writing.

DATE	DESCRIPTION
MARCH 25, 1967	ISSUED FOR CONSTRUCTION
	USE ONLY PRINTS OF LATEST DATE

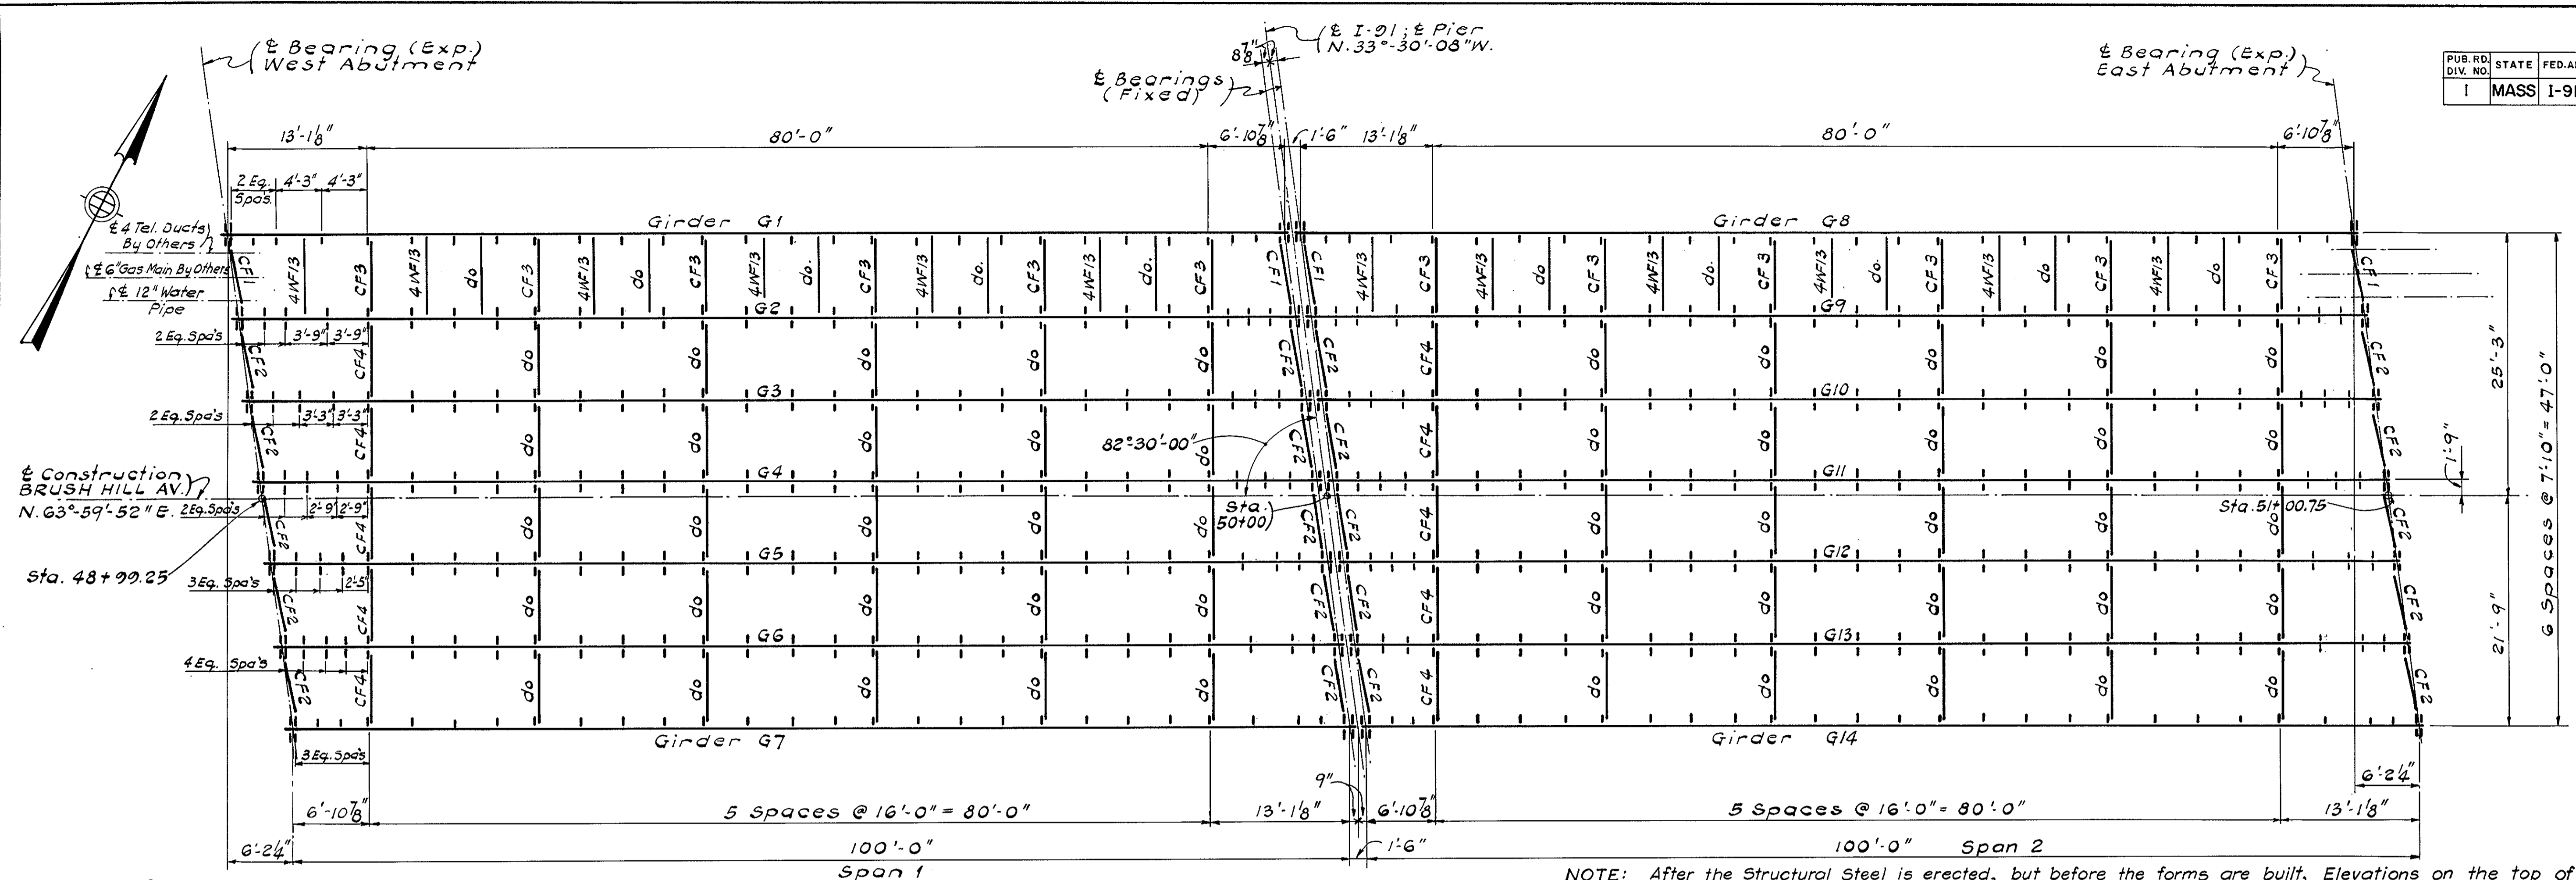


**NOTE:** After the Structural Steel is erected, but before the forms are built, Elevations on the top of the Flange of the Beams are to be obtained at the Points indicated in the Table. The Difference between the Elevation obtained and those shown in the Table gives the actual Blocking Distance from the Top of Beam to the bottom of Slab at Centerline of Beam. See Haunch Detail.

GIRDER	SPAN 1								SPAN 2										
	€ BRG	1/8 PT	1/4 PT	3/8 PT	1/2 PT	5/8 PT	3/4 PT	7/8 PT	€ BRG	1/8 PT	1/4 PT	3/8 PT	1/2 PT	5/8 PT	3/4 PT	7/8 PT	€ BRG		
G 1	200.49	200.31	200.10	199.85	199.56	199.23	198.86	198.44	198.00	G 8	197.95	197.65	197.32	196.95	196.53	196.07	195.58	195.04	194.47
G 2	200.63	200.46	200.25	200.00	199.71	199.38	199.00	198.58	198.13	G 9	198.09	197.79	197.46	197.08	196.67	196.21	195.71	195.17	194.59
G 3	200.77	200.59	200.38	200.13	199.84	199.50	199.13	198.71	198.26	G 10	198.22	197.91	197.58	197.20	196.79	196.33	195.82	195.28	194.71
G 4	200.92	200.73	200.52	200.27	199.98	199.64	199.26	198.84	198.39	G 11	198.35	198.04	197.71	197.33	196.91	196.45	195.95	195.41	194.83
G 5	200.82	200.62	200.41	200.15	199.86	199.52	199.14	198.72	198.27	G 12	198.23	197.92	197.58	197.21	196.79	196.32	195.82	195.28	194.70
G 6	200.62	200.44	200.22	199.97	199.67	199.33	198.95	198.53	198.08	G 13	198.03	197.72	197.39	197.01	196.59	196.12	195.62	195.07	194.50
G 7	200.44	200.25	200.04	199.79	199.49	199.15	198.77	198.34	197.88	G 14	197.84	197.53	197.20	196.82	196.40	195.93	195.43	194.88	194.29





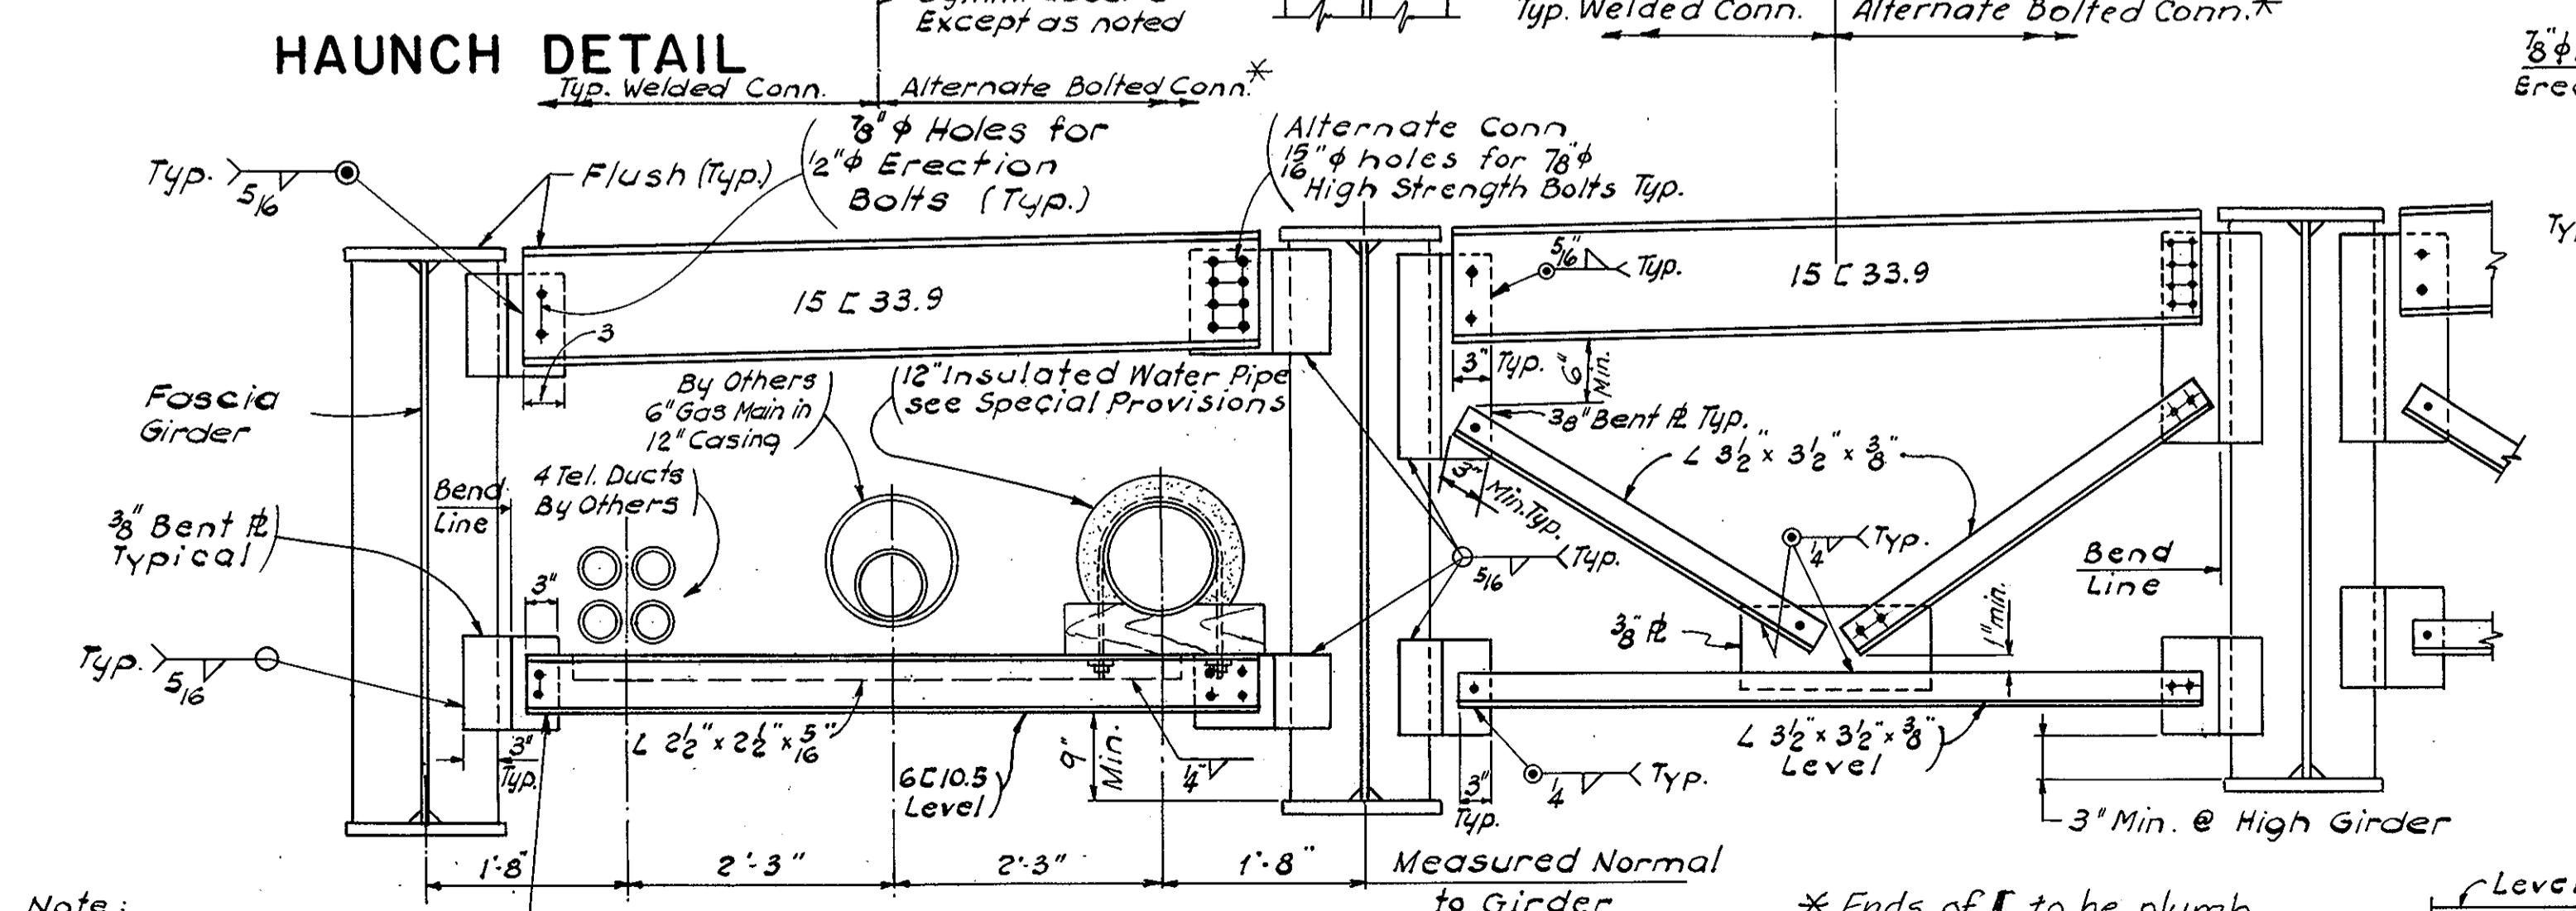
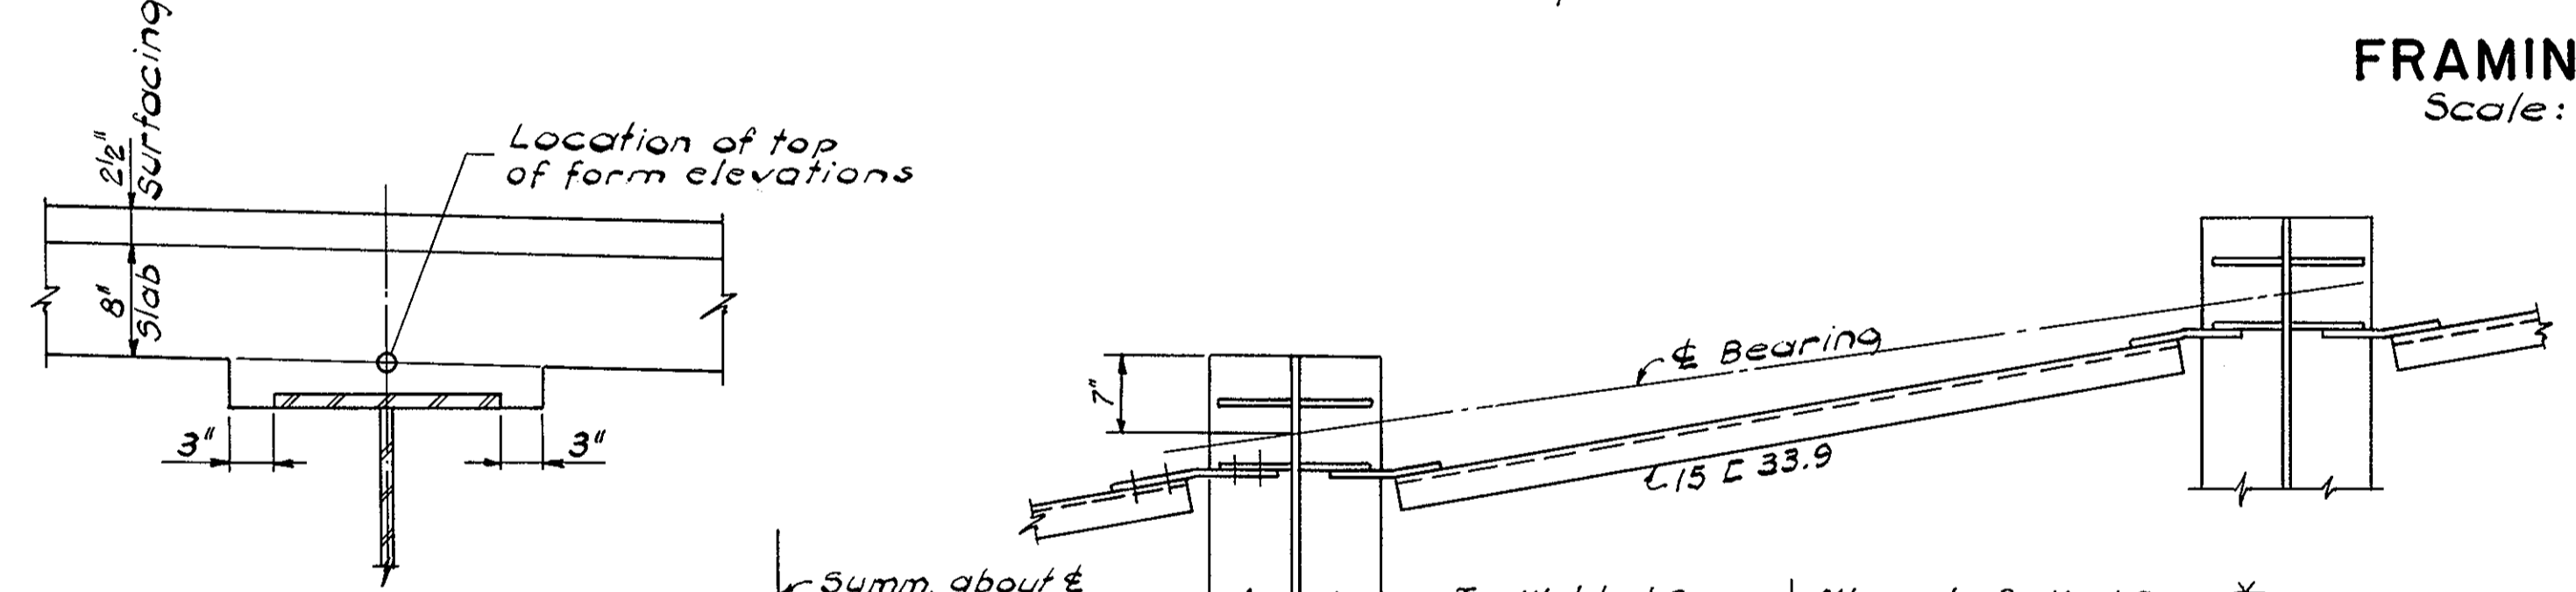


**Note:** All bolts, nuts & washers for utility supports to be galv. All bolts to be 5/8"

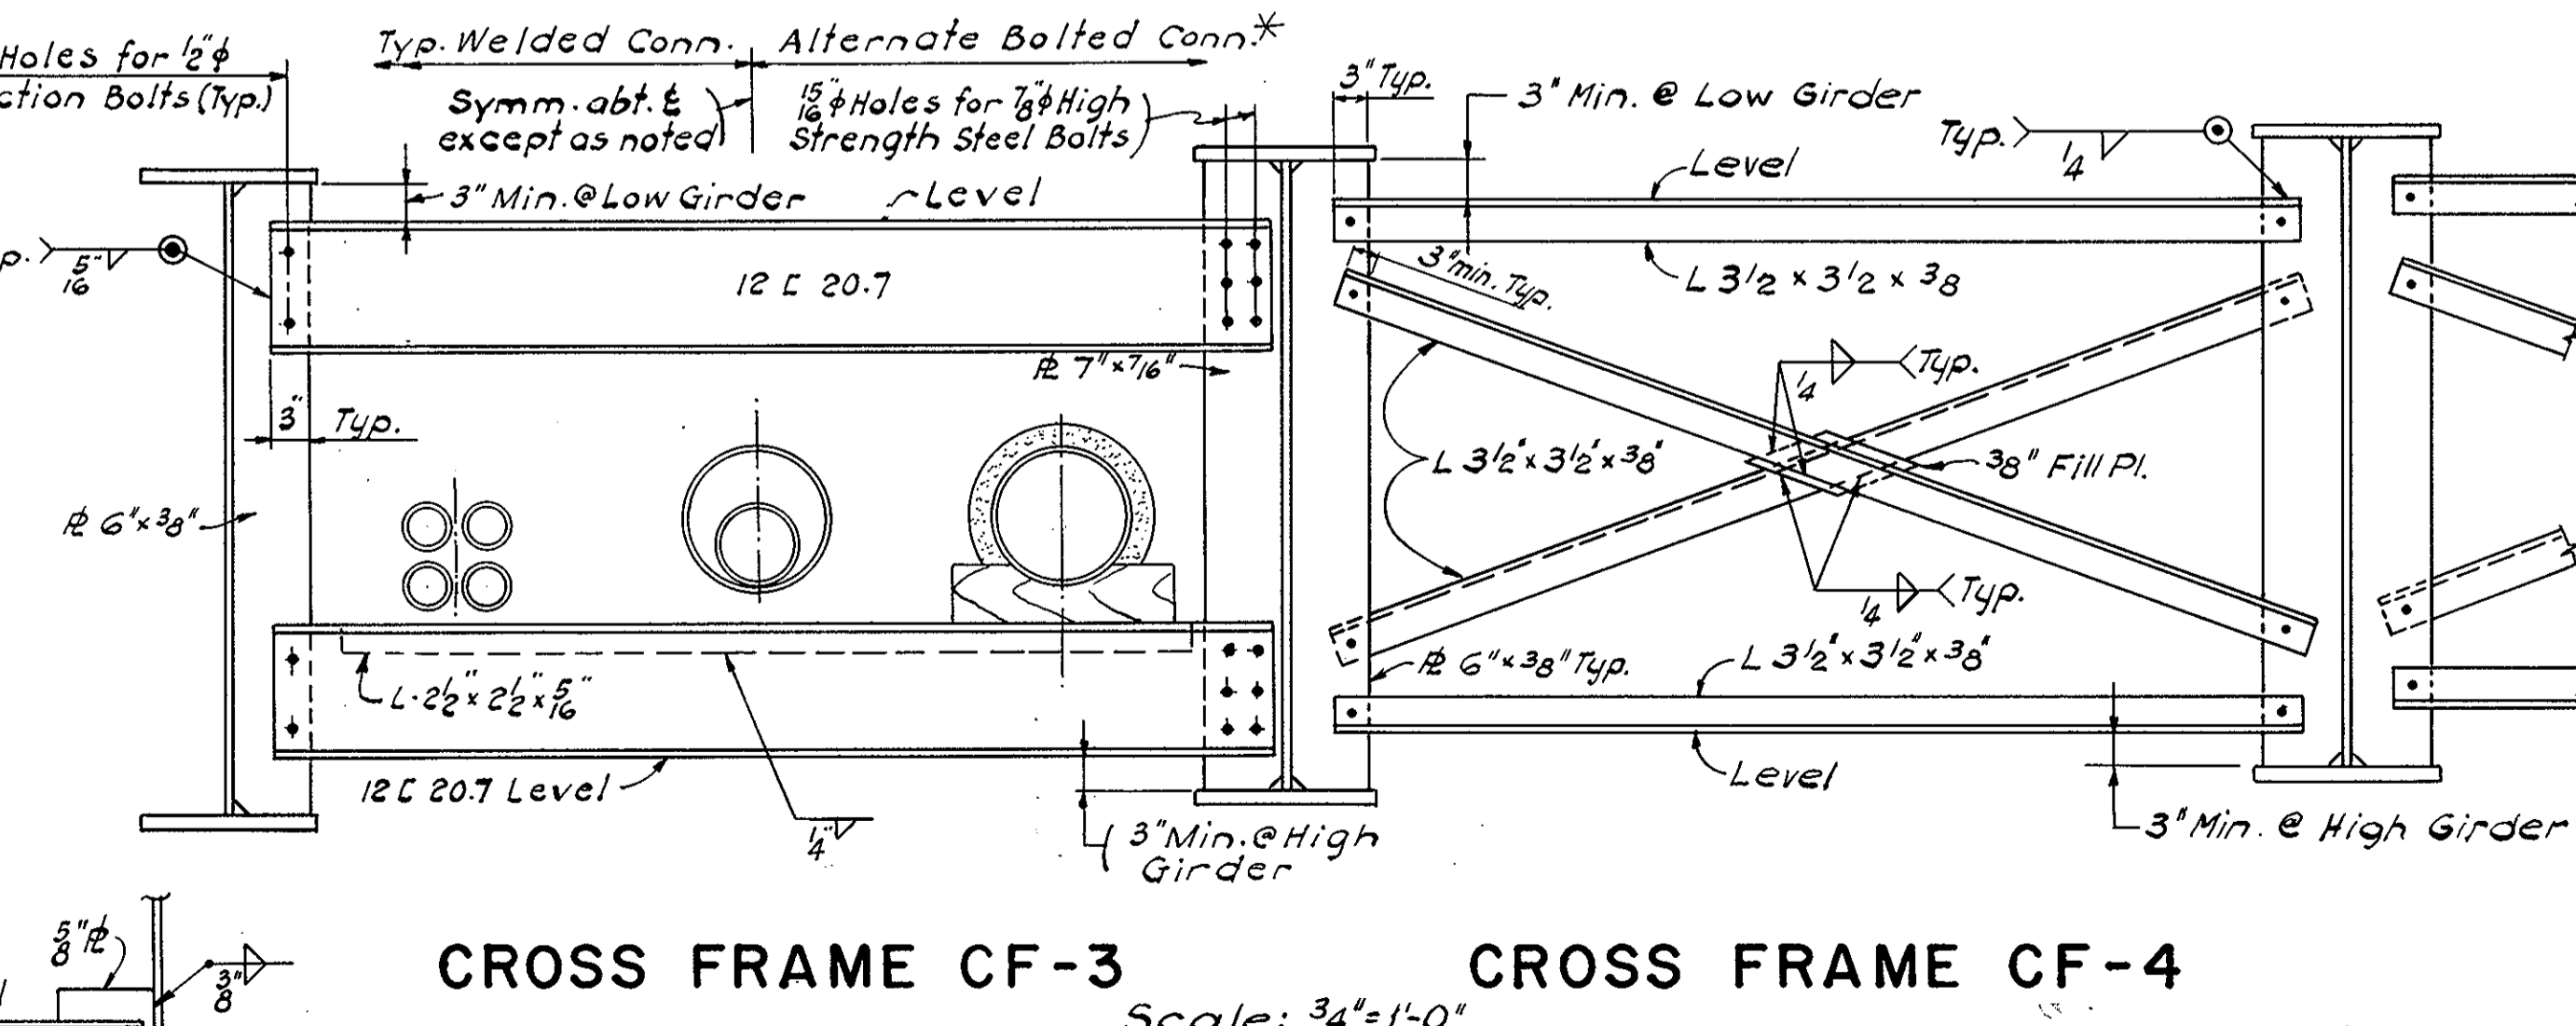

**Note:** Alternate Bolted Connections similar to those shown for CF1\*



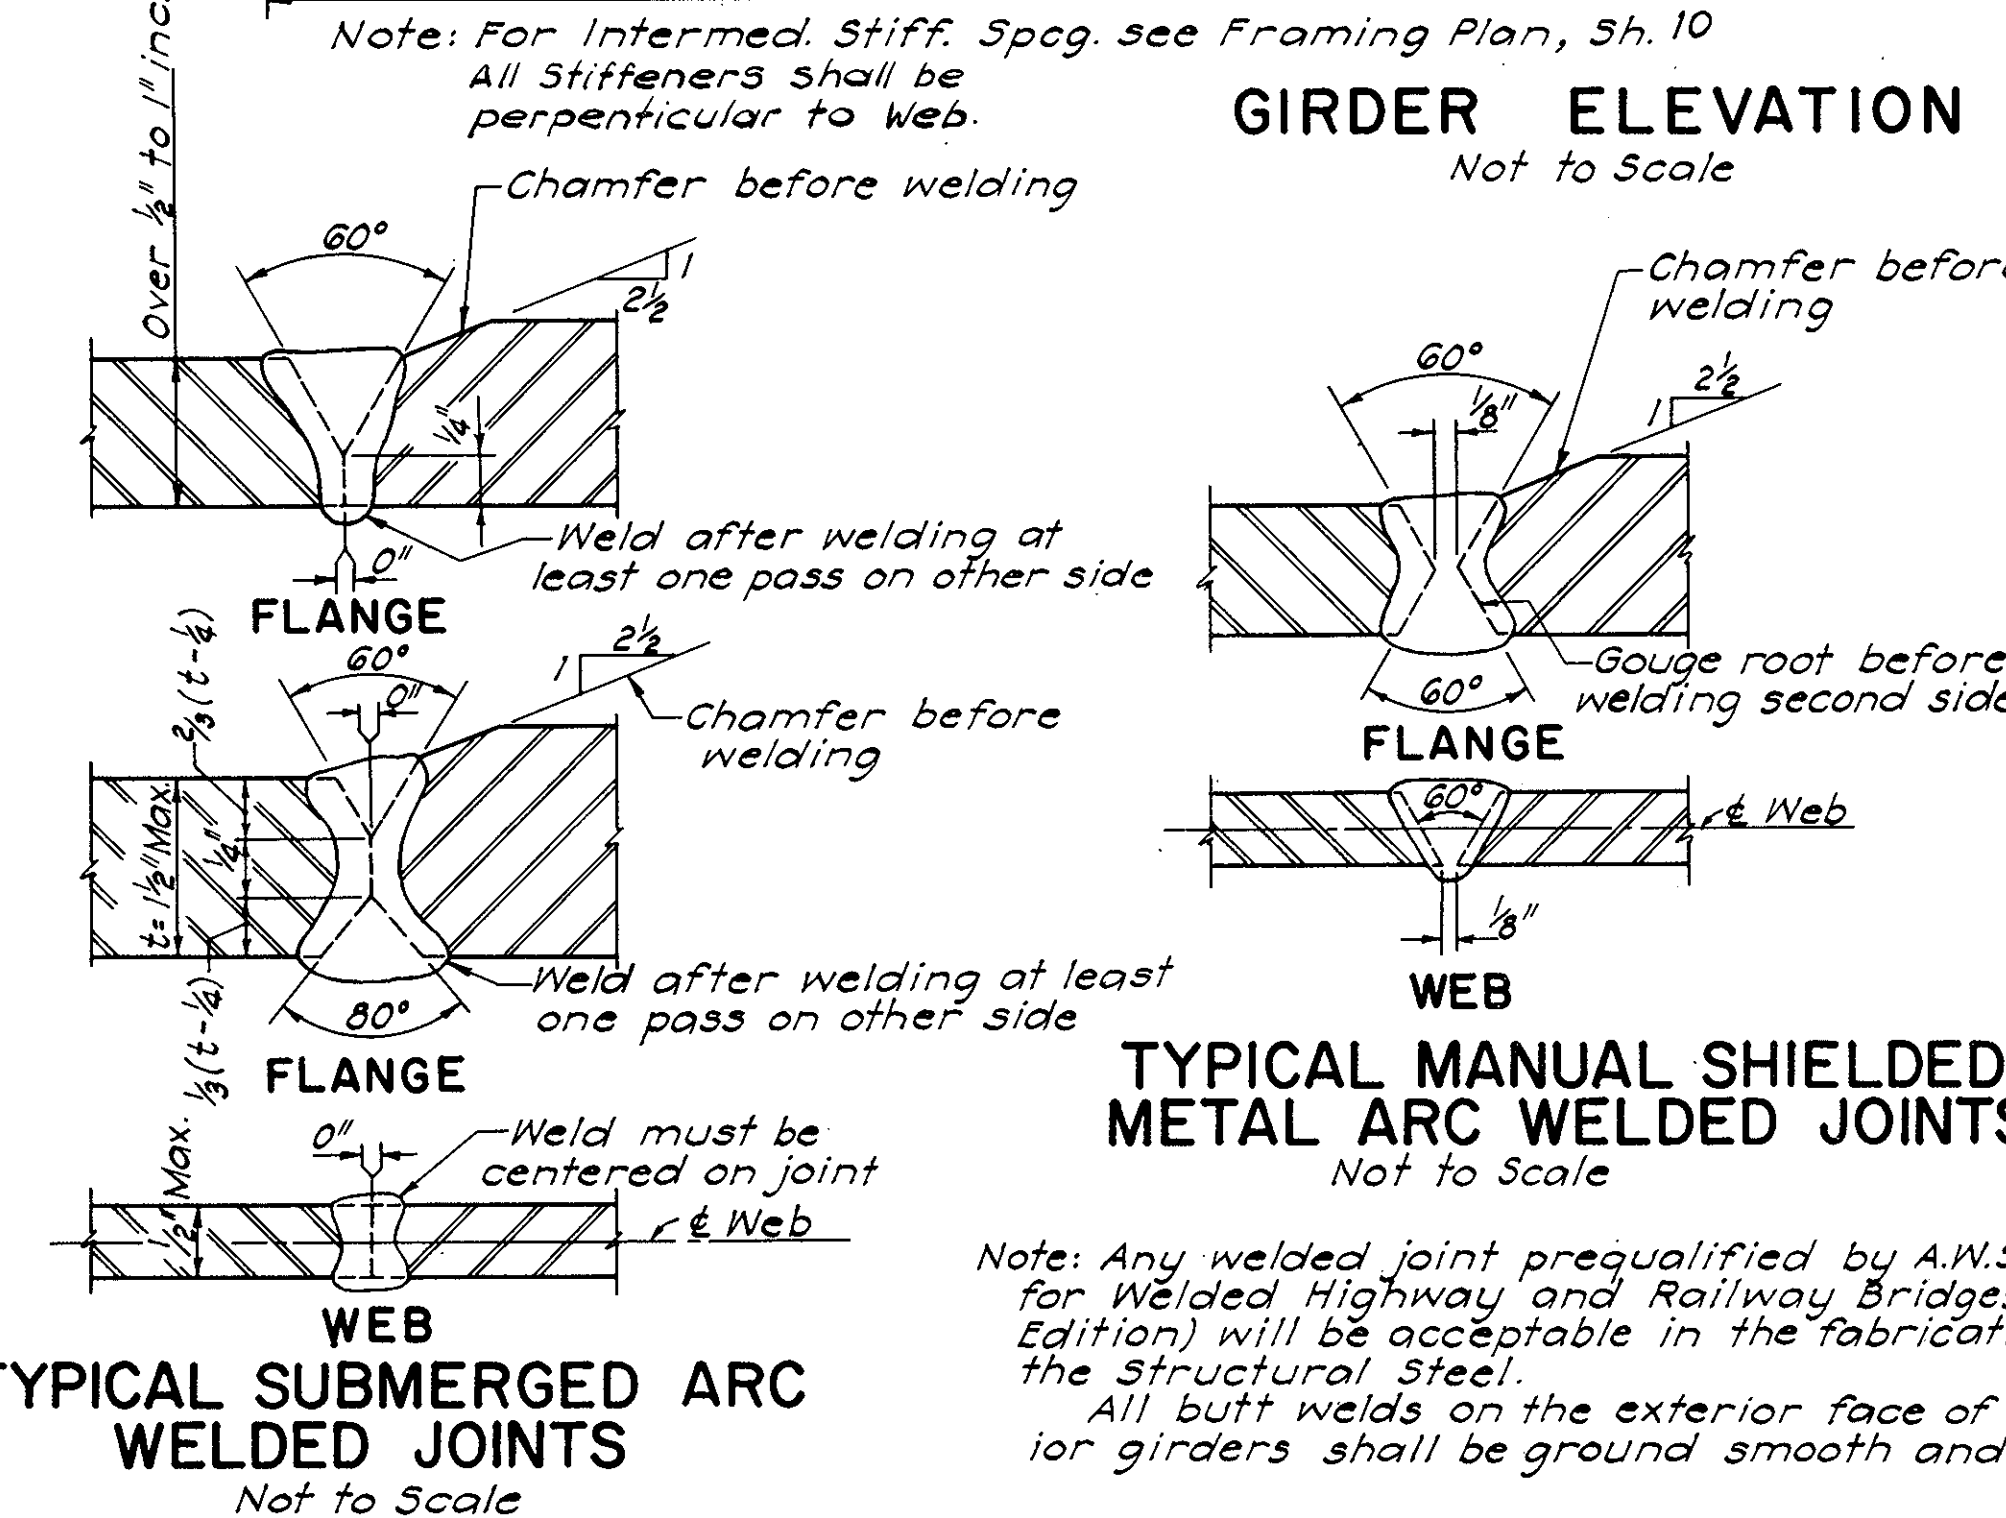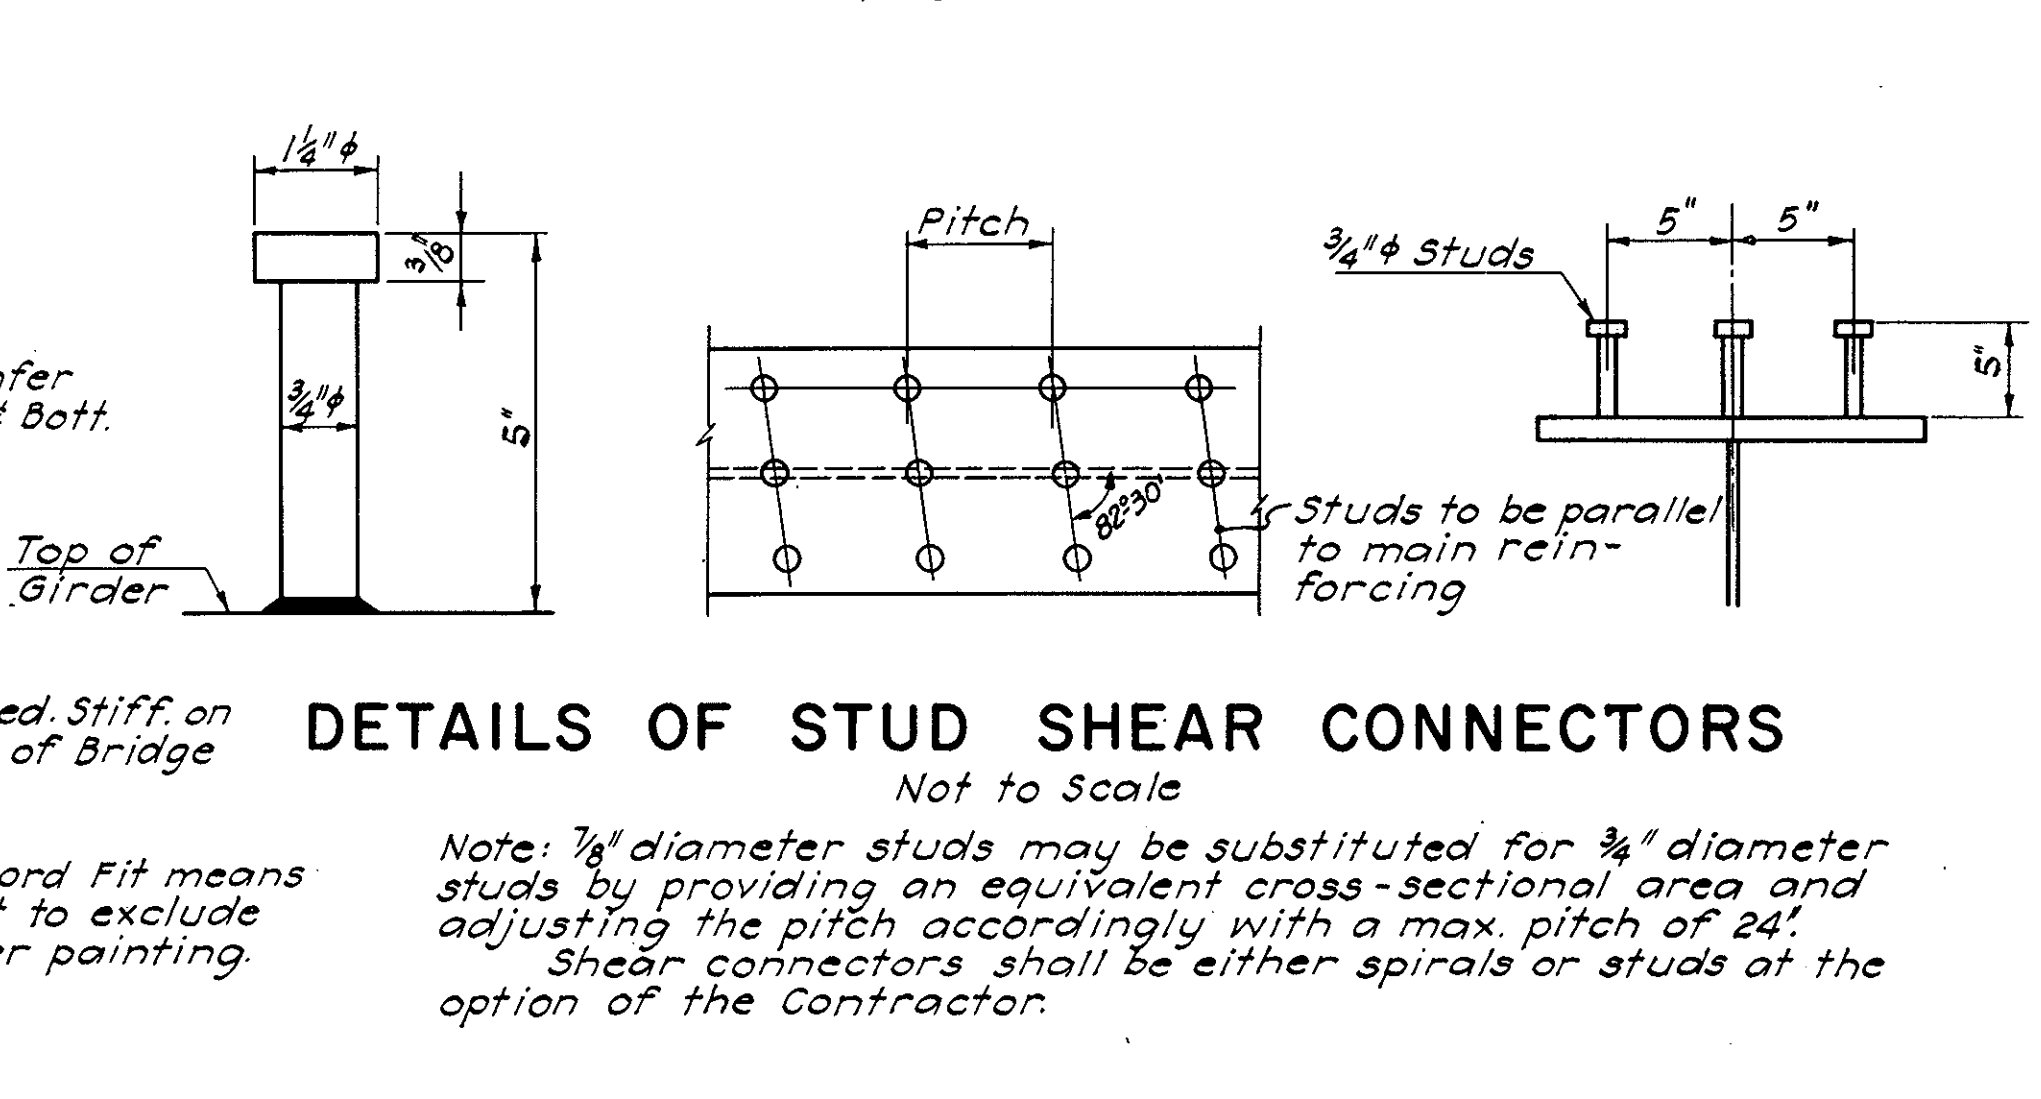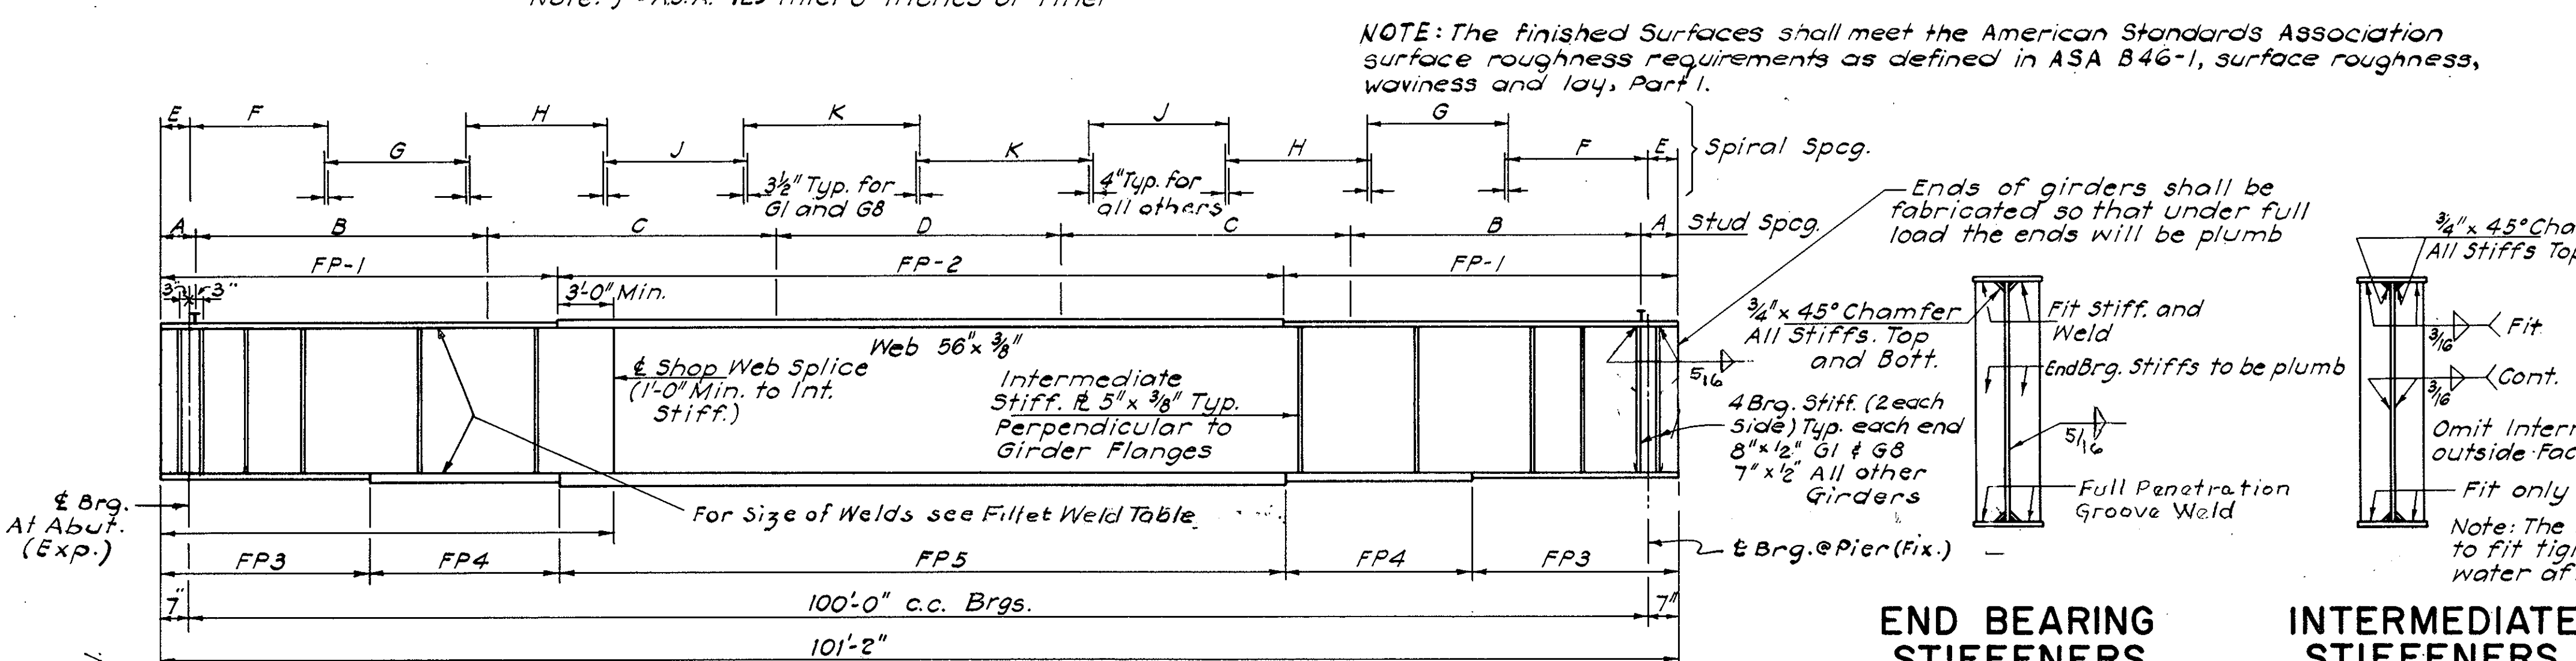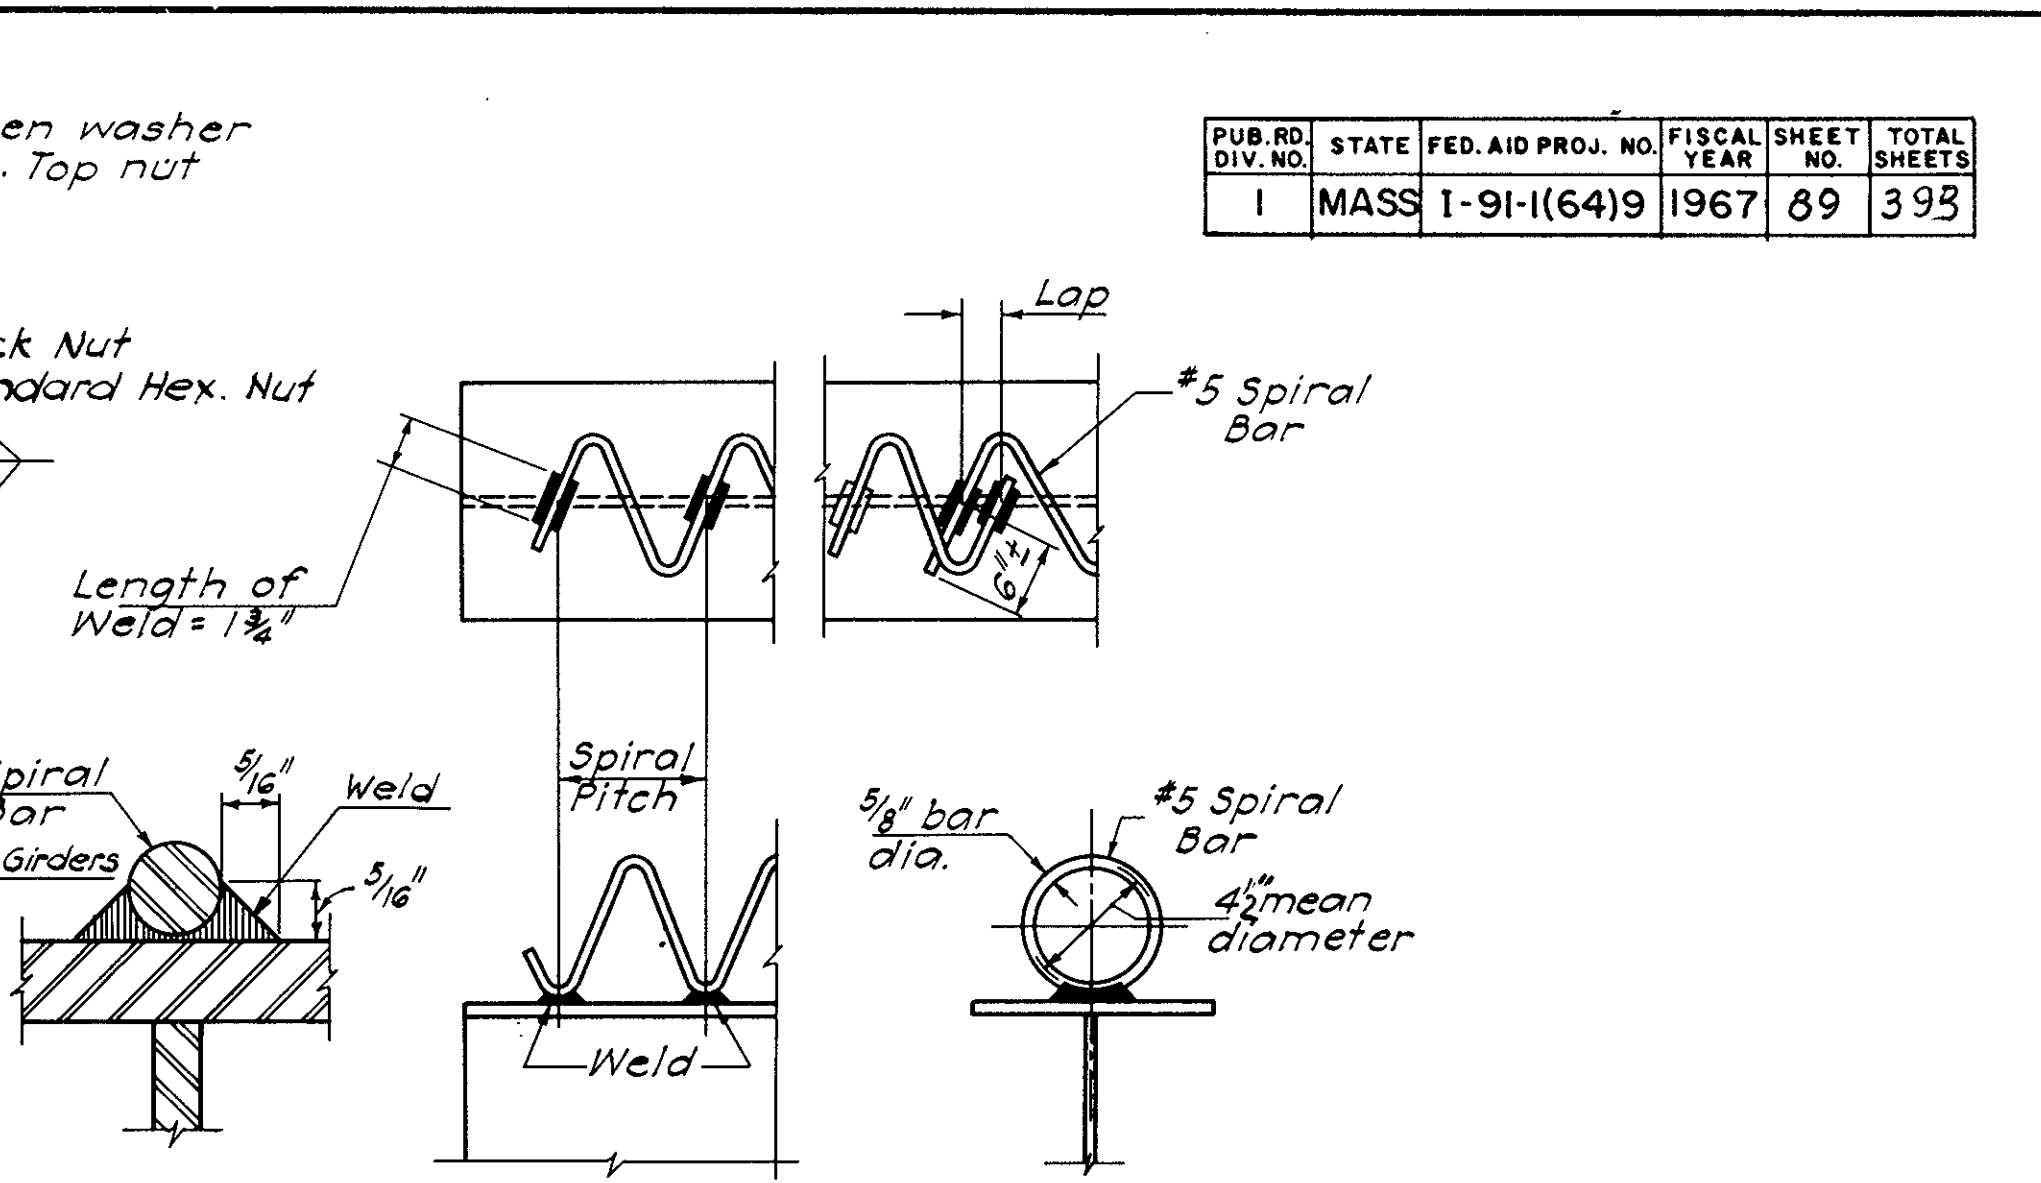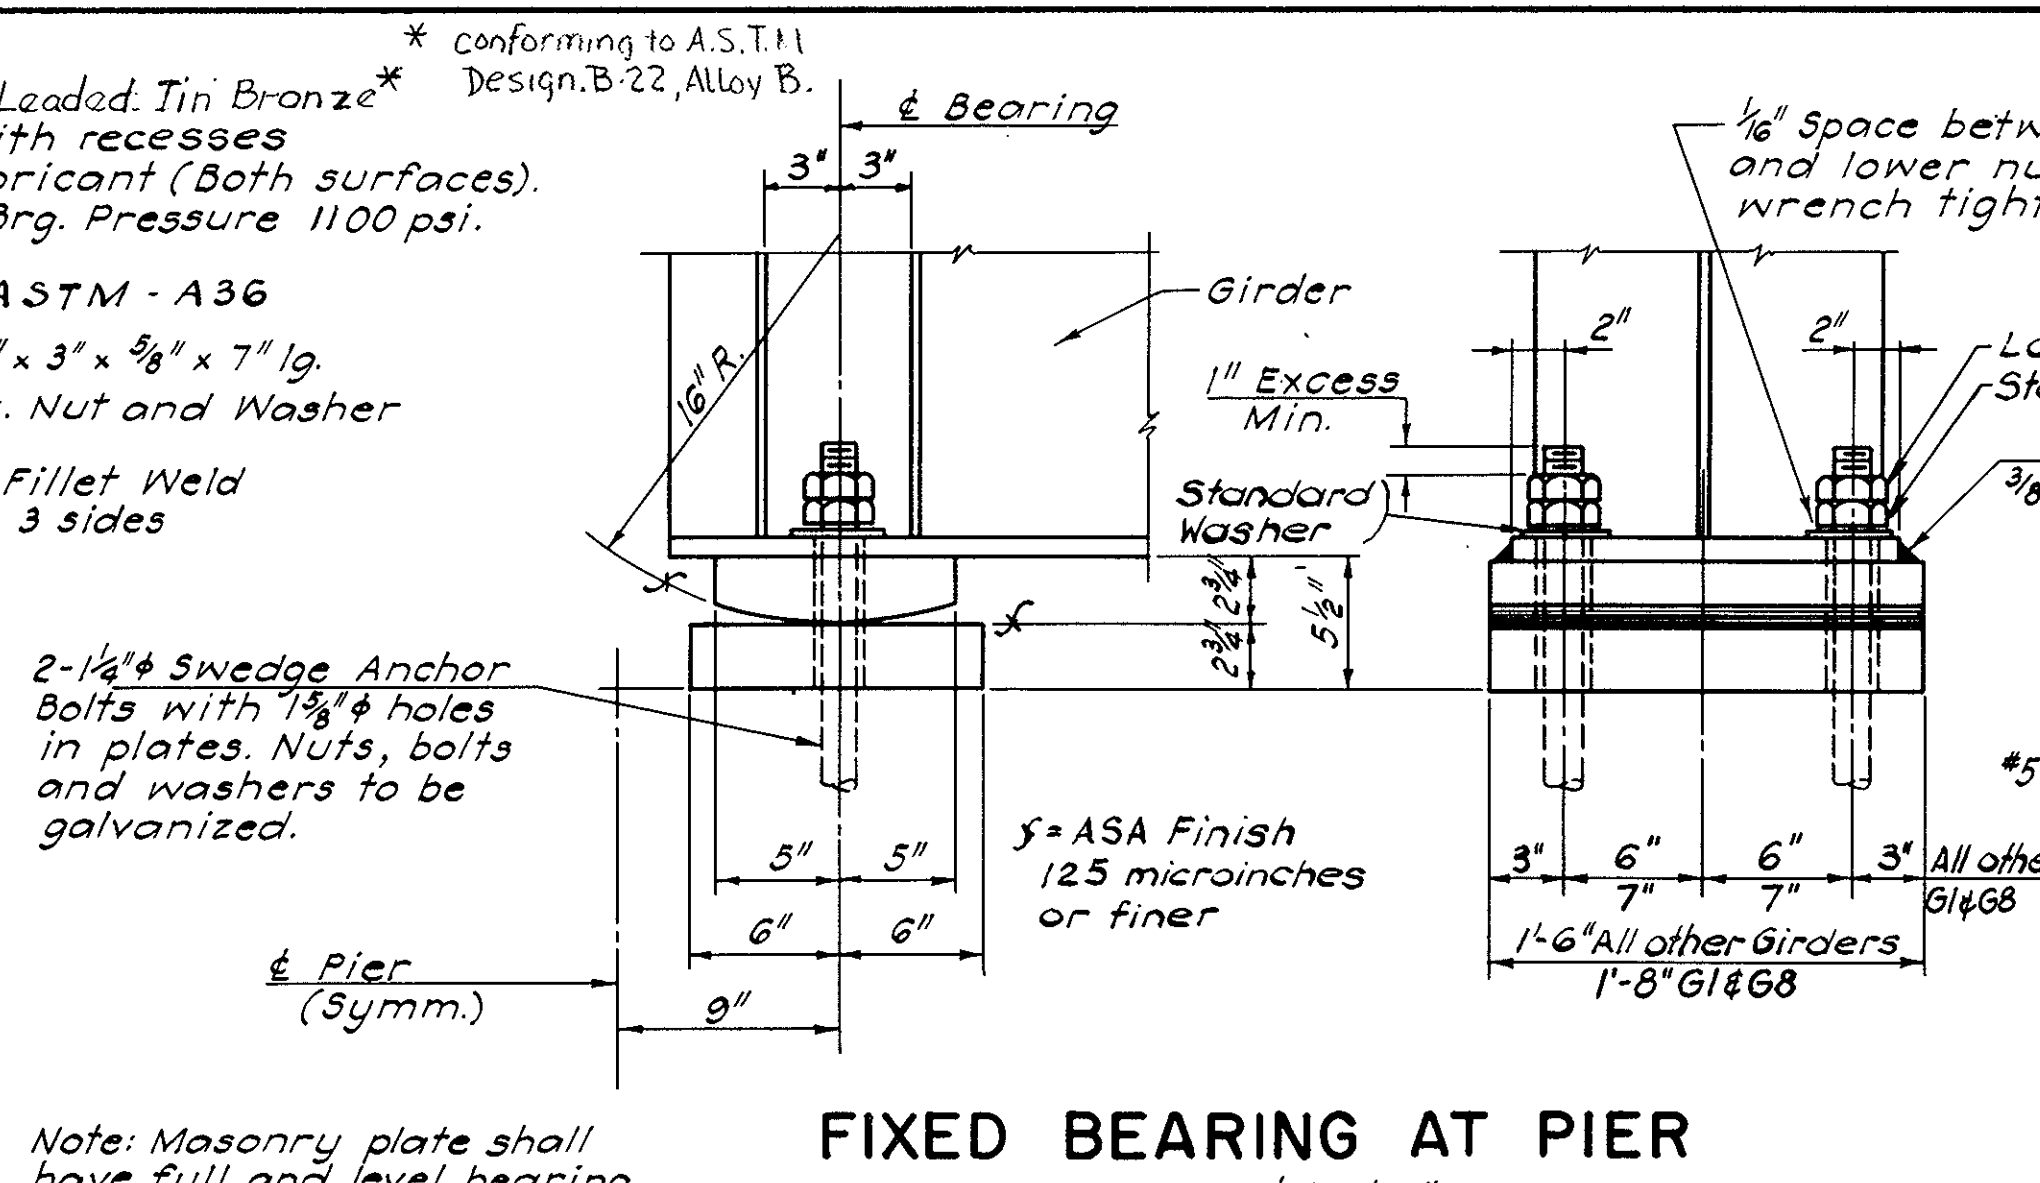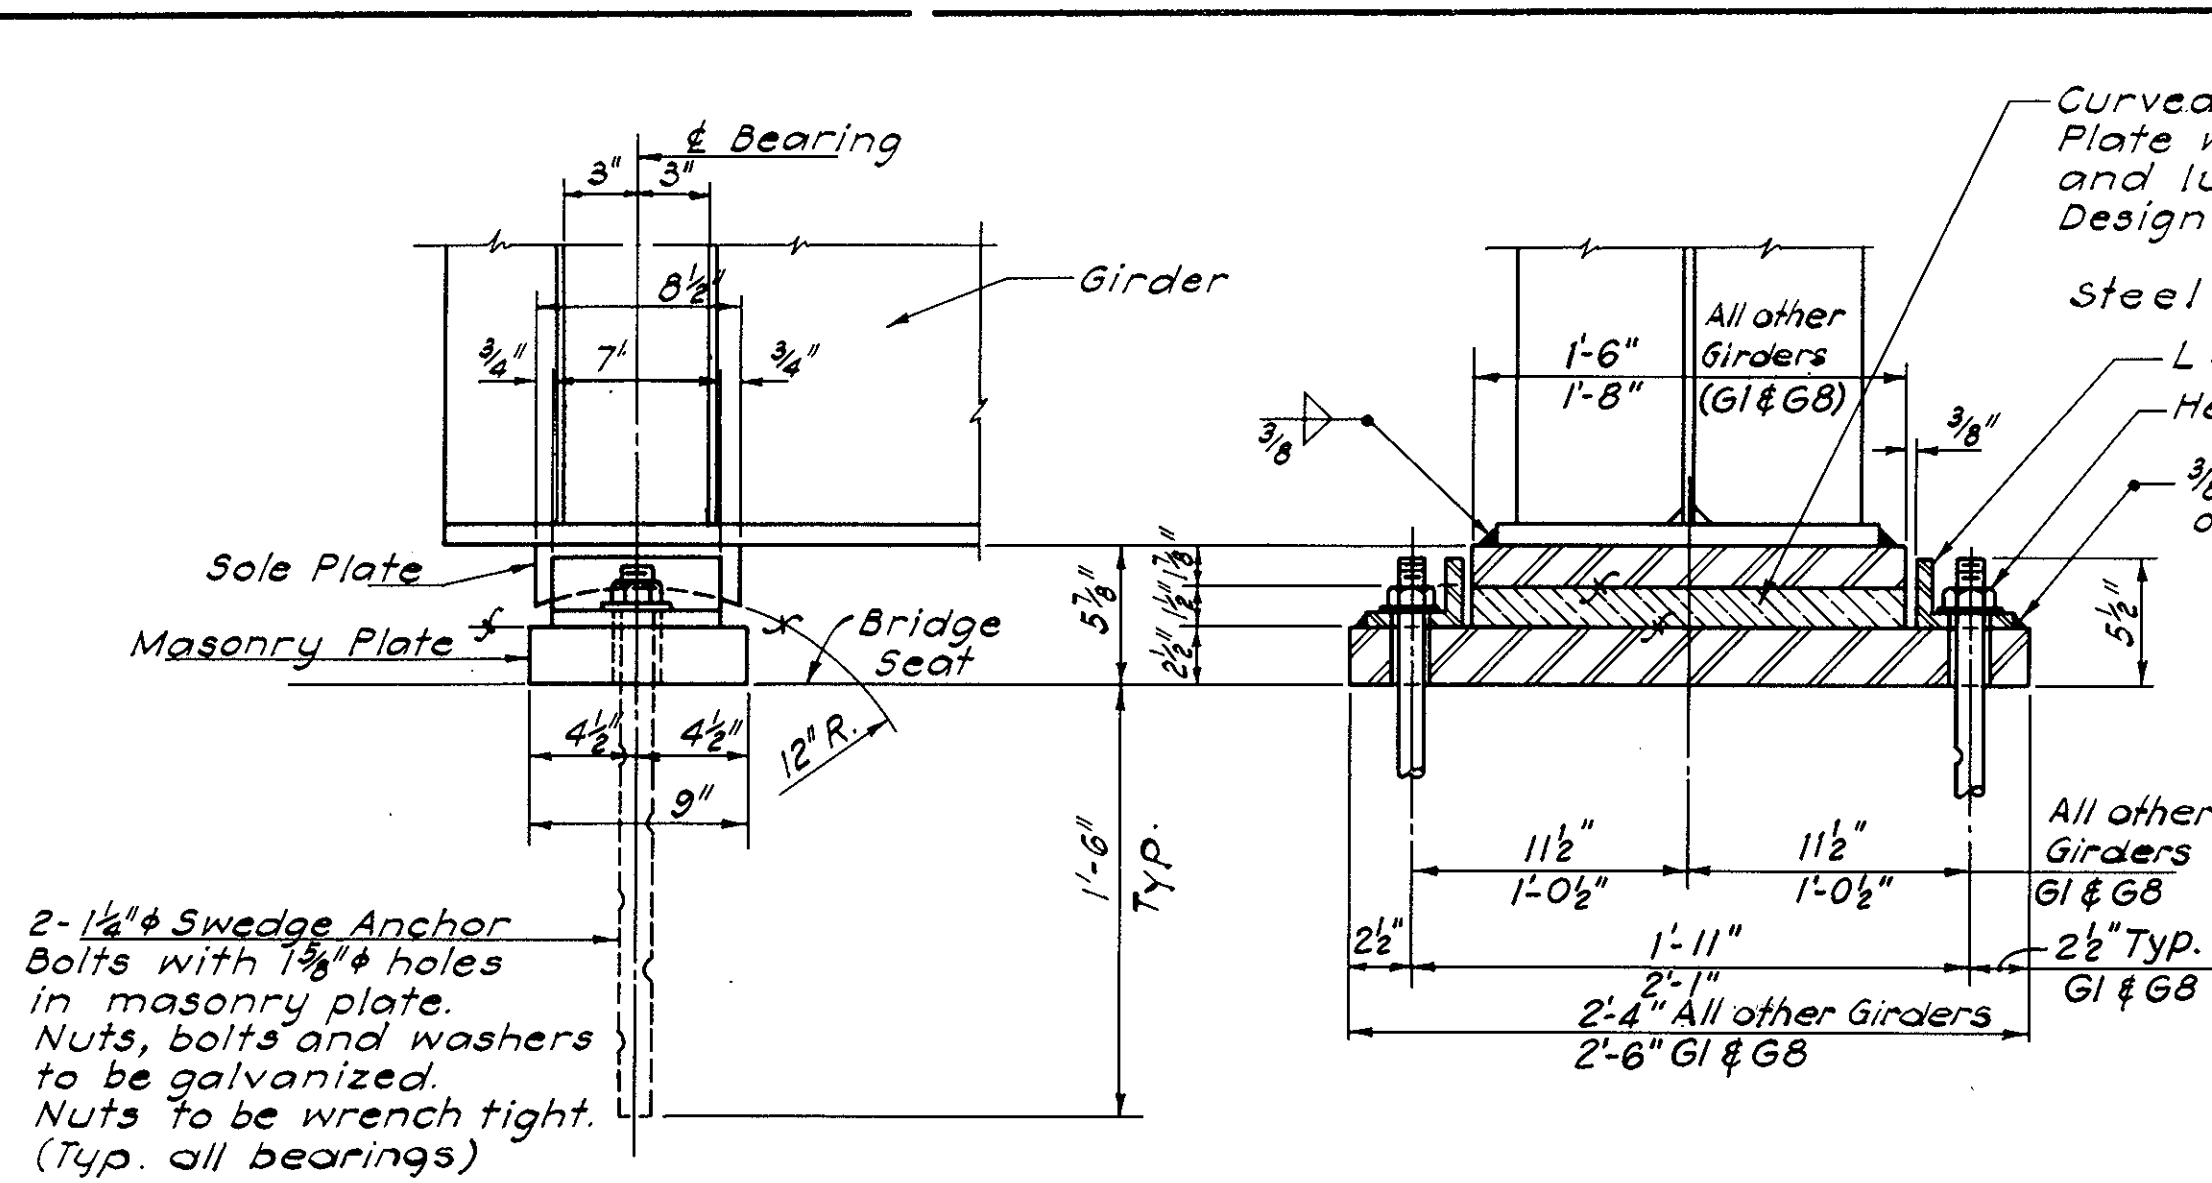

GIRDER NO.	FLANGE PLATE (F.P.)					SHEAR CONNECTOR SPACING											CAMBER (MIN.)
						STUDS					SPIRALS						
	1	2	3	4	5	A	B	C	D	E	F	G	H	J	K		
G1 & G8	18 x 3/8 x 28'-7"	18 x 1/2 x 44'-0"	18 x 1 x 16'-7"	18 x 1/2 x 11'-0"	18 x 2 x 46'-0"	9 1/2"	195ps @ 10" = 15'-10"	125ps @ 16" = 16'-0"	185ps @ 24" = 36'-0"	7"	215ps @ 6" = 10'-6"	155ps @ 8" = 10'-0"	125ps @ 10" = 10'-0"	105ps @ 12" = 10'-0"	85ps @ 16" = 10'-8"	4 1/4"	
G2 & G9	16 x 3/8 x 27'-7"	16 x 1/2 x 46'-0"	16 x 1 x 16'-7"	16 x 1/2 x 10'-0"	16 x 2 x 48'-0"	7 1/2"	165ps @ 12" = 16'-0"	125ps @ 16" = 16'-0"	185ps @ 24" = 36'-0"	7 1/2"	185ps @ 6" = 9'-0"	"	135ps @ 10" = 10'-10"	115ps @ 12" = 11'-0"	"	4 3/8"	
G3-G6 G10-G13	16 x 3/8 x 32'-1"	16 x 1 x 37'-0"	16 x 1 x 19'-1"	16 x 1/2 x 12'-0"	16 x 1 1/8 x 39'-0"	"	"	"	"	"	"	"	"	"	"	4 1/4"	
G7-G14	16 x 3/8 x 31'-1"	16 x 1 x 39'-0"	16 x 1 x 18'-1"	16 x 1/2 x 12'-0"	16 x 1 1/8 x 41'-0"	"	"	"	"	"	"	"	"	"	"	4 3/8"	

For Girder Location see Framing Plan, Sh. #10

**TABLE OF FILLET WELDS - WEB R. TO FLANGE R.**

All Girders: Web To Flange R.'s F.P. #1, #2, #3 & #4	5/16"
All Girders: Web To Flange R. F.P. #5	3/8"

Preparation of Material for Welding shall conform to the provisions of Art 402, A.W.S. D.2.0-66.  
Assembly of Material for Welding shall conform to the provisions of Art. 403, A.W.S. D.2.0-66.

Note: Any welded joint prequalified by A.W.S. Specs. for Welded Highway and Railway Bridges (1966 Edition) will be acceptable in the fabrication of the Structural Steel.  
All butt welds on the exterior face of the exterior girders shall be ground smooth and flush.

MARCH 25/1967	ISSUED FOR CONSTRUCTION
DATE	DESCRIPTION
USE ONLY PRINTS OF LATEST DATE	




GENERAL NOTES

- FOUNDATIONS**  
Foundations may be altered if necessary to suit conditions encountered during construction.
- DATE AND SEAL**  
To be located as shown on Sheet 6. A Sheet showing Size and Character of Numerals will be furnished. Seal to be furnished by the State and shall be set by the Contractor.
- DESIGN**  
In Accordance with the current AASHTO Specifications (1961 Edition) and Interim Specifications for H&D-44 Loading, modified for military loading.
- REINFORCEMENT**  
All bars shall have deformations conforming to A.S.T.M.A.-305. Unless otherwise shown on the plans, Bars shall be lapped 20 diameters for Splices, except that Bars near the Top of Slabs and Beams with more than 12 inches of Concrete under the Bars shall be lapped 36 diameters for Splices.
- BRIDGE RAILING**  
See Department Standard Plans dated May 1965 for details of Bridge Railings.
- SCALES**  
Scales noted on Plans are not applicable to reduced Size Prints. Divide Scales by 2 for 4-Size Prints.
- BENCH MARK**  
B.M. Top of Right Outer Corner Bottom Concrete Step House #1162 Route 5, Sta. 101+38 @ Route 5 68' R.L. E.L.=67.31
- SURVEY BOOK NUMBERS**  
77,361 & 21,000.
- UNSUITABLE MATERIAL**  
All Unsuitable Material shall be Removed Within the Limits of the Foundations of the Structure.
- ANCHOR BOLTS**  
All Anchor Bolts are to be Set by Template and Placed Before Concrete is Poured.

ESTIMATED QUANTITIES (NOT GUARANTEED)

ITEM	QUANTITIES
Bridge Excavation	475 C.Y.
Class B's Rock Excavation	5 C.Y.
Gravel Borrow	1,450 C.Y.
Gravel Borrow For Bridge Foundations	2,900 C.Y.
Class I Bituminous Concrete Pavement Type I-1	58 Tons
Class I Dense Protective Bottom Course For Bridges	62 Tons
Metal Bridge Railing (1 Rail) Option	40A L.F.
Bridge Structure (W-21-46)	1 A.S.

The following Quantities are included in Item 384.02  
Steel Reinforcement for Structures 124,000 lbs.  
Structural Steel 208,000 lbs.

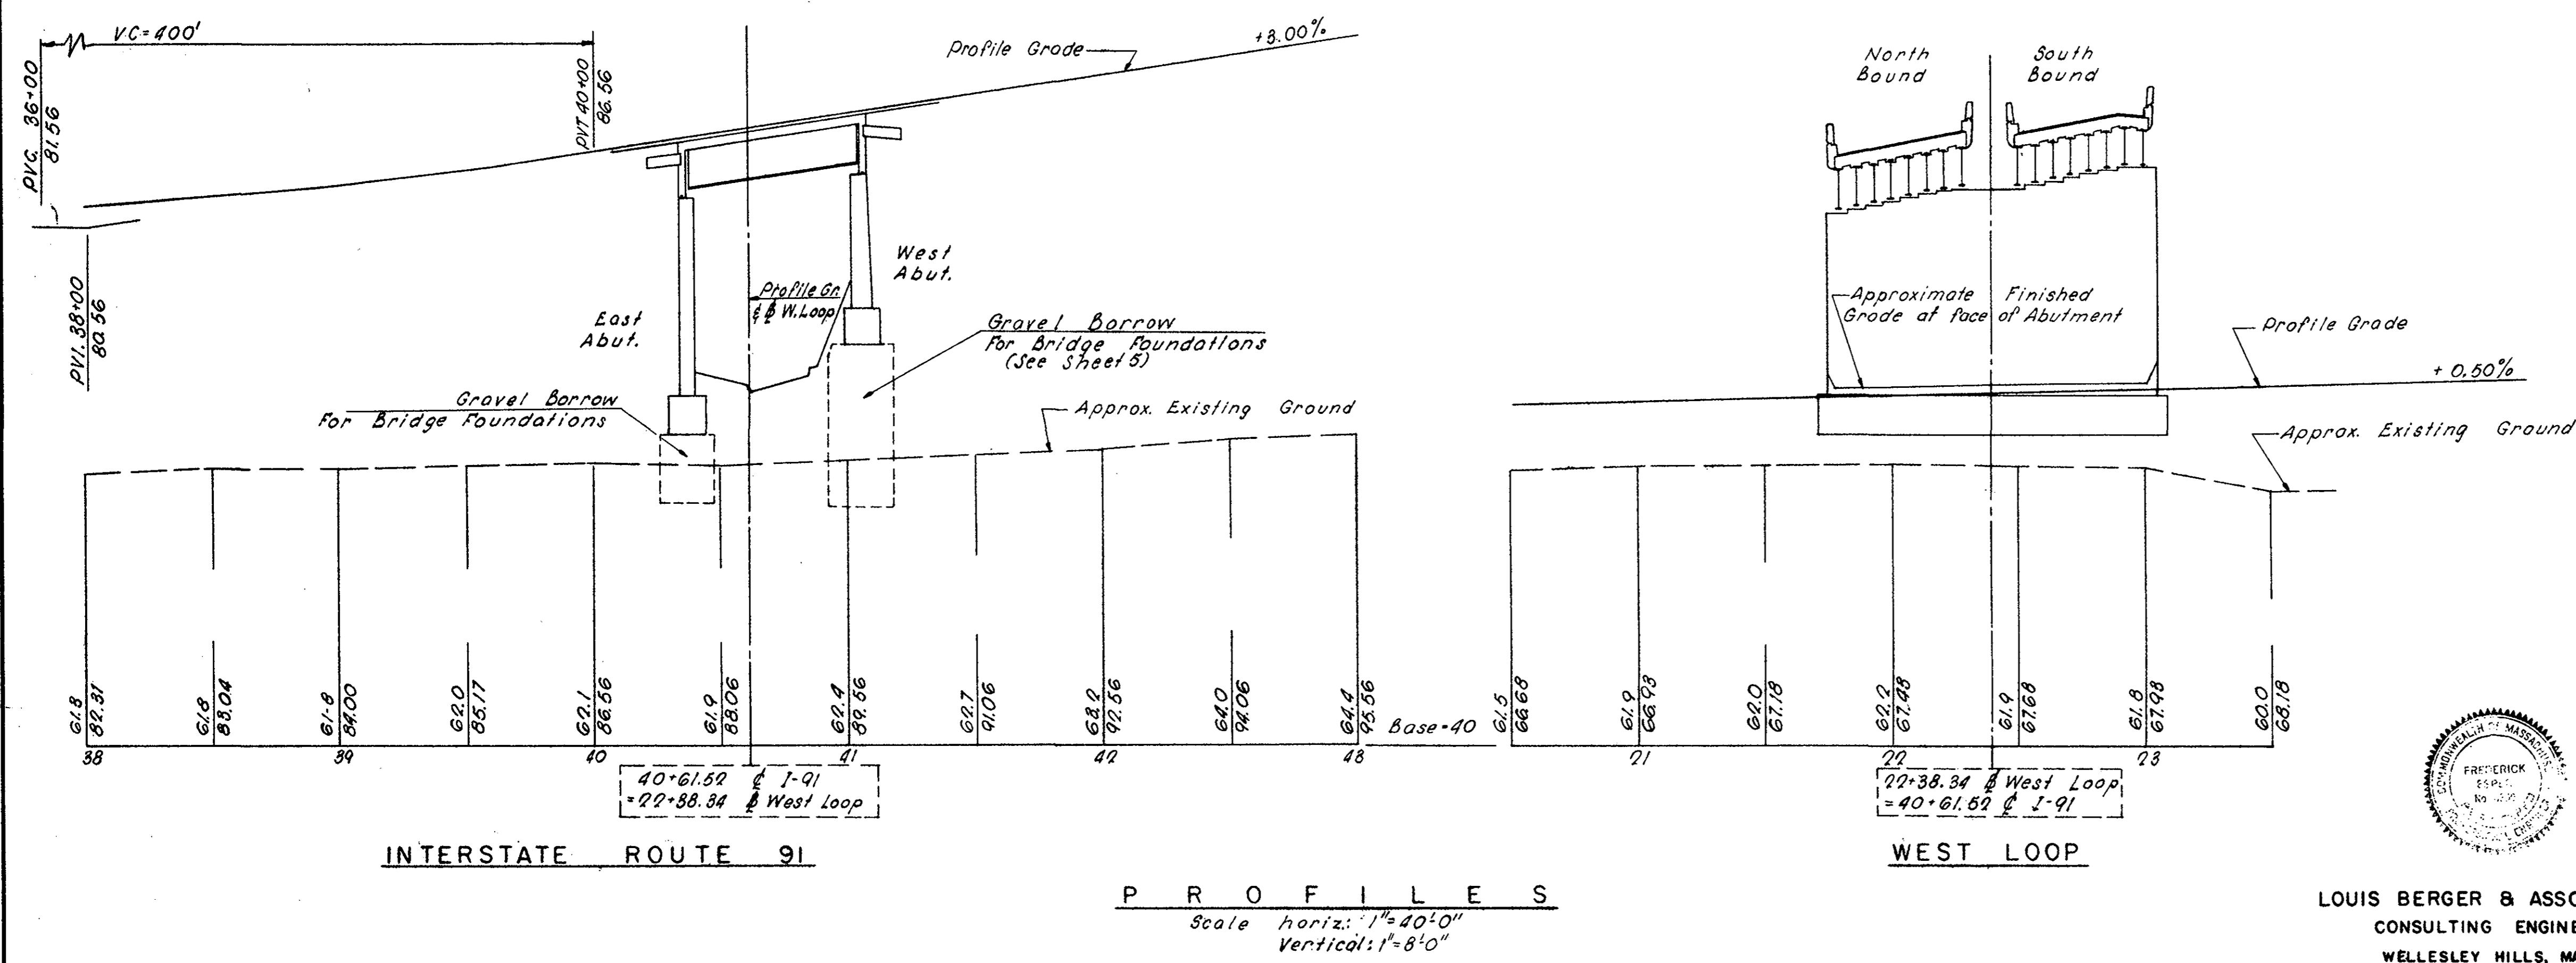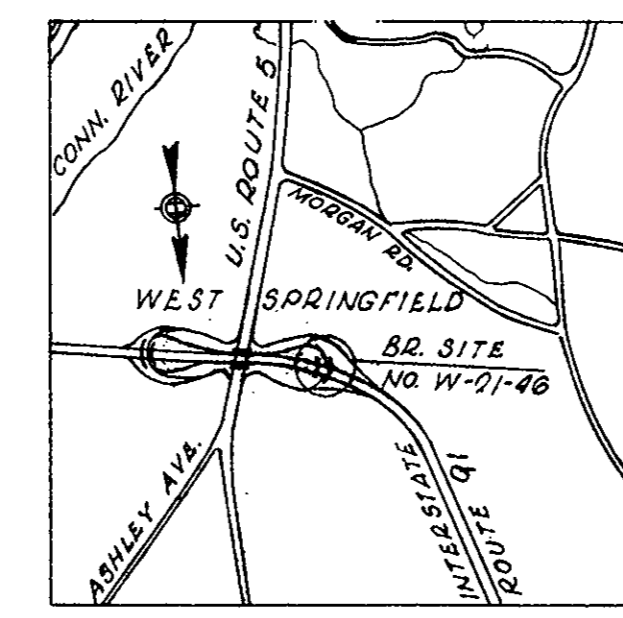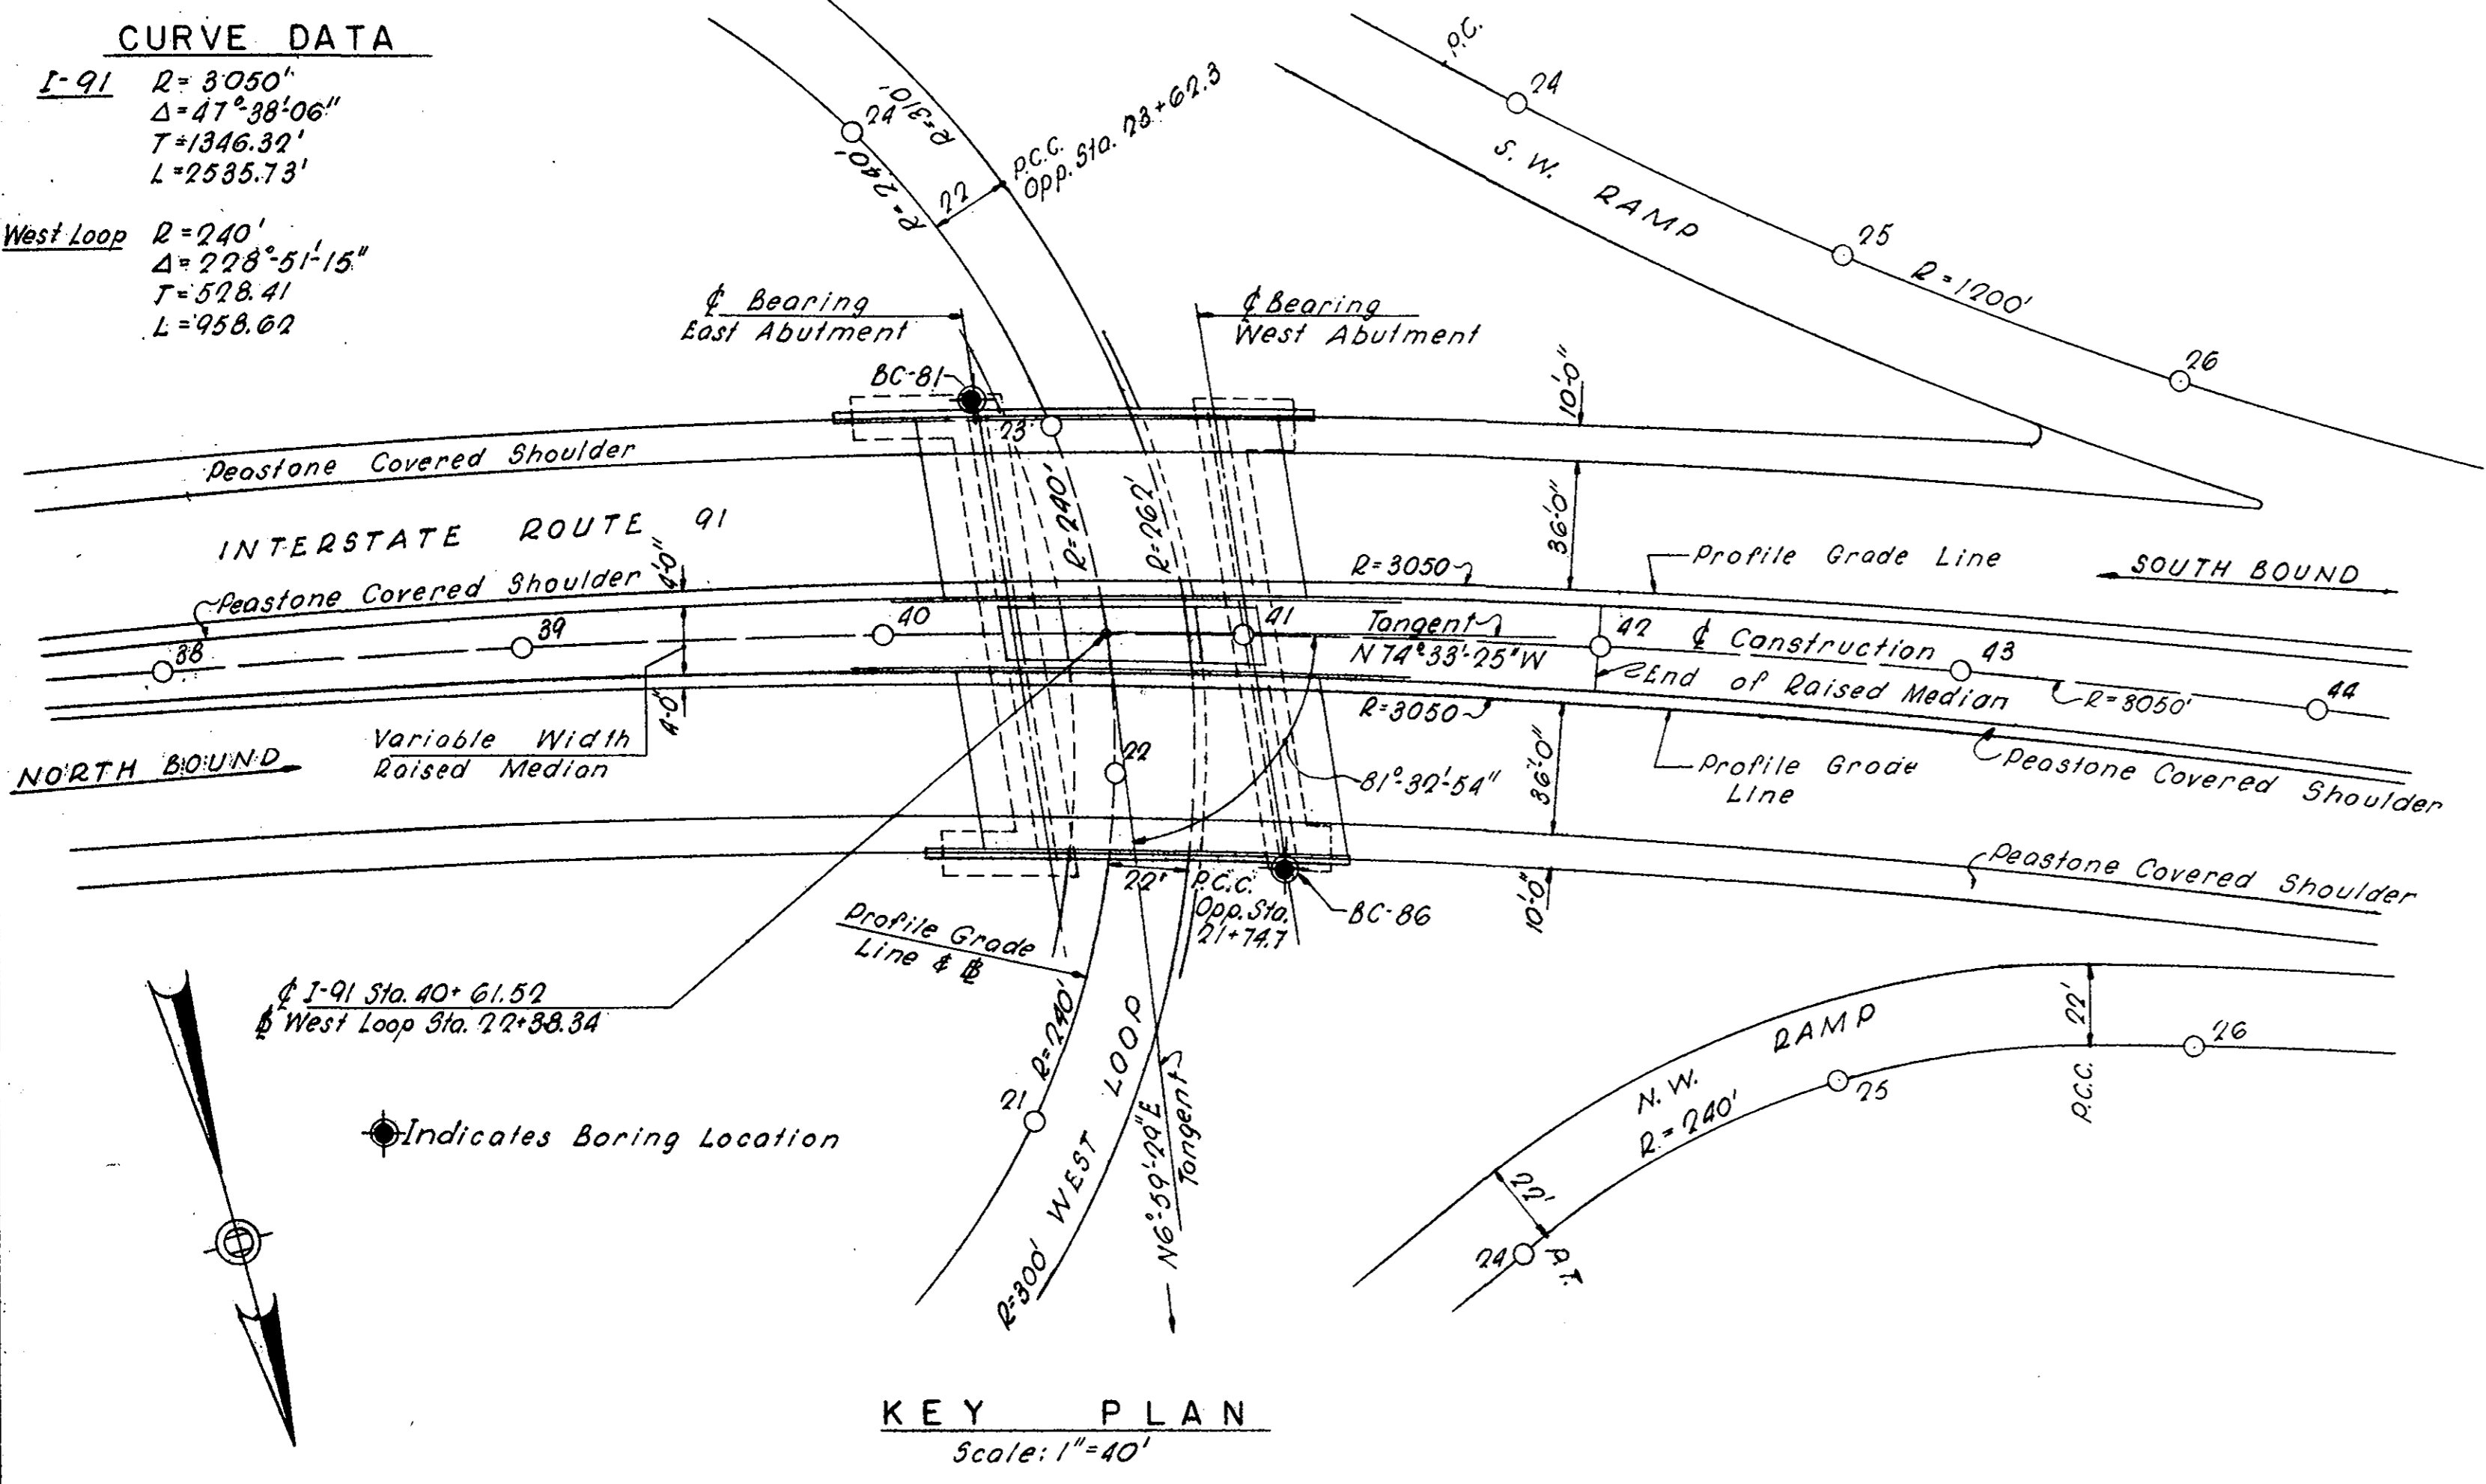



DESIGNED BY  
DRAWN BY  
CHECKED BY  
APPROVED FOR DESIGN

APRIL 9, 1966 ISSUED FOR CONSTRUCTION

THE COMMONWEALTH OF MASSACHUSETTS  
PROPOSED BRIDGE  
WEST SPRINGFIELD MASS  
INTERSTATE ROUTE 91  
INTERSTATE ROUTE 91 OVER WEST LOOP  
(AT ROUTE 5)  
SCALES AS NOTED

LOUIS BERGER & ASSOCIATES  
CONSULTING ENGINEER  
WELLESLEY HILLS, MASS.

OFFICE OF  
DEPARTMENT OF PUBLIC WORKS  
100 NASHUA ST. BOSTON MASS  
BRIDGE ENGINEER  
APR. 1966  
CHIEF ENGINEER

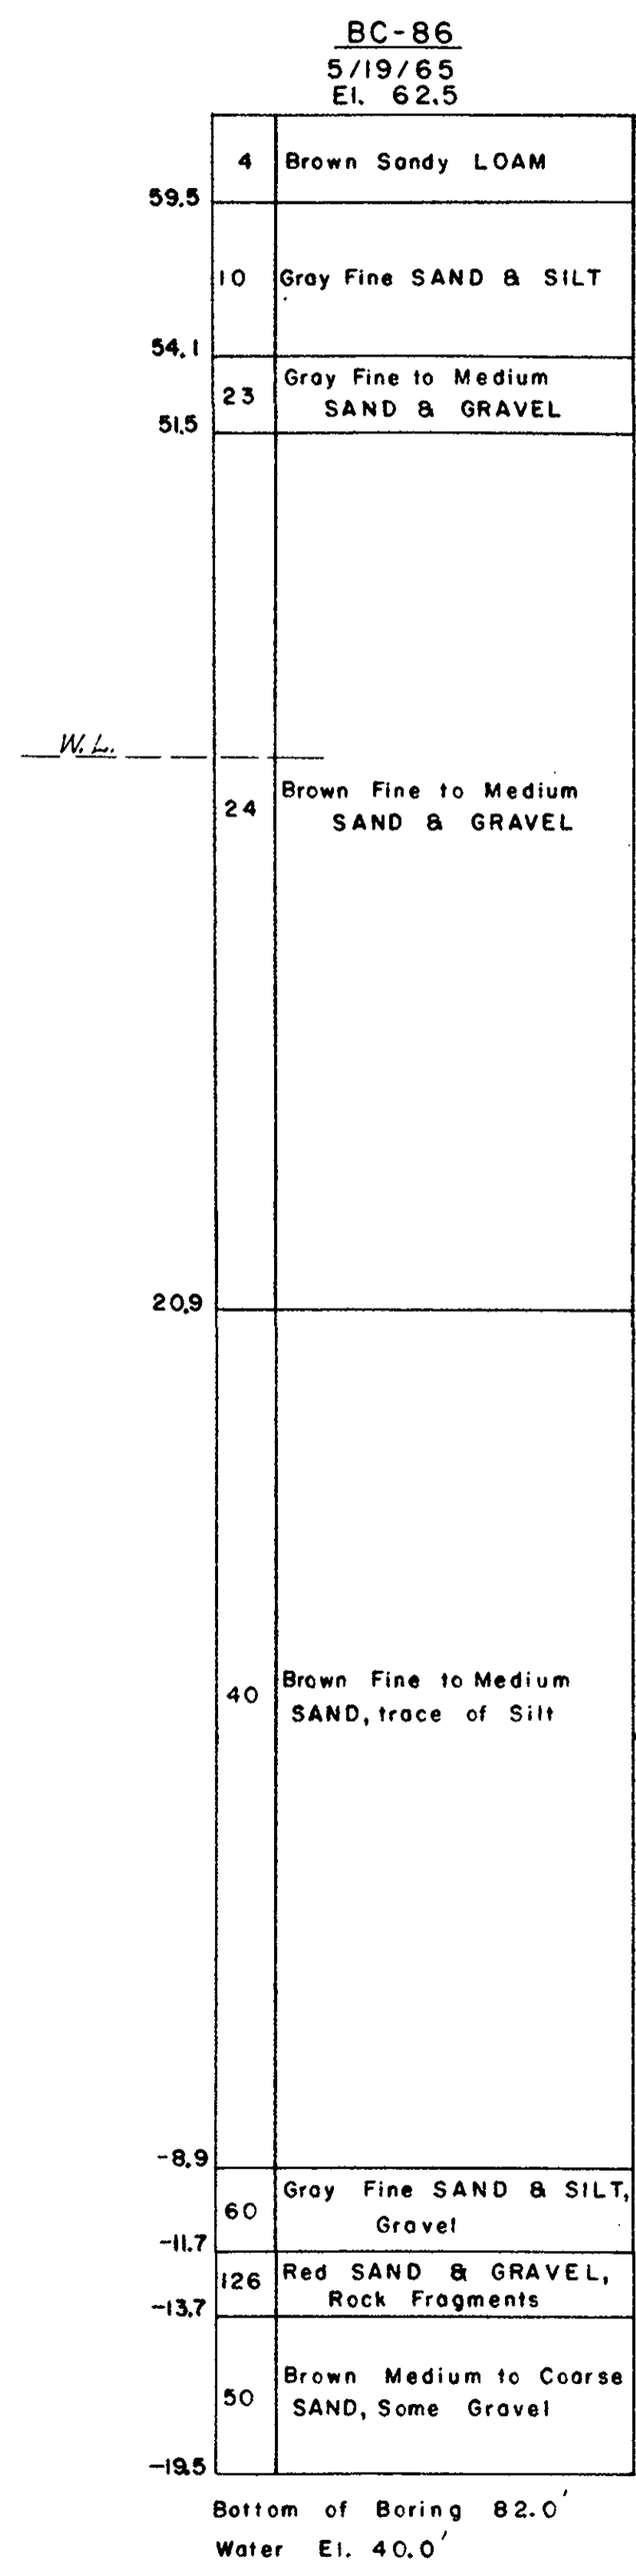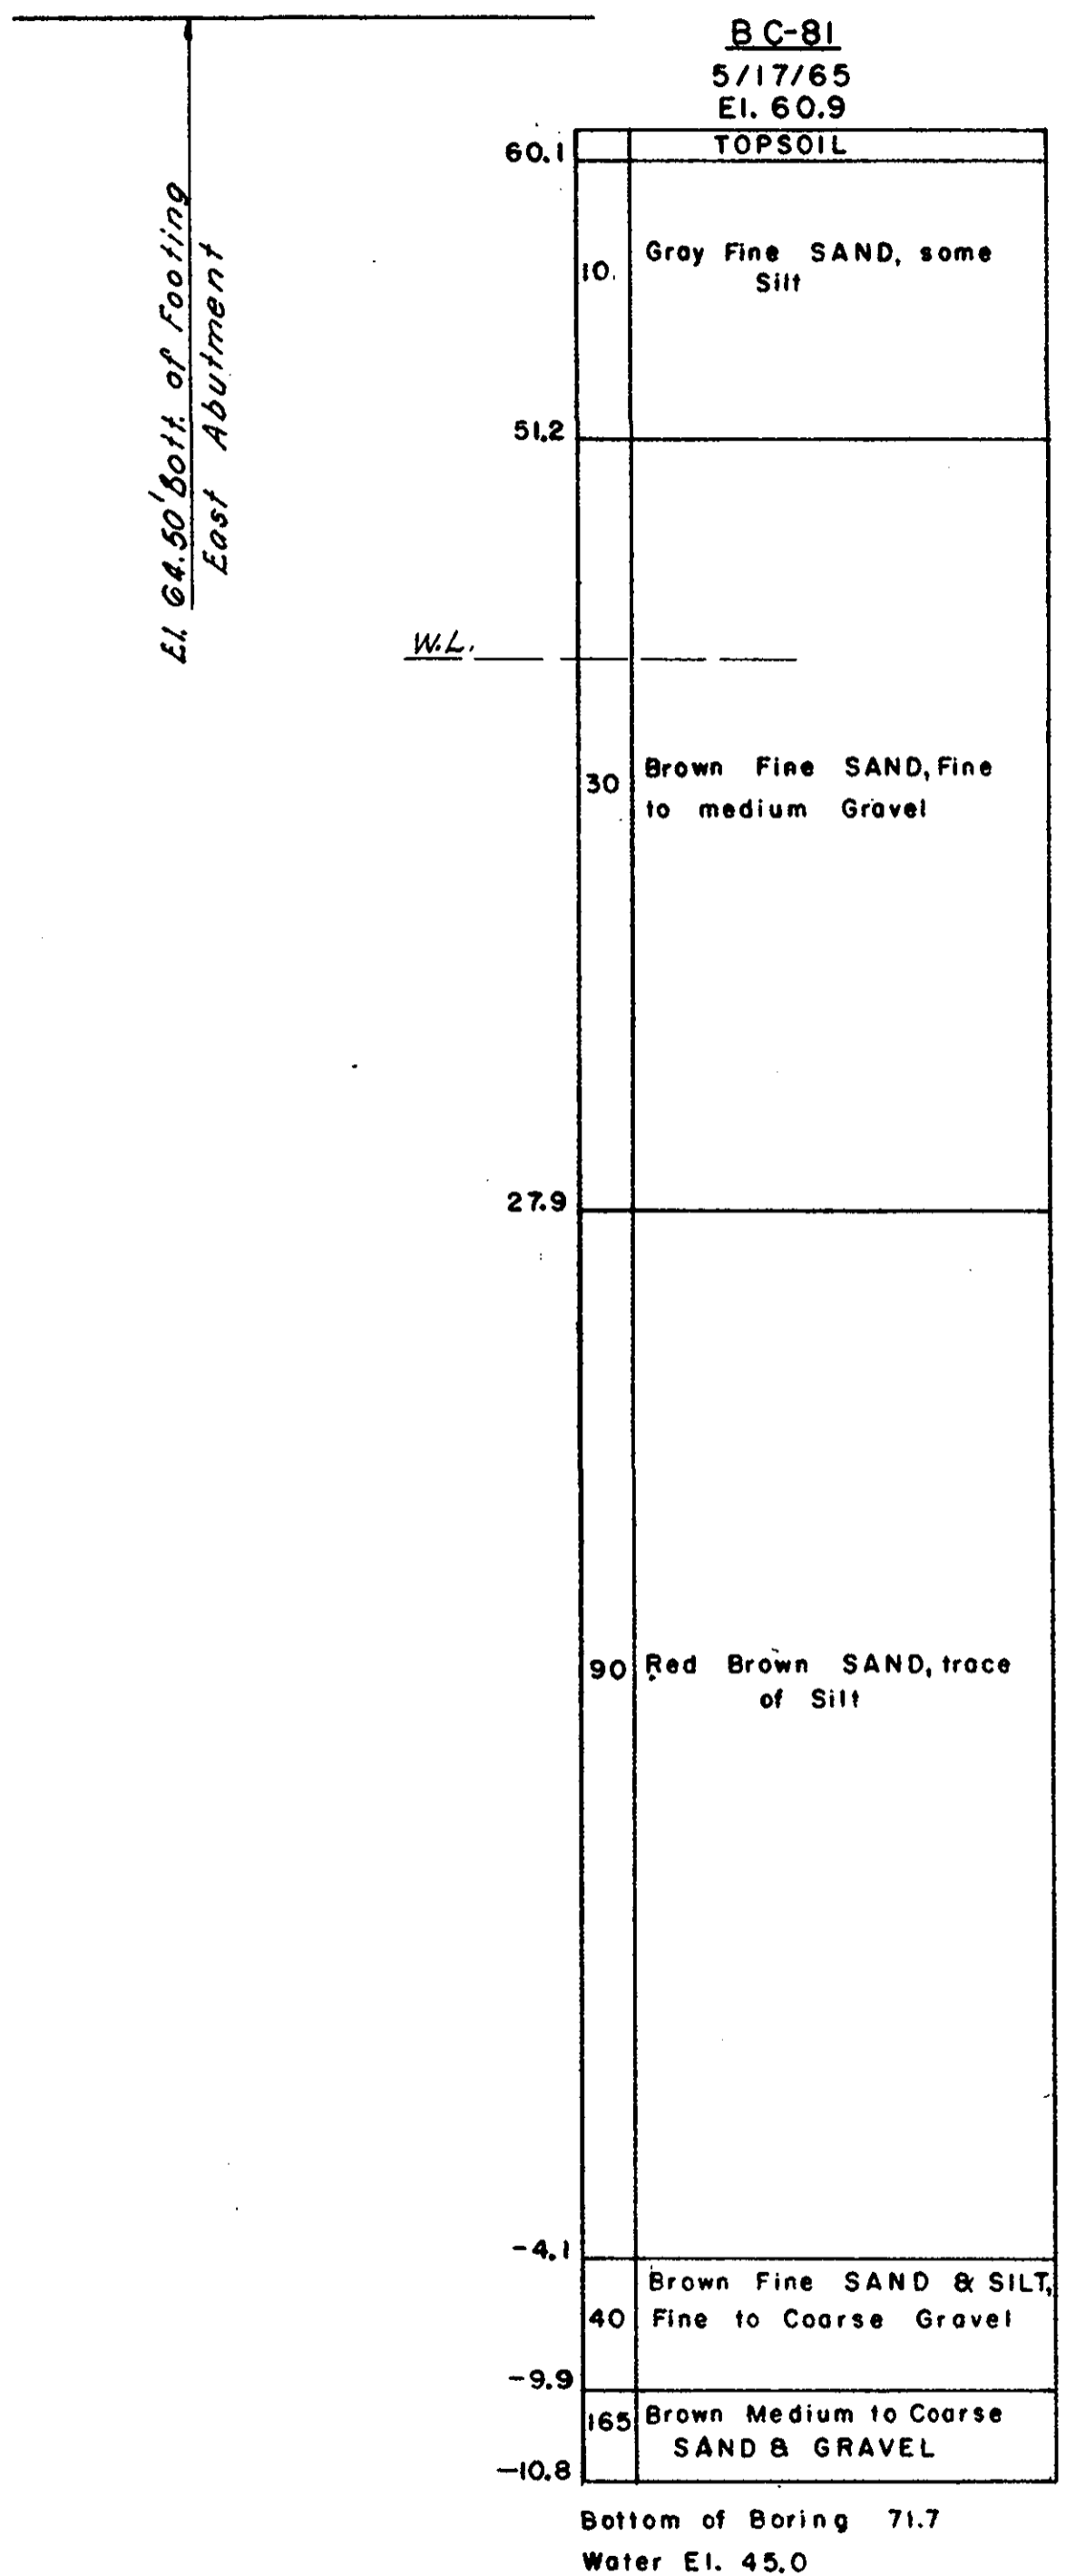


**BORING DATA**  
Scale: 3/8" = 1'0"

**BORING NOTES:**


Location of Borings shown on Key Plan, Sheet 1 thus: BC-81. BC indicates a Bridge Core Boring. Borings taken for purpose of Design & show conditions at Boring Points only but do not necessarily show Nature of Material to be encountered during construction. Figures in left hand column indicate Number of Blows required to drive 2" O.D. Sampler 12" using 140lb. weight falling 30". Borings were made by Allstate Drilling Co. 227 Wampanoag Trail, Riverside, R.I. Boring Samples may be seen at the Research and Materials Division, 99 Worcester Street, Wellesley Hills, at the intersection of Route 9 and Route 128. by appointment only. Water levels shown on the Borings Logs were observed at the time of taking borings and do not necessarily show the true ground water level.

APRIL 9, 1966	ISSUED FOR CONSTRUCTION
DATE	DESCRIPTION
	USE ONLY PRINTS OF LATEST DATE


PUB. RD. DIV. NO.	STATE	FED. AID PROJ. NO.	FISCAL YEAR	SHEET NO.	TOTAL SHEETS
1	MASS.	1-91-1(54)8	19	70	188

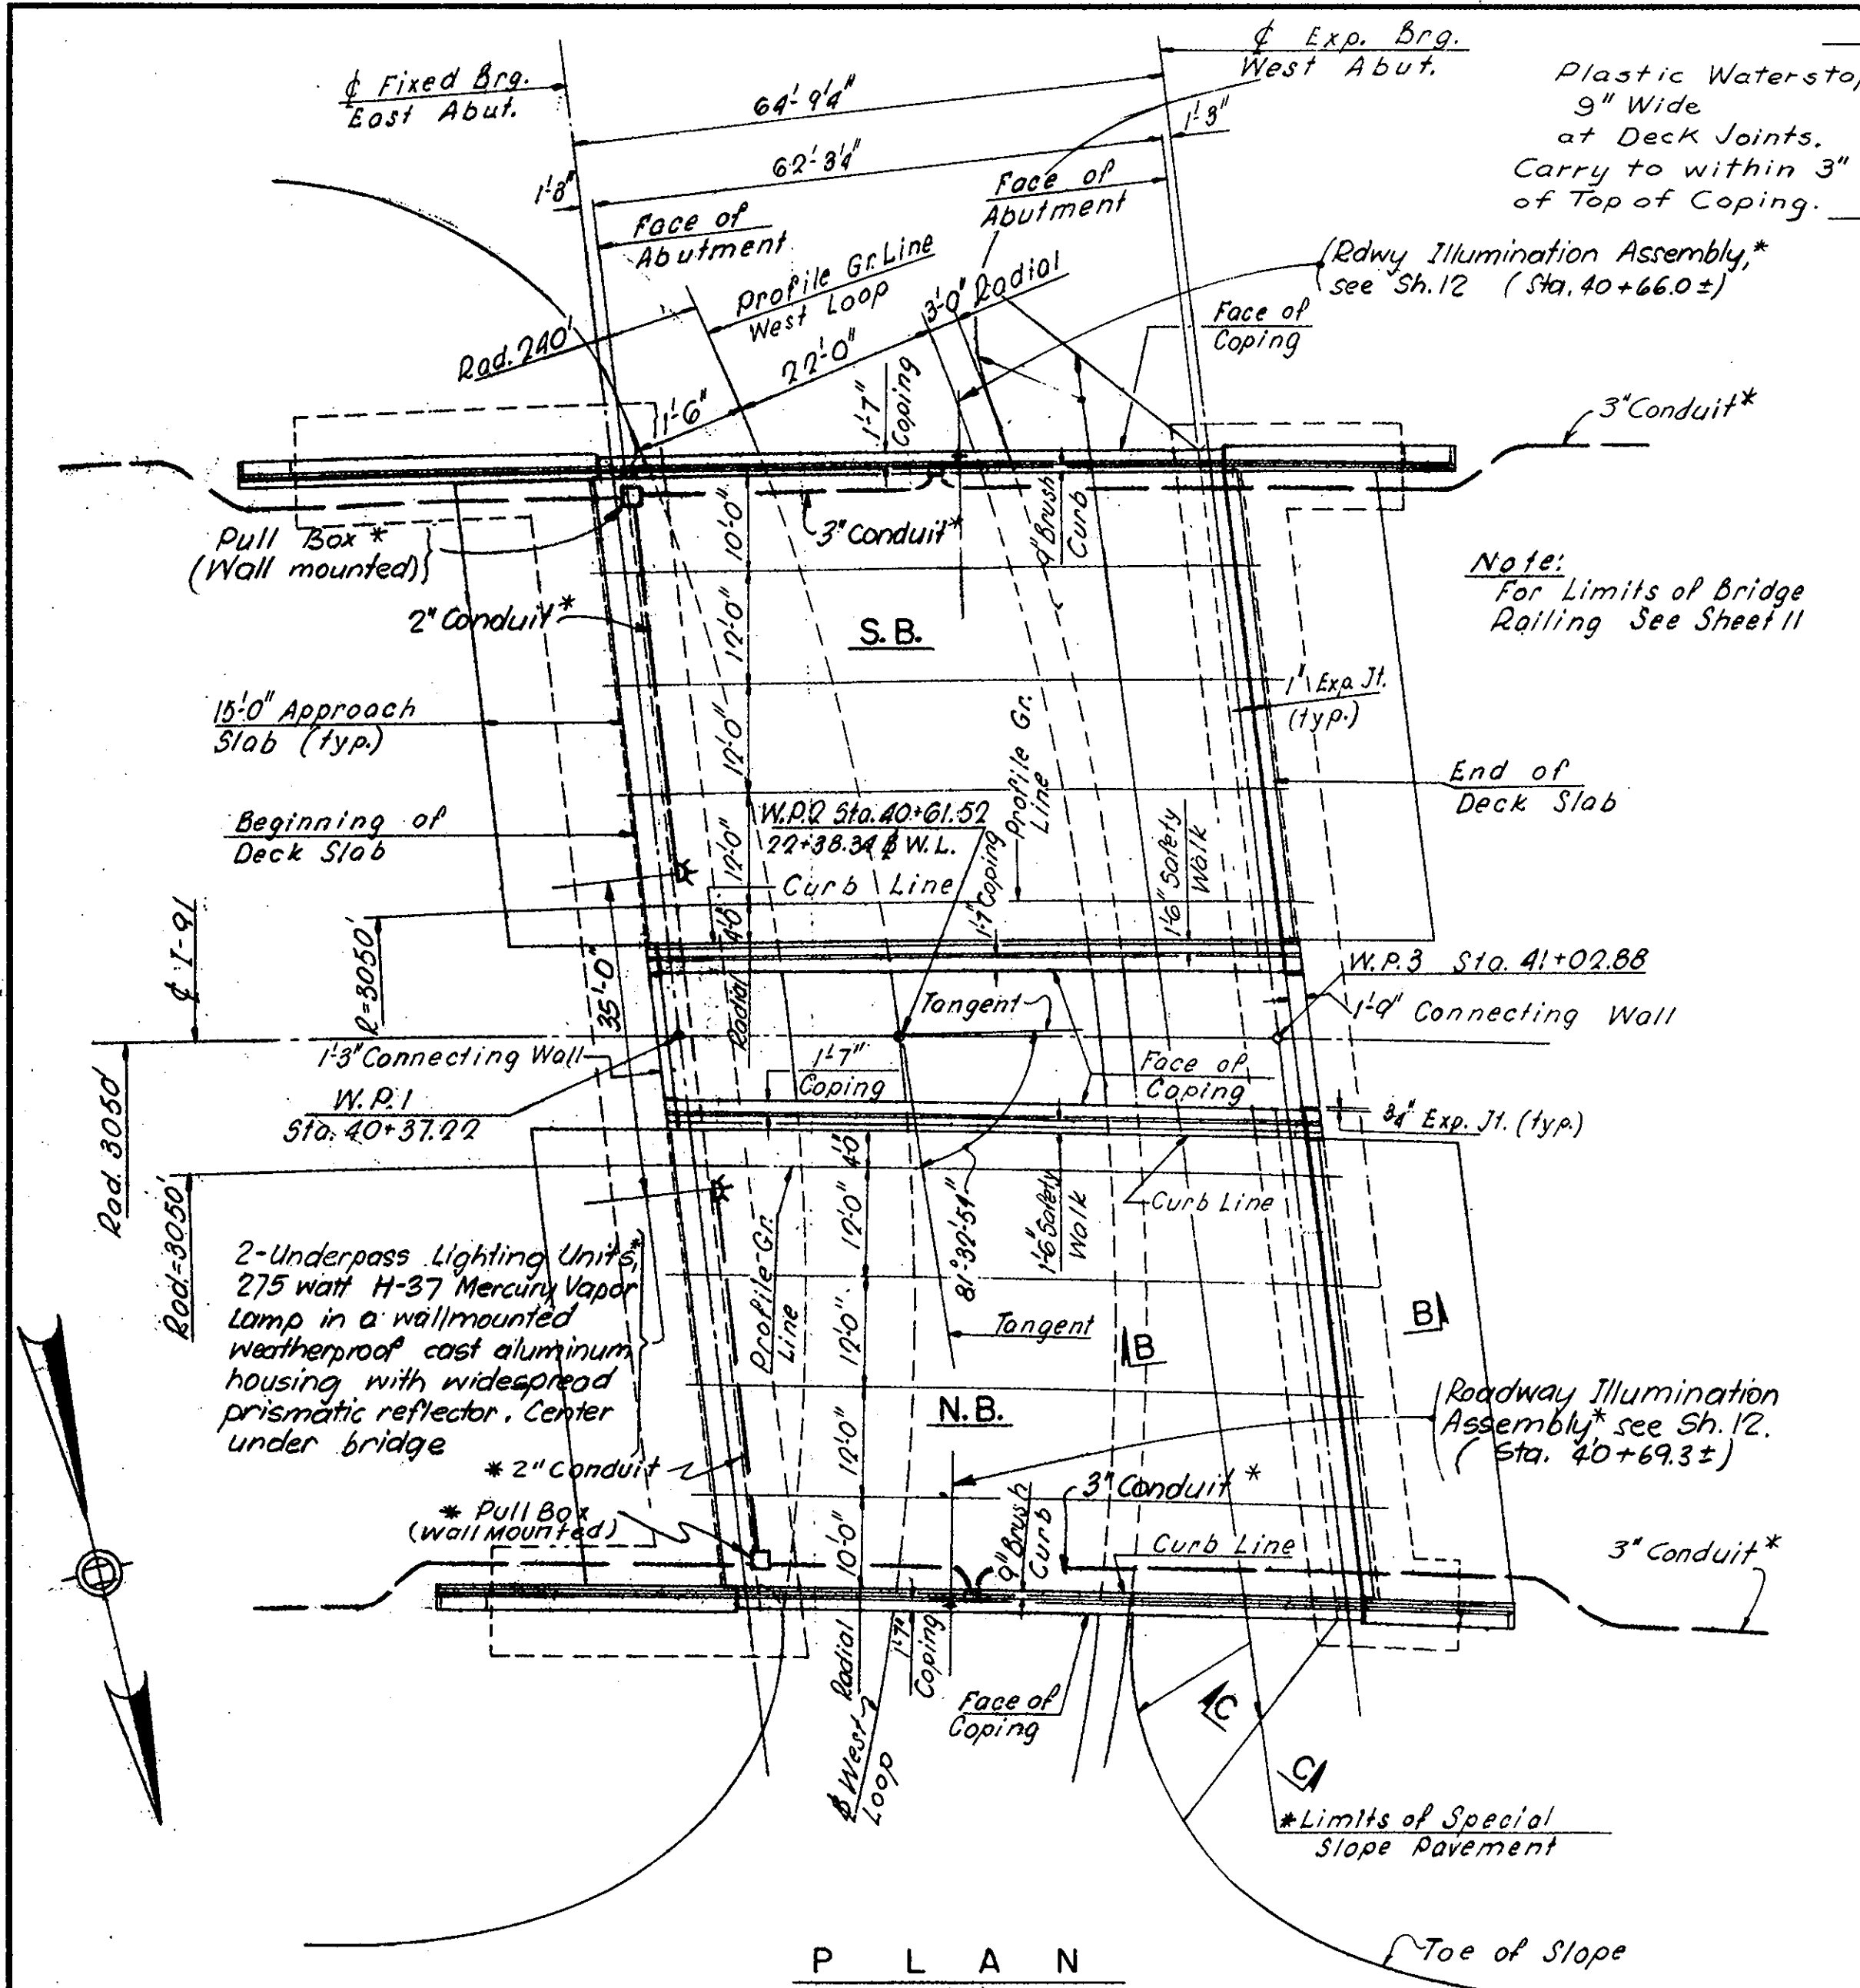


PLAN  
Scale: 1/8" = 1'-0"

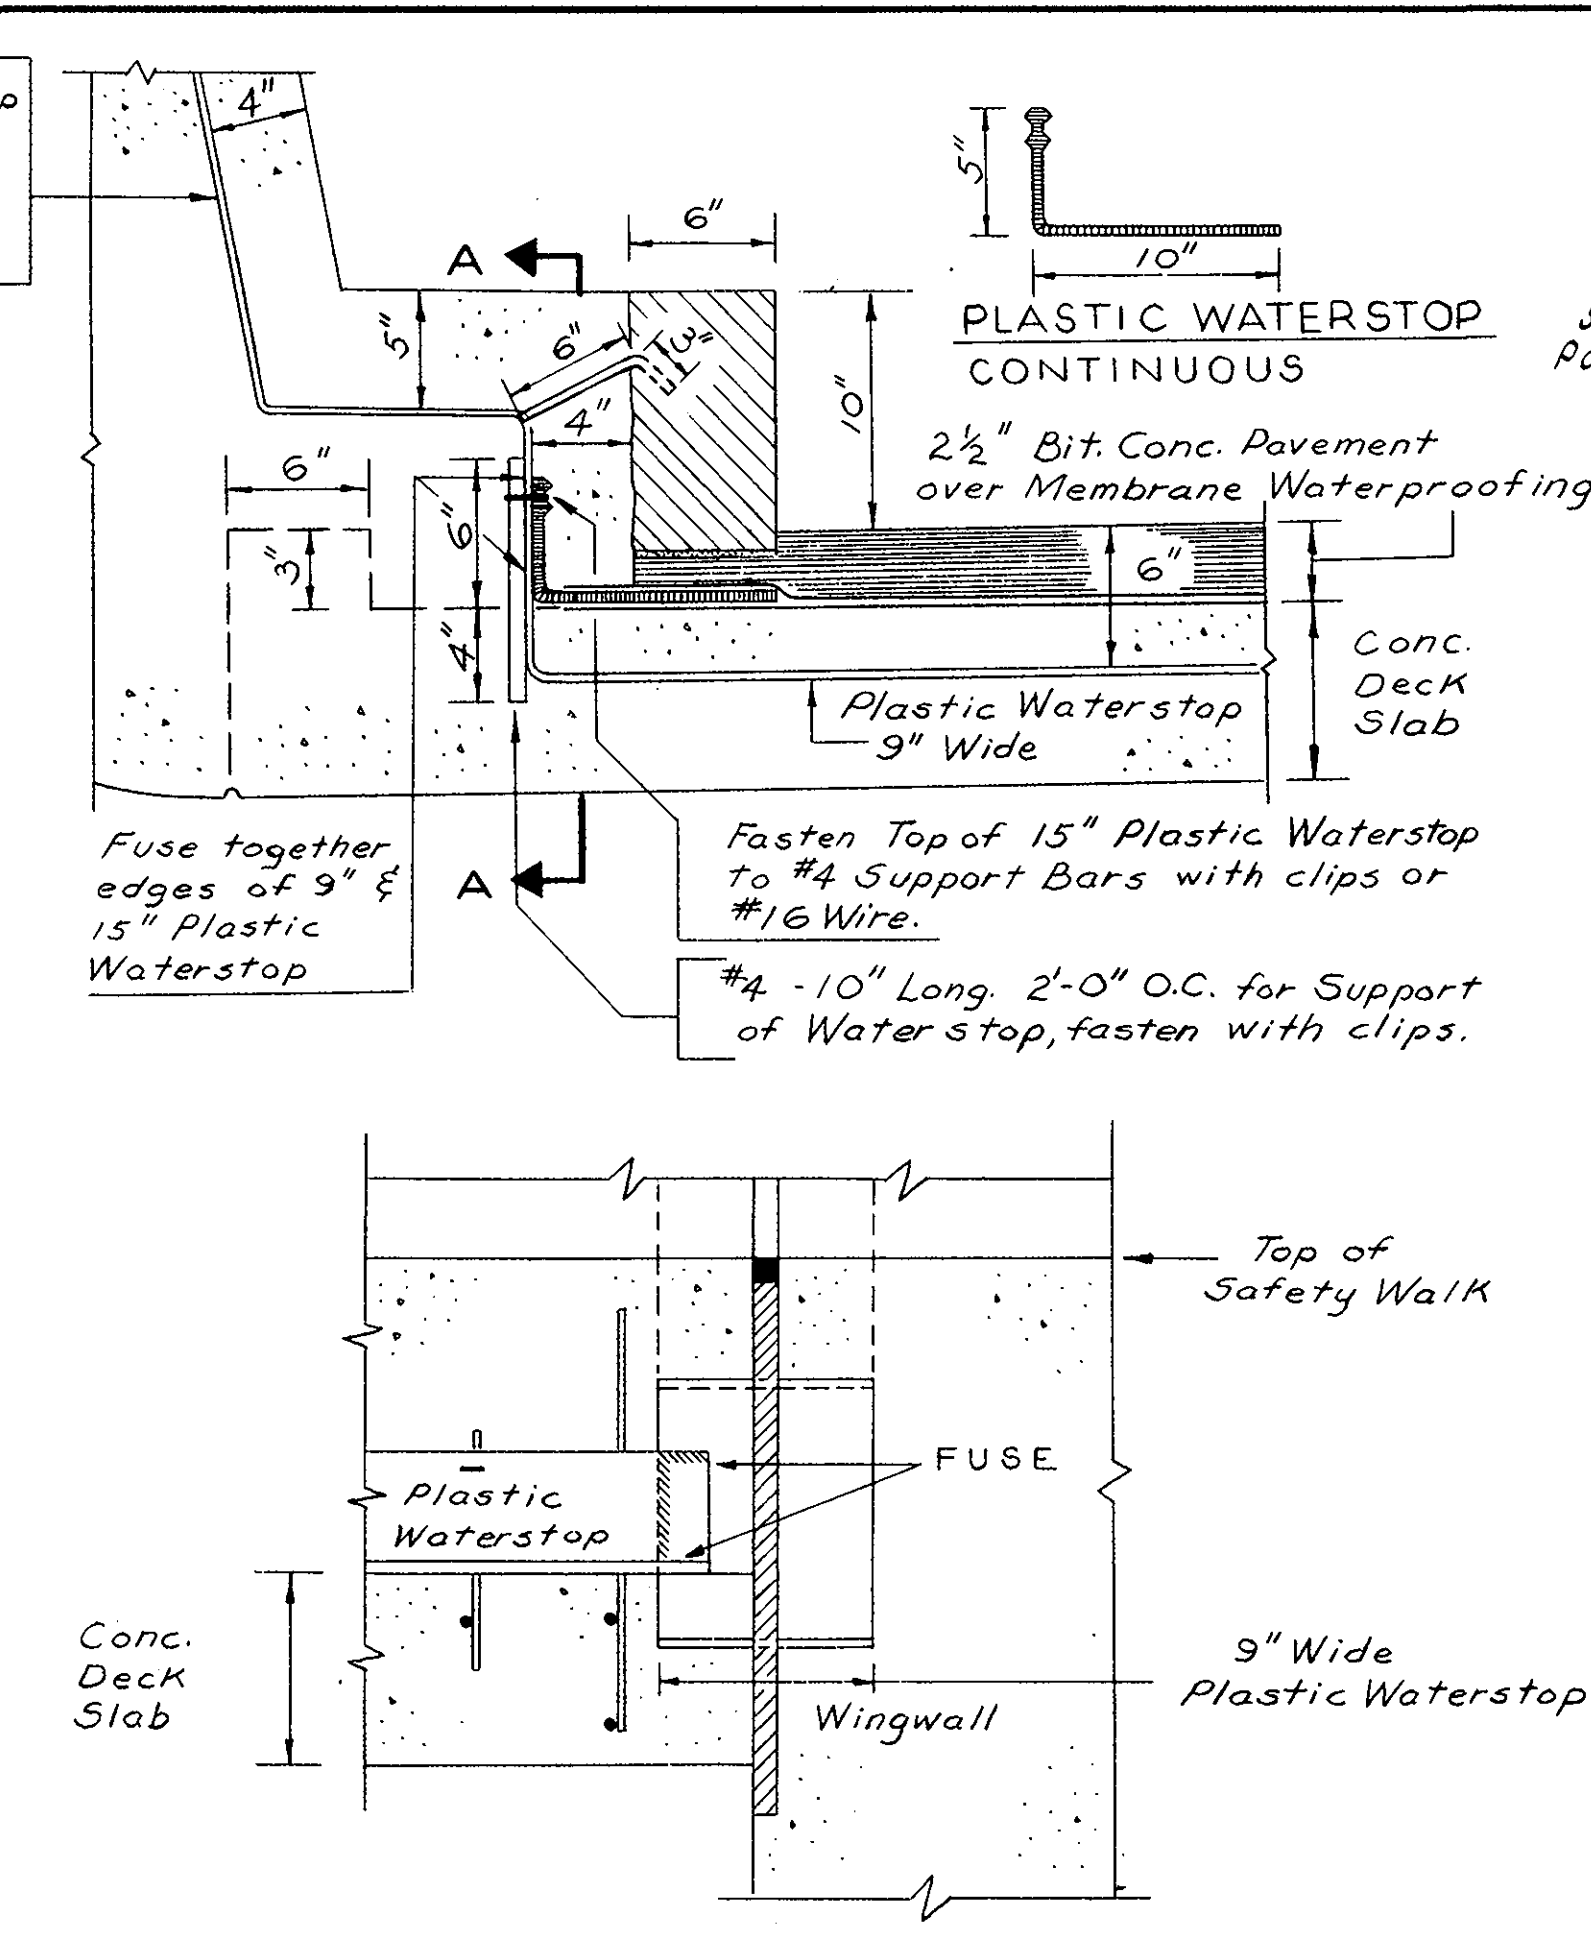


SECTION A-A  
CURB DETAIL AT DECK JOINT

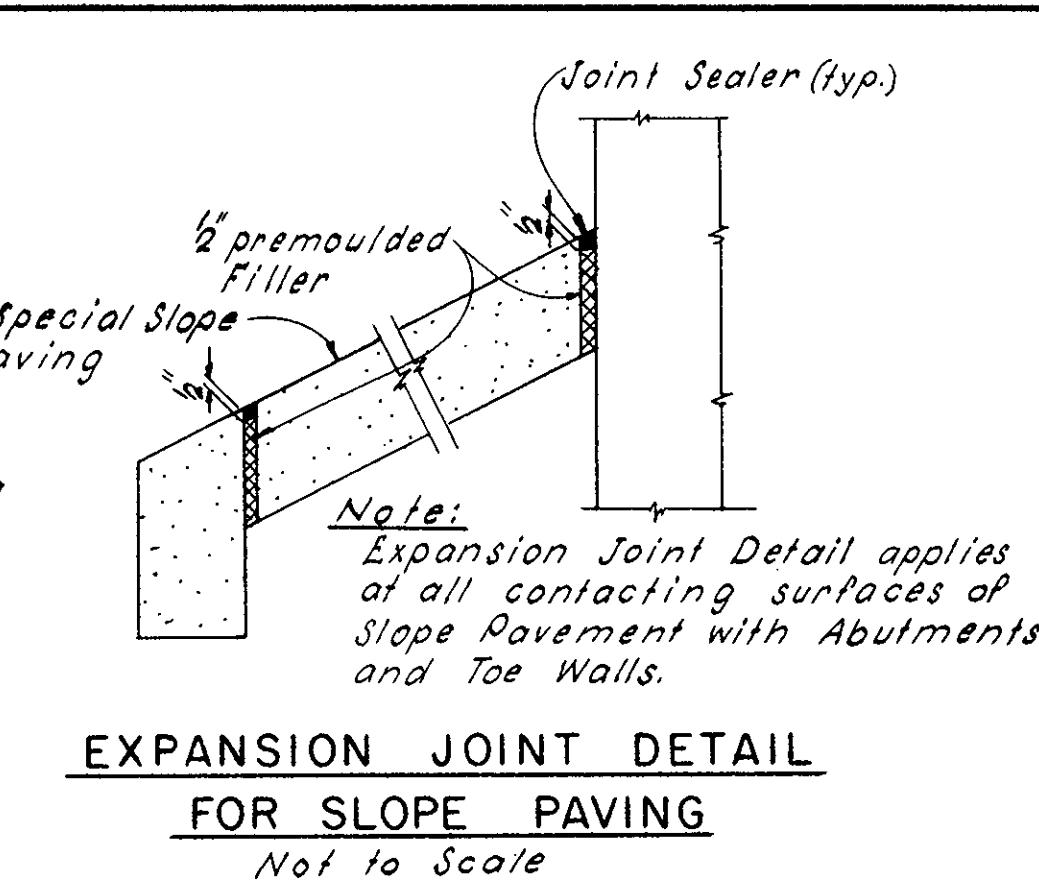


EXPANSION JOINT DETAIL  
FOR SLOPE PAVING  
Not to Scale

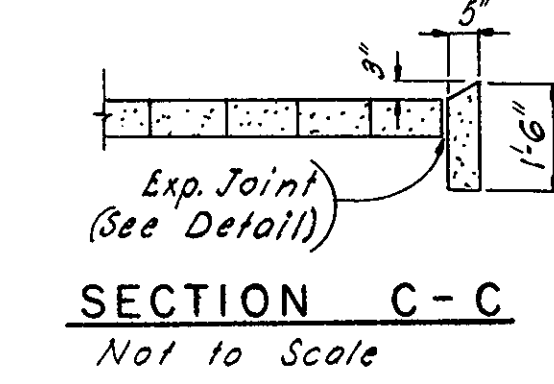

SECTION C-C  
Not to Scale

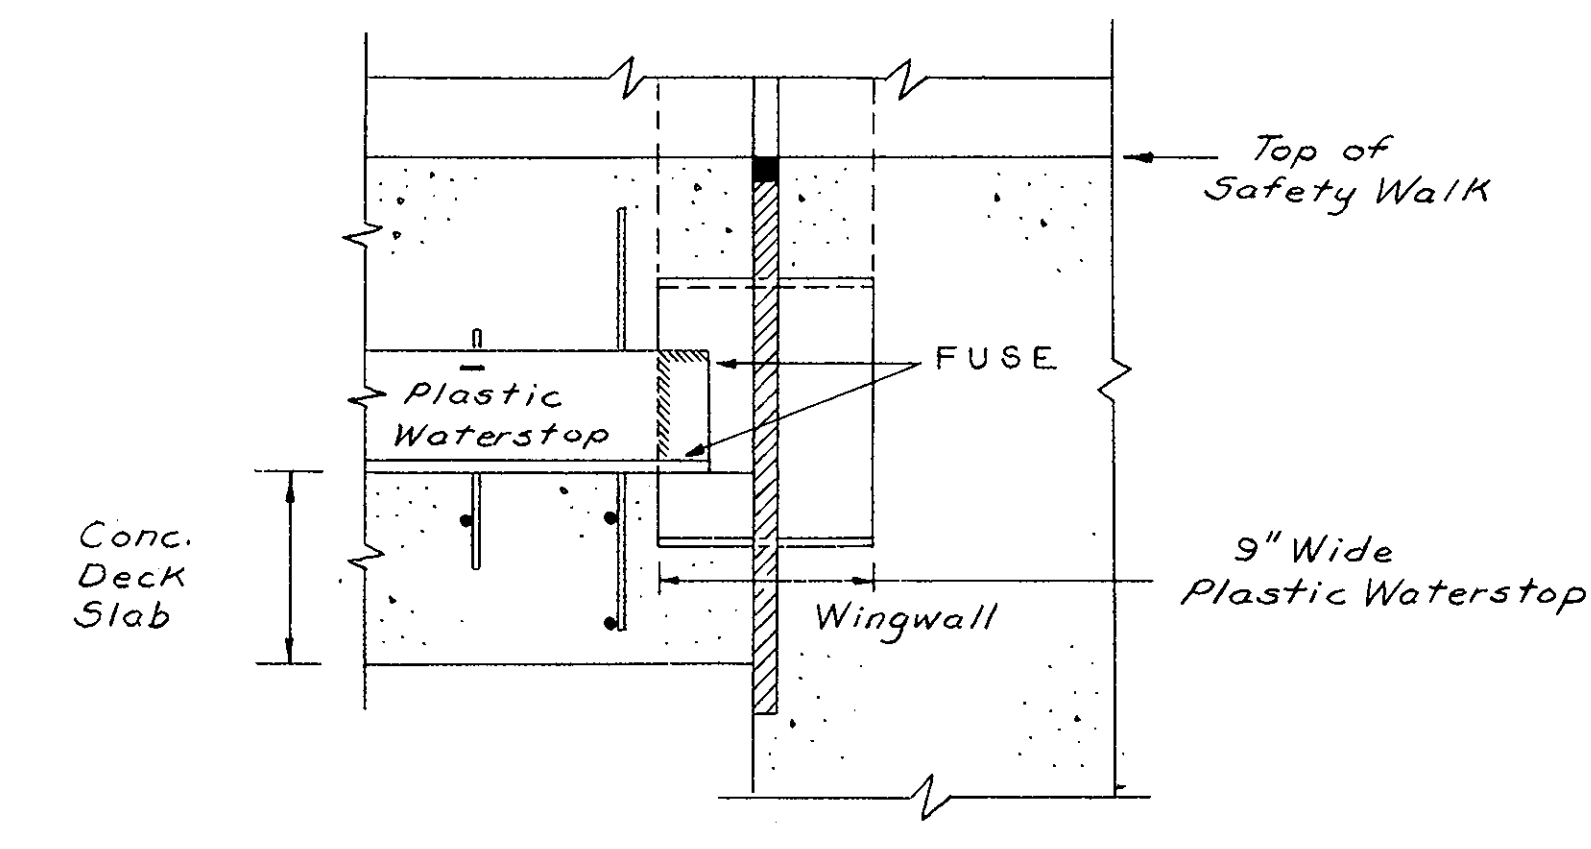


SECTION B-B  
DETAILS OF SPECIAL SLOPE PAVING  
Not to Scale

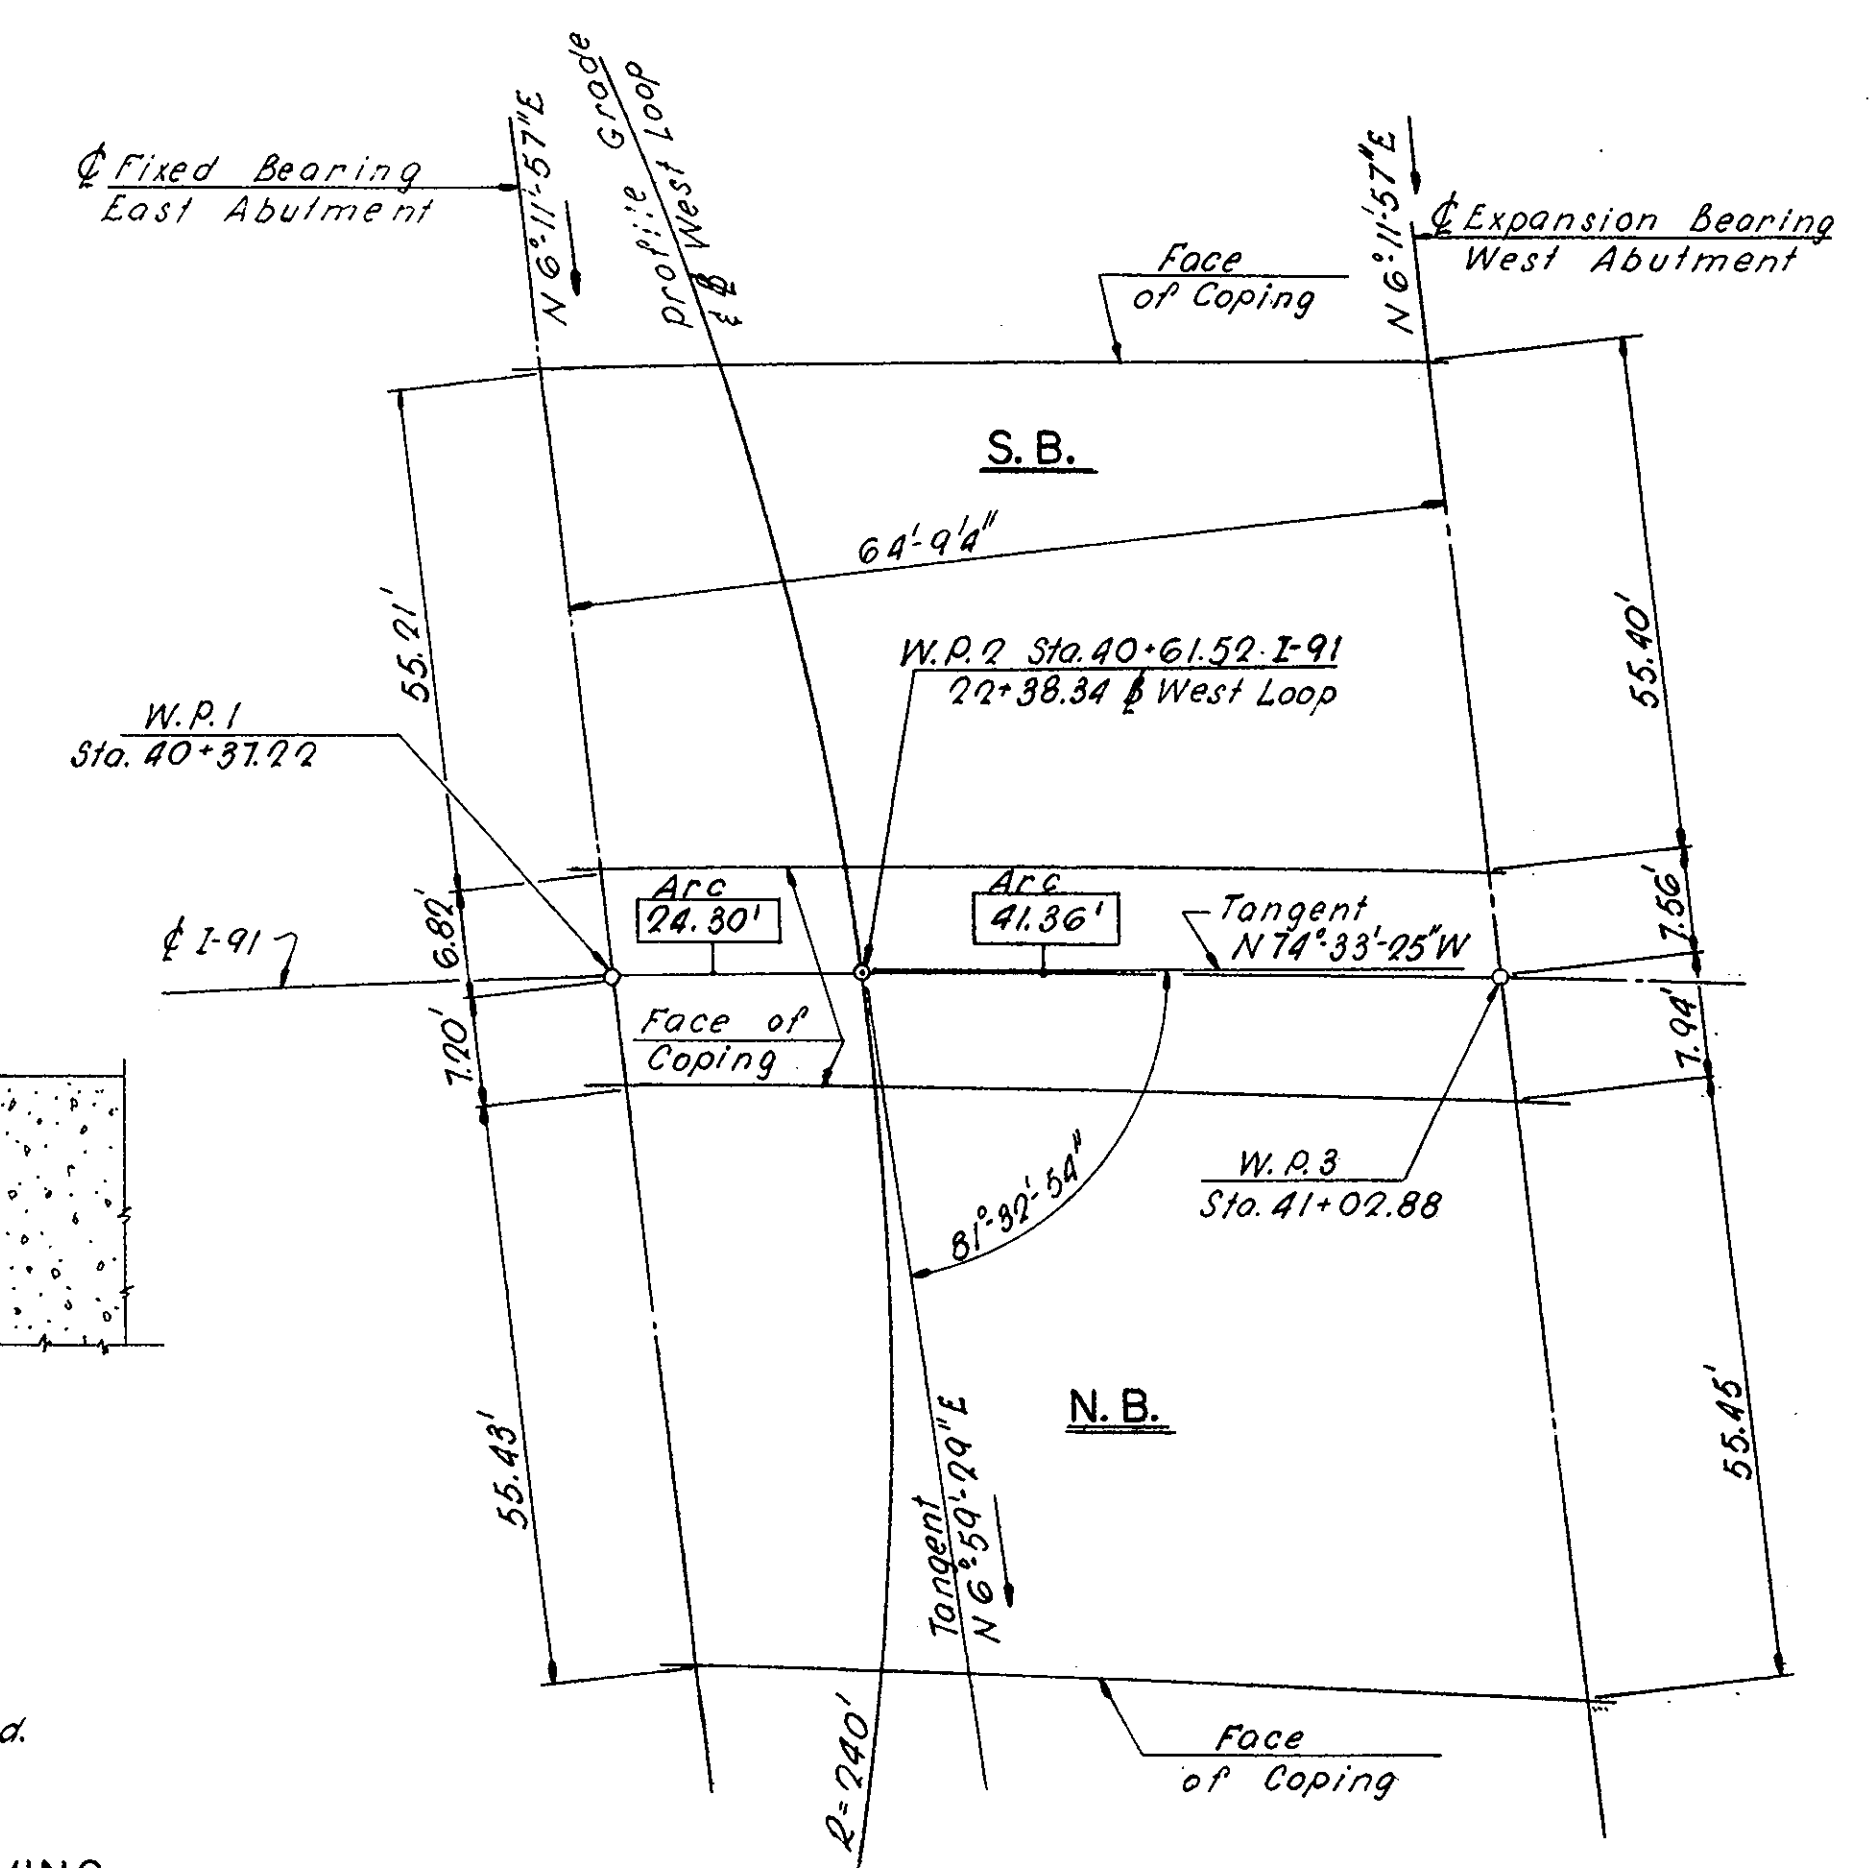


WORKING POINT DIAGRAM  
Not to Scale

Note: Dimension denotes distance between W.P.s

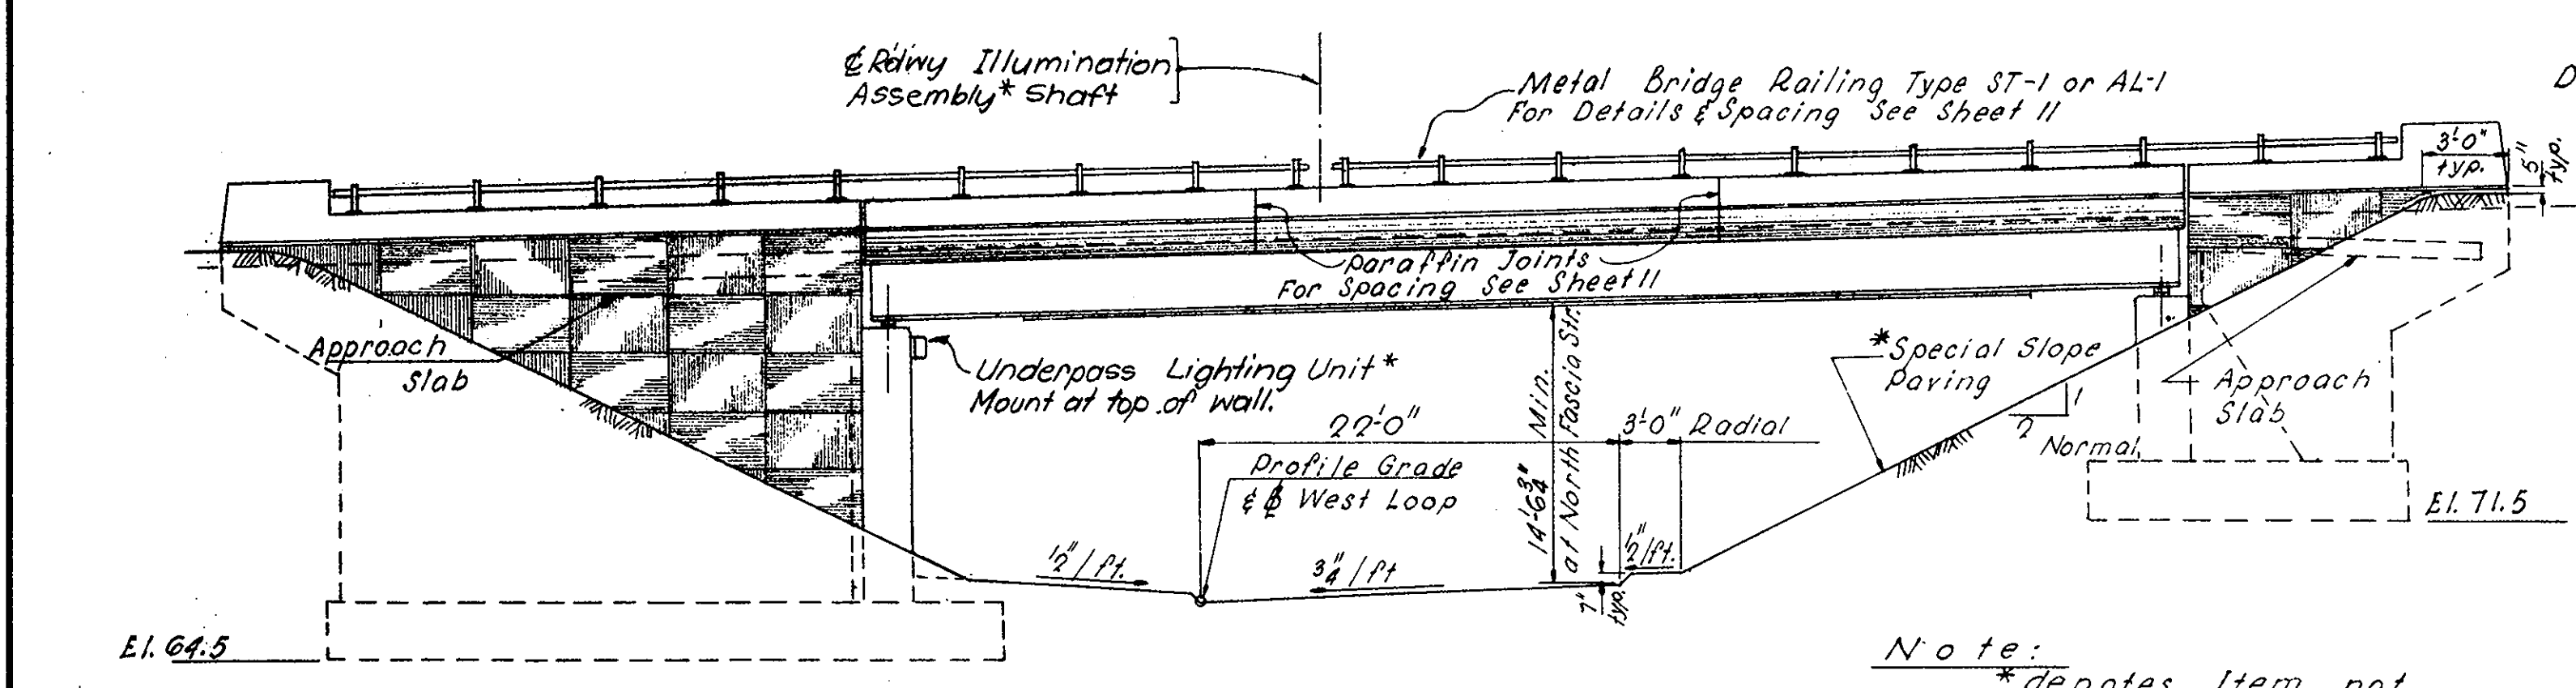

ELEVATION  
Scale: 1/8" = 1'-0"

Note: \*denotes item not included in Bridge estimate. For Rail Post spacing & other details see Sheet 11.

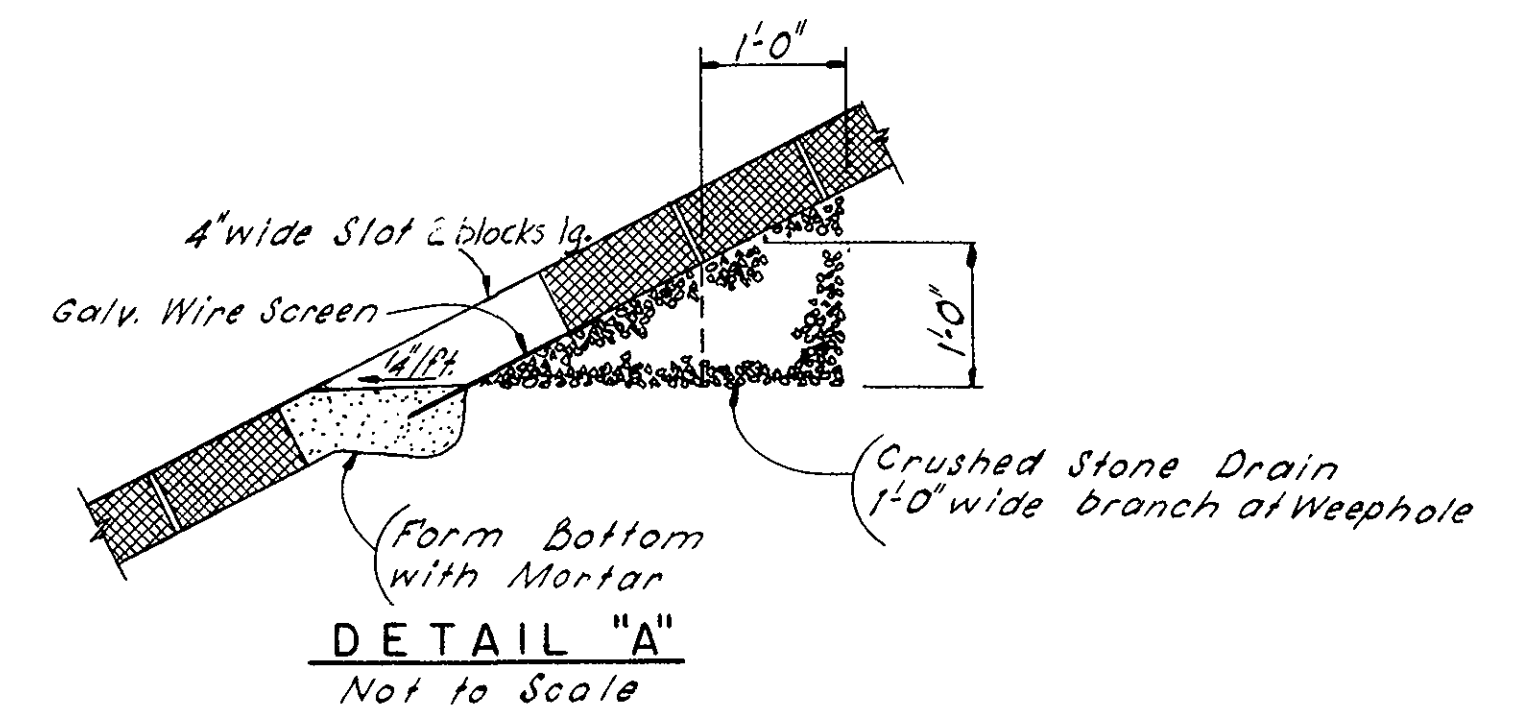


DETAIL "A"  
Not to Scale

APRIL 9, 1966	ISSUED FOR CONSTRUCTION
DATE	DESCRIPTION
	USE ONLY PRINTS OF LATEST DATE




PUR. RD. DIV. NO.	STATE	FED. AID PROJ. NO.	FISCAL YEAR	SHEET NO.	TOTAL SHEETS
1	MASS.	1541(54)S	19	72	188


Reference Notes:  
1. For Sections D-D, E-E & F-F  
& Footing Layout See Sheet 6

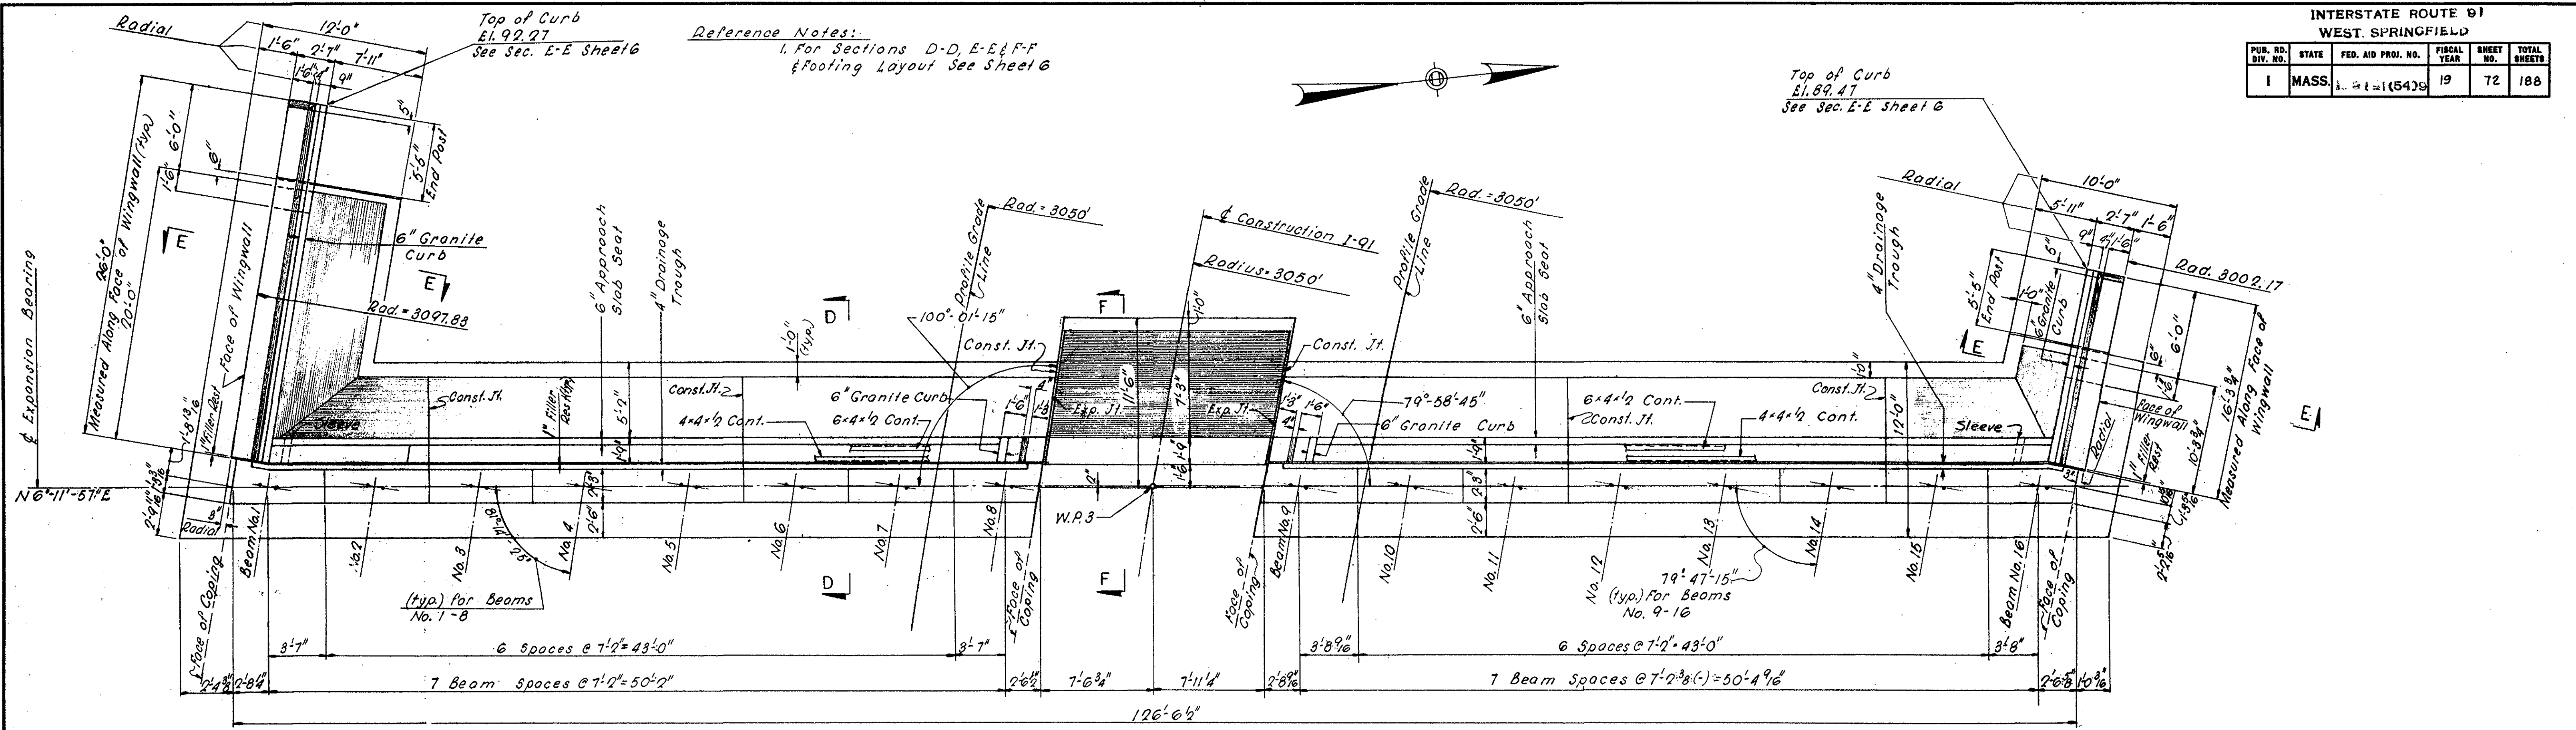


PLAN

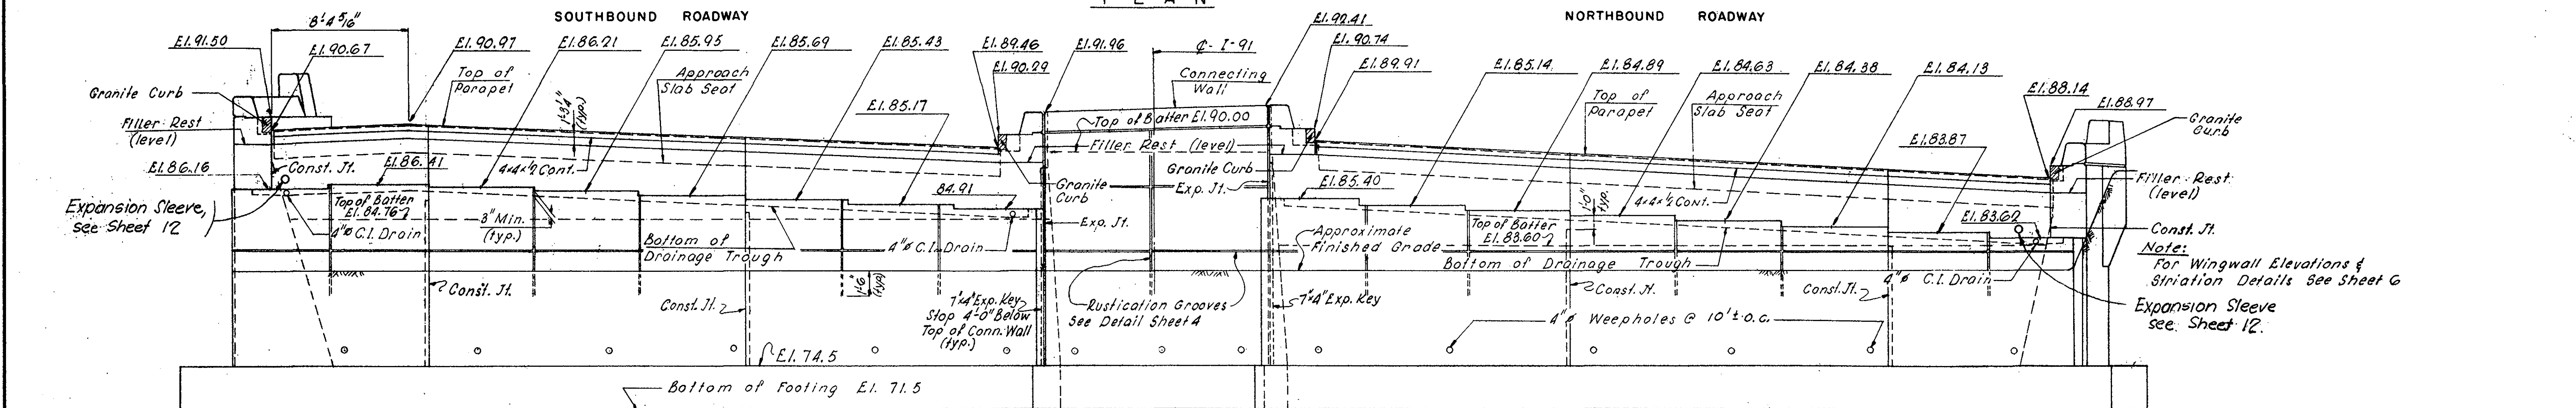


ELEVATION  
WEST ABUTMENT  
Scale: 3/8" = 1'-0"

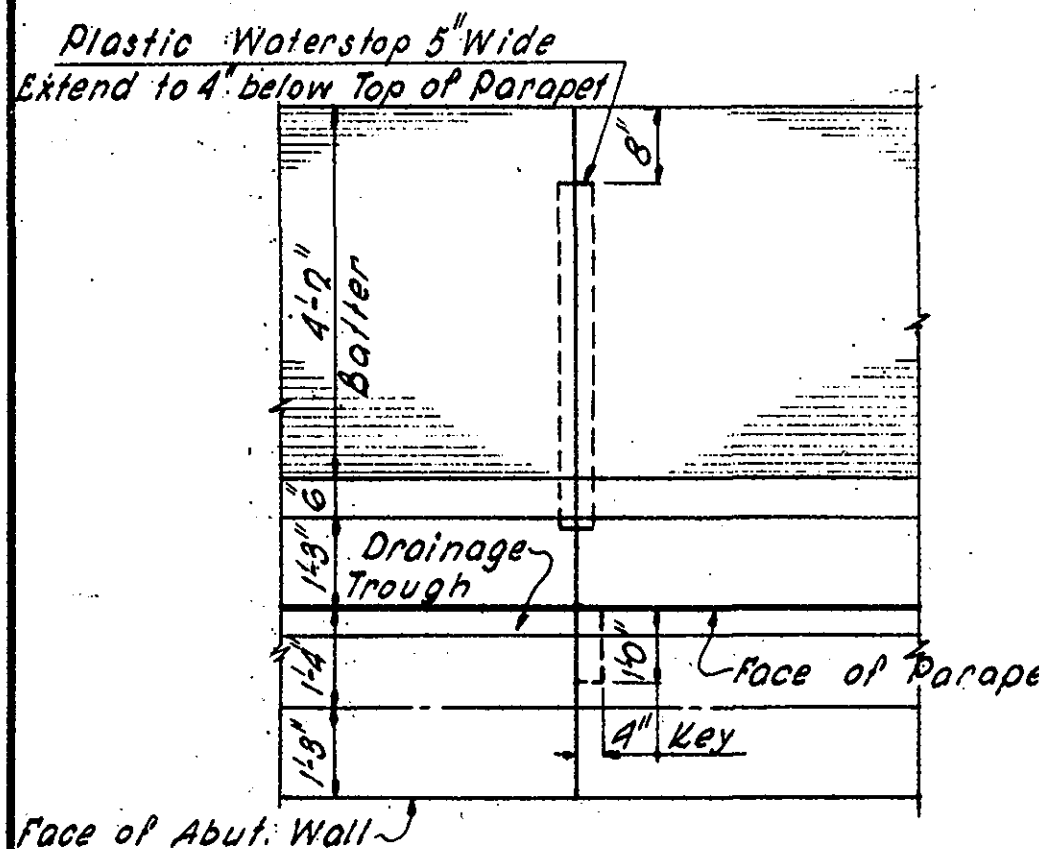

CONSTRUCTION JOINT  
Scale: 3/8" = 1'-0"

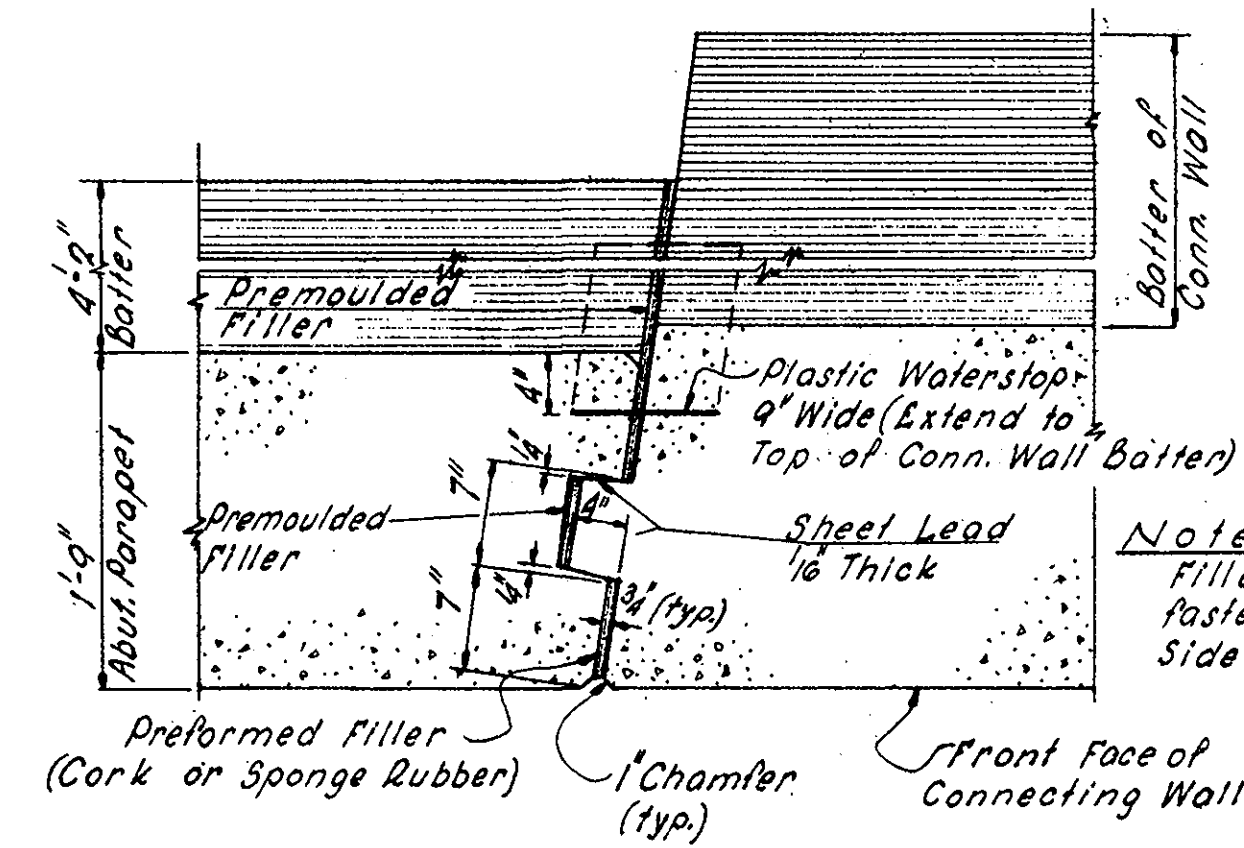

EXPANSION JOINT  
Scale: 1/2" = 1'-0"

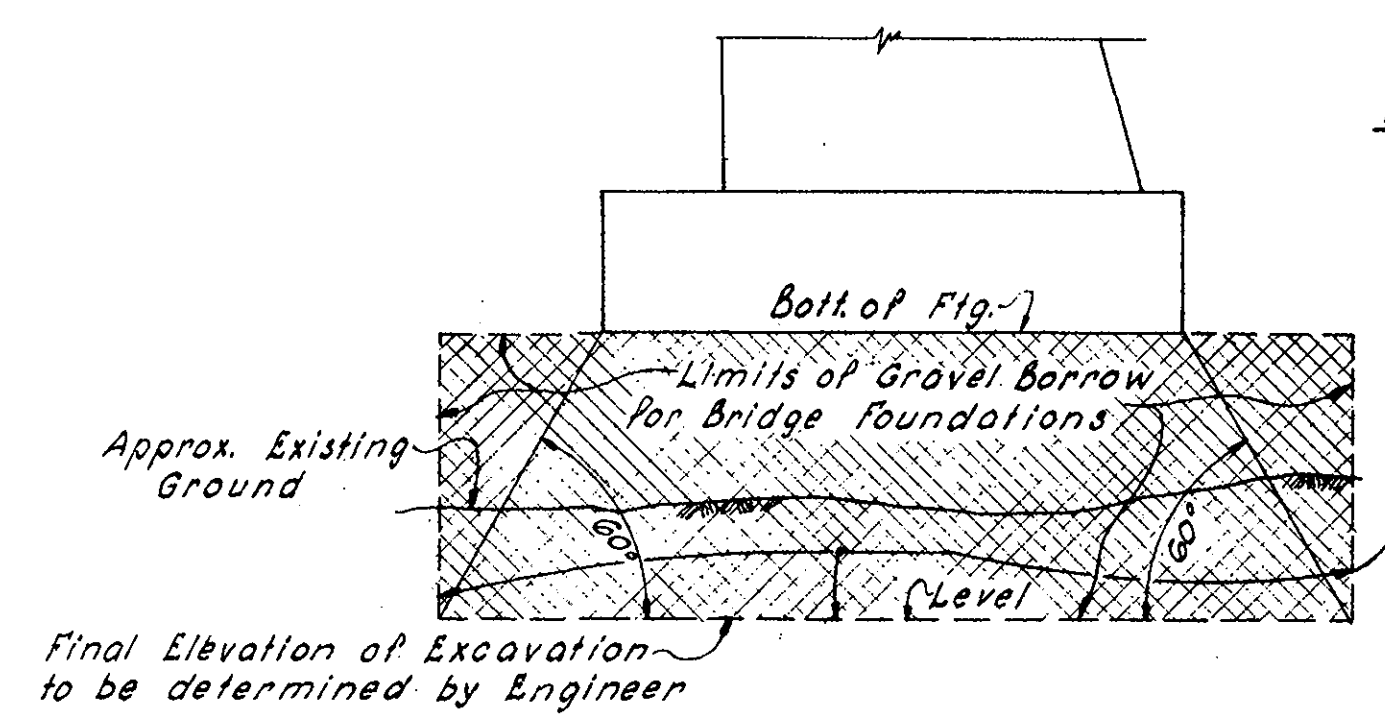


LIMITS OF BRIDGE EXCAVATION AND  
LIMITS OF GRAVEL BORROW  
FOR BRIDGE FOUNDATIONS  
Not to Scale


Notes:  
Same Treatment to be used at Wingwalls. See Standard Specifications for Compaction.

Limits of Bridge Excavation. Upper Limit of Bridge Excavation to be Bottom of "Topsoil Excavated and Stacked".


APRIL 9, 1966	ISSUED FOR CONSTRUCTION
DATE	DESCRIPTION
	USE ONLY PRINTS OF LATEST DATE

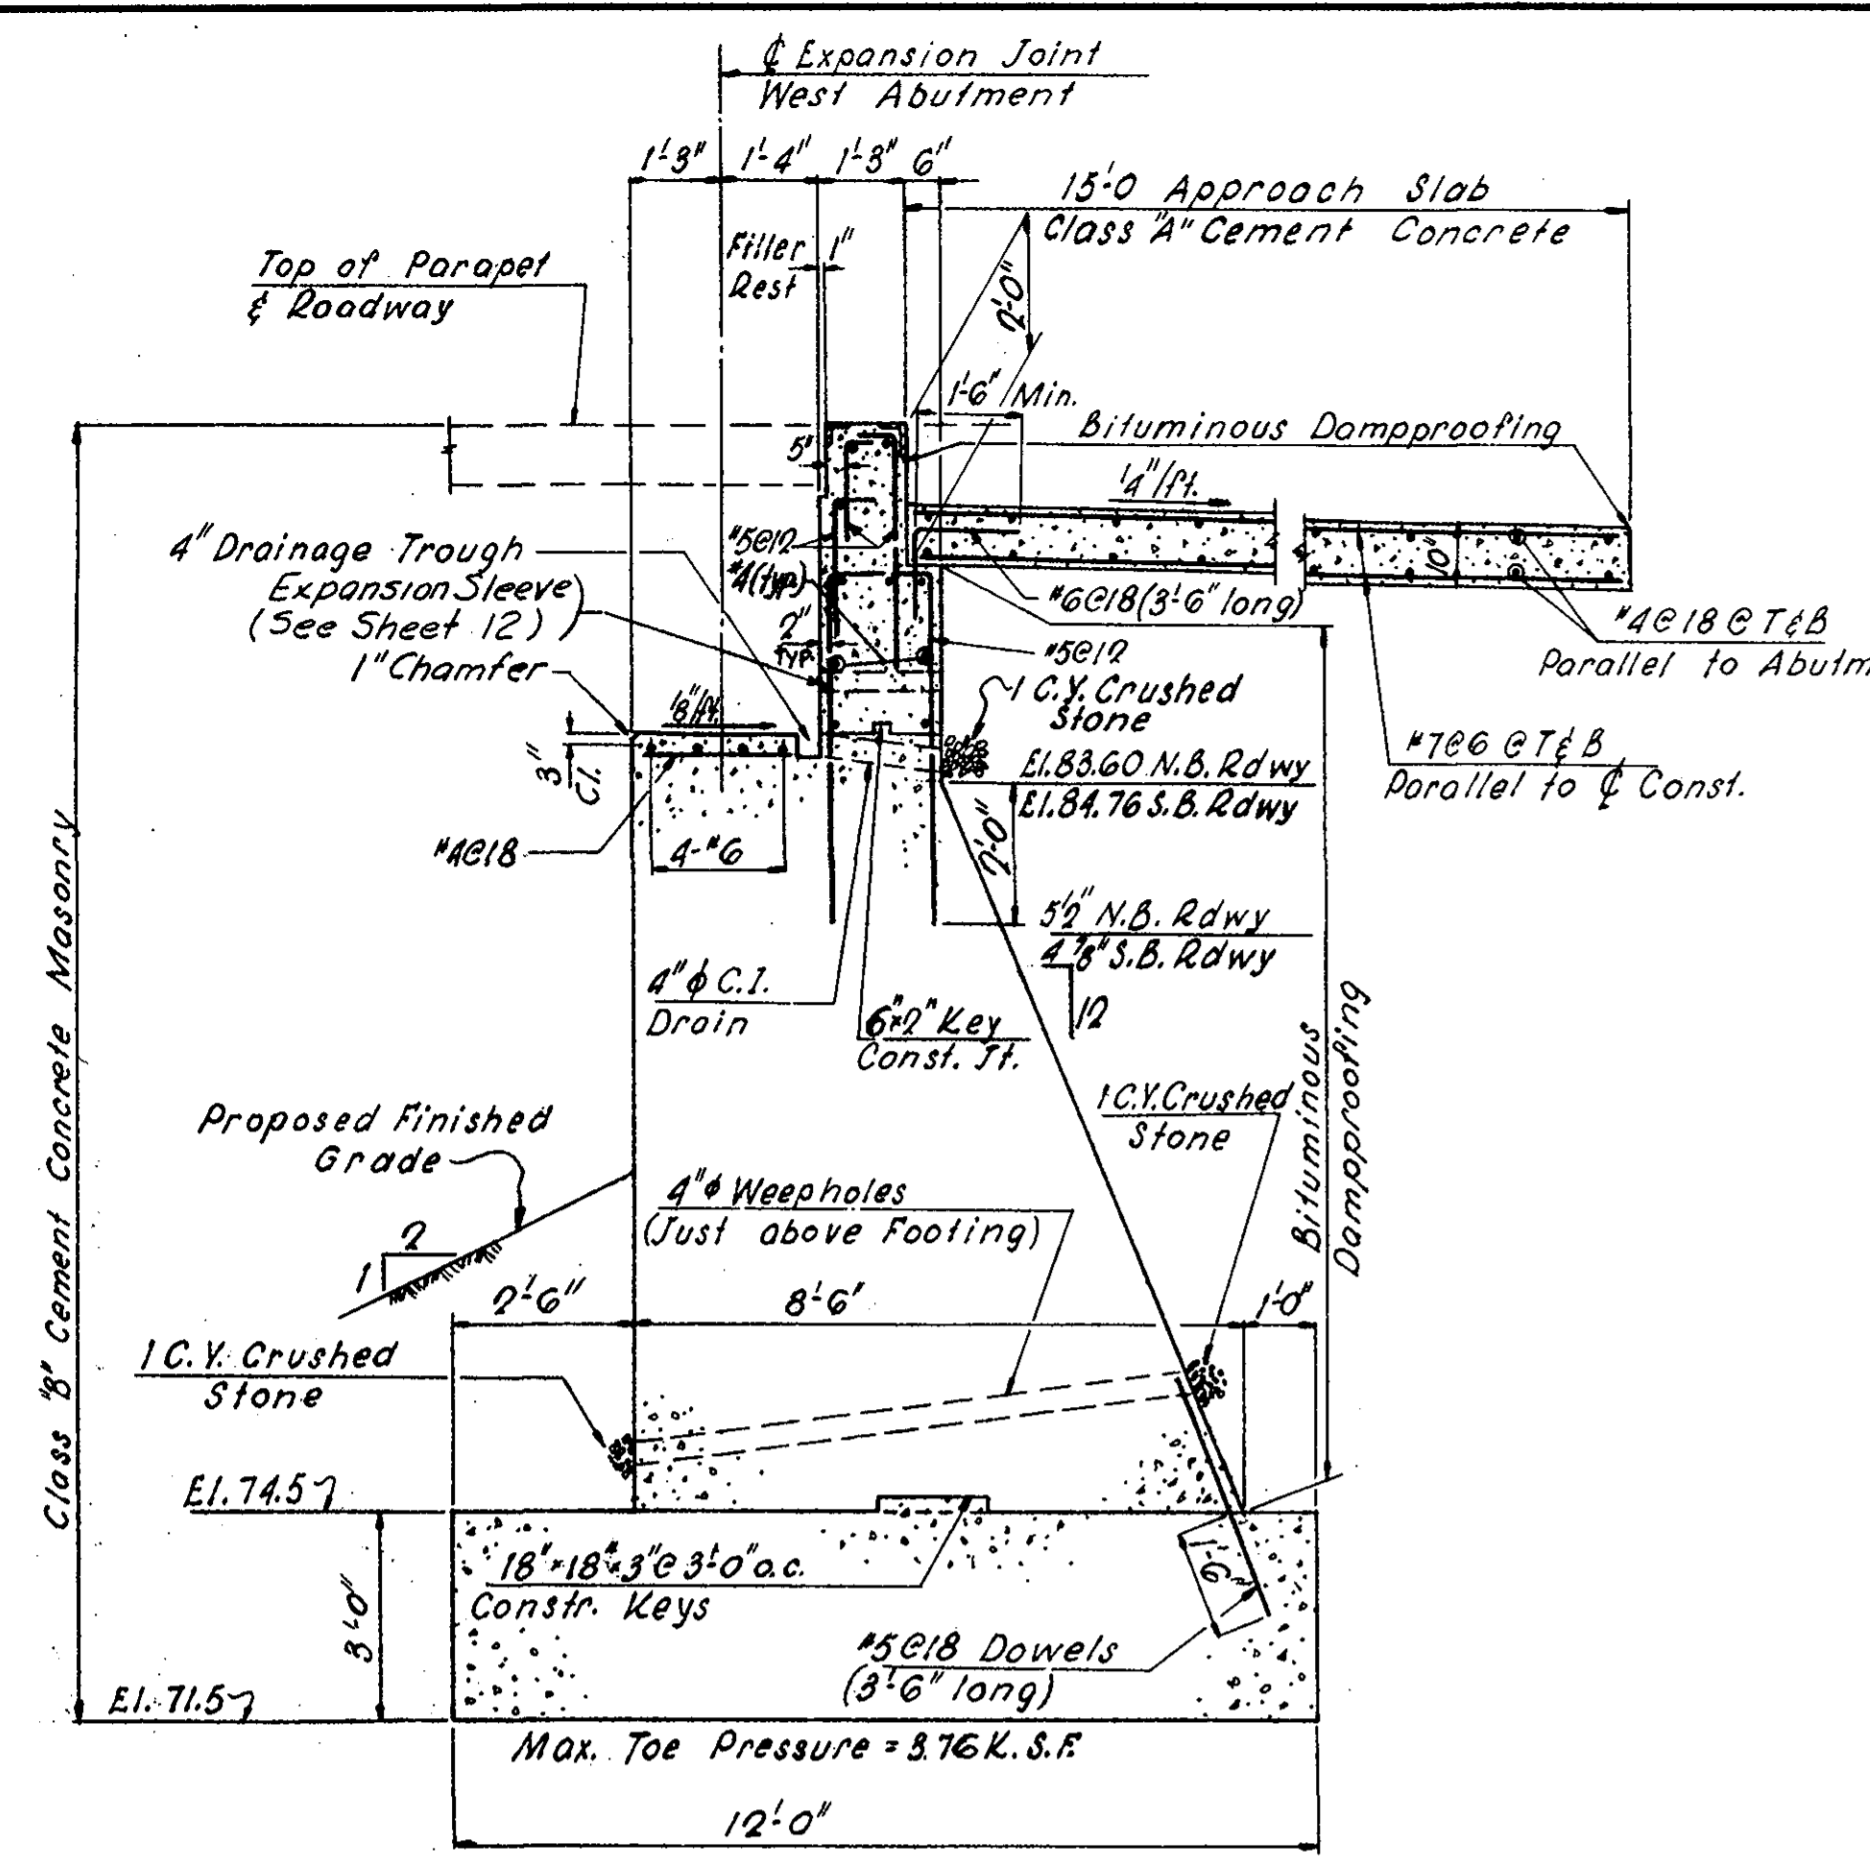


SECTION D-D  
Scale: 3/8" = 1'-0"

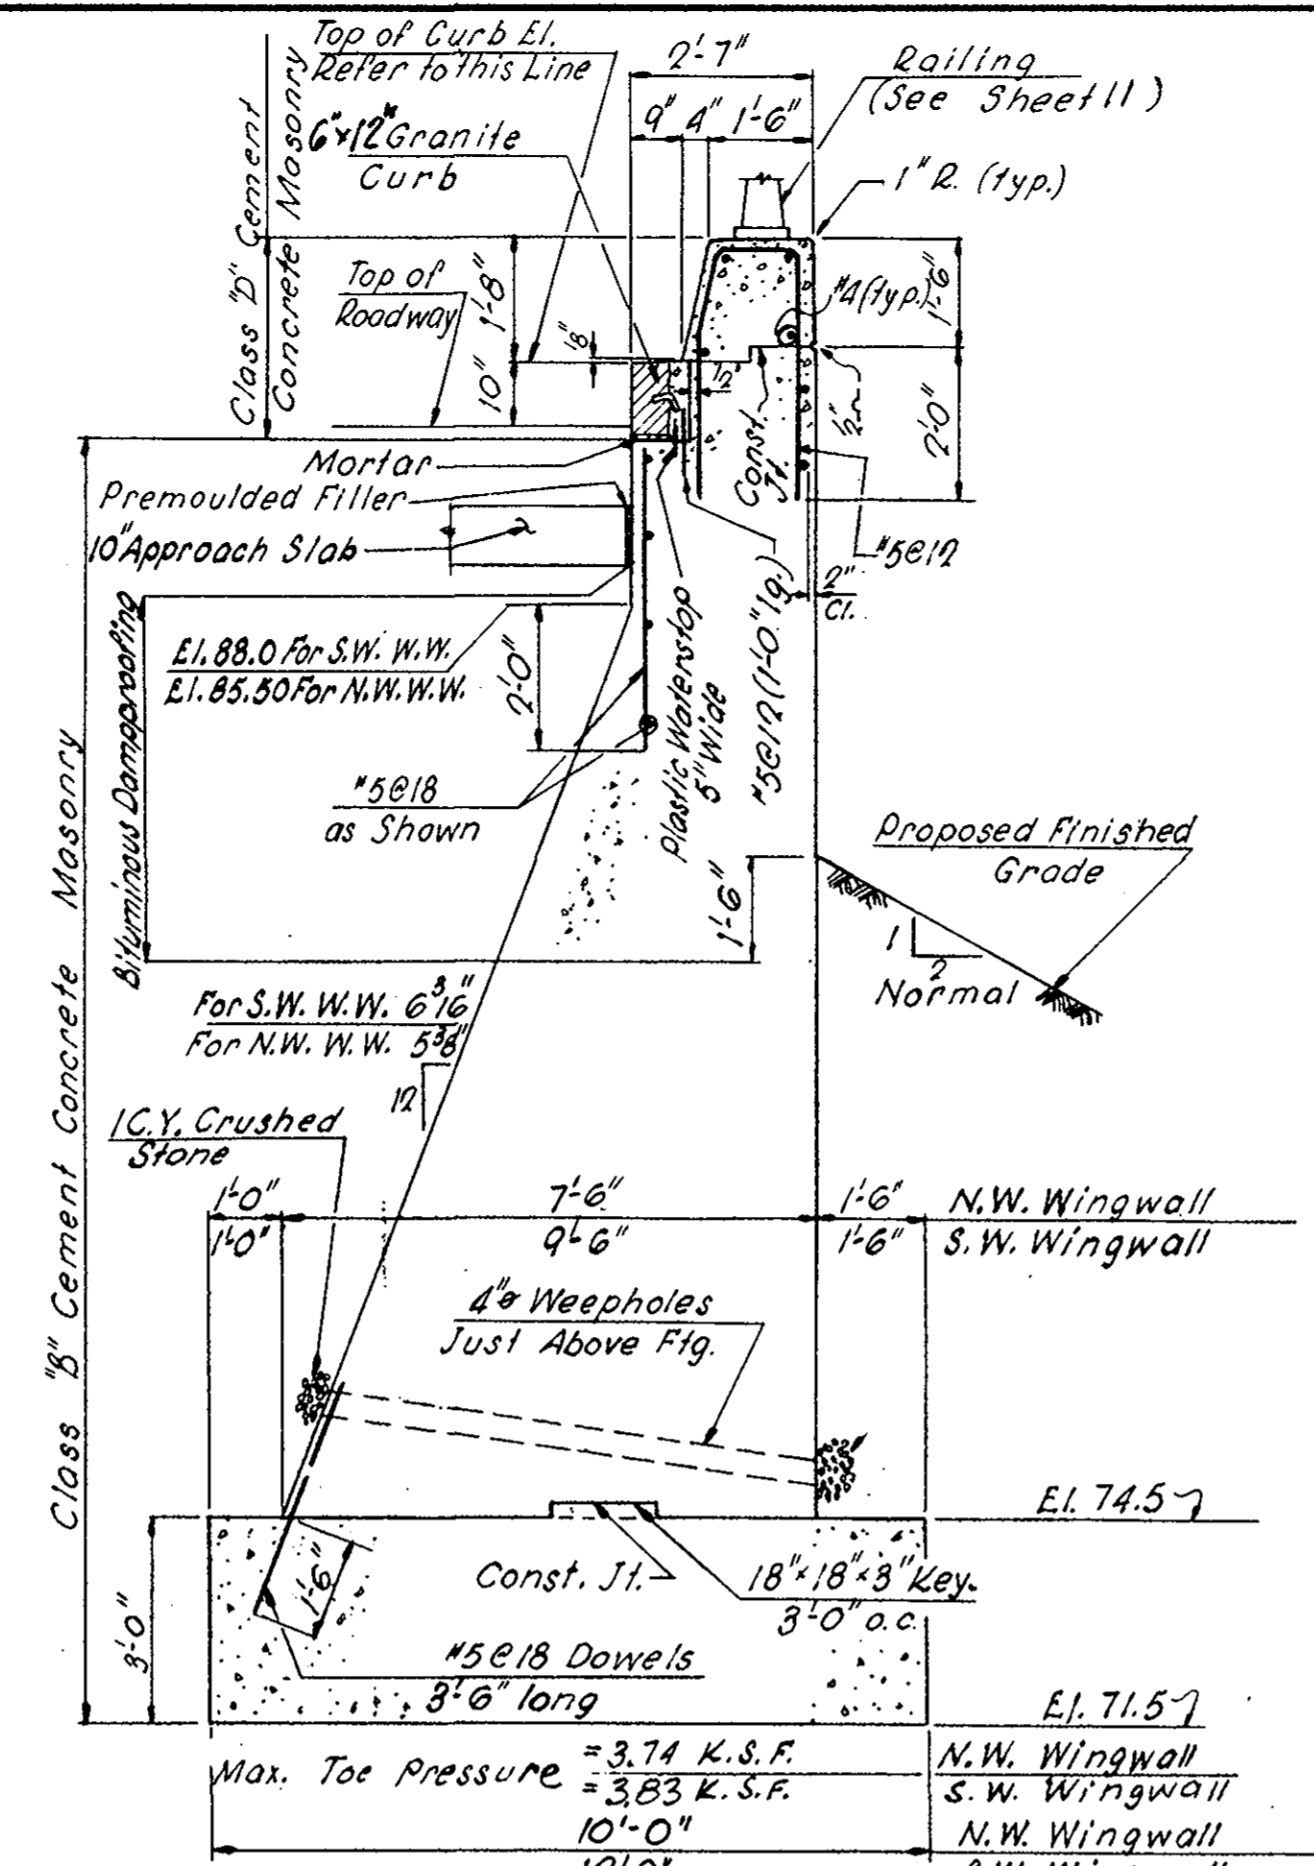


SECTION E-E  
Scale: 3/8" = 1'-0"

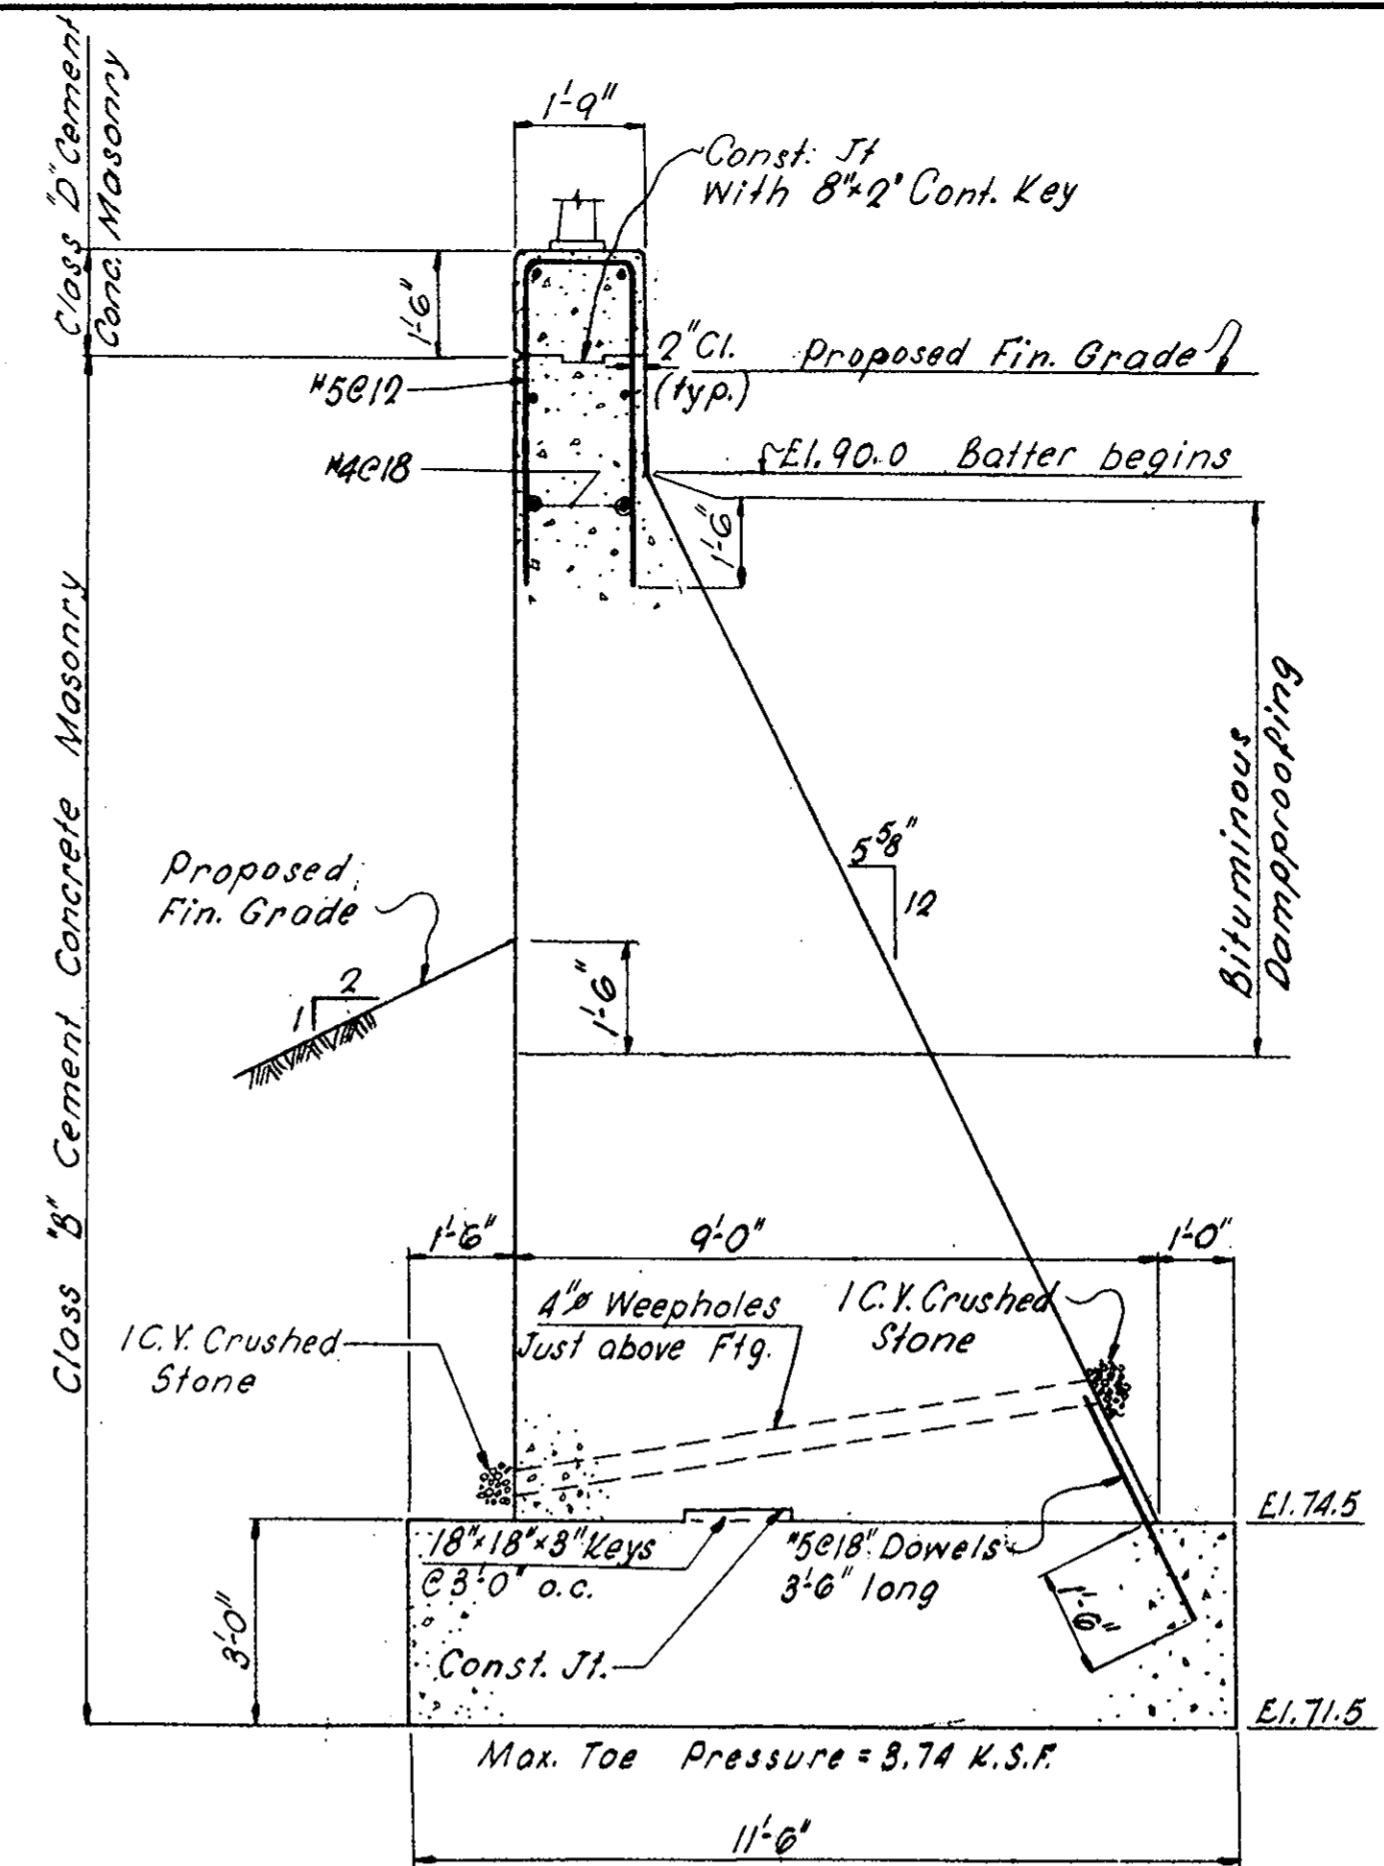

SECTION F-F  
Scale: 3/8" = 1'-0"

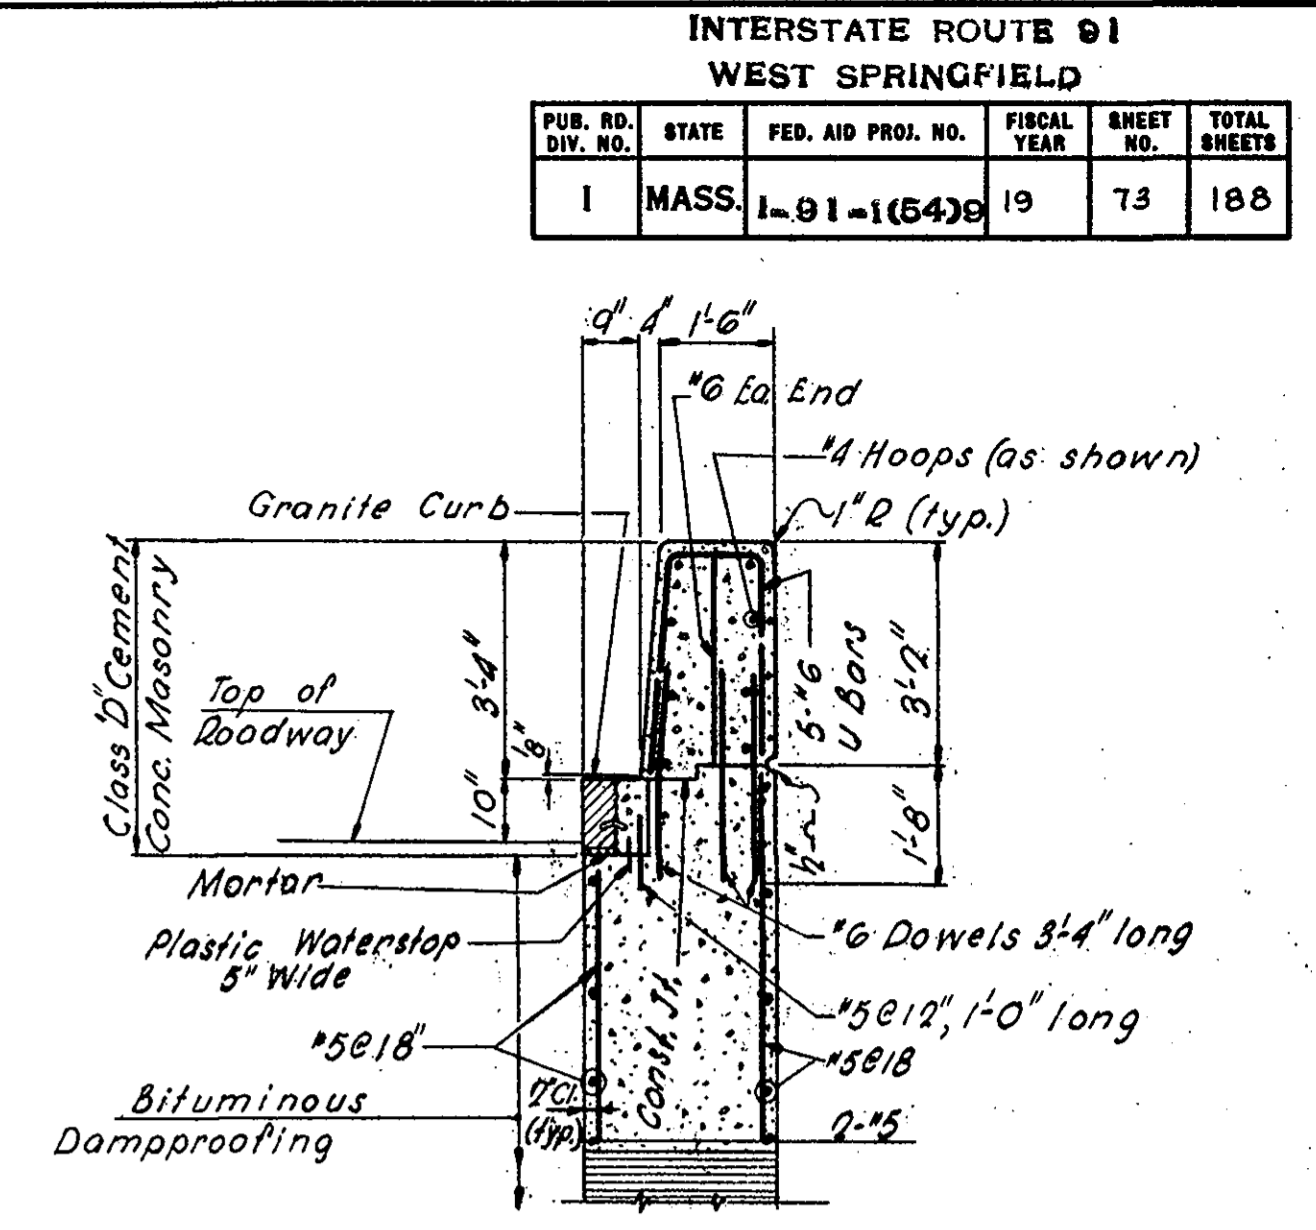

SECTION G-G  
Scale: 3/8" = 1'-0"

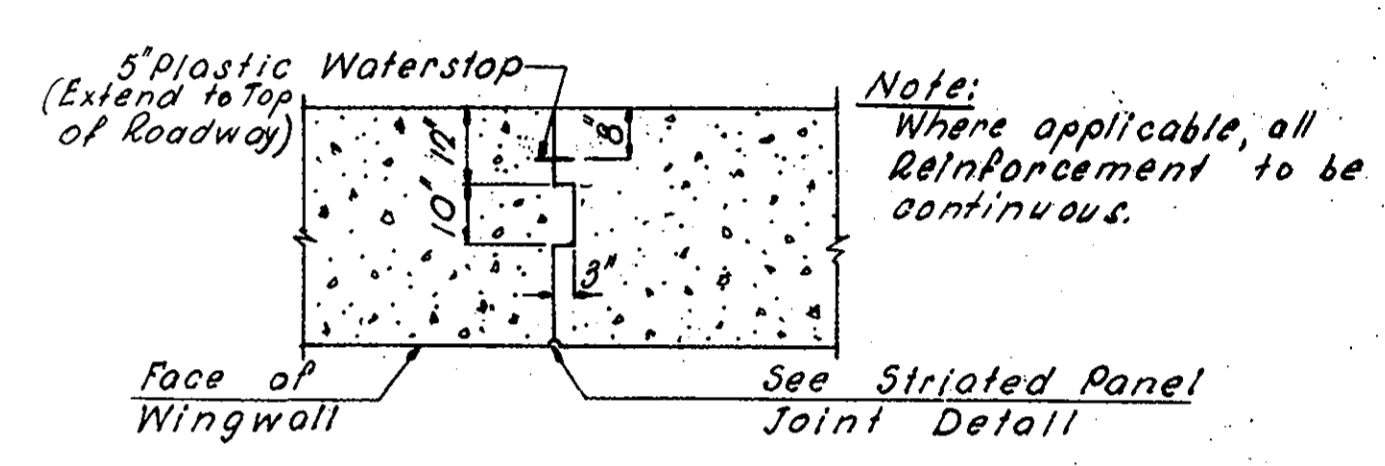


SECTION H-H  
Scale: 3/8" = 1'-0"


WINGWALL ELEVATIONS

Wingwall	El. A'	El. B'	El. C'
North East	87.05	86.06	64.50
South East	89.67	88.50	64.50
North West	89.14	89.64	71.50
South West	91.67	92.44	71.50


Note:  
Date & Seal to be located at the inside faces of N.E. & S.W. Wingwalls. Fill shall be placed and thoroughly compacted to the grade of the bottom of the wings; or where no fill is required below the wings, the concrete shall be placed upon undisturbed soil.

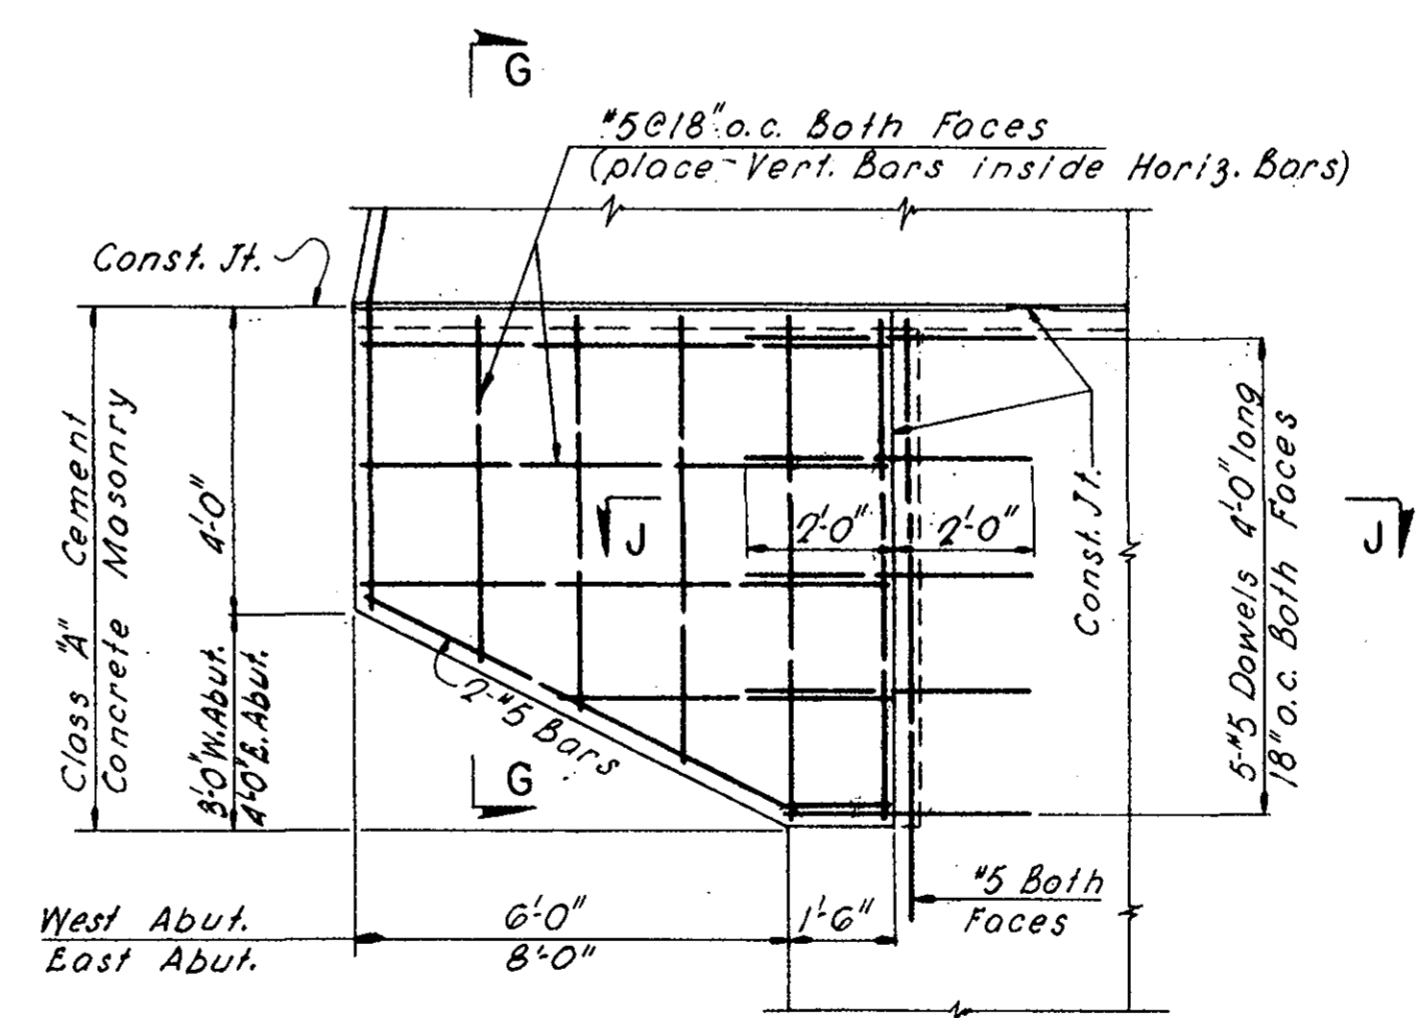

FLYING WING REINFORCEMENT  
Scale: 3/8" = 1'-0"

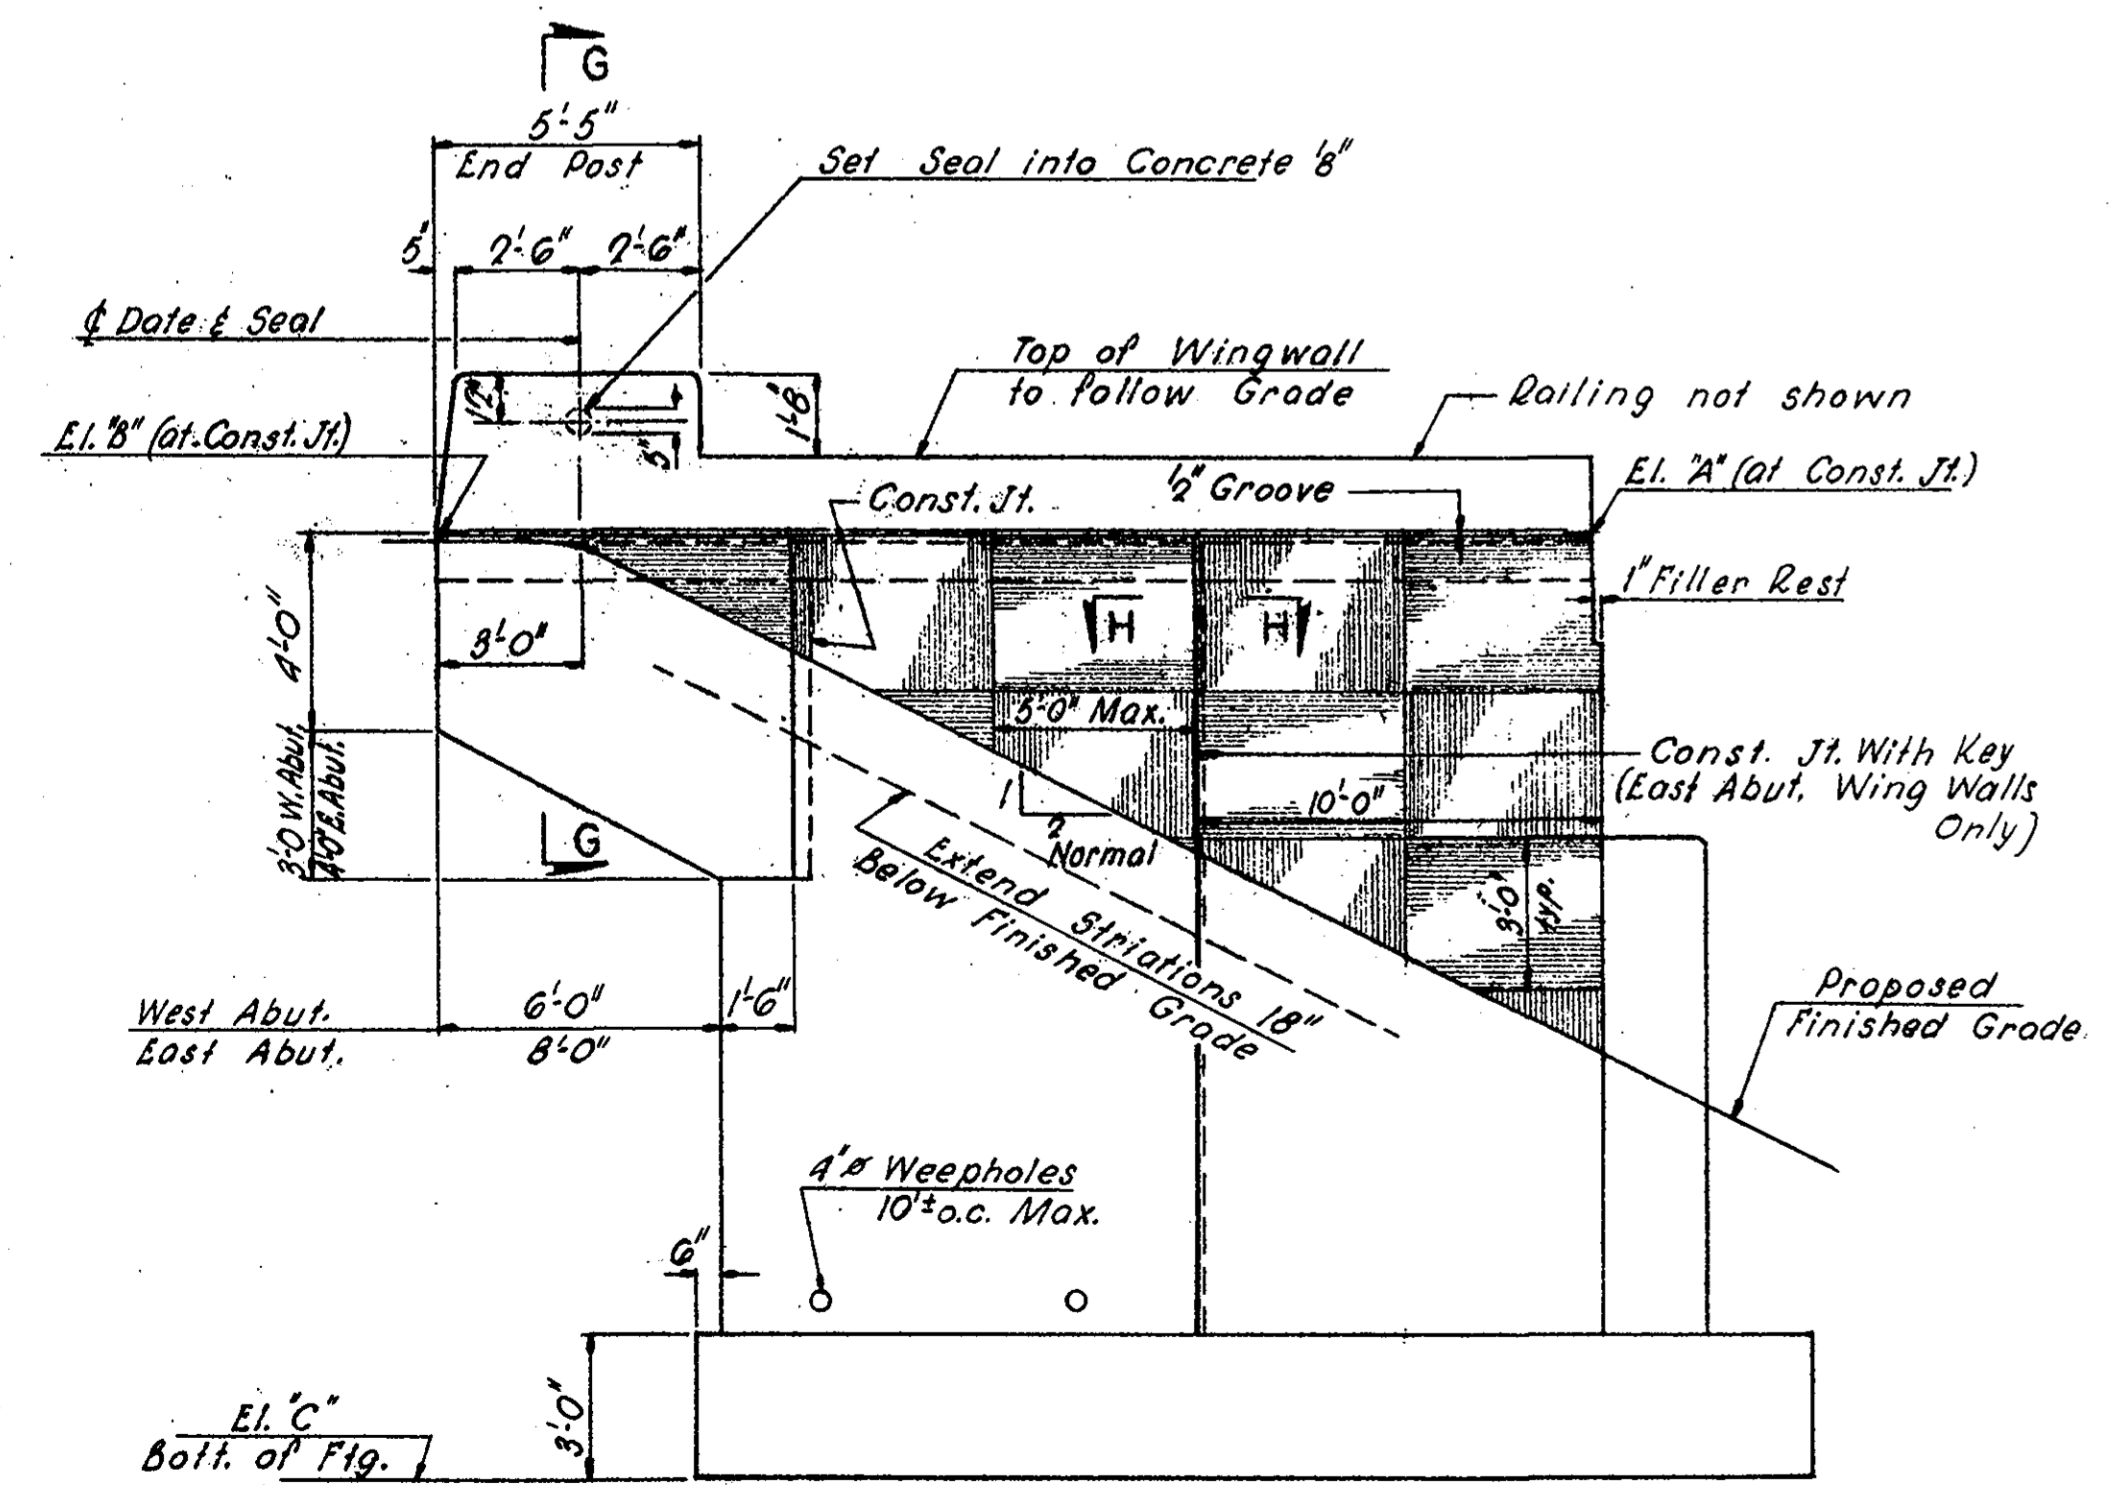

TYPICAL WINGWALL ELEVATION  
Scale: 1/4" = 1'-0"

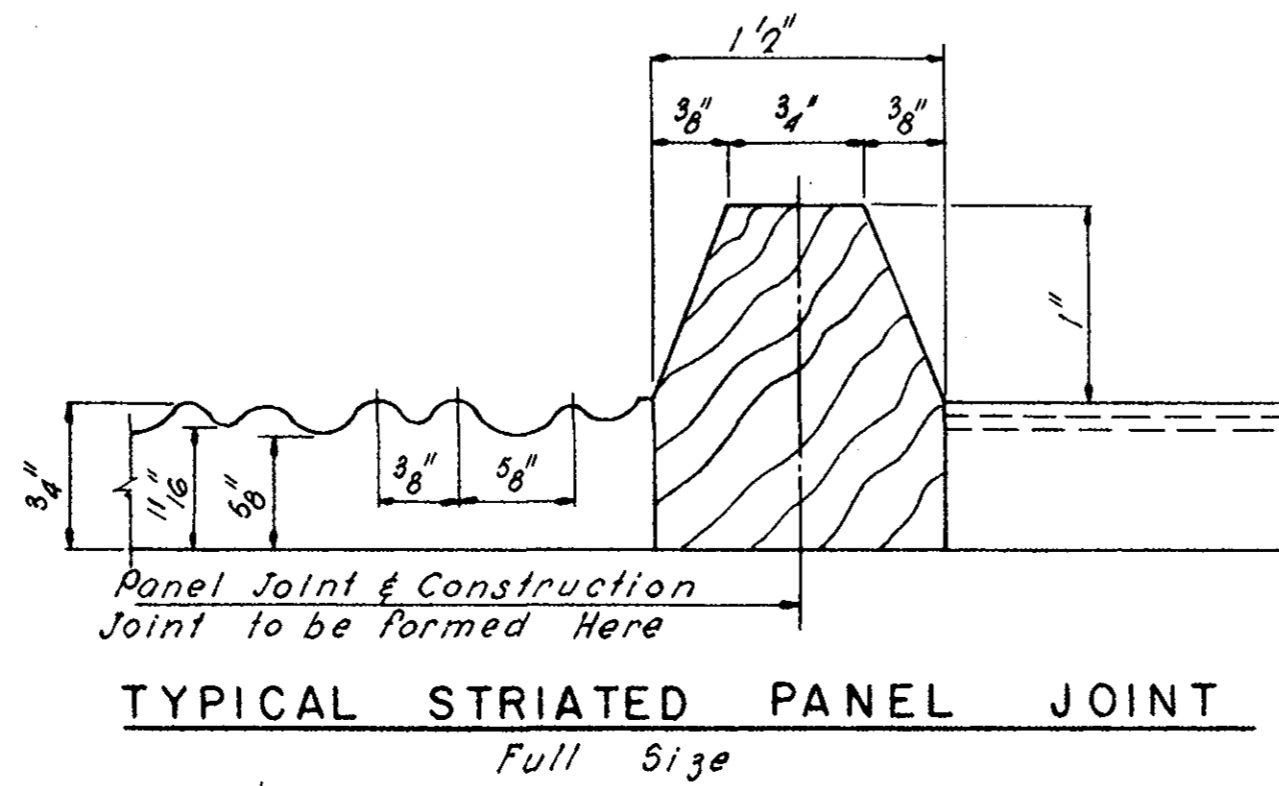

TYPICAL STRIATED PANEL JOINT  
Full Size

Notes:  
For Footing Layout & Gravel Borrow Sections See Sheet 7.


APRIL 9, 1966	ISSUED FOR CONSTRUCTION
DATE	DESCRIPTION
	USE ONLY PRINTS OF LATEST DATE








PUB. NO.	STATE	FED. AID PROJ. NO.	FISCAL YEAR	SHEET NO.	TOTAL SHEETS
1	MASS.	1-3-1-1-3-19	19	76	188

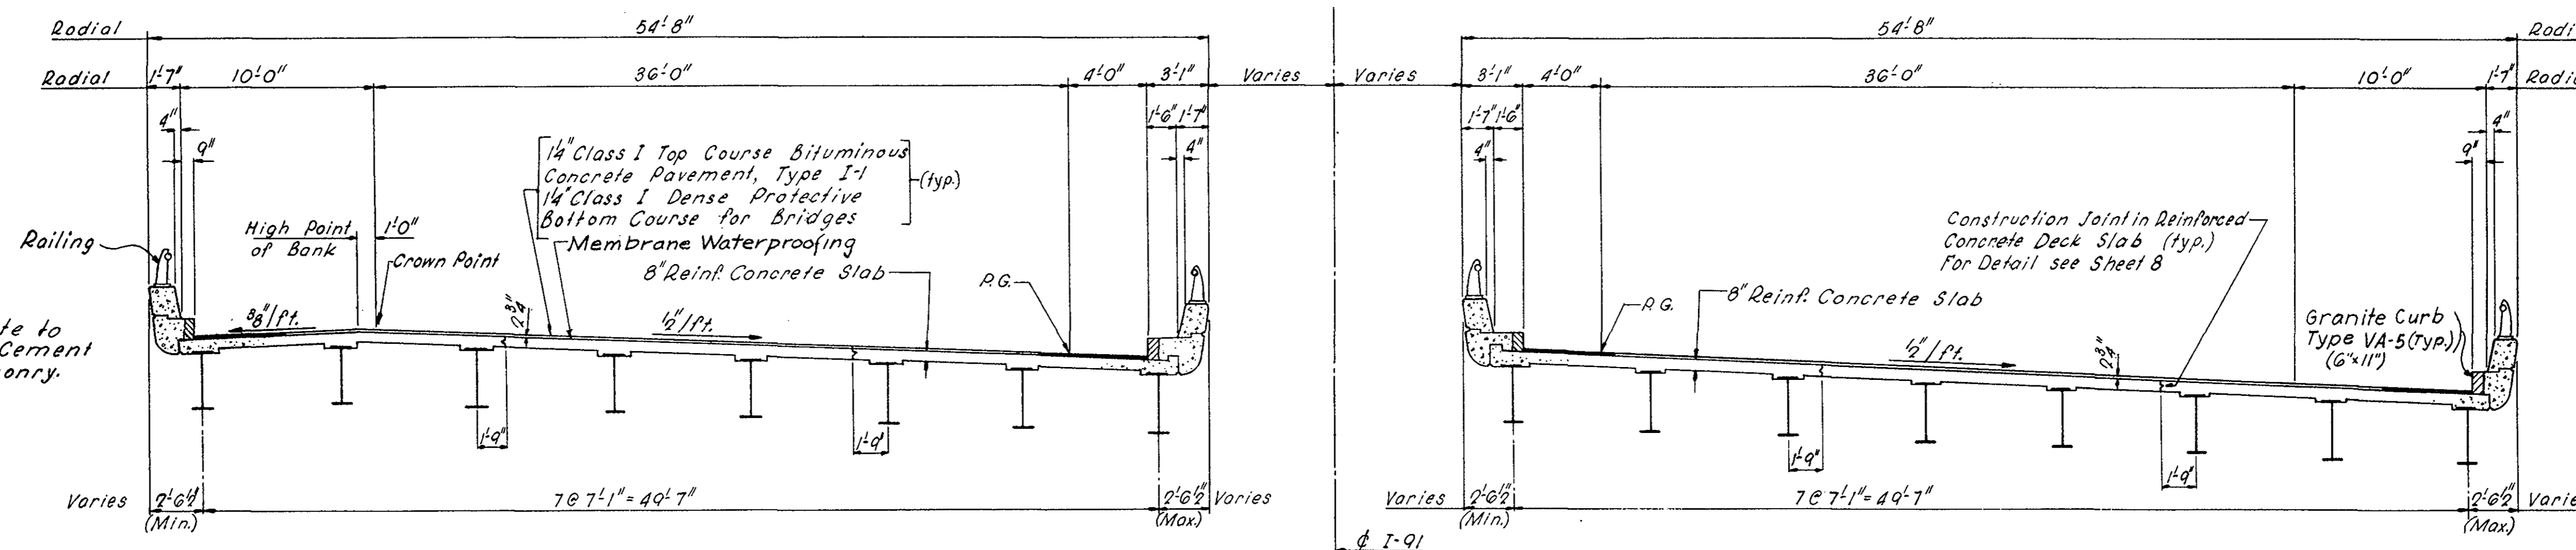


Note:  
All Concrete to be Class 'D' Cement Concrete Masonry.

TYPICAL CROSS SECTION  
Scale: 3/16" = 1'-0"

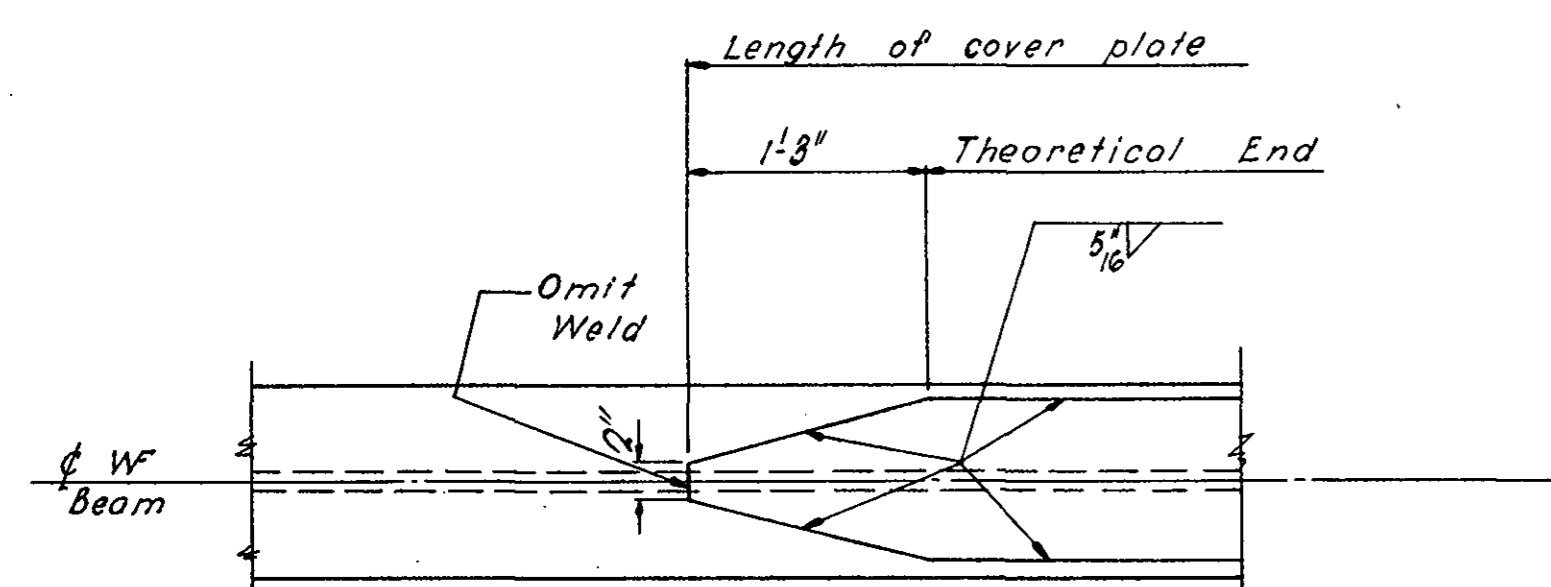

Notes:  
Preparation of material for welding shall conform to art. 402, A.W.S. 1963.  
Assembly of material for welding shall conform to art. 403, A.W.S. 1963.

COVER PLATE DETAIL  
Not to Scale

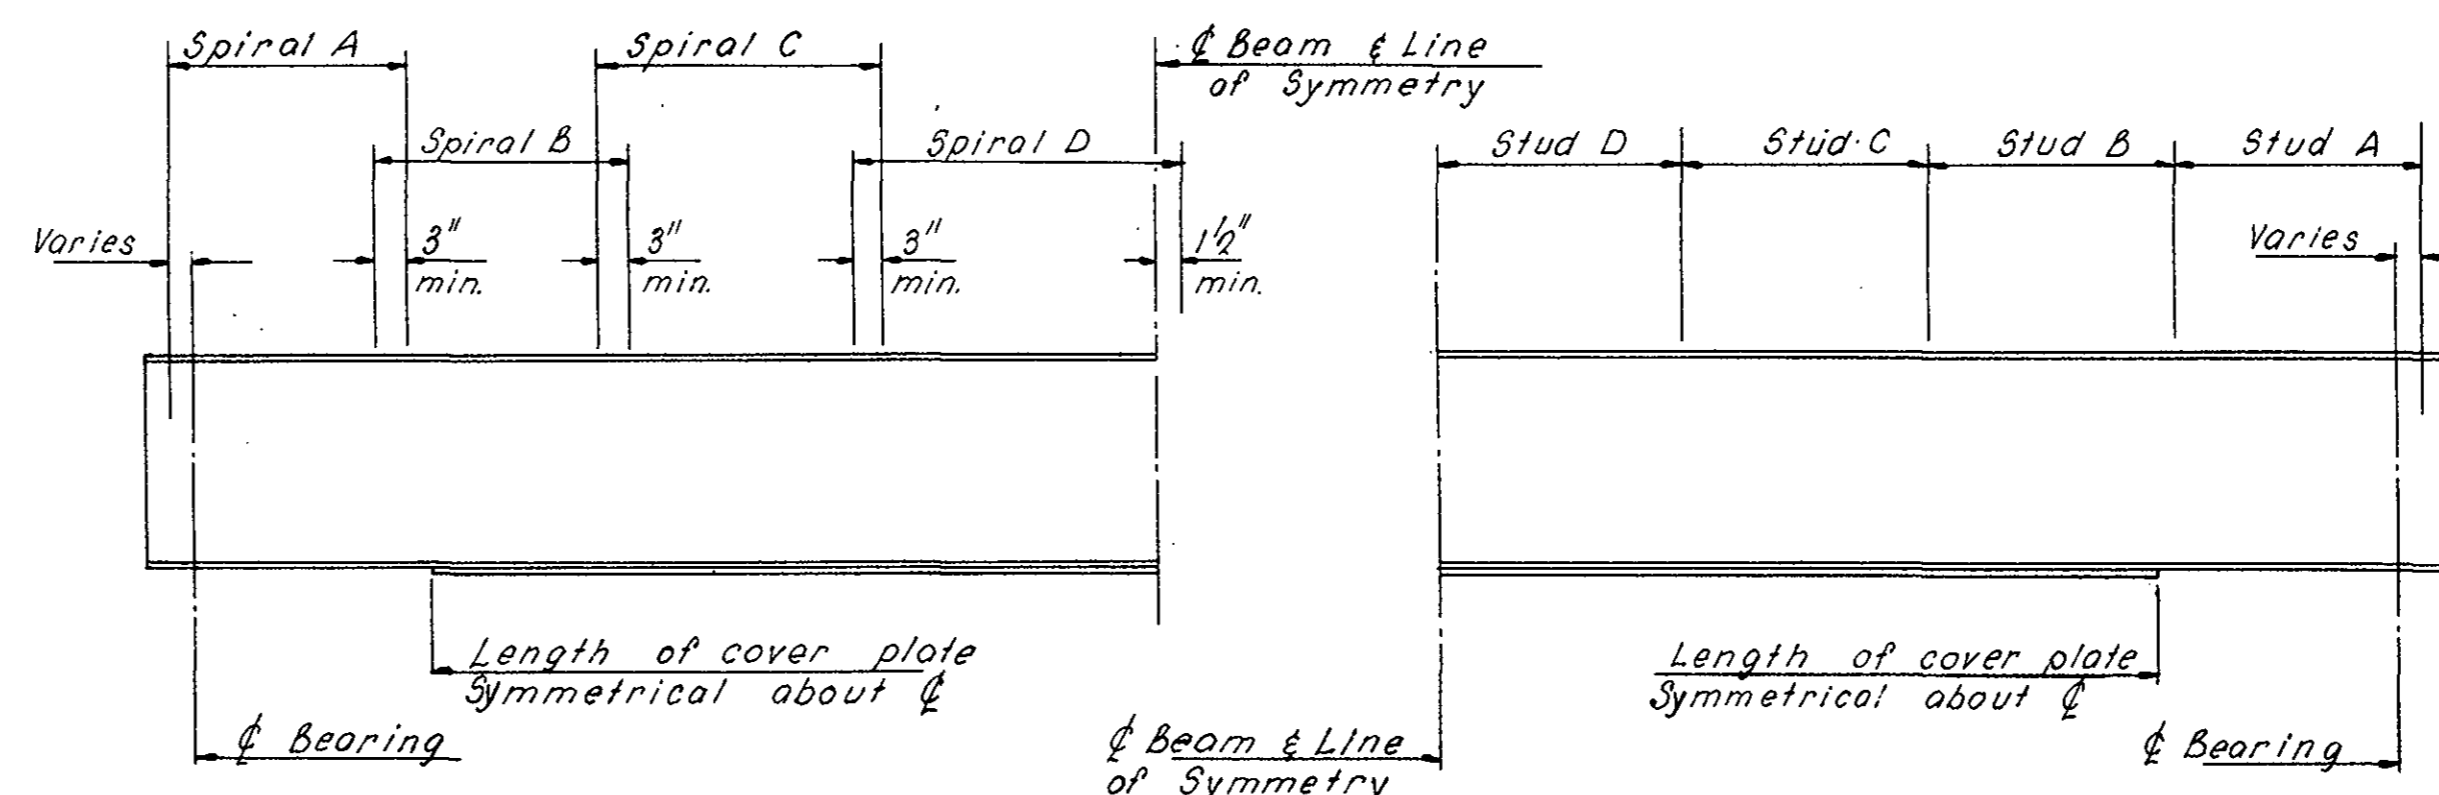

BEAM NO.	DEFLECTION DUE TO CONCRETE SLAB			TOTAL DEAD LOAD DEFLECTIONS			CAMBER AT MID SPAN
	1/4 SPAN	1/2 SPAN	3/4 SPAN	1/4 SPAN	1/2 SPAN	3/4 SPAN	
1	7/16"	9/16"	7/16"	1"	1 3/8"	1"	2 1/4"
2	5/8"	13/16"	5/8"	1 1/8"	1 7/8"	1 1/8"	2 3/8"
3							
4							
5							
6							
7	5/8"	13/16"	5/8"	1 1/8"	1 1/2"	1 1/8"	2 3/8"
8	7/16"	9/16"	7/16"	1"	1 3/8"	1"	2 1/4"
9	7/16"	9/16"	7/16"	1"	1 3/8"	1"	2 1/4"
10	5/8"	13/16"	5/8"	1 1/8"	1 1/2"	1 1/8"	2 3/8"
11							
12							
13							
14							
15	5/8"	13/16"	5/8"	1 1/8"	1 1/2"	1 1/8"	2 3/8"
16	7/16"	9/16"	7/16"	1"	1 3/8"	1"	2 1/4"

† The Deflection due to Concrete Slab is 80% of the Theoretical Value and is intended for the use of Resident Engineer only.

EAST BEARING	DESIGN ELEVATIONS ALONG TOP FLANGE			WEST BEARING
	1/4 SPAN	1/2 SPAN	3/4 SPAN	
87.67	88.27	88.79	89.24	89.61
87.93	88.53	89.05	89.50	89.86
87.73	88.33	88.85	89.30	89.66
87.47	88.06	88.58	89.03	89.40
87.20	87.80	88.32	88.77	89.14
86.93	87.54	88.06	88.51	88.88
86.67	87.27	87.79	88.25	88.62
86.40	87.00	87.52	87.98	88.36
86.87	87.47	88.00	88.46	88.83
86.61	87.22	87.75	88.21	88.59
86.35	86.96	87.49	87.96	88.34
86.09	86.71	87.24	87.70	88.08
85.83	86.45	86.98	87.44	87.83
85.57	86.19	86.72	87.19	87.58
85.32	85.93	86.47	86.93	87.32
85.06	85.67	86.20	86.67	87.07


BEAM NO.	SIZE	LENGTH CL-CL BEAR'GS	BOTTOM COVER PLATE	2-5/8" Φ SPIRAL SHEAR CONNECTORS				3-3/4" Φ STUD SHEAR CONNECTORS											
				SPIRAL A		SPIRAL B		STUD A		STUD B		STUD C		STUD D					
				LENGTH	PITCH	LENGTH	PITCH	LENGTH	PITCH	LENGTH	PITCH	LENGTH	PITCH	LENGTH	PITCH				
1	36W135	65'-6 1/2"	10' x 1/2" x 50'-9"	9'-7 1/2"	5 1/2"	8'-9"	7"	7'-6"	9"	8'-0"	12"	9'-0"	4 1/2"	9'-2"	5 1/2"	8'-0"	8"	7'-0"	10 1/2"
2-7		65'-6 1/2"	10' x 1/2" x 51'-9"	9'-4 1/2"	4 1/2"			7"	7'-6"	9"			12"	9'-0"	4 1/2"	9'-2"	5 1/2"	7'-6"	10"
8		65'-6 1/2"	10' x 1/2" x 50'-9"	9'-7 1/2"	5 1/2"			7"	7'-6"	9"			12"	9'-0"	4 1/2"	9'-2"	5 1/2"	8'-0"	10 1/2"
9		65'-9 1/2"	10' x 1/2" x 50'-9"	9'-7 1/2"	5 1/2"			7"	7'-6"	9"			12"	9'-0"	4 1/2"	9'-2"	5 1/2"	8'-0"	10 1/2"
10-15		65'-9 1/2"	10' x 1/2" x 51'-9"	9'-4 1/2"	4 1/2"			7"	7'-6"	9"			12"	9'-0"	4 1/2"	9'-2"	5 1/2"	7'-6"	10"
16	36W135	65'-9 1/2"	10' x 1/2" x 50'-9"	9'-7 1/2"	5 1/2"	8'-9"	7"	7'-6"	9"	8'-0"	12"	9'-0"	4 1/2"	9'-2"	5 1/2"	8'-0"	8"	7'-0"	10 1/2"

Notes:  
1. Ends of all beams shall be fabricated so that under full dead load the ends will be plumb.  
2. The table of Design Elevations along top flange is for the use of Resident Engineer in the field for comparison of:  
a) Elevations along top flange of stringers in place and  
b) the design elevations tabulated.  
3. Any Welded Joint Prequalified by American Welding Society Specifications for Welded Highway and Railway Bridges (1963 Edition), will be Acceptable in the Fabrication of the Structural Steel.

APRIL 9, 1966	ISSUED FOR CONSTRUCTION
DATE	DESCRIPTION
	USE ONLY PRINTS OF LATEST DATE




PUB. RD. DIV. NO.	STATE	FED. AID PROJ. NO.	FISCAL YEAR	SHEET NO.	TOTAL SHEETS
1	MASS.	1-91-1(54)B	19	78	188

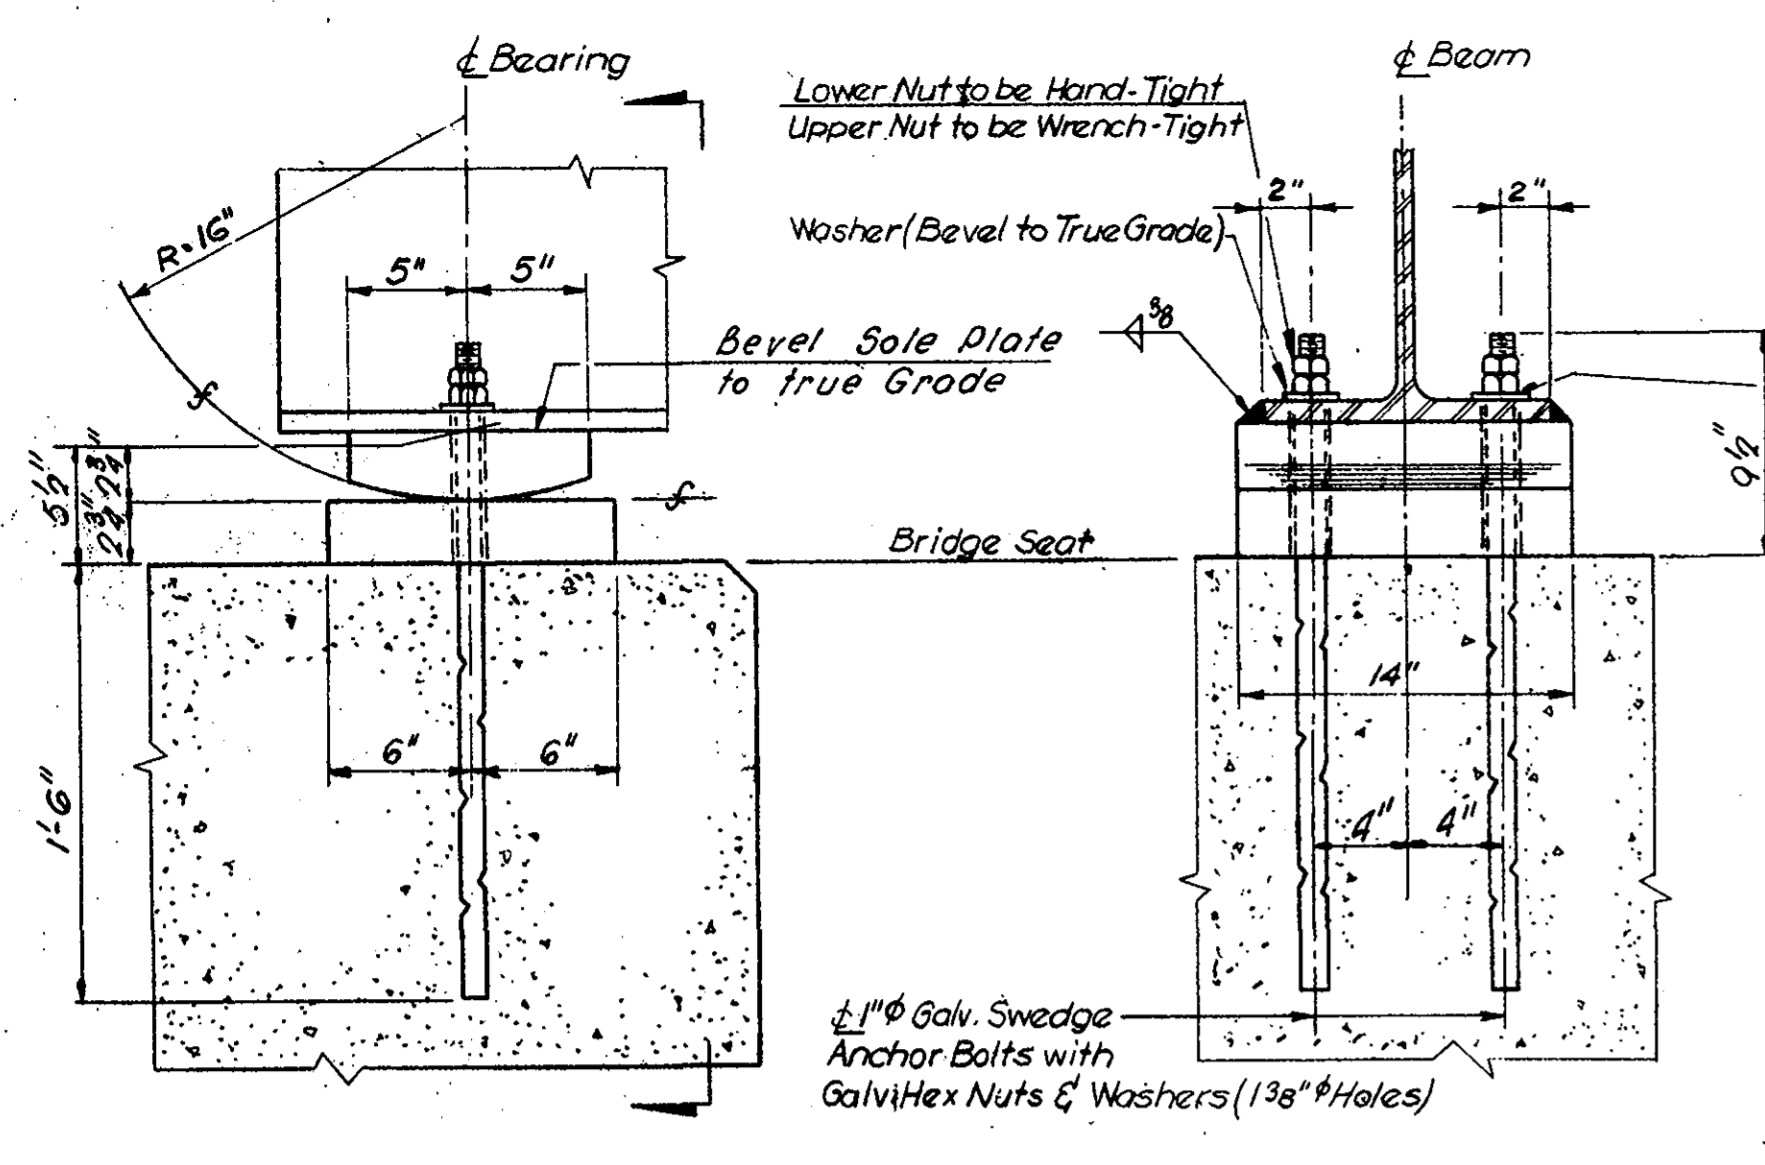


**FIXED BEARINGS**  
Scale 1/2" = 1'-0"


- Notes**
- Masonry, Plates and Sole Plates to be ASTM A36 Steel.  $\phi$  denotes ASA 125 microinches or finer.
  - The finished surfaces shall meet the American Standard's Association surface roughness requirements as defined in ASAB46-1, surface roughness, waviness and lay, Part 1.
  - Anchor bolts to be set by template and placed before concrete is poured.
  - Masonry plate to have full bearing and to be adjusted for level before placing the stringers on bearing assembly.

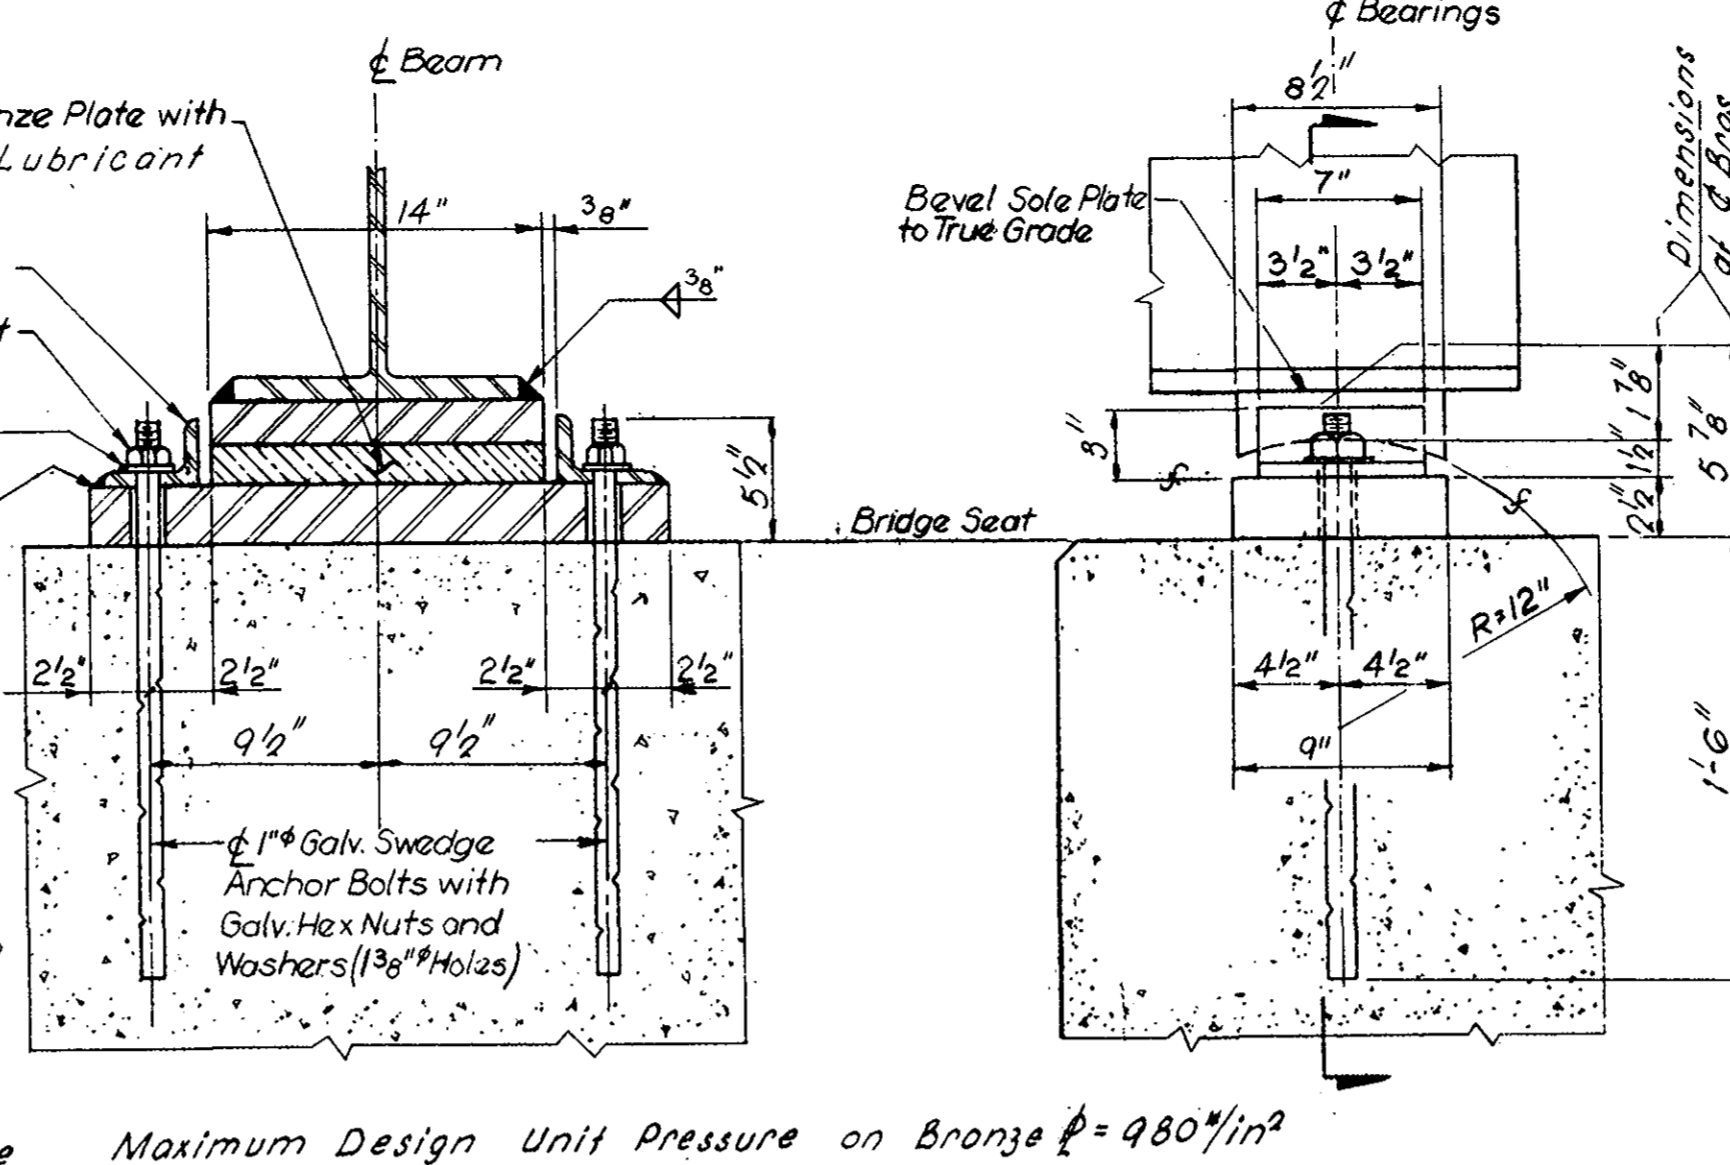


**EXPANSION BEARINGS**  
Scale 1/2" = 1'-0"

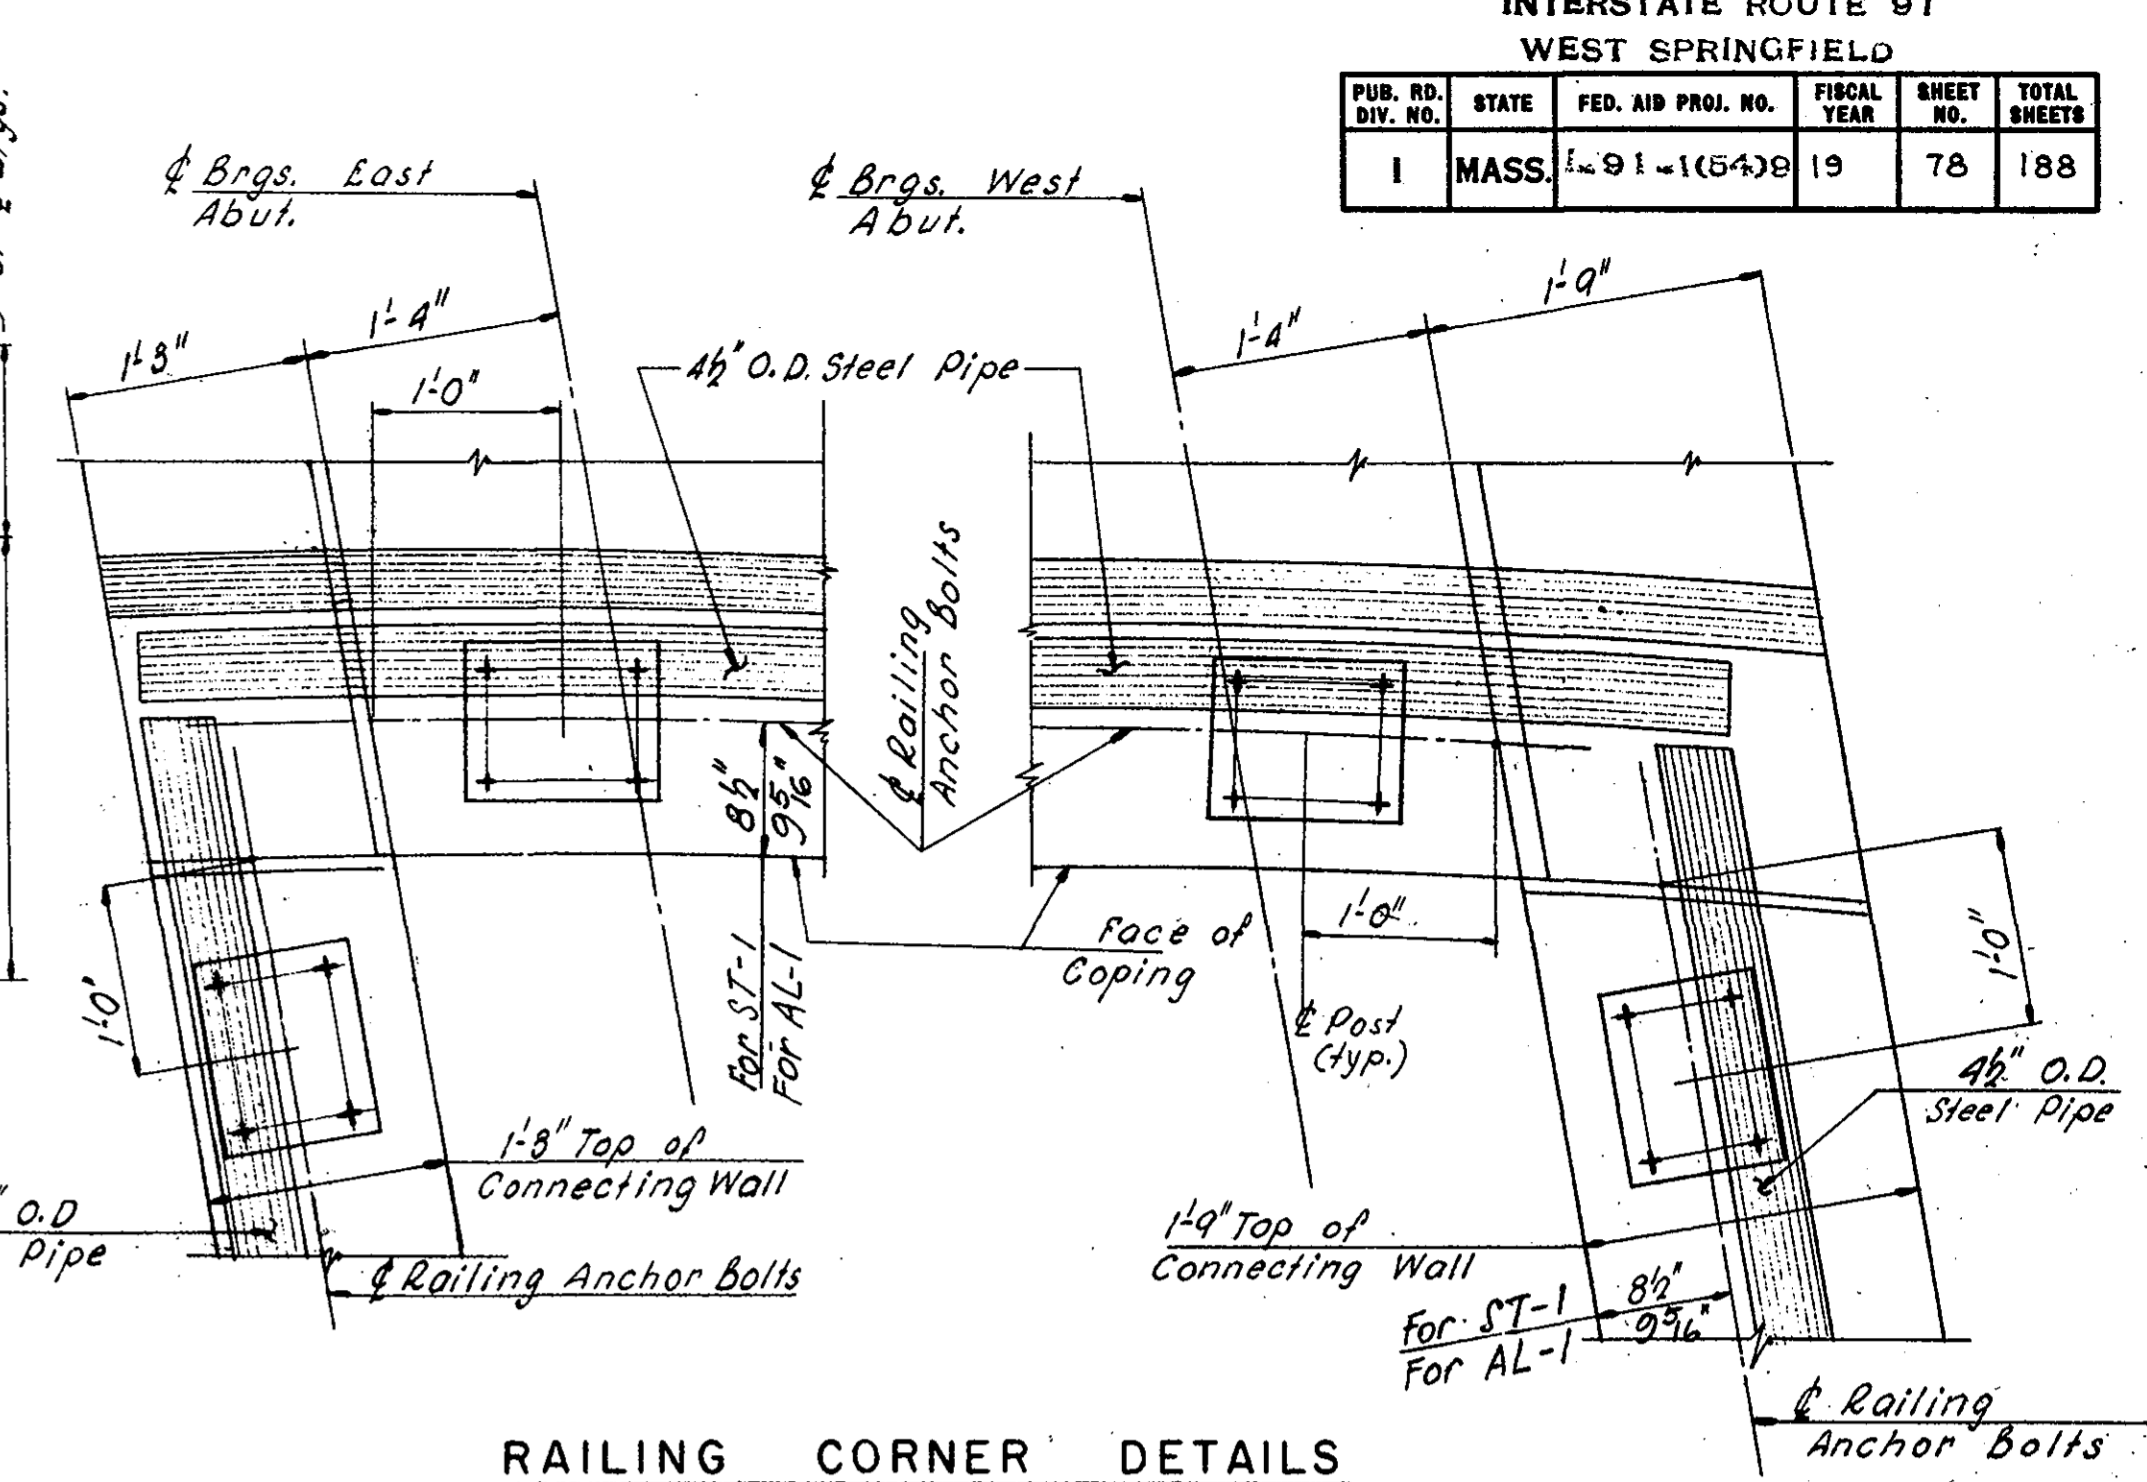


**RAILING CORNER DETAILS**  
Not to Scale

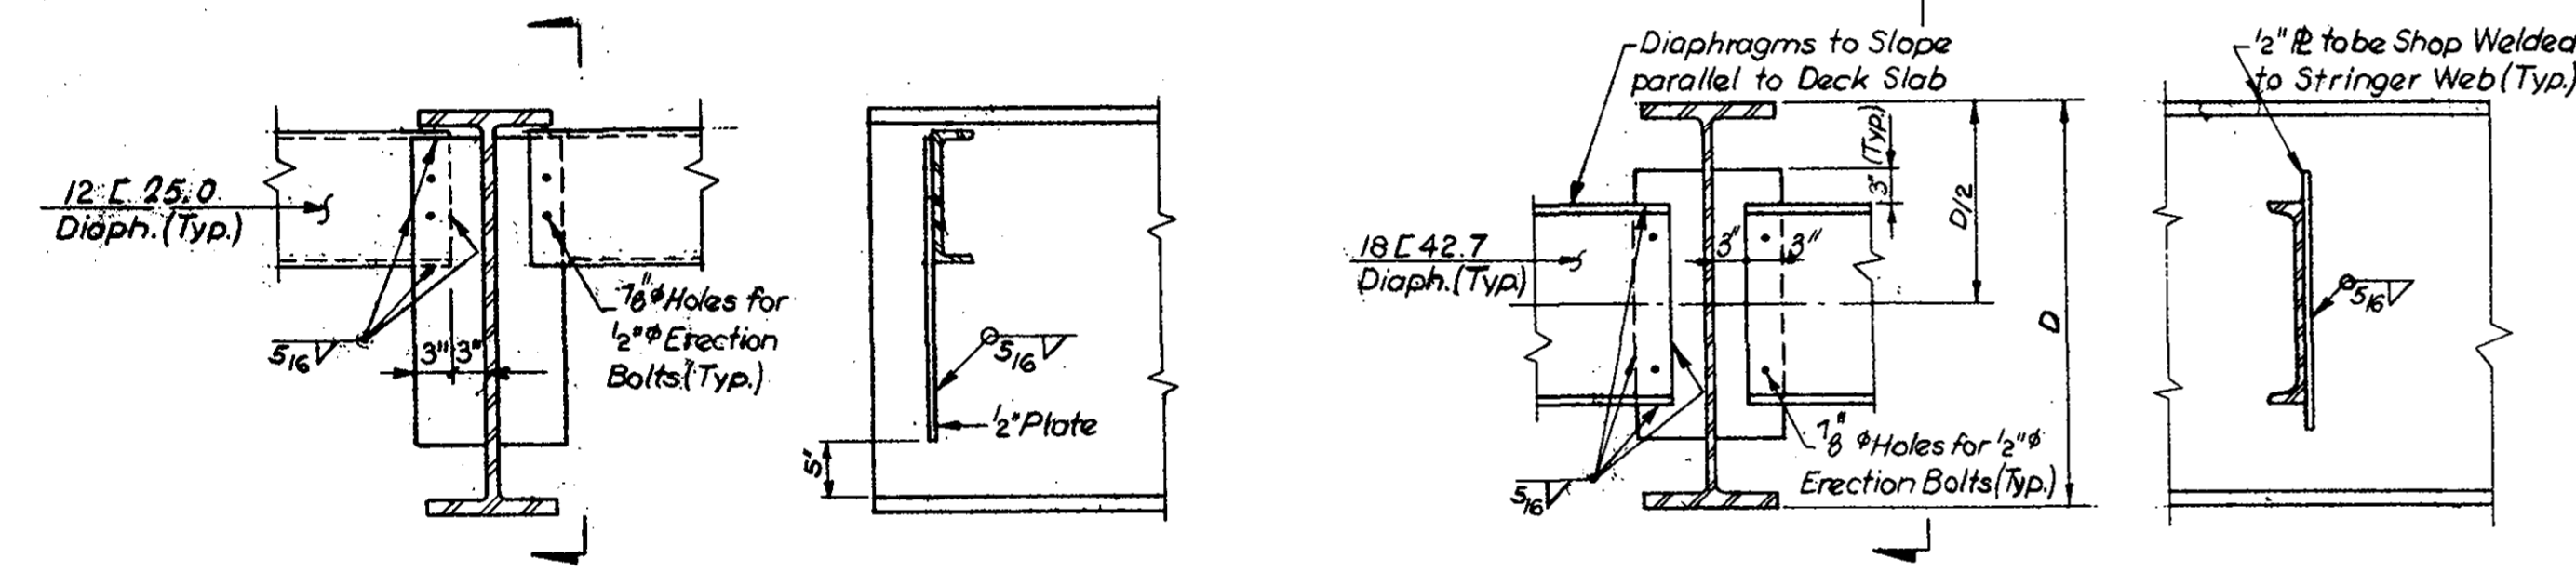


**TYPICAL DIAPHRAGM CONNECTIONS**  
Scale 3/4" = 1'-0"

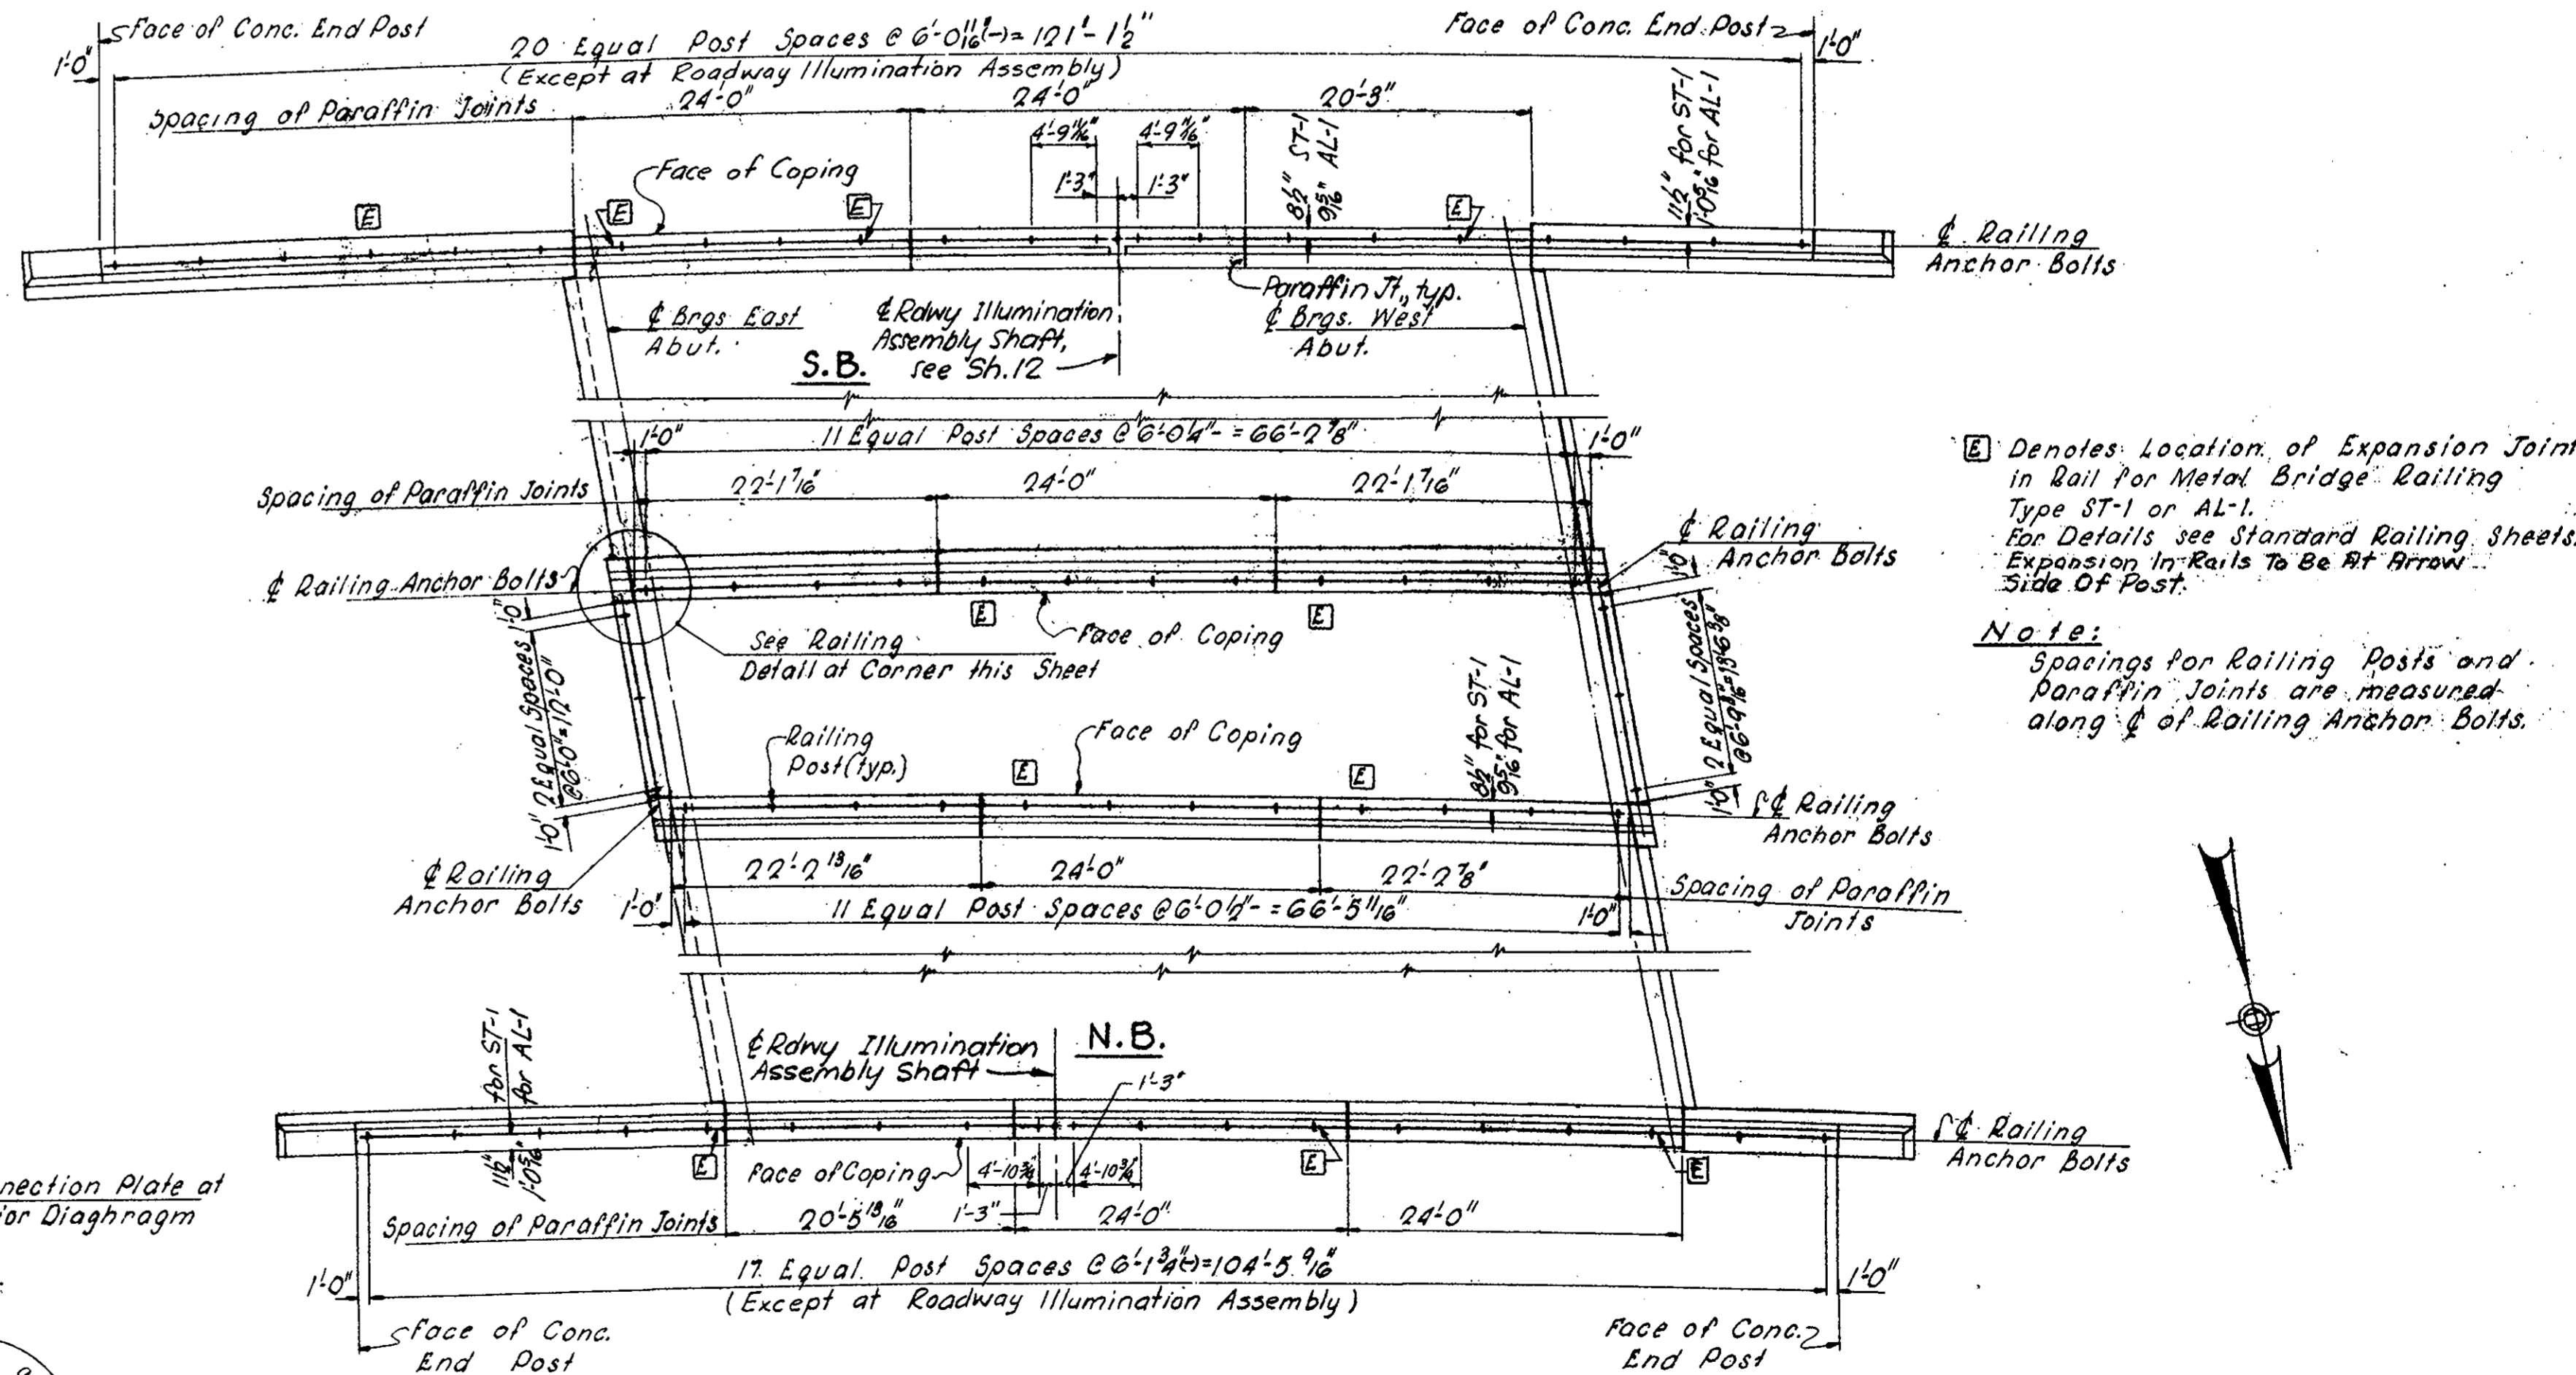

**RAILING POST & PARAFFIN JOINT LAYOUT PLAN**  
Not to Scale

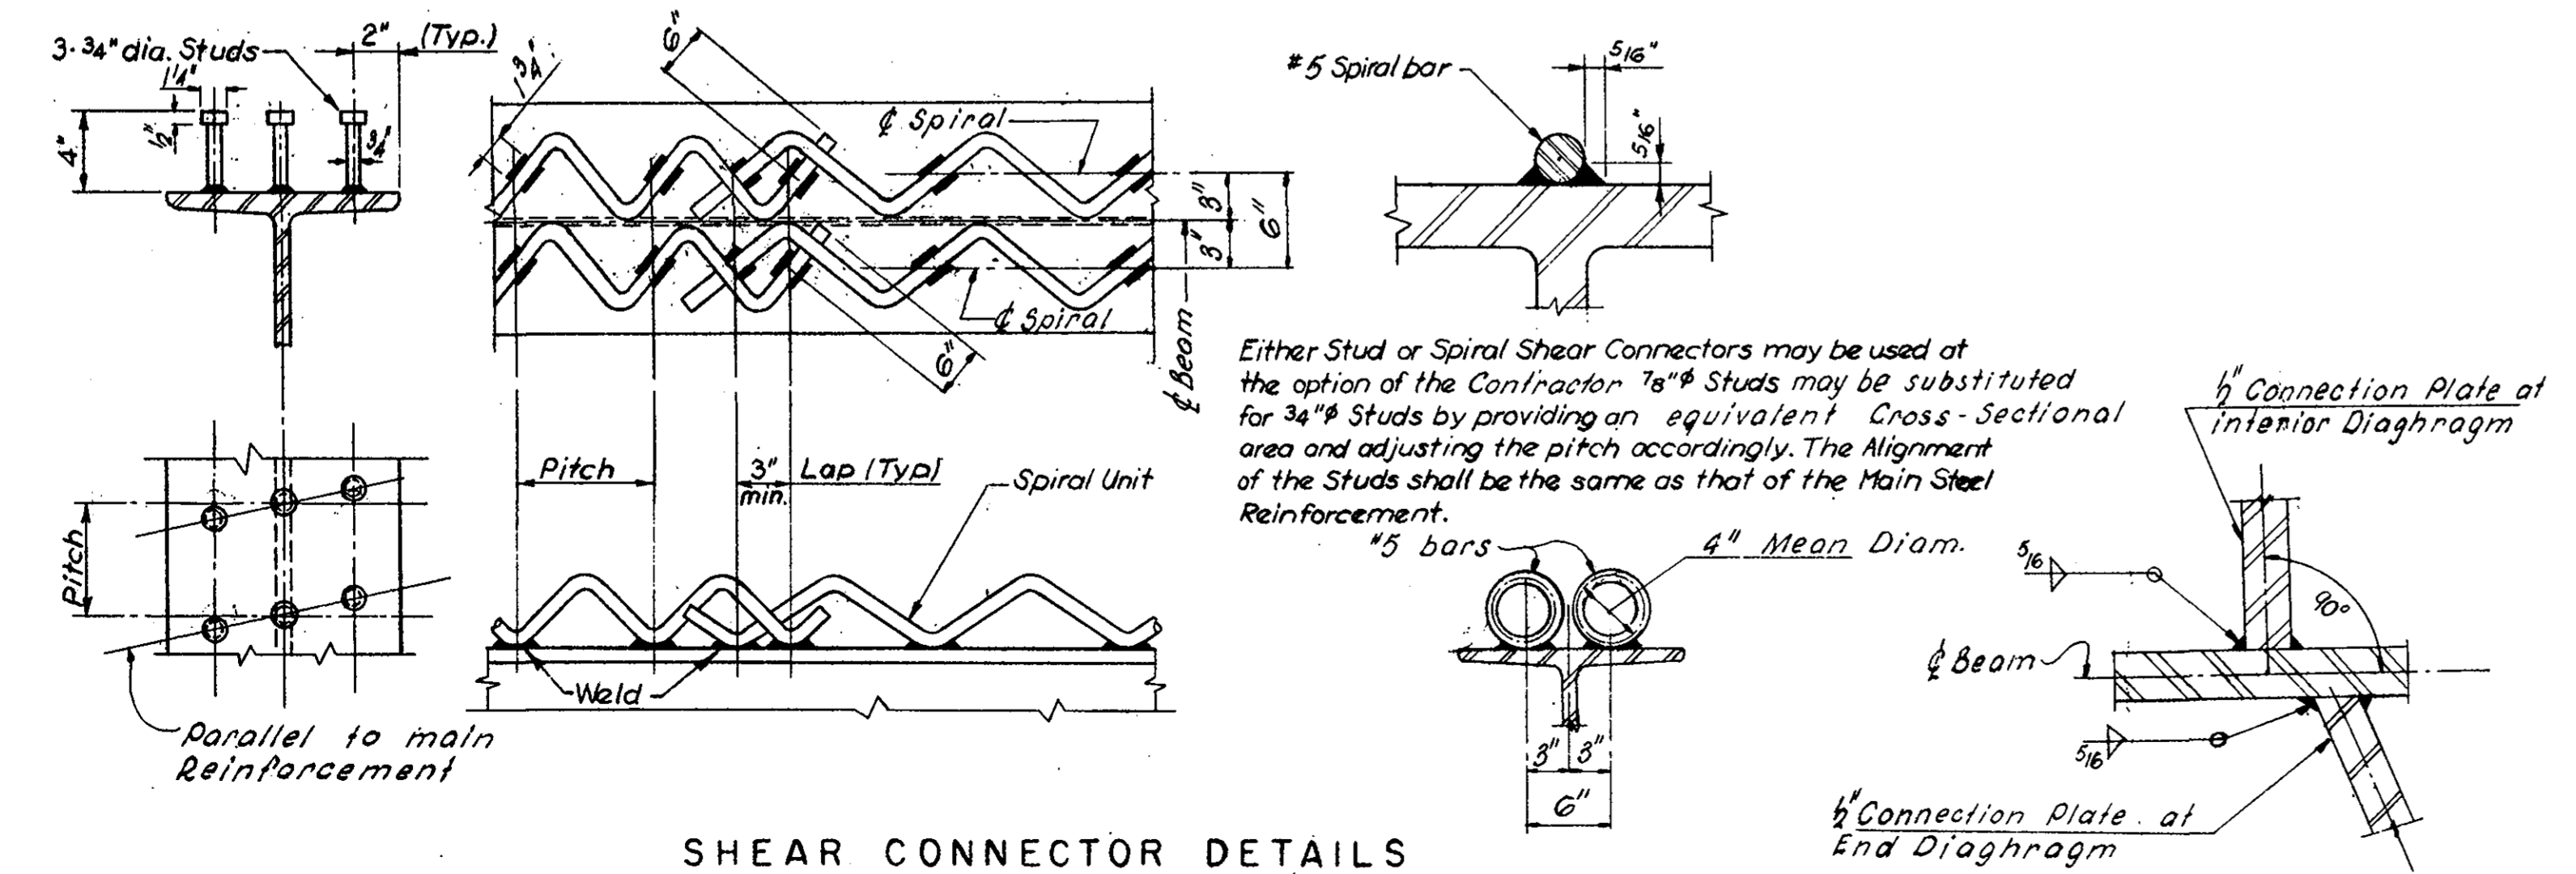

**SHEAR CONNECTOR DETAILS**  
Not to Scale

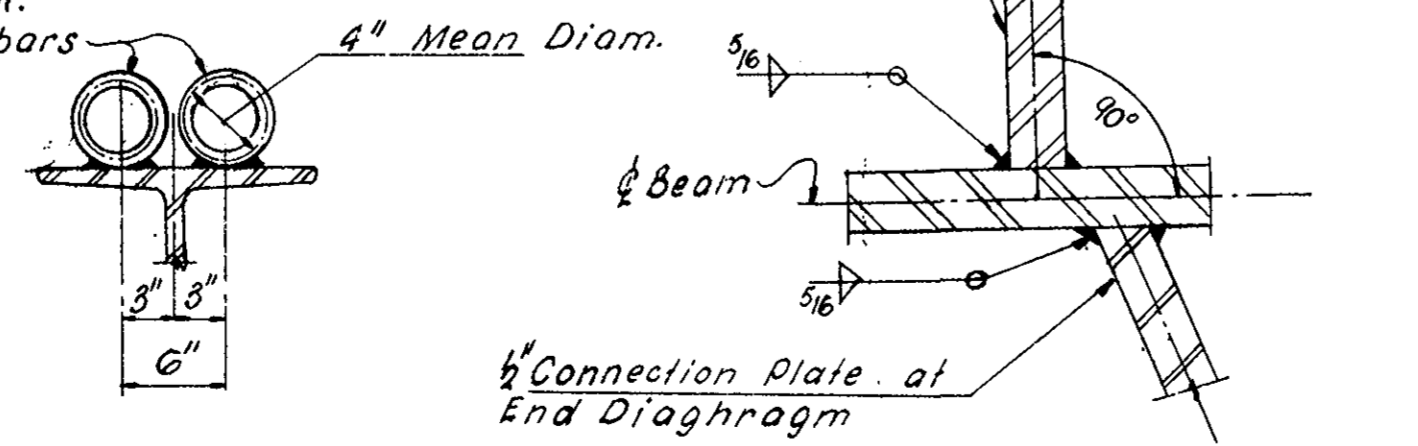

**CONNECTION PLATE DETAIL**

Ⓜ Denotes Location of Expansion Joint in Rail for Metal Bridge Railing Type ST-1 or AL-1. For Details see Standard Railing Sheets. Expansion in Rails to be at Arrow Side of Post.

**Notes:**  
Spacings for Railing Posts and Paraffin Joints are measured along  $\phi$  of Railing Anchor Bolts.



APRIL 9, 1966	ISSUED FOR CONSTRUCTION
DATE	DESCRIPTION
	USE ONLY PRINTS OF LATEST DATE



WEST SPRINGFIELD / CHICOPEE  
INTERSTATE 91 / ROUTE 5


STATE	FED. AID PROJ. NO.	SHEET NO.	TOTAL SHEETS
MA	NHP(NHS)-091S(305)X	35	39
PROJECT FILE NO.		608600	

BRIDGE PLAN AND ELEVATION

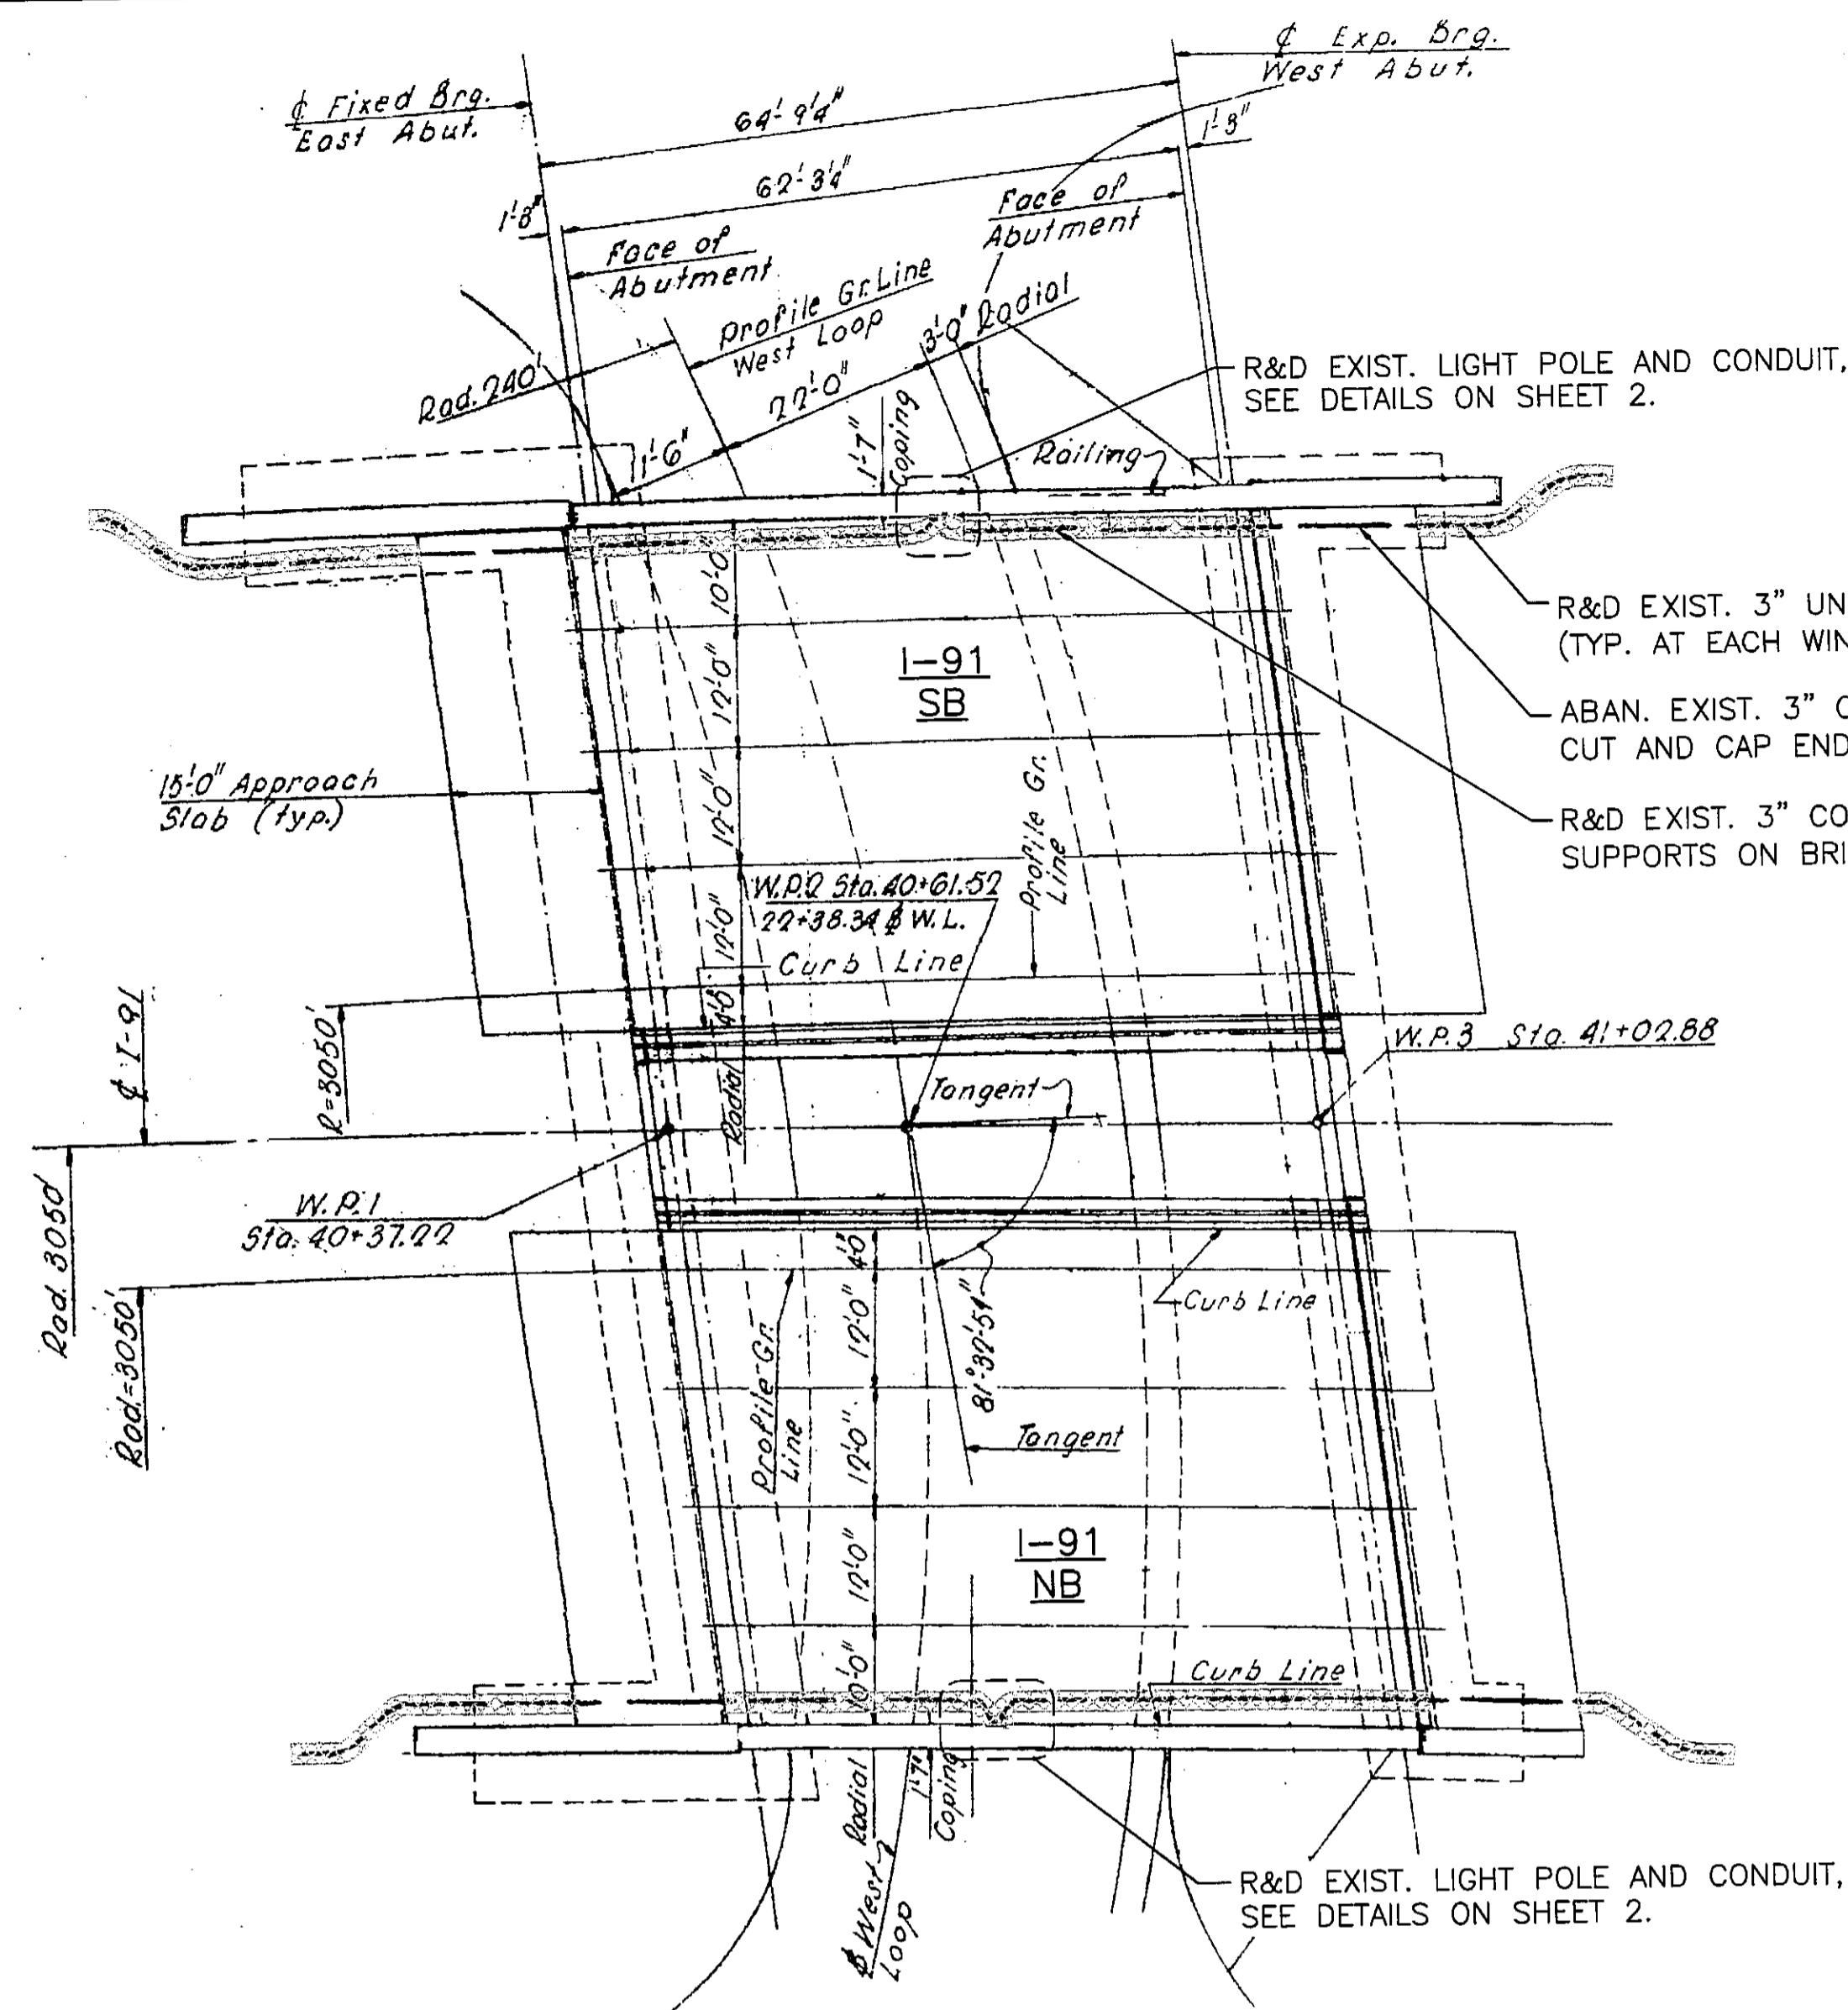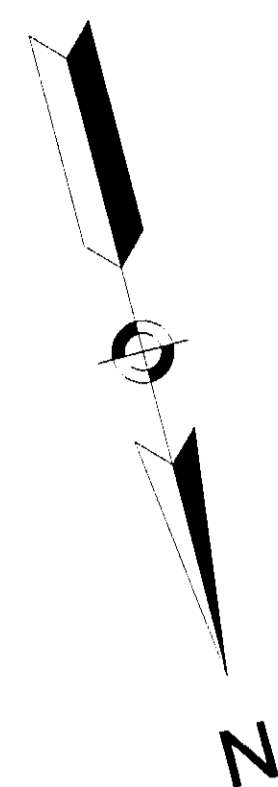

PLAN

SCALE: 1/16" = 1'-0"

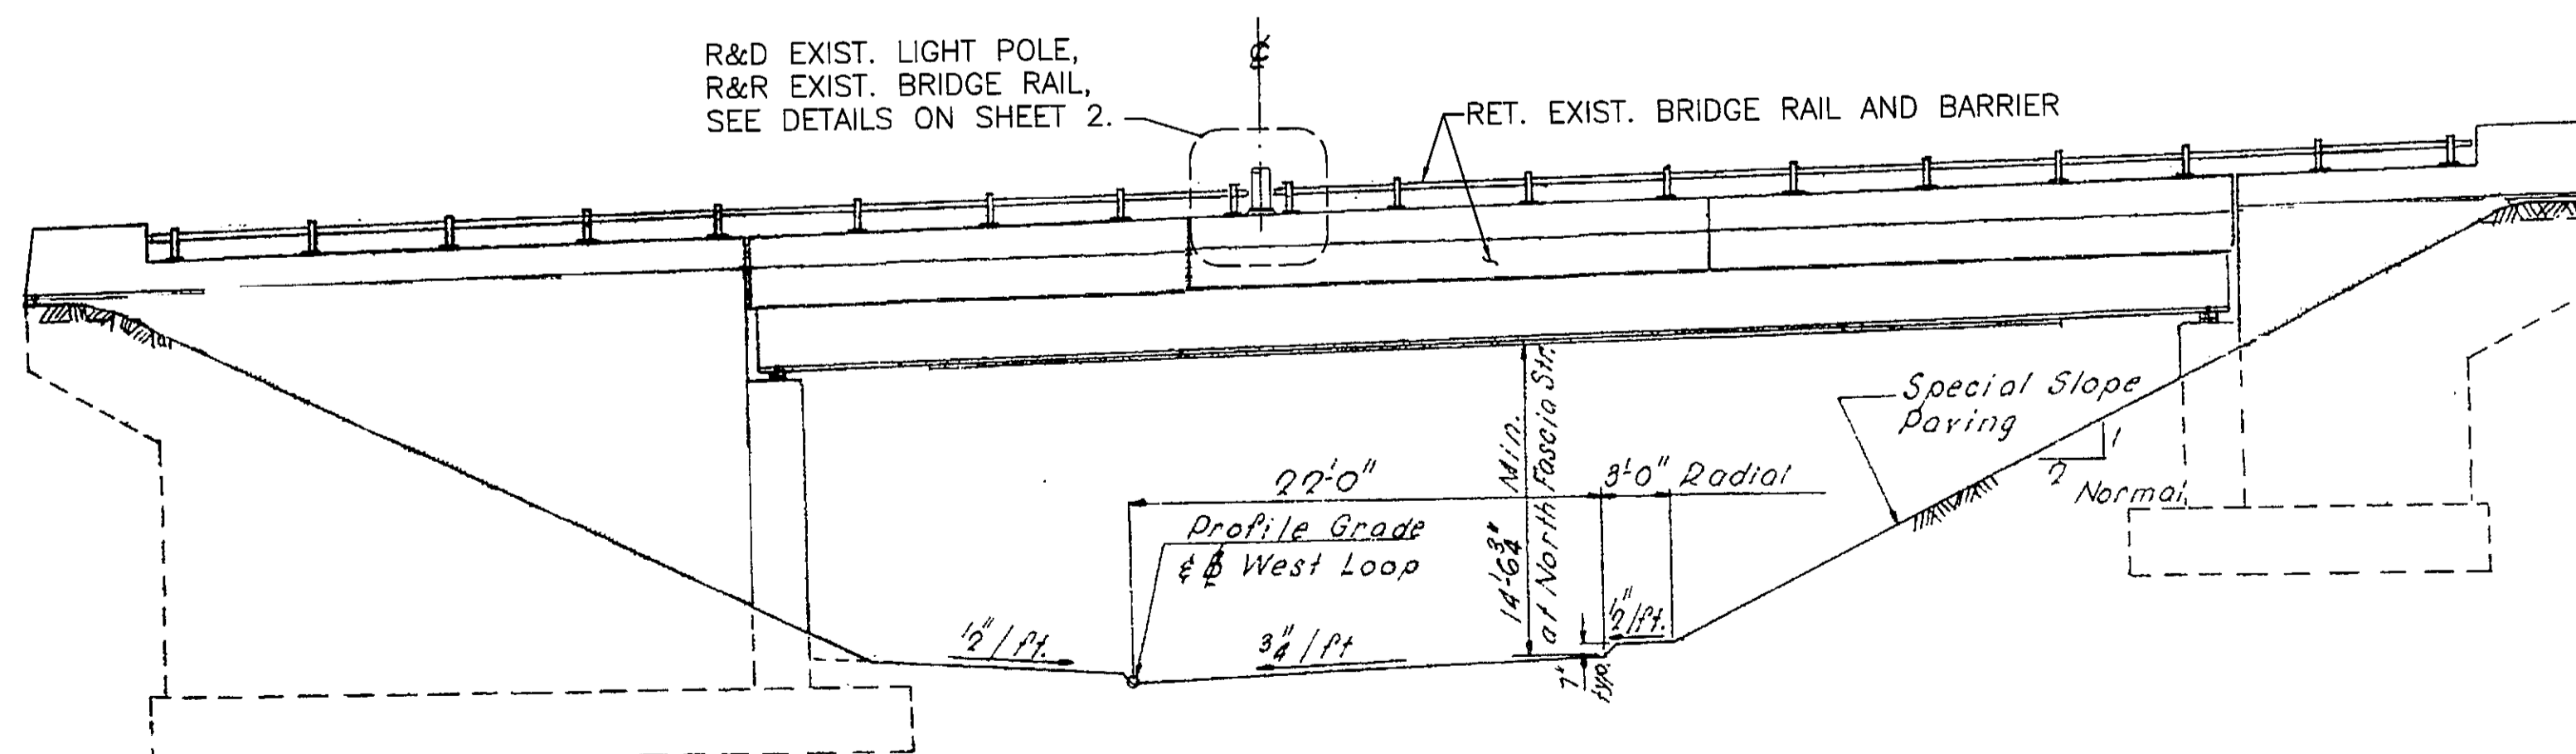

NORTH ELEVATION

SCALE: 1/8" = 1'-0"

GENERAL NOTES:

EXISTING BRIDGE PLANS

PLANS FOR EXISTING BRIDGE NUMBER W-21-046 (BIN 10X) CAN BE FOUND AT THE MASSACHUSETTS DEPARTMENT OF TRANSPORTATION - HIGHWAY DIVISION, 10 PARK PLAZA, BOSTON, MASSACHUSETTS.

EXISTING PLAN, ELEVATION, BASELINE STATIONING, AND UTILITIES SHOWN WERE TAKEN FROM RECORD BRIDGE DRAWINGS. THE CONTRACTOR SHALL FIELD VERIFY ALL RELEVANT DIMENSIONING AND DETAILS PRIOR TO CONSTRUCTION OR ORDERING OF MATERIAL.

DEMOLITION

PRIOR TO CONSTRUCTION, THE CONTRACTOR SHALL SUBMIT TO THE ENGINEER FOR APPROVAL ALL PROPOSED CONSTRUCTION METHODS, EQUIPMENT, CONSTRUCTION SEQUENCE PLANS, AND MATERIAL TO PERFORM THE WORK.

ALL MODIFICATIONS TO PROPOSED WORK SHOWN ON THE PLANS SHALL BE SUBMITTED TO THE ENGINEER FOR REVIEW AND APPROVAL PRIOR TO COMMENCING WORK.

THE CONTRACTOR SHALL EXERCISE CAUTION TO AVOID DAMAGING EXISTING BRIDGE AND ANY COMPONENTS TO REMAIN, AND SHALL BE RESPONSIBLE FOR REPAIRING ANY DAMAGE CAUSED DURING DEMOLITION AND CONSTRUCTION.

EMPLOY TEMPORARY SHIELDING AS REQUIRED TO PROTECT SURROUNDING ROADWAY FROM FALLING OBJECTS AND CONSTRUCTION DEBRIS. DURING CONSTRUCTION THE ENGINEER MAY REVIEW SHIELDING AND DETERMINE WHETHER ADEQUATE PROTECTION HAS BEEN PROVIDED BY THE CONTRACTOR. IF DEEMED NOT ACCEPTABLE, WORK WILL BE SUSPENDED UNTIL ADEQUATE PROTECTION IS PROVIDED.

SCALES

SCALES NOTED ON THE PLANS ARE NOT APPLICABLE TO REDUCED SIZE PRINTS. DIVIDE SCALED BY 2 FOR HALF-SIZE PRINTS.

TRAFFIC MANAGEMENT

REFER TO THE TRAFFIC MANAGEMENT PLANS FOR STAGED CONSTRUCTION SEQUENCING AND PROPOSED TRAFFIC MAINTENANCE THROUGHOUT ALL STAGES OF CONSTRUCTION.

ELECTRICAL WORK

REFER TO THE LIGHTING PLANS FOR ADDITIONAL GENERAL NOTES REGARDING PROJECT ELECTRICAL WORK.

EXISTING UTILITIES

THE CONTRACTOR SHALL VERIFY THE LOCATION OF ALL EXISTING UTILITIES PRIOR TO DEMOLITION AND THE COMMENCEMENT OF EXCAVATION ACTIVITIES. THE CONTRACTOR SHALL PROTECT ALL EXISTING UTILITIES DURING CONSTRUCTION AND SHALL COORDINATE WORK WITH THE UTILITY COMPANIES PERFORMING WORK IN THE SAME AREA.

THE CONTRACTOR SHALL NOTIFY DIG-SAFE (1-888-344-7233) AT LEAST 72 BUSINESS HOURS BEFORE CONSTRUCTION BEGINS.

THE CONTRACTOR SHALL DE-ENERGIZE ALL ELECTRICAL CIRCUITS IN CONDUITS THAT ARE IN AREAS TO BE DEMOLISHED. THE CONTRACTOR SHALL ALSO VERIFY AS NEEDED THE LOCATIONS OF EXISTING REBAR AND ELECTRICAL CONDUIT TO AVOID DAMAGE DURING CONSTRUCTION.


LEGEND:

[Symbol] LIMITS OF DEMOLITION

ESTIMATED QUANTITIES

(NOT GUARANTEED)

STEEL THRIE BEAM BRIDGE RAIL REMOVED AND RESET .....	40 FT
ELECTRICAL CONDUIT REMOVED AND DISPOSED .....	130 FT
METAL BRIDGE RAILING REMOVED AND RESET .....	80 FT
METAL BRIDGE RAILING (1 RAIL), ALUMINUM (TYPE AL-1) .....	6 FT

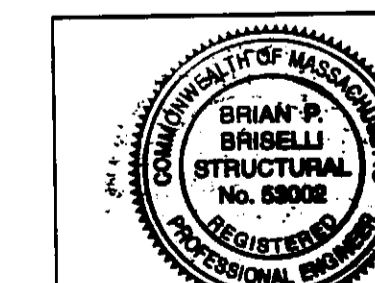

Brian P. Brull: 2/14/19

JACOBS

120 ST. JAMES AVENUE  
5TH FLOOR  
BOSTON, MA 02116

DEC. 8, 2018

ISSUED FOR CONSTRUCTION

**massDOT**  
Massachusetts Department of Transportation  
Highway Division  
**PROPOSED BRIDGE REHABILITATION  
WEST SPRINGFIELD**

INTERSTATE ROUTE 91  
OVER WEST LOOP (AT ROUTE 5)  
MASSACHUSETTS DEPARTMENT OF TRANSPORTATION  
HIGHWAY DIVISION  
10 PARK PLAZA BOSTON, MASS

*Thomas A. D. Kelly, P.E.*  
TITLE: State Bridge Engineer  
*Thomas A. D. Kelly, P.E.*  
TITLE: CHIEF ENGINEER

STATE	FED. AID PROJ. NO.	SHEET NO.	TOTAL SHEETS
MA	NHP(NHS)-091S(305)X	36	39
PROJECT FILE NO.		608600	


**LIGHT SUPPORT DETAILS**

**NOTES:**

- FOR GENERAL NOTES, SEE SHEET 1 OF 2.
- PROPOSED BRIDGE RAILING SHALL BE REINSTALLED CONTINUOUS AT AREAS OF EXISTING LIGHT POLE REMOVAL. CONTRACTOR SHALL FIELD VERIFY RAILING SECTION LENGTHS, SPLICE LOCATIONS, AND POST LOCATIONS TO DETERMINE WHAT COMPONENTS AND LOCATIONS CAN BE REUSED. SHOP DRAWINGS SHALL BE SUBMITTED TO THE ENGINEER FOR APPROVAL OF MATERIALS AND PROPOSED LAYOUT PRIOR TO RAILING REINSTALLATION.


**LEGEND:**

 LIMITS OF DEMOLITION

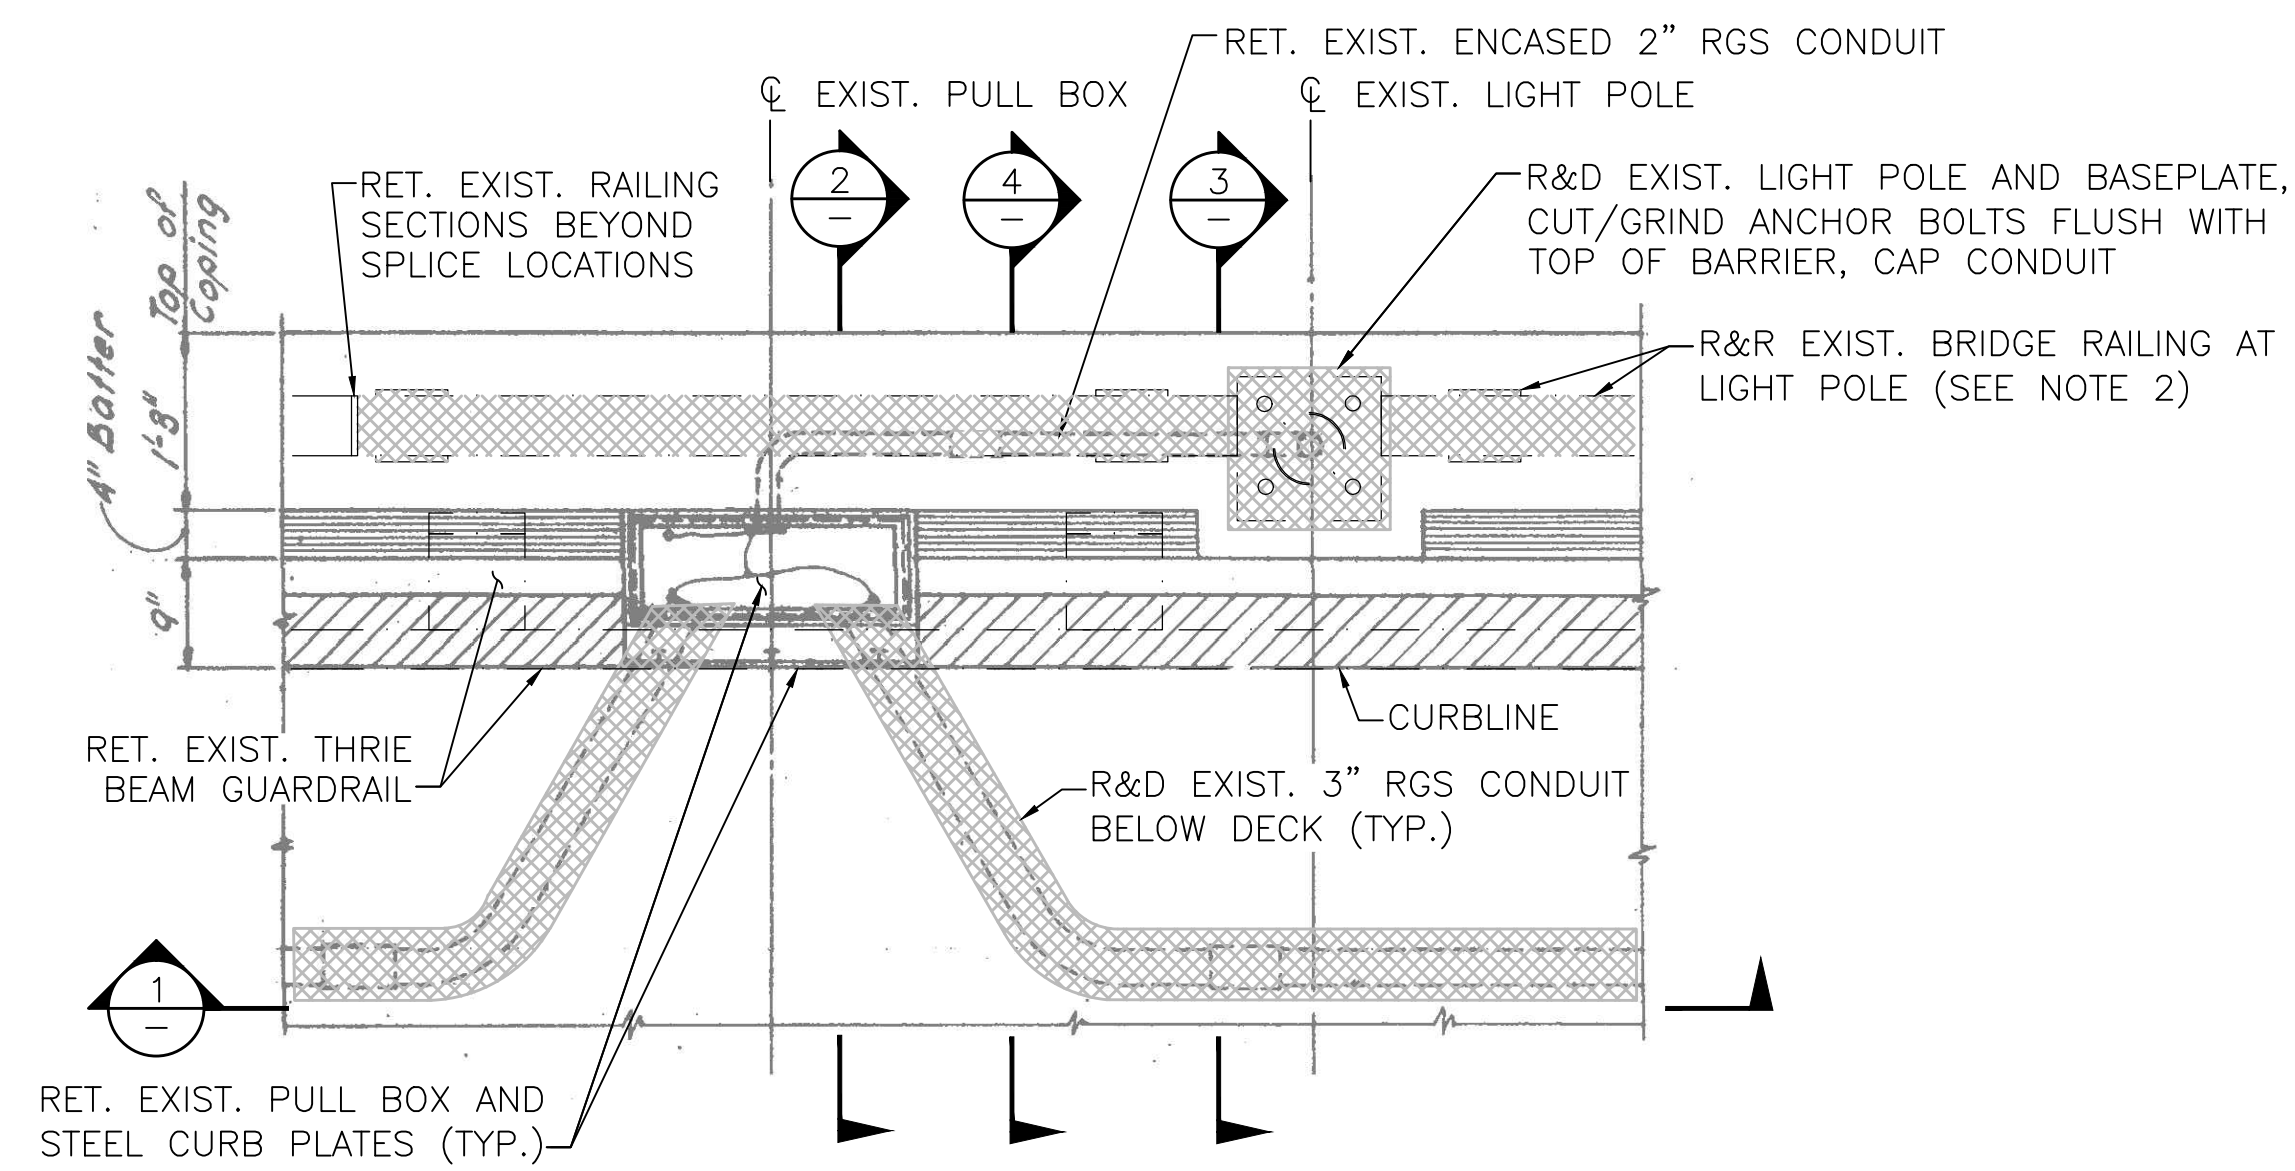


**PARTIAL PLAN AT EXISTING LIGHT POLE**

SCALE: 3/4" = 1'-0"

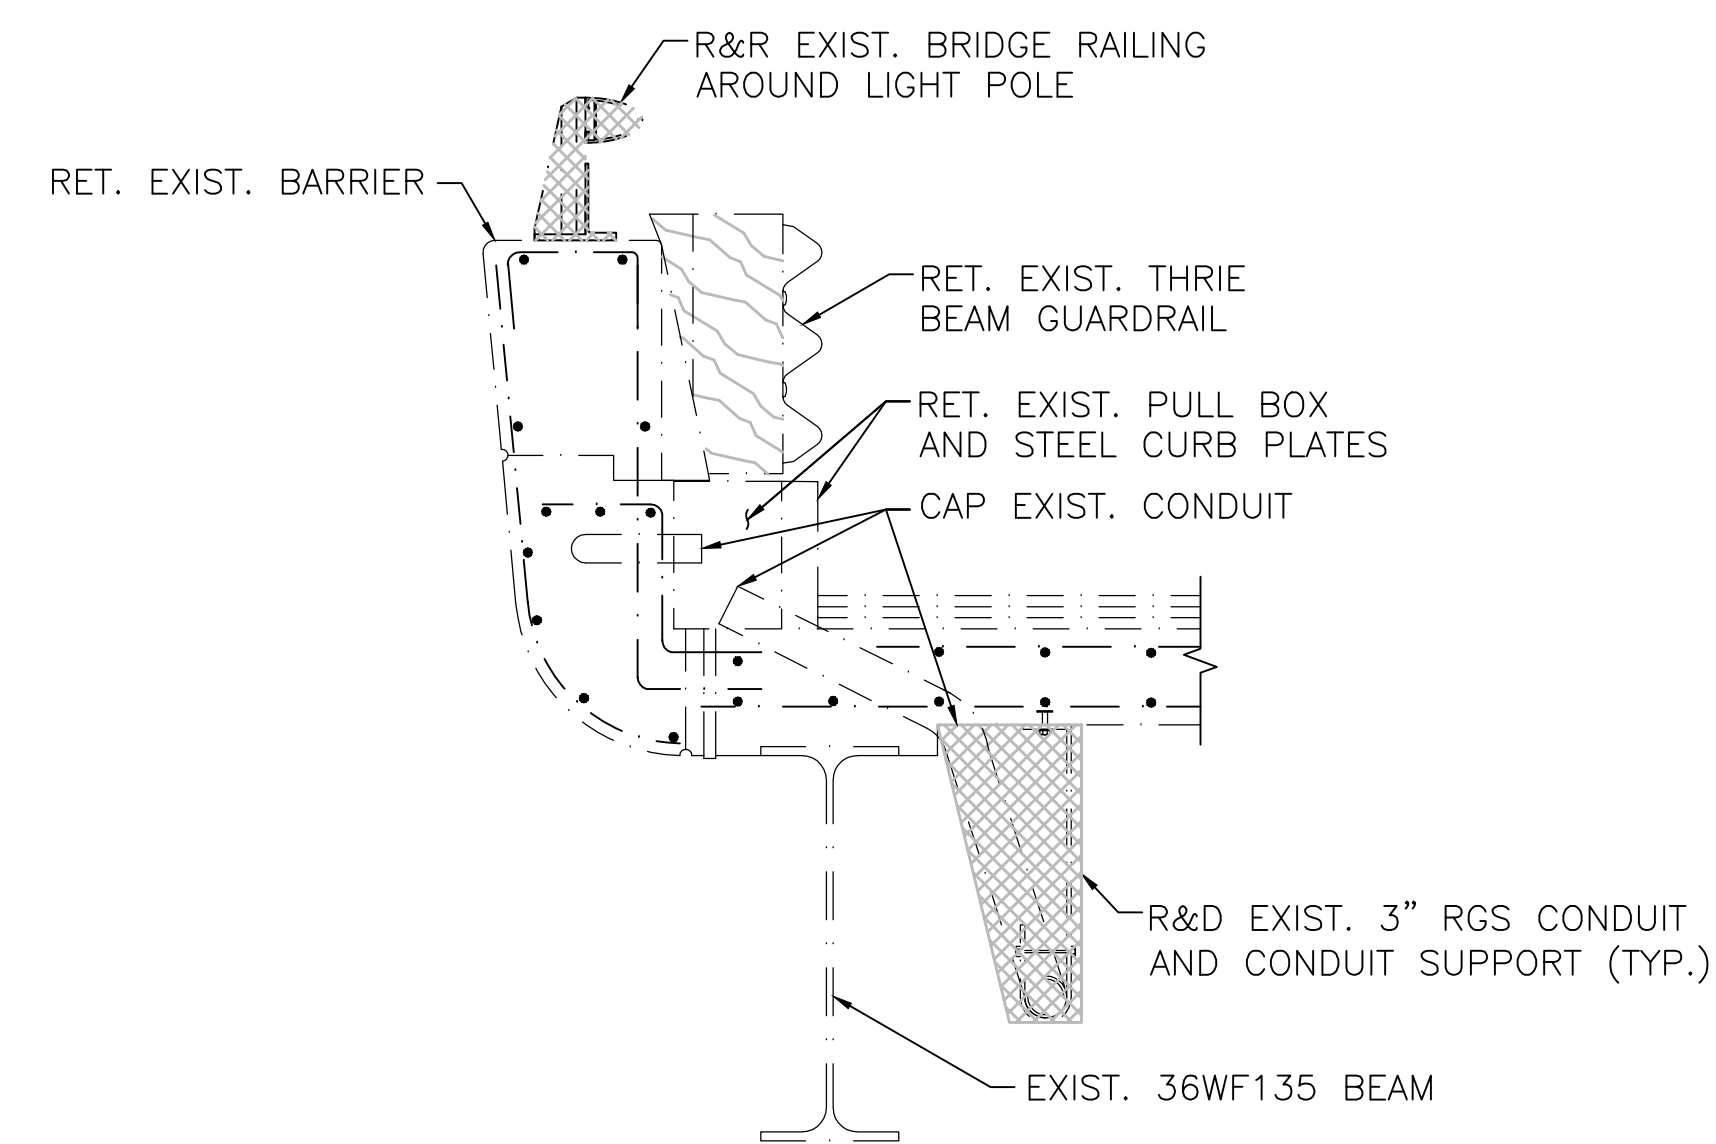

**SECTION AT EXISTING PULL BOX**


SCALE: 3/4" = 1'-0"

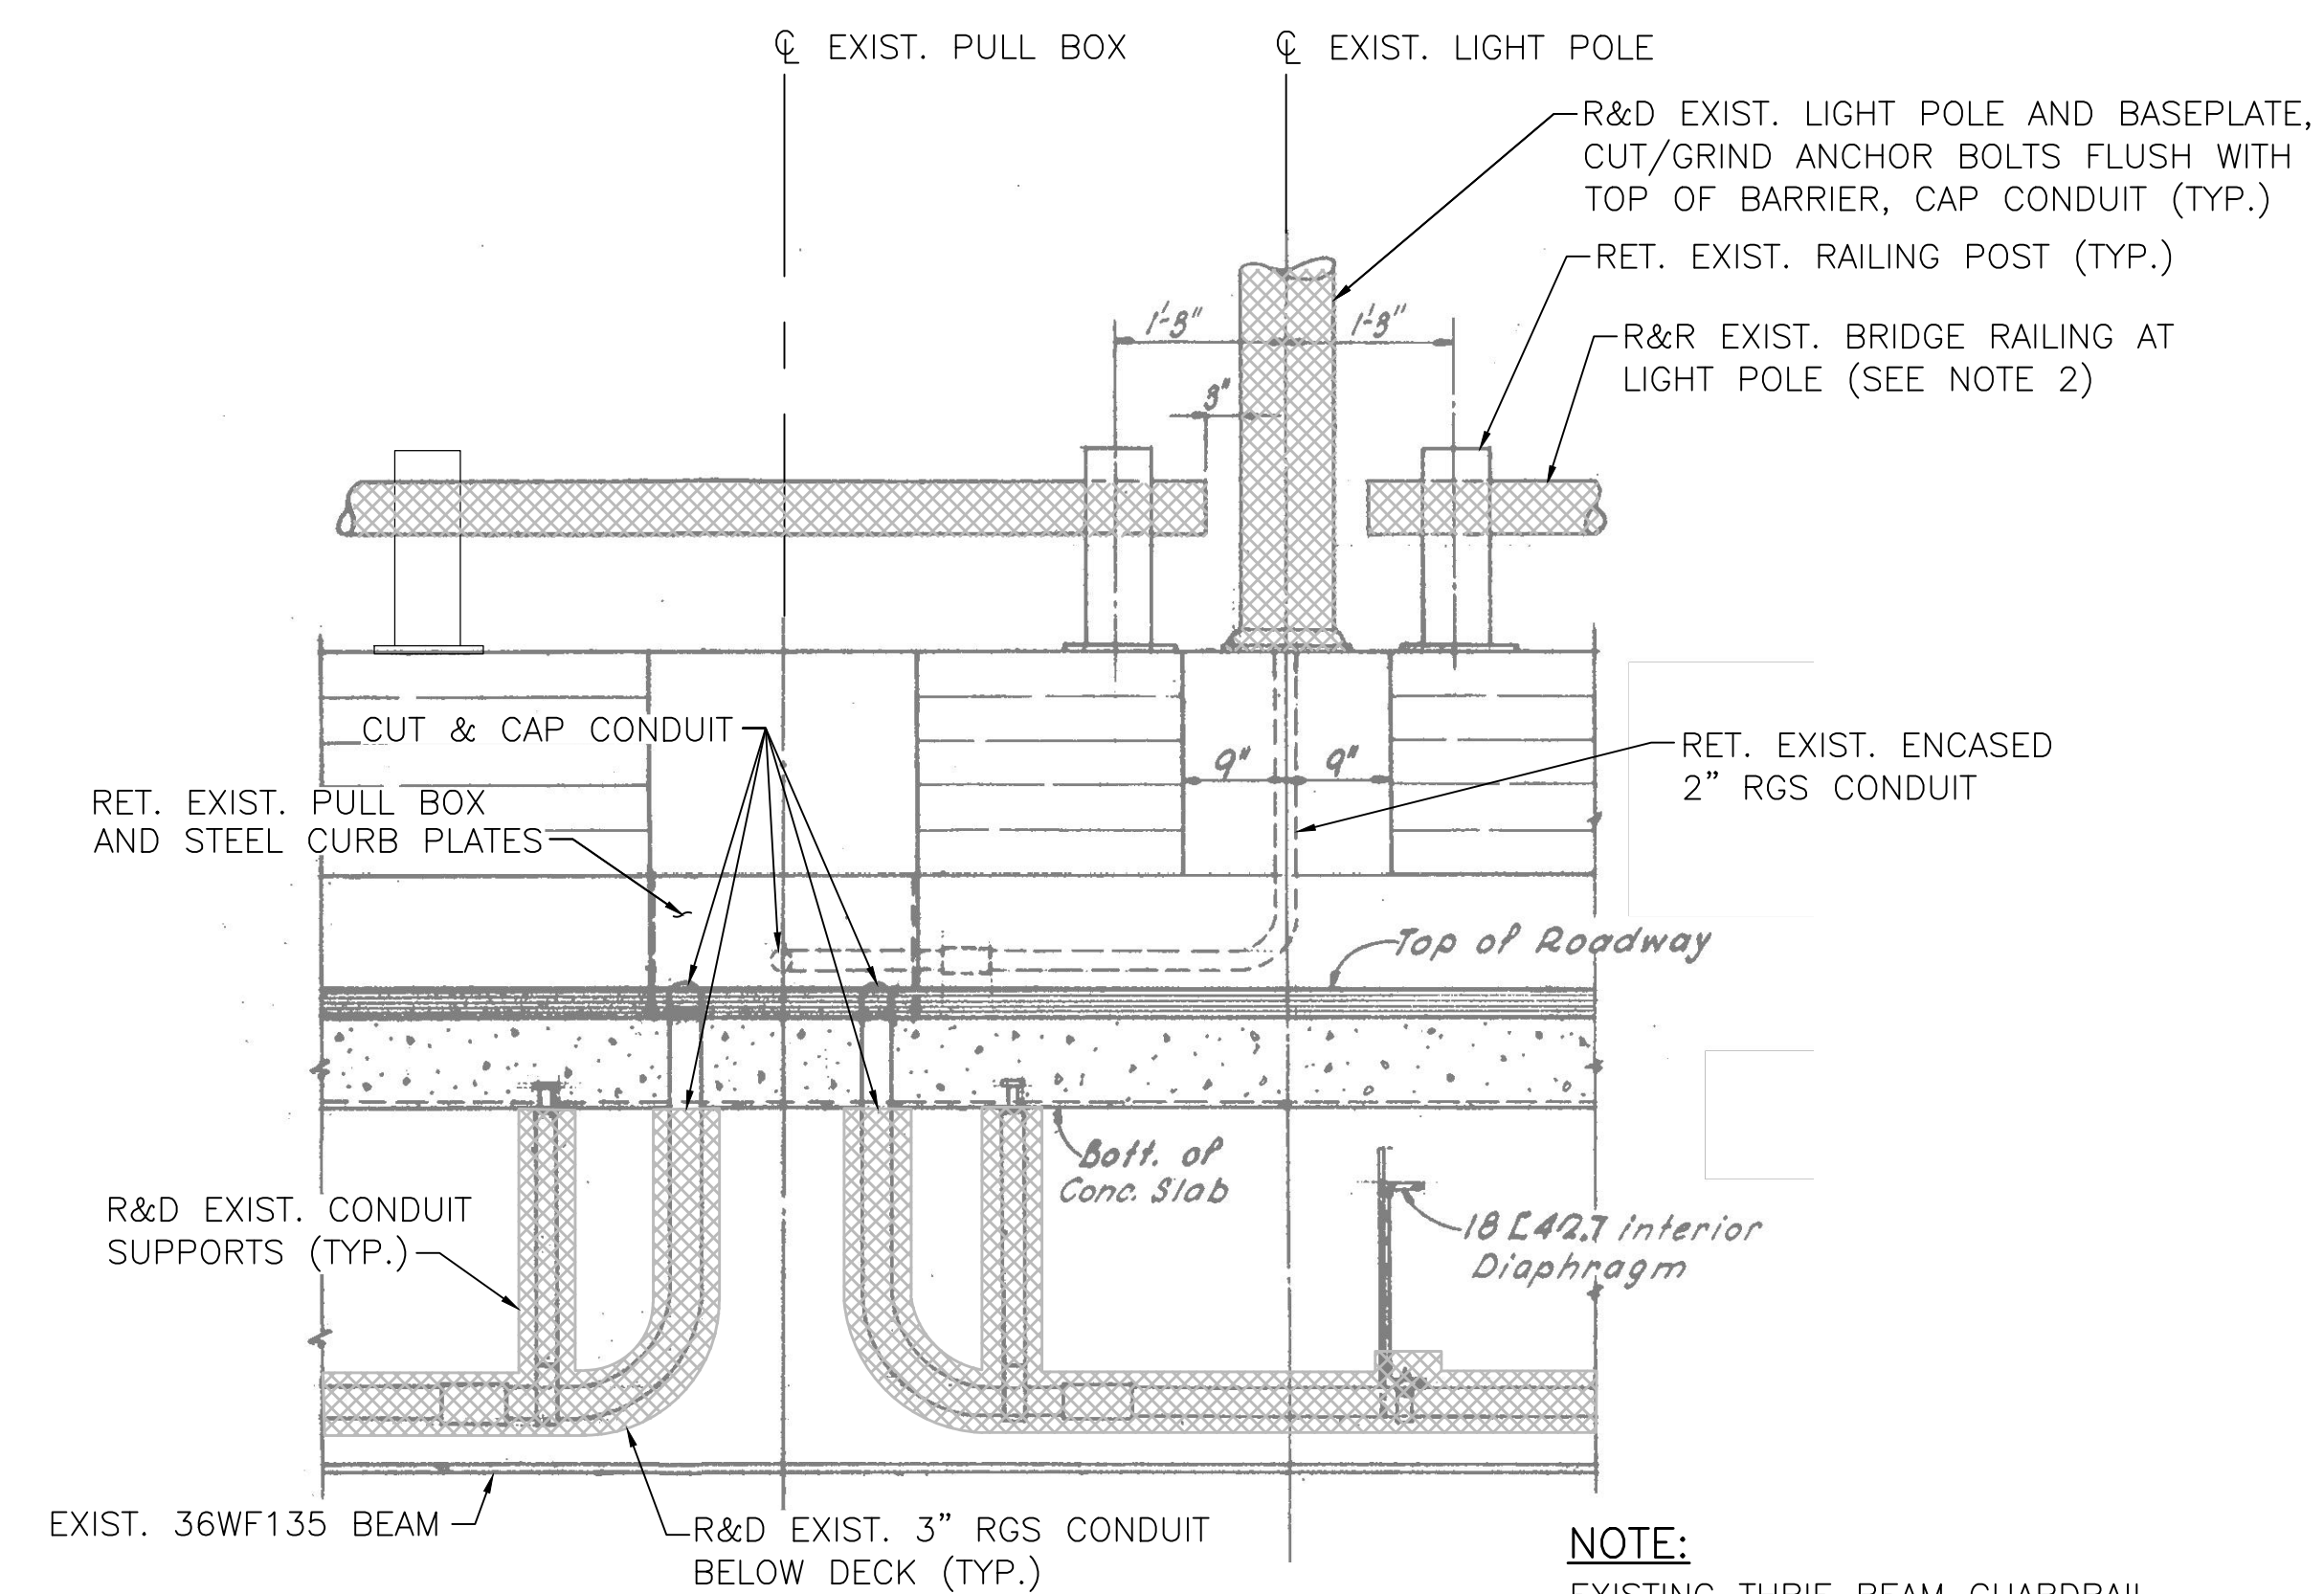

**SECTION AT EXISTING LIGHT POLE**


SCALE: 3/4" = 1'-0"

**NOTE:**  
EXISTING THRIE BEAM GUARDRAIL NOT SHOWN FOR CLARITY.

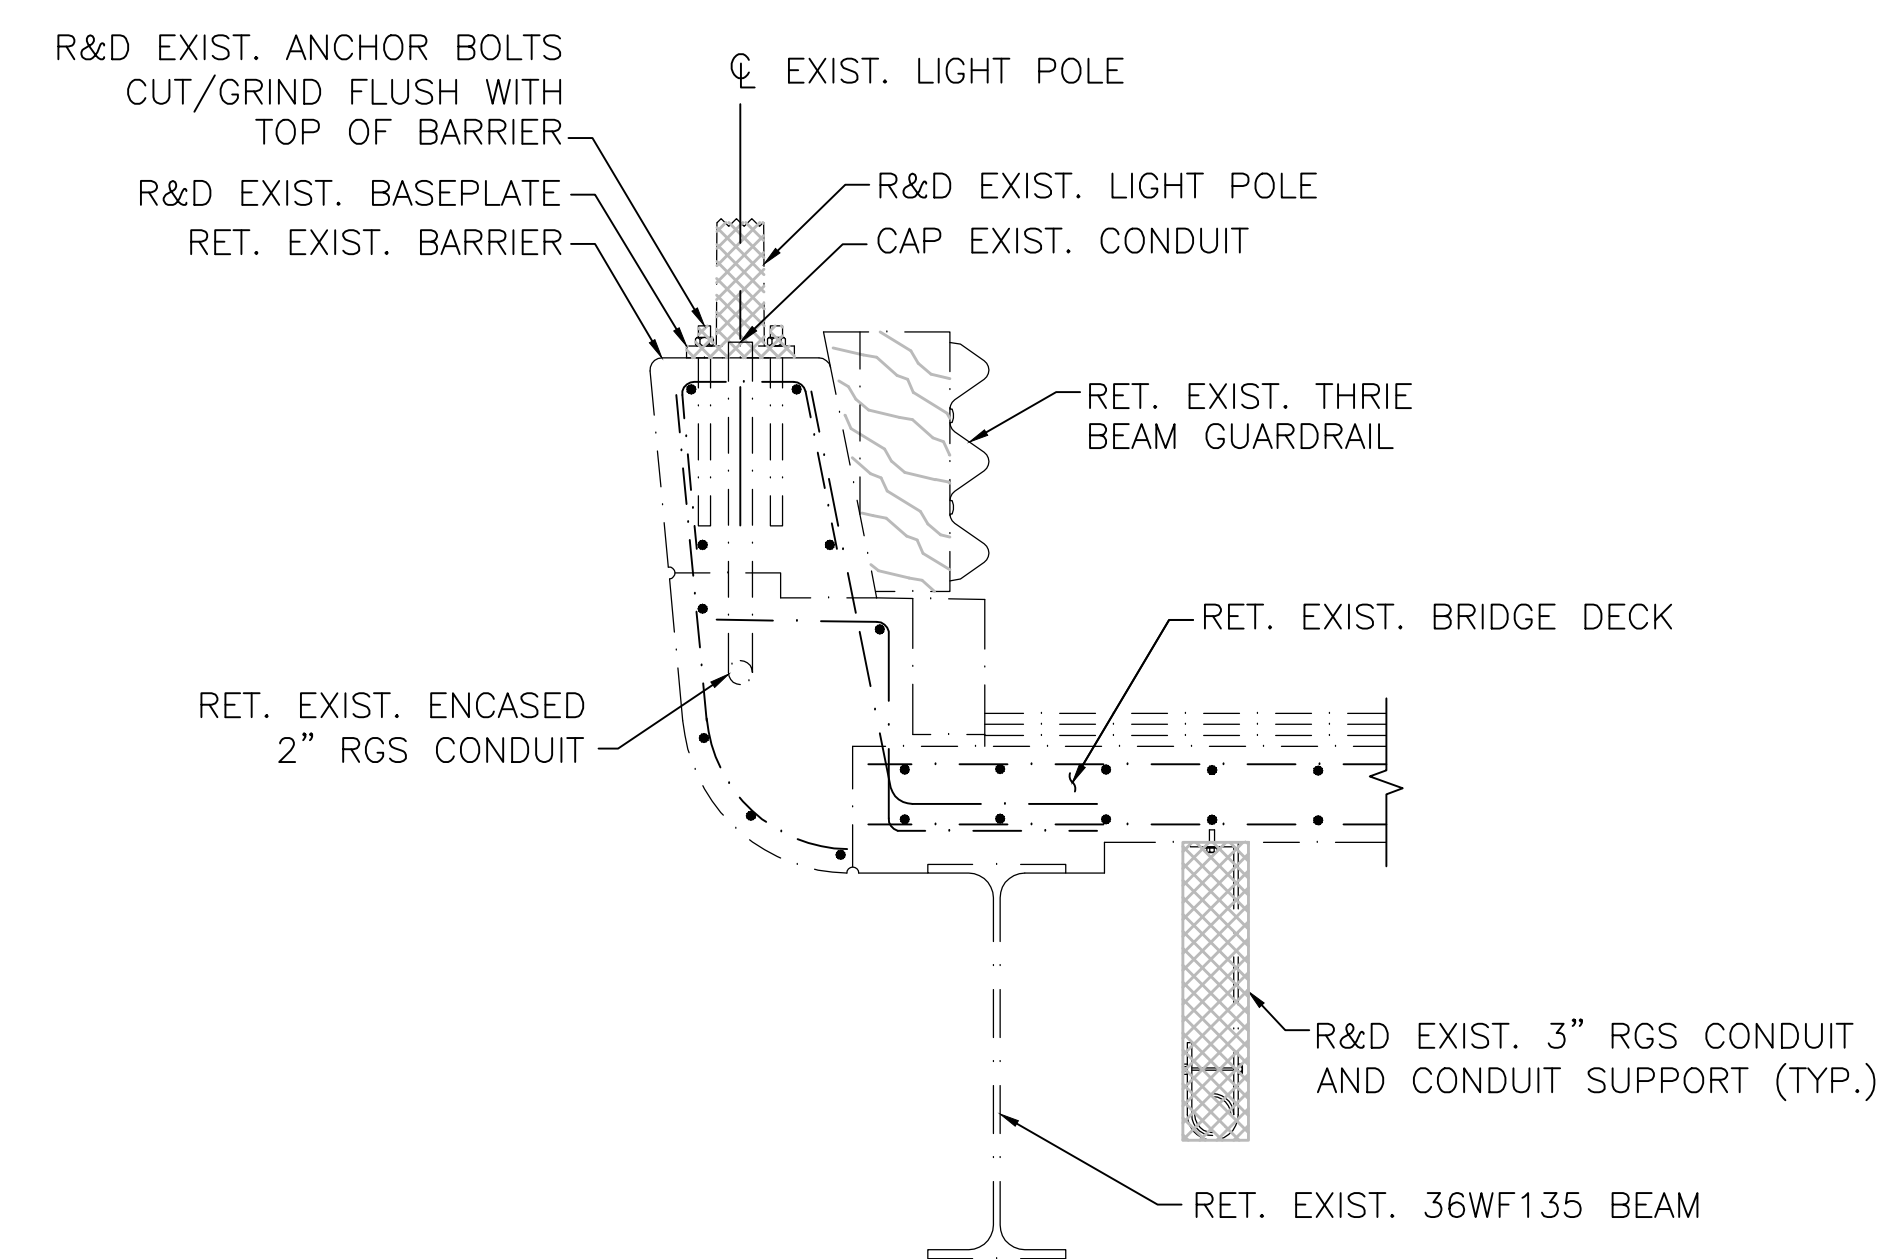

**SECTION AT EXISTING LIGHT POLE BASE**

SCALE: 3/4" = 1'-0"

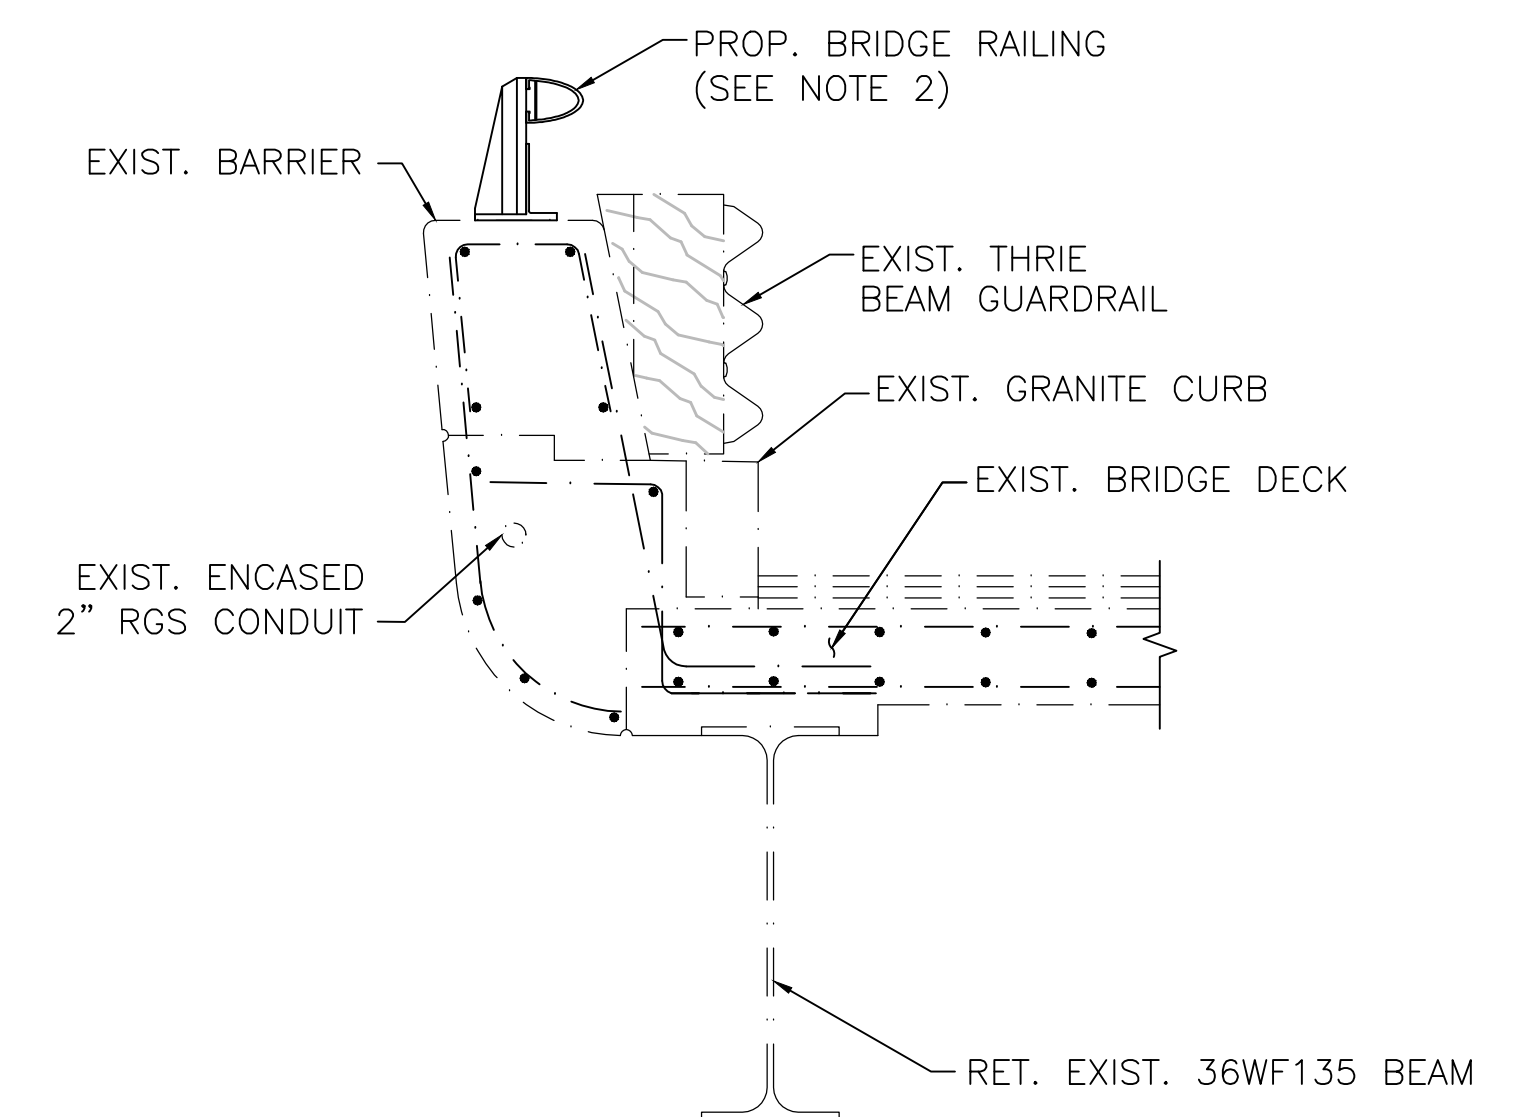

**PROPOSED SECTION**

SCALE: 3/4" = 1'-0"

DEC. 8, 2018	ISSUED FOR CONSTRUCTION
DATE	DESCRIPTION
	USE ONLY PRINTS OF LATEST DATE

GENERAL NOTES

**FOUNDATIONS**  
Foundations may be altered if necessary to suit conditions encountered during construction.

**DATE AND SEAL**  
To be located as shown on Sheet 5. A Sheet showing Size and Character of Numerals will be furnished. Seal to be furnished by the State and shall be set by the Contractor.

**DESIGN**  
In Accordance with the current AASHO Specifications (1961 Edition) and Interim Specifications for H520-44 Loading, modified for military Loading.

**REINFORCEMENT**  
All bars shall have deformations conforming to A.S.T.M.A.-305. Unless otherwise shown on the plans, Bars shall be lapped 20 diameters for Splices, except that Bars near the Top of Slabs and Beams with more than 12 inches of Concrete under the Bars shall be lapped 35 diameters for Splices.

**BRIDGE RAILING**  
See Department Standard Plans dated May 1965, for details of Bridge Railings, (1 Rail) Option

**SCALES**  
Scales noted on Plans are not applicable to reduced Size Prints. Divide Scales by 2 for 1/2-Size Prints.

**BENCH MARK**  
B.M. #7 - Top of right outer corner bottom concrete Step - House Number 1162 Route 5, Sta. 101+38 & Route 5, 68' 0". Elev. 67.31

**SURVEY BOOK NUMBERS**  
27361, 27363, 20976, 19814

**UNSUITABLE MATERIAL**  
All Unsuitable Material shall be Removed within the Limits of the Foundation of the Structure.





**ANCHOR BOLTS**  
All Anchor Bolts are to be Set by Template and Placed Before Concrete is Poured.

ESTIMATED QUANTITIES (NOT GUARANTEED)

ITEM	QUANTITIES
Class B Rock Excavation	5 C.Y.
Bridge Excavation	1730 C.Y.
Gravel Borrow	850 C.Y.
Gravel Borrow for Bridge Foundations	1563 C.Y.
Class I Bituminous Concrete Pavement - Type I-1	110 Tons
Class I Dense Protective Bottom Course for Bridges	120 Tons
Metal Bridge Railing (1 Rail) Option	336 L.F.
Metal Bridge Railing - Type M-2	130 L.F.
Bridge Structure (W-21-47)	1 L.S.

The following Quantities are included in Item 339.03

Steel Reinforcement for Structures - 184,500 lbs.  
Structural Steel - 373,000 lbs.

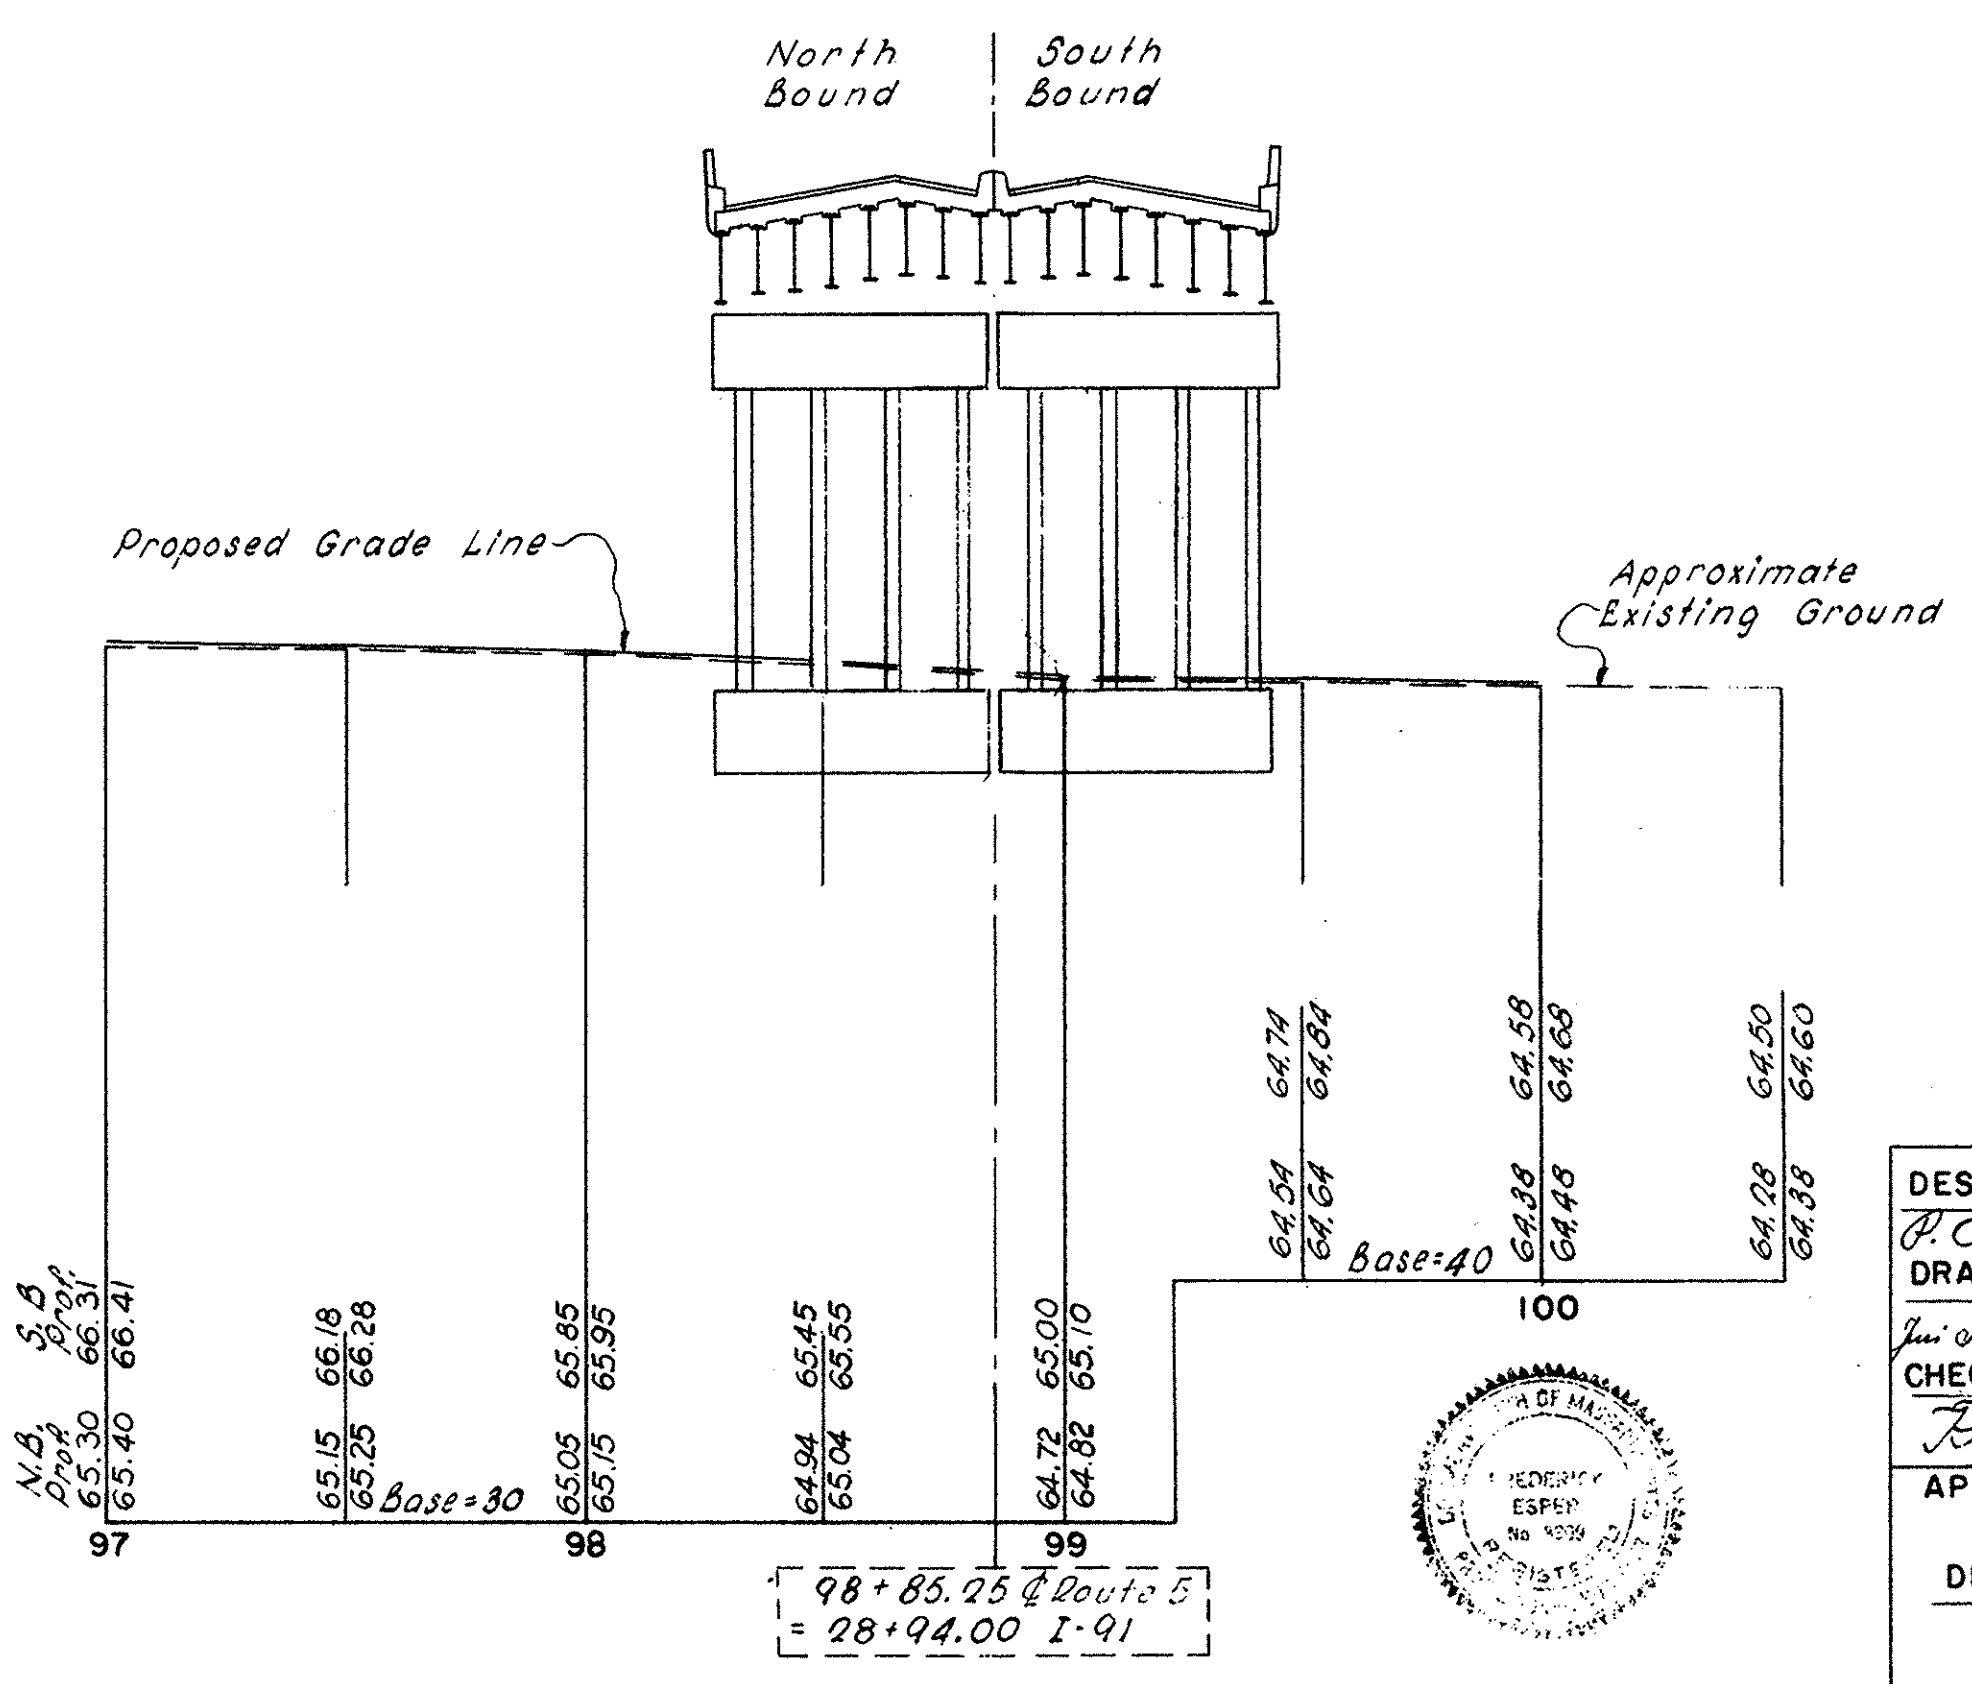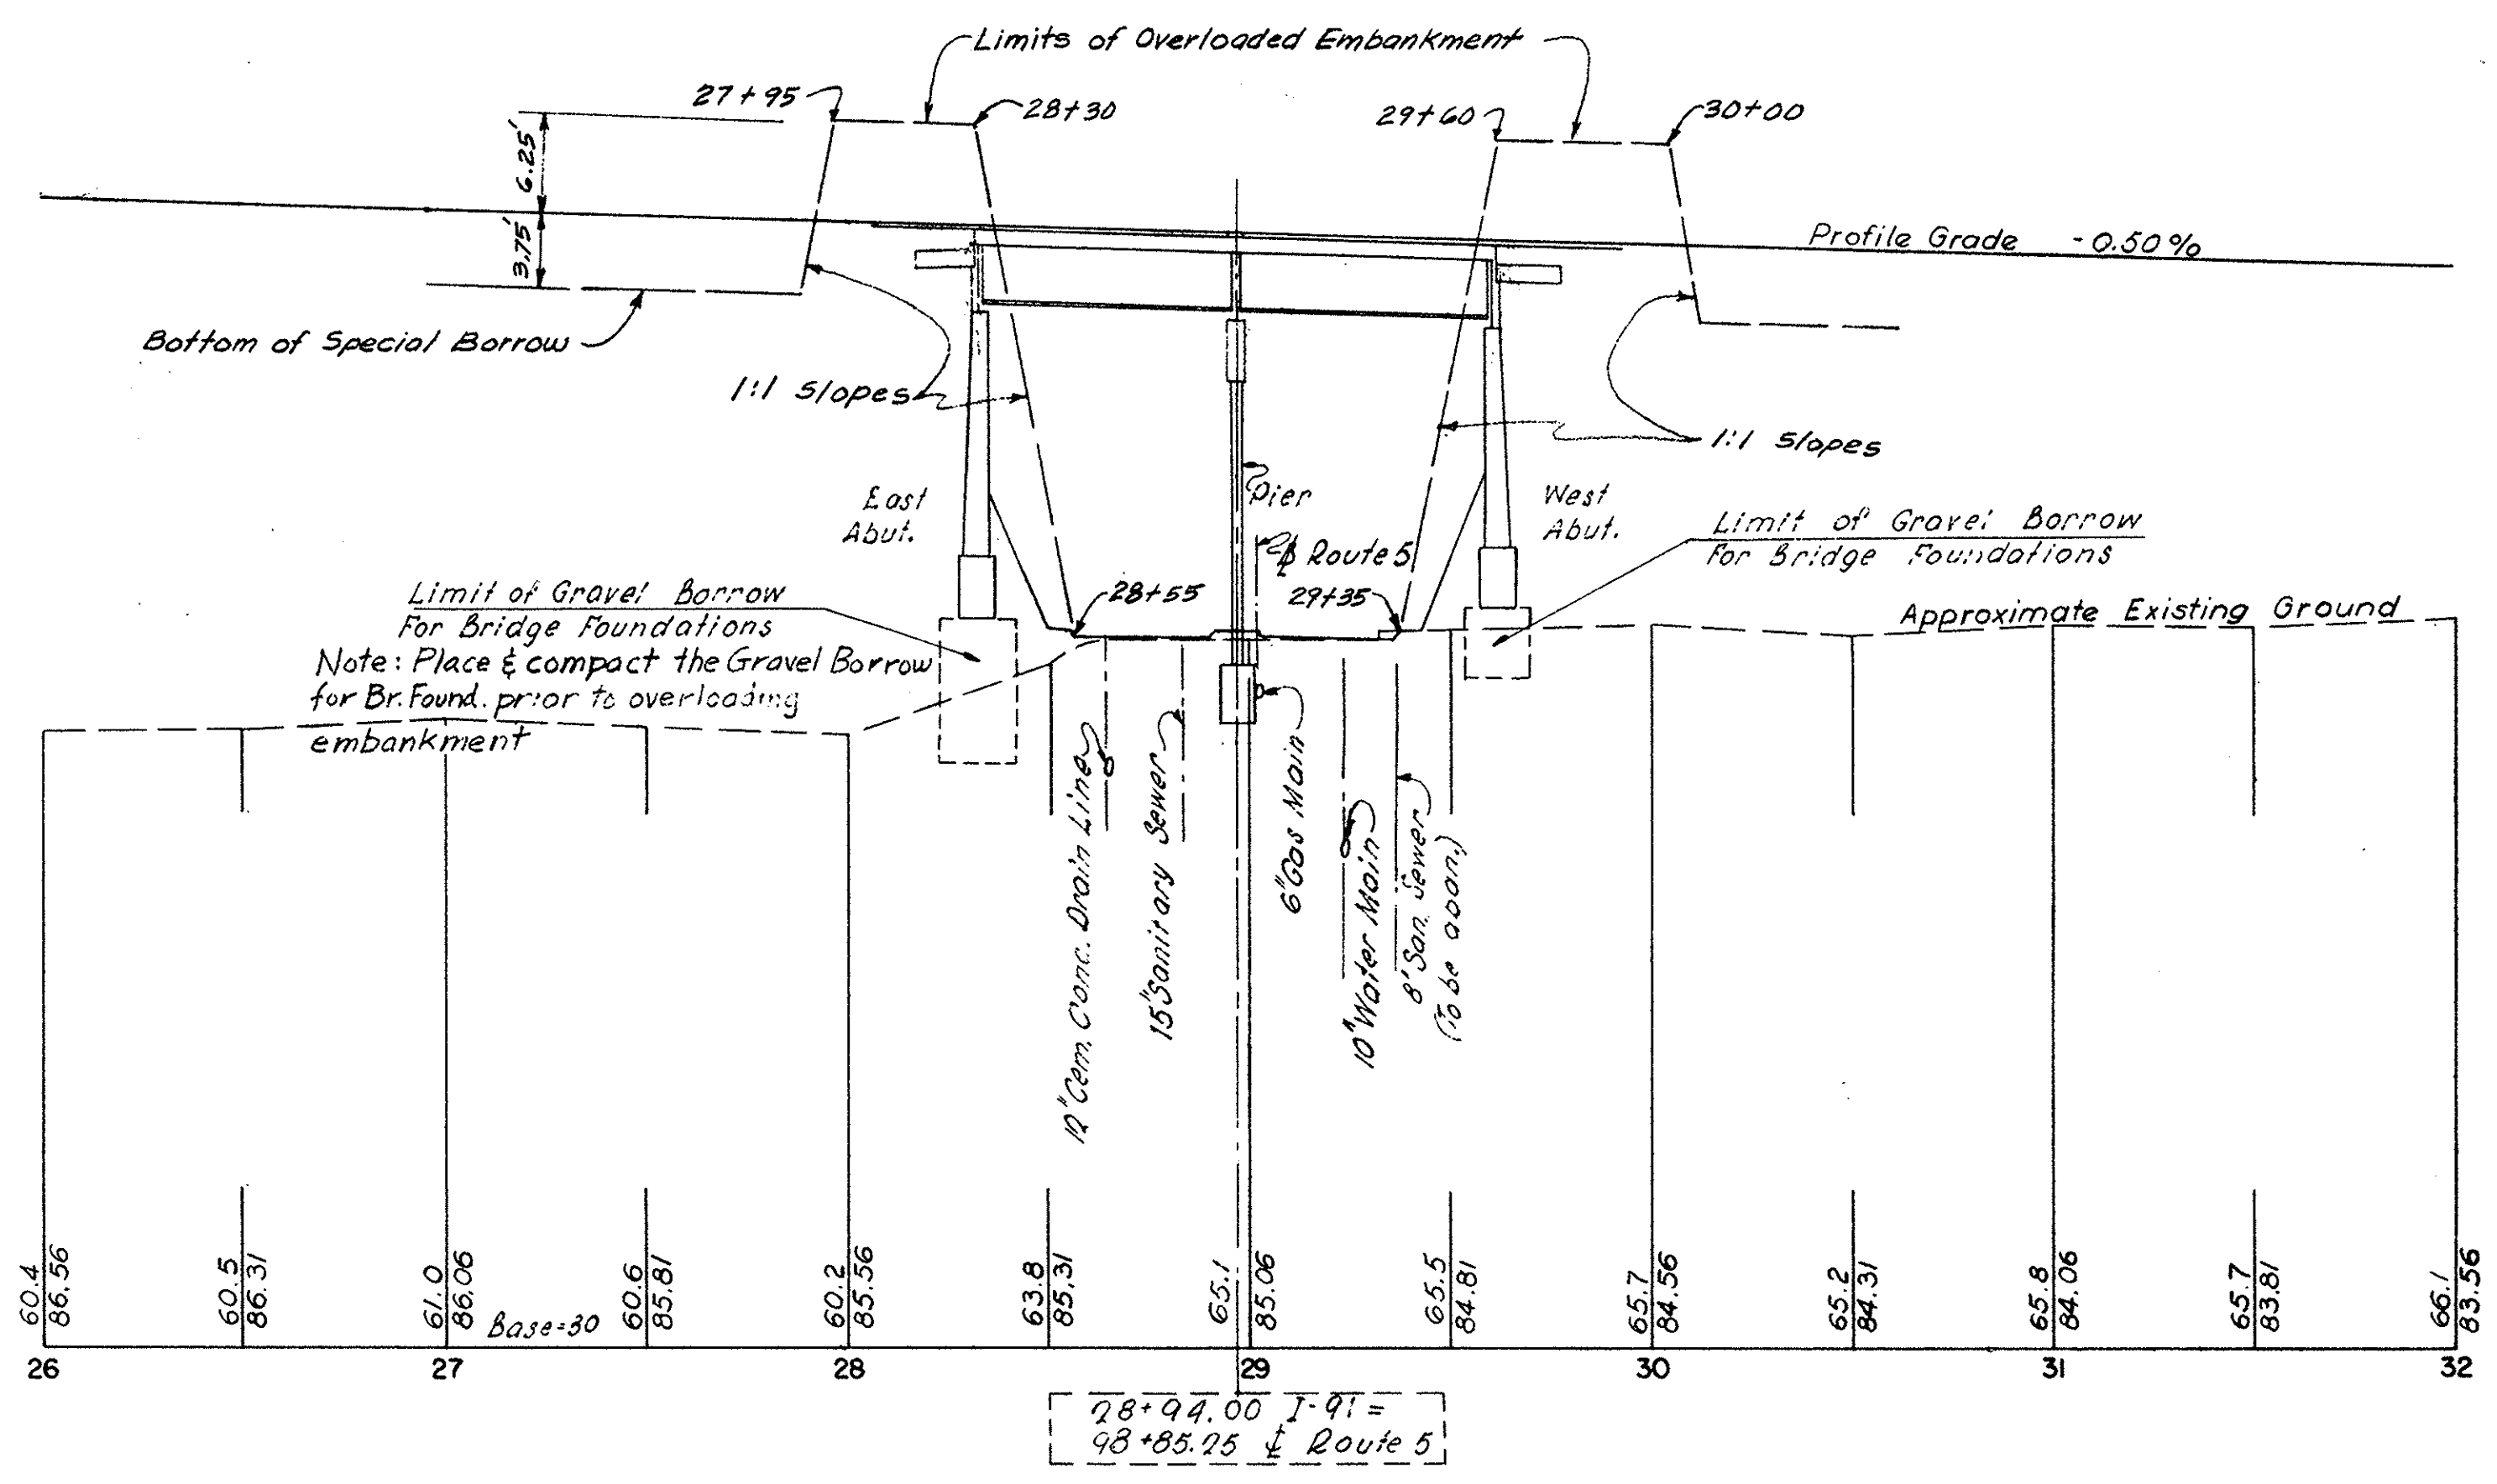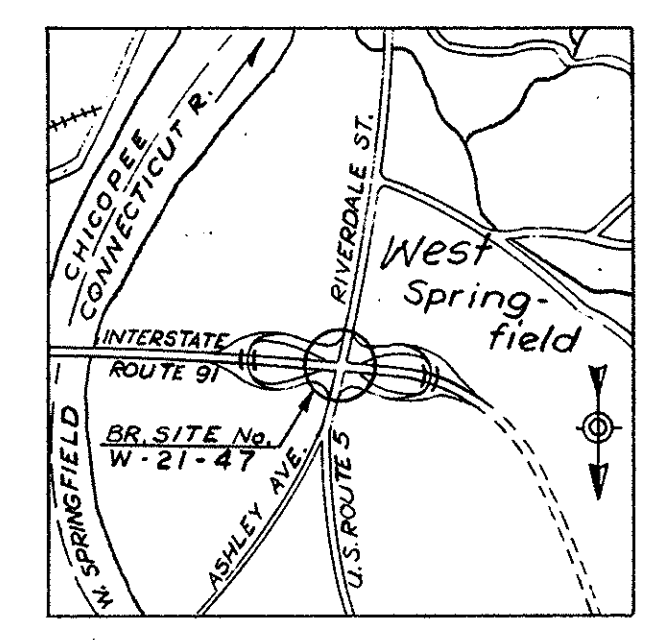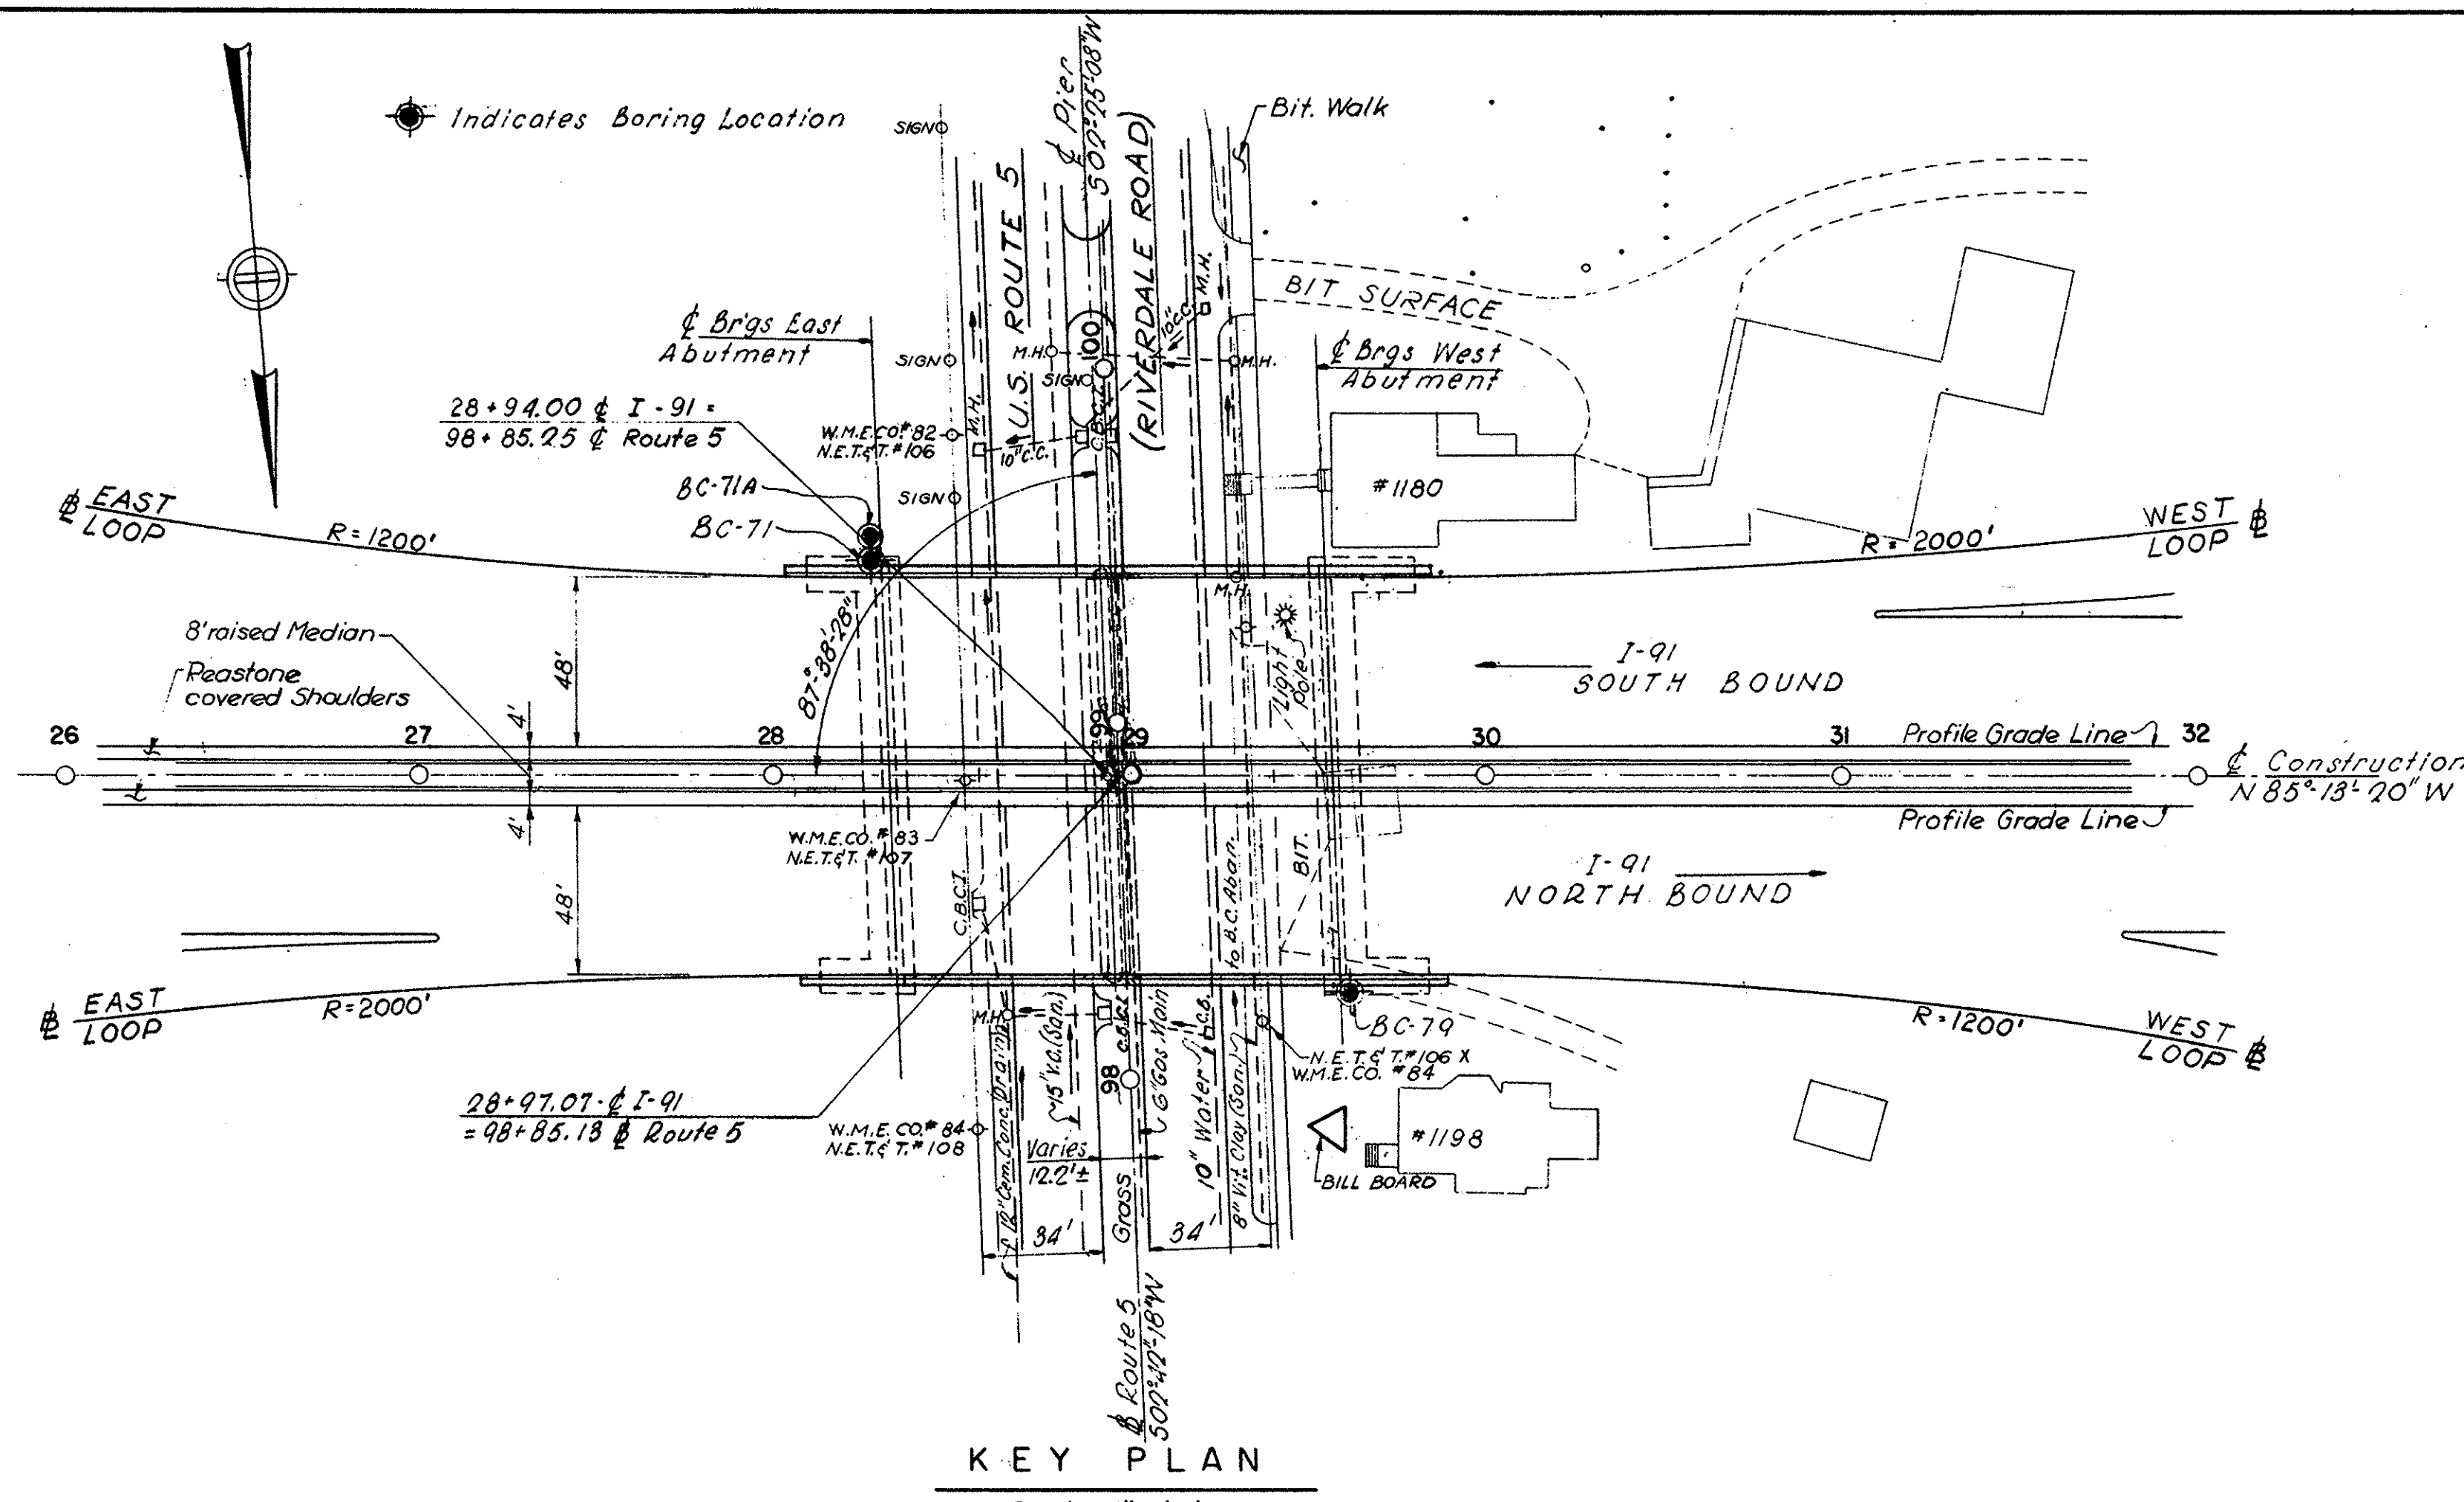

LOUIS BERGER & ASSOCIATES  
CONSULTING ENGINEER  
WELLESLEY HILLS, MASS.

DESIGNED BY APRIL 9, 1966 ISSUED FOR CONSTRUCTION

THE COMMONWEALTH OF MASSACHUSETTS  
PROPOSED BRIDGE  
WEST SPRINGFIELD MASS.  
INTERSTATE ROUTE 91  
INTERSTATE ROUTE 91 OVER ROUTE 5

SCALES AS NOTED  
OFFICE OF  
DEPARTMENT OF PUBLIC WORKS  
100 NASHUA ST. BOSTON, MASS.  
APR. 1966

APPROVED FOR DESIGN

BRIDGE ENGINEER CHIEF ENGINEER



WEST SPRINGFIELD					
PUB. NO. DIV. NO.	STATE	FED. AID PROJ. NO.	FISCAL YEAR	SHEET NO.	TOTAL SHEETS
1	MASS.	91-1(54)9	19	81	188

80


60

40


20

00


-20

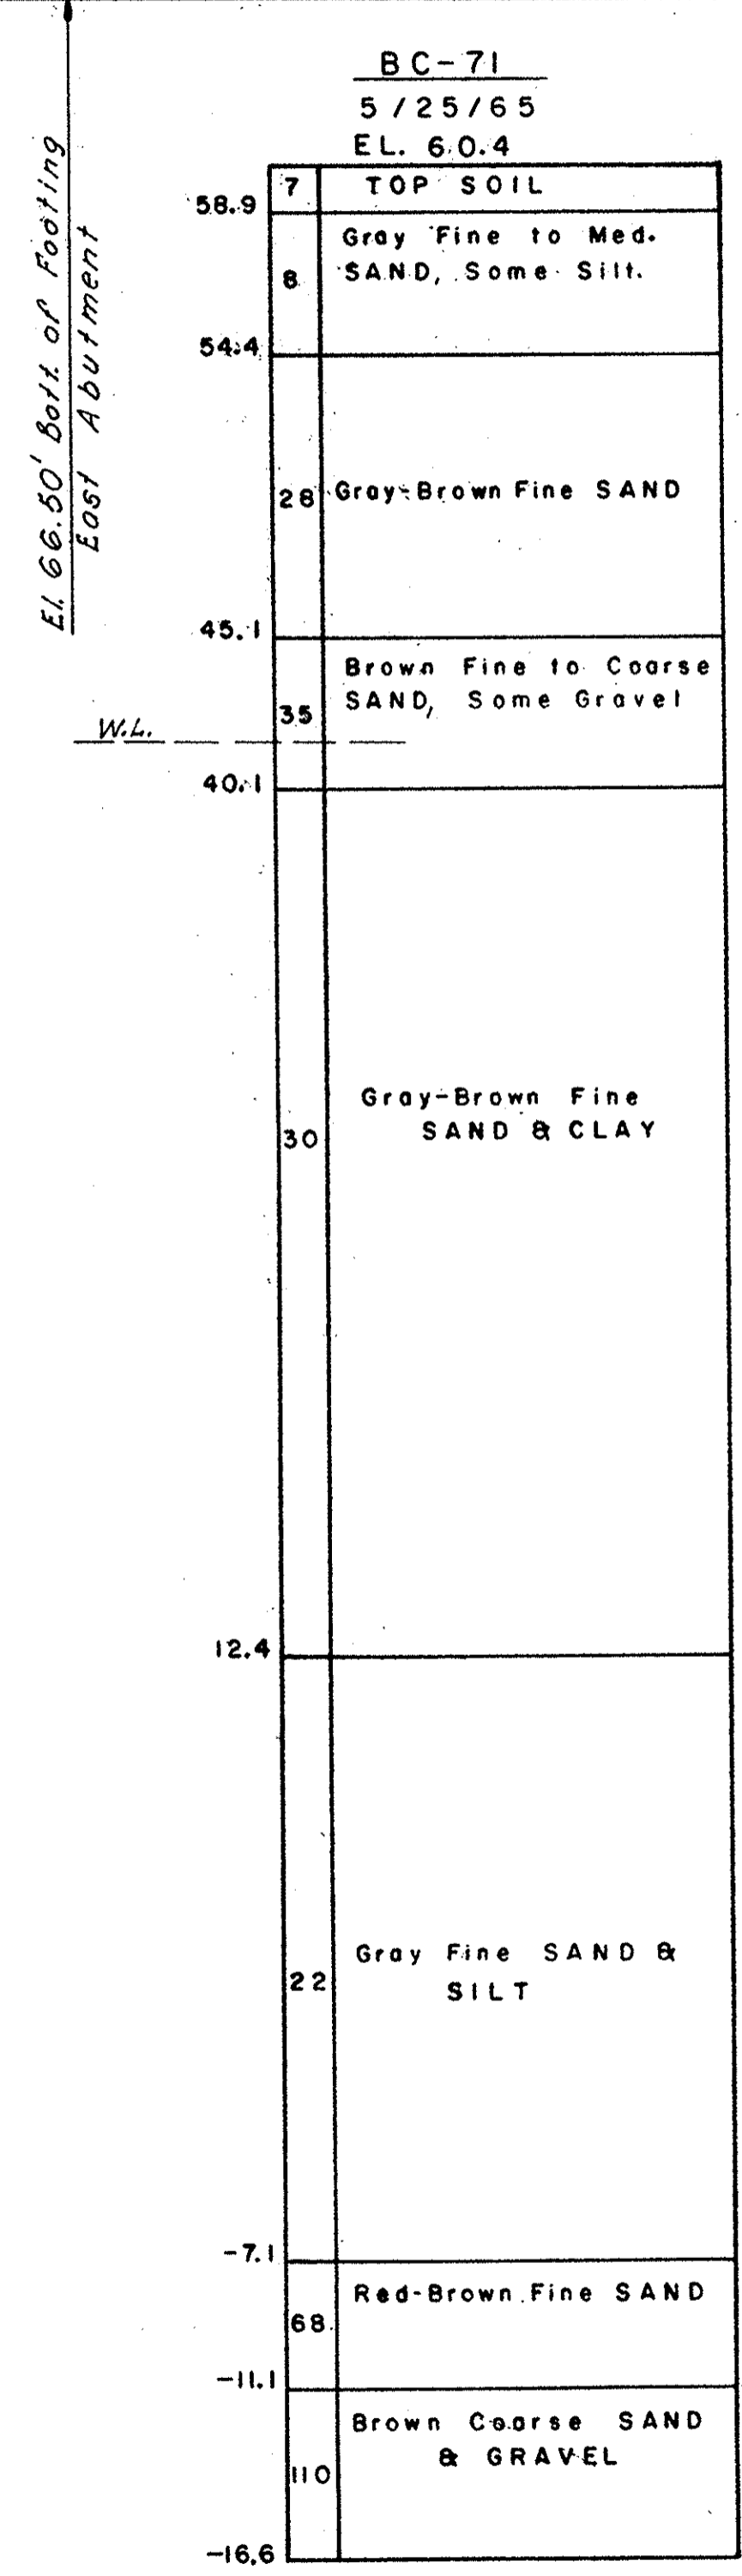


Boring Taken by  
D.R.W. Soils Unit

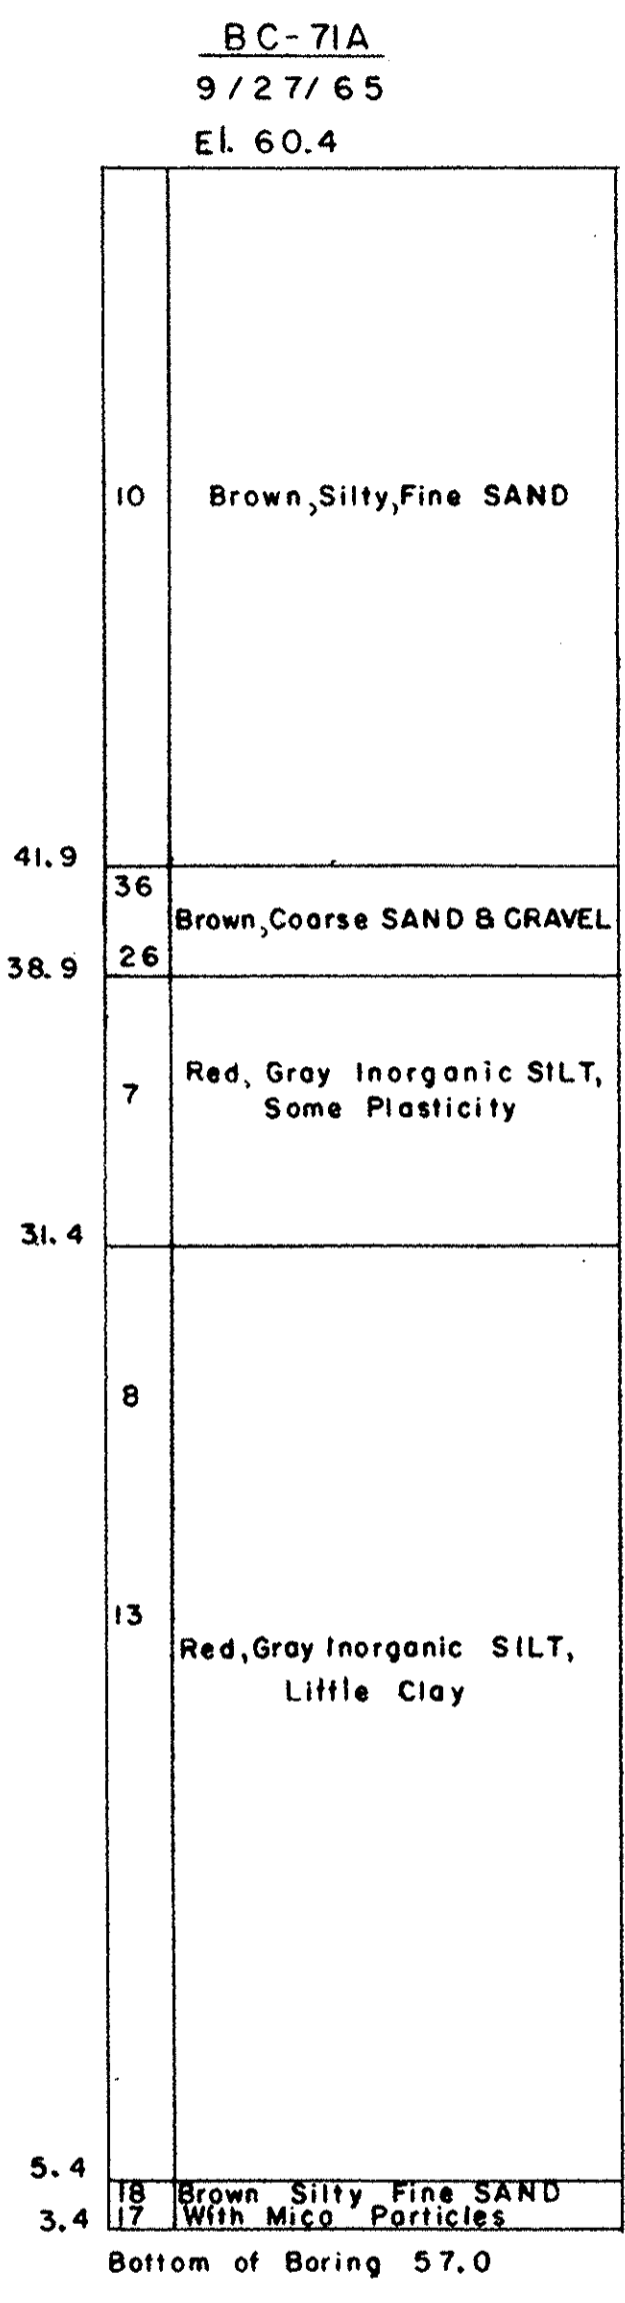

**BC-79**  
5/21/65  
EL. 66.6

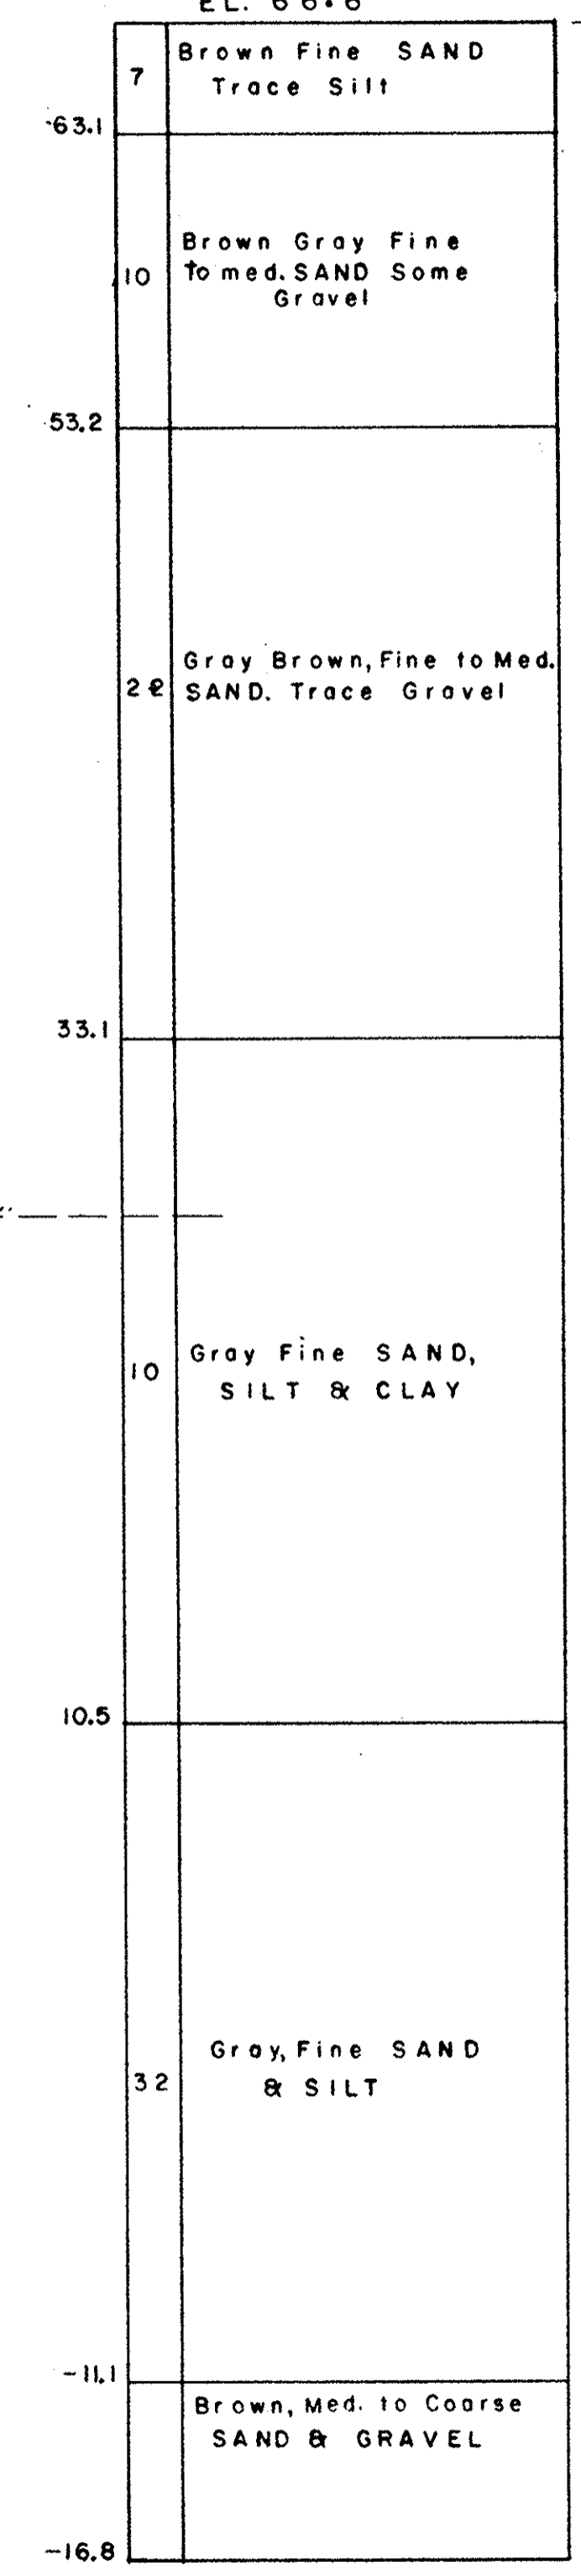

El. 66.50' bott. of Footing West Abutment

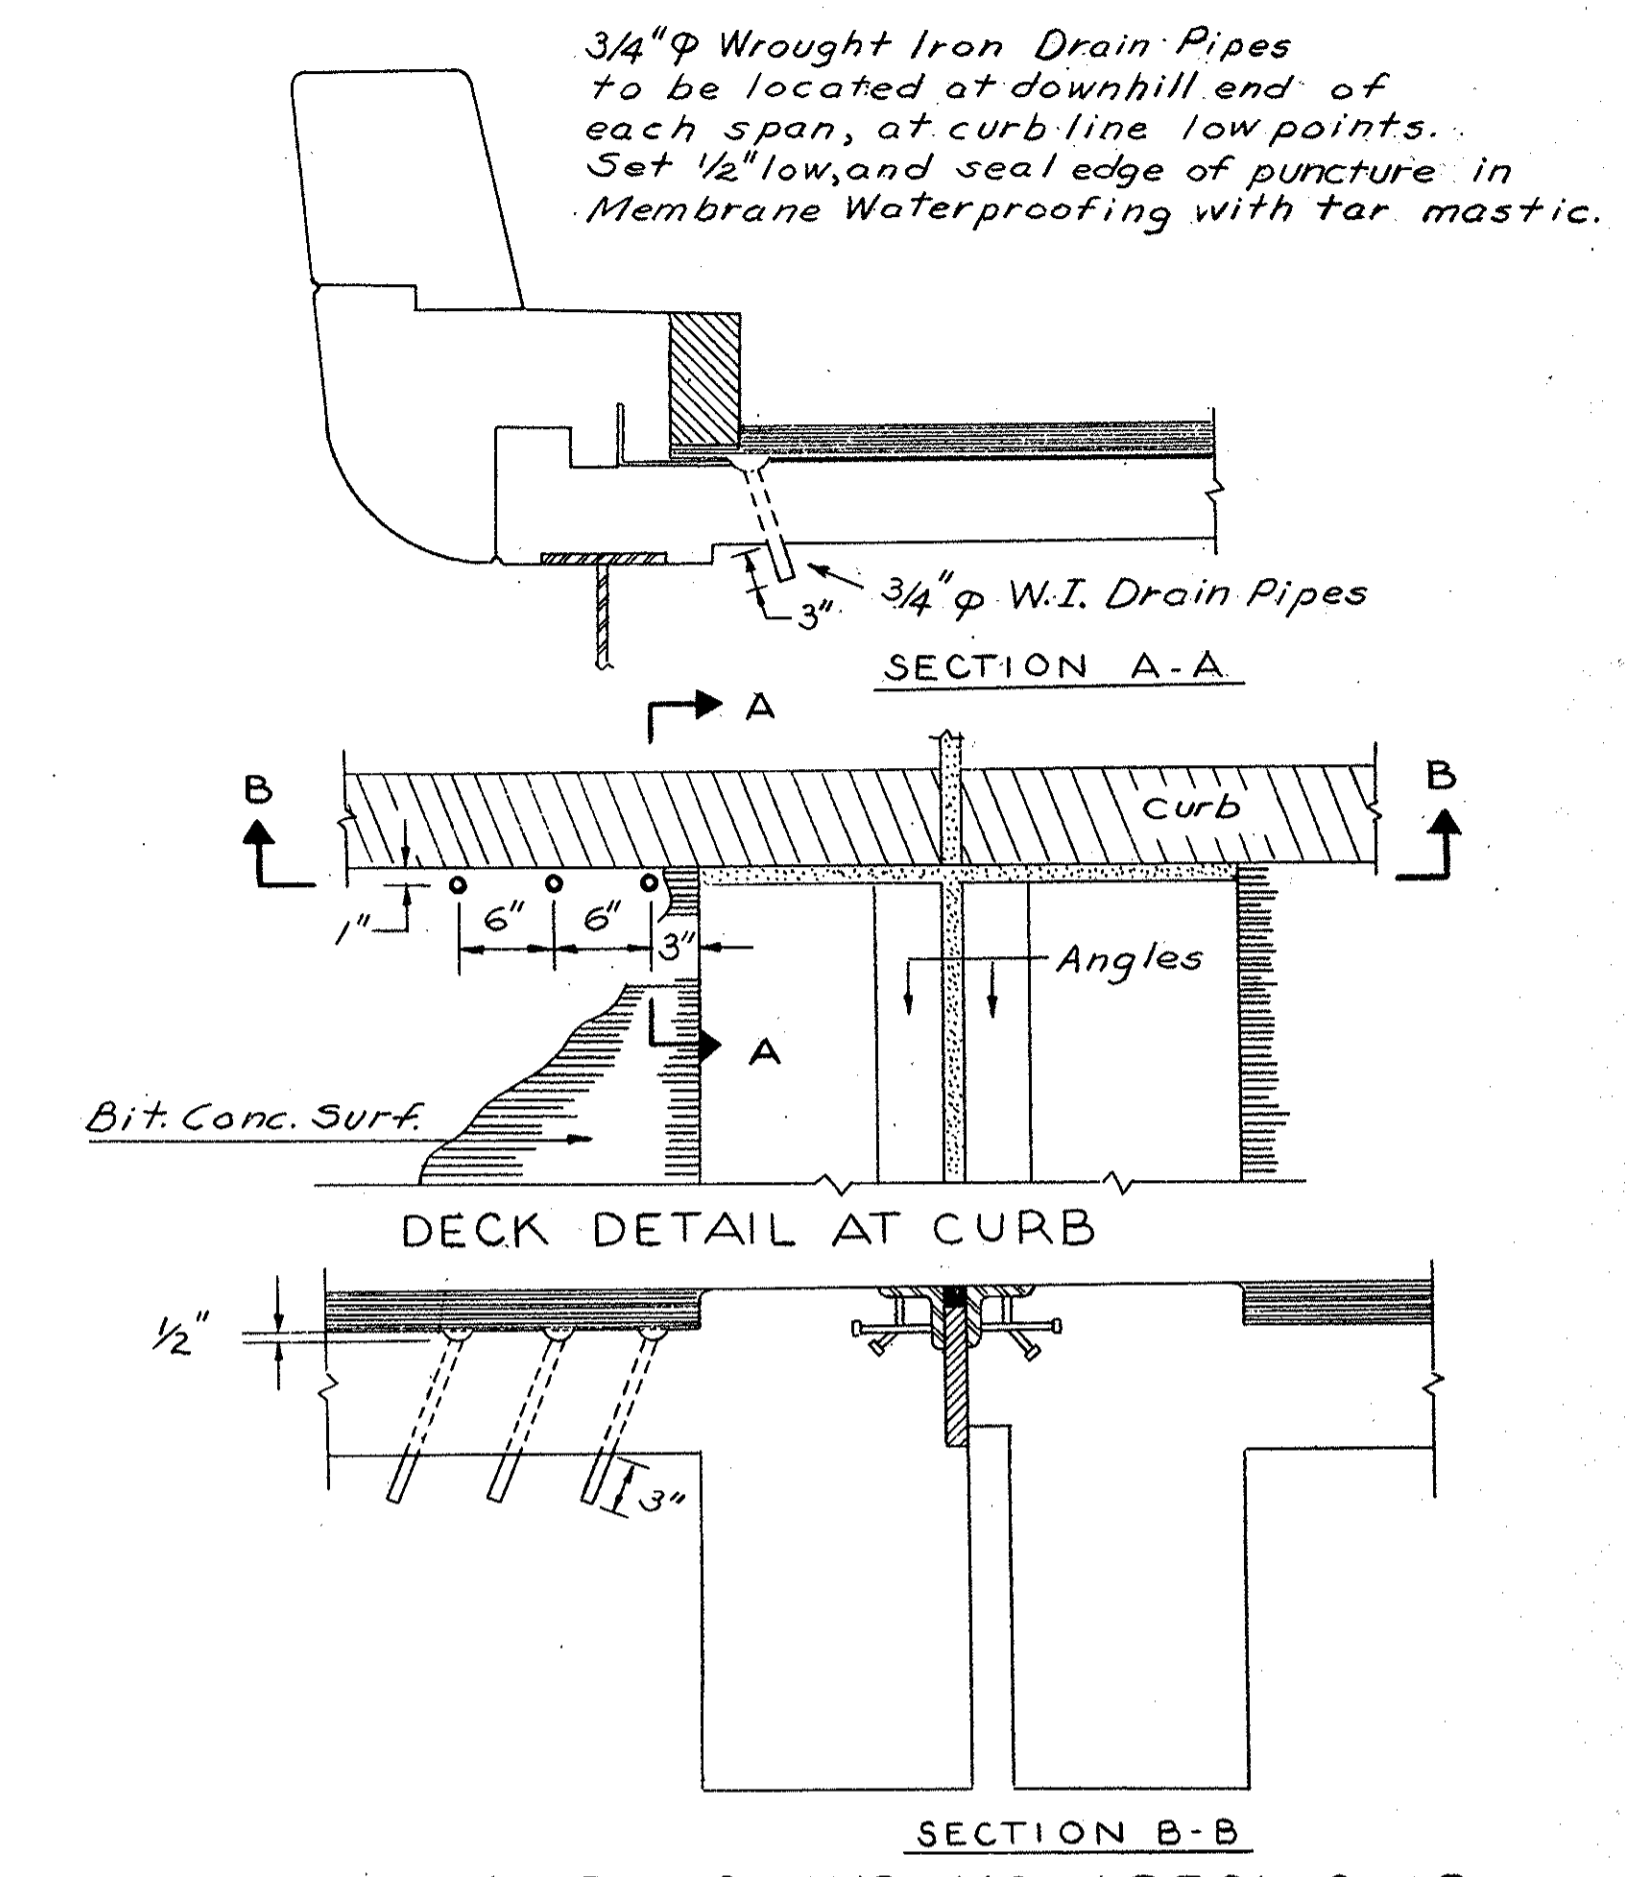

**BORING NOTES**

Location of Borings shown on Key Plan, Sheet 1 thus: ● BC-71. BC indicates a Bridge Core Boring. Borings taken for purpose of Design & show conditions at Boring Points only but do not necessarily show Nature of Material to be encountered during construction.

Figures in left hand column indicate Number of Blows required to drive 2" O.D. Sampler 12" using 140lb. weight falling 30".








Borings were made by Allstate Drilling Co., 227 Wampanoag Trail, Riverside, R.I. May 1965.

Boring Samples may be seen at the Research and Material Division, 99 Worcester Street, Wellesley Hills, at the intersection of Route 9 and Route 128 by appointment only.

Water levels shown on the Boring Logs were observed at the time of taking borings and do not necessarily show the true ground water level.

**BORING DATA**  
Scale: 1/16" = 1'-0"

APRIL 9, 1966	ISSUED FOR CONSTRUCTION
DATE	DESCRIPTION
USE ONLY PRINTS OF LATEST DATE	

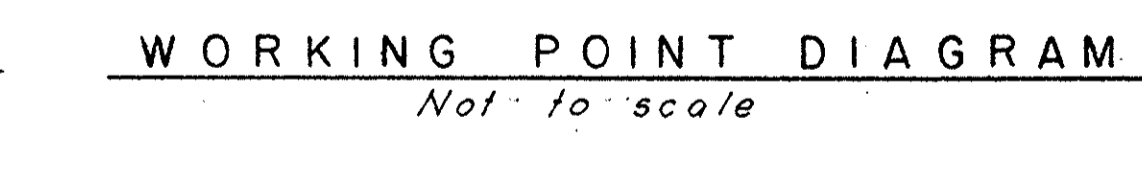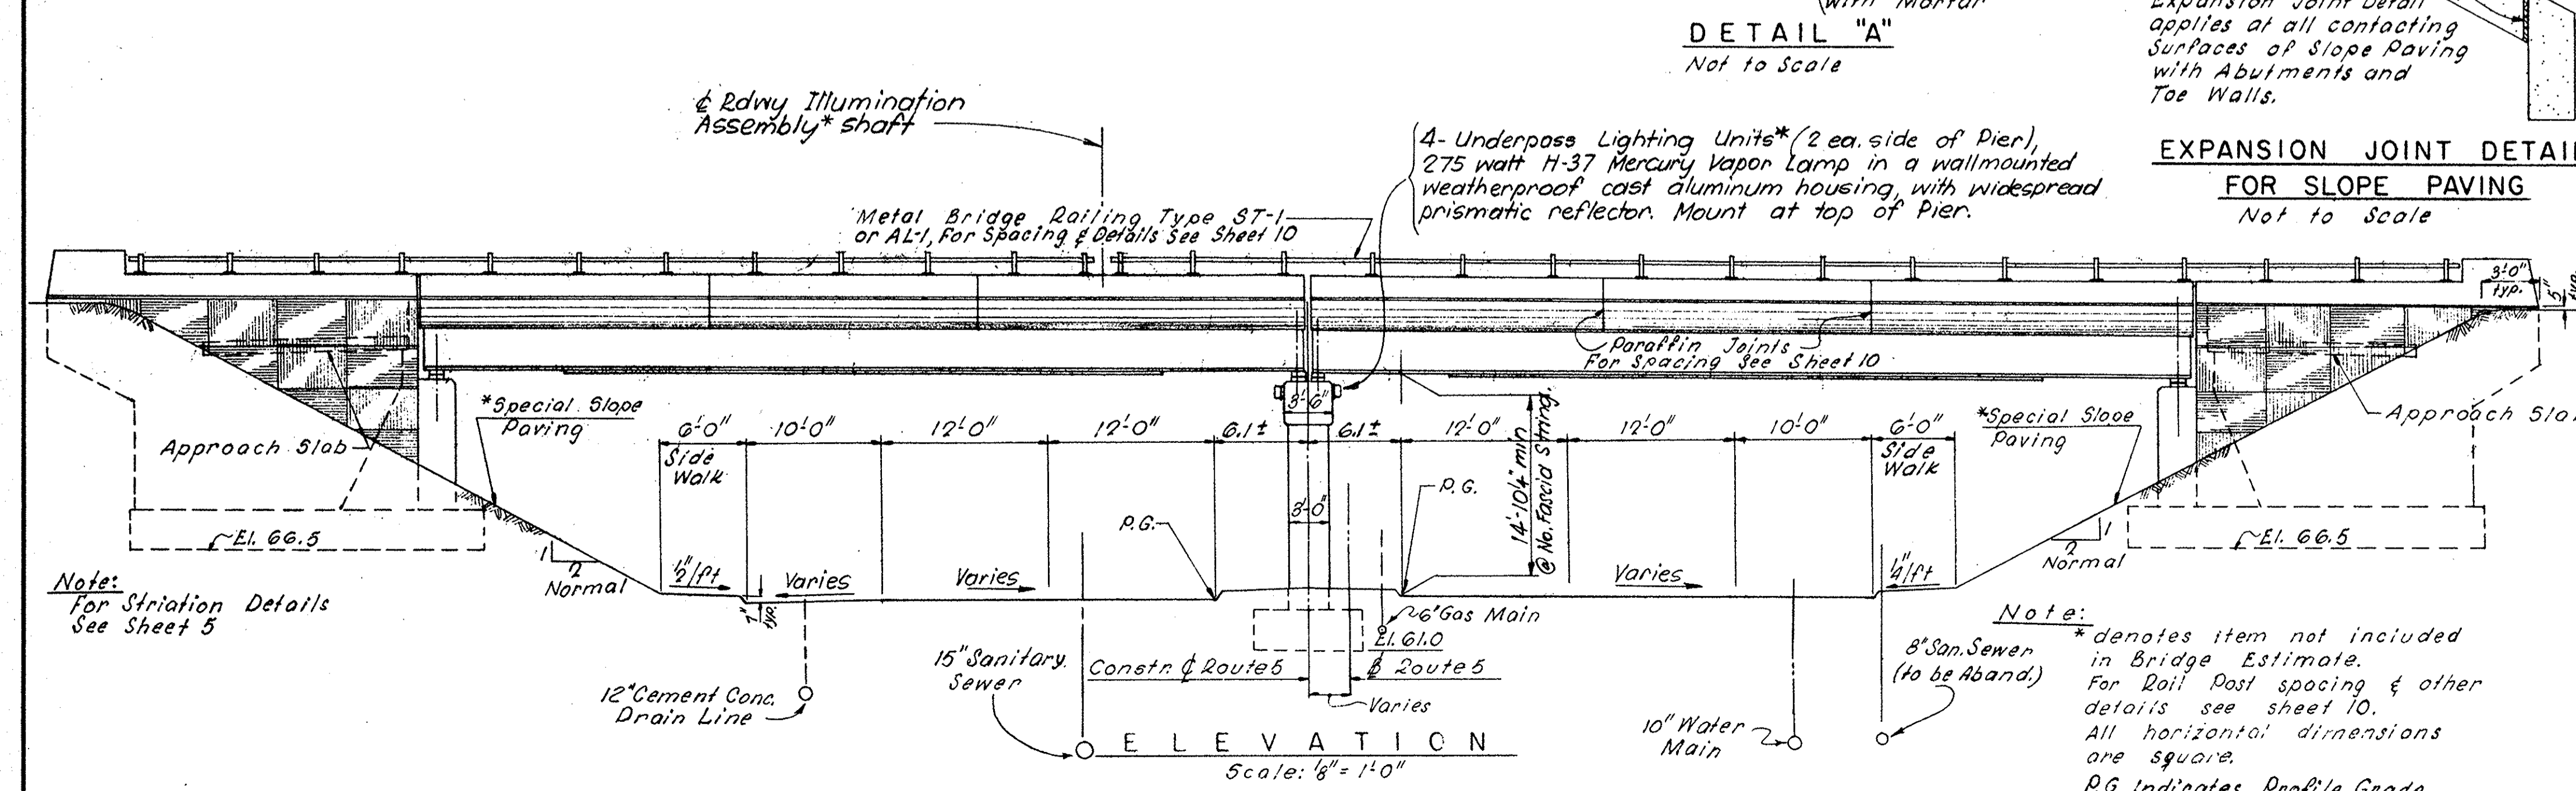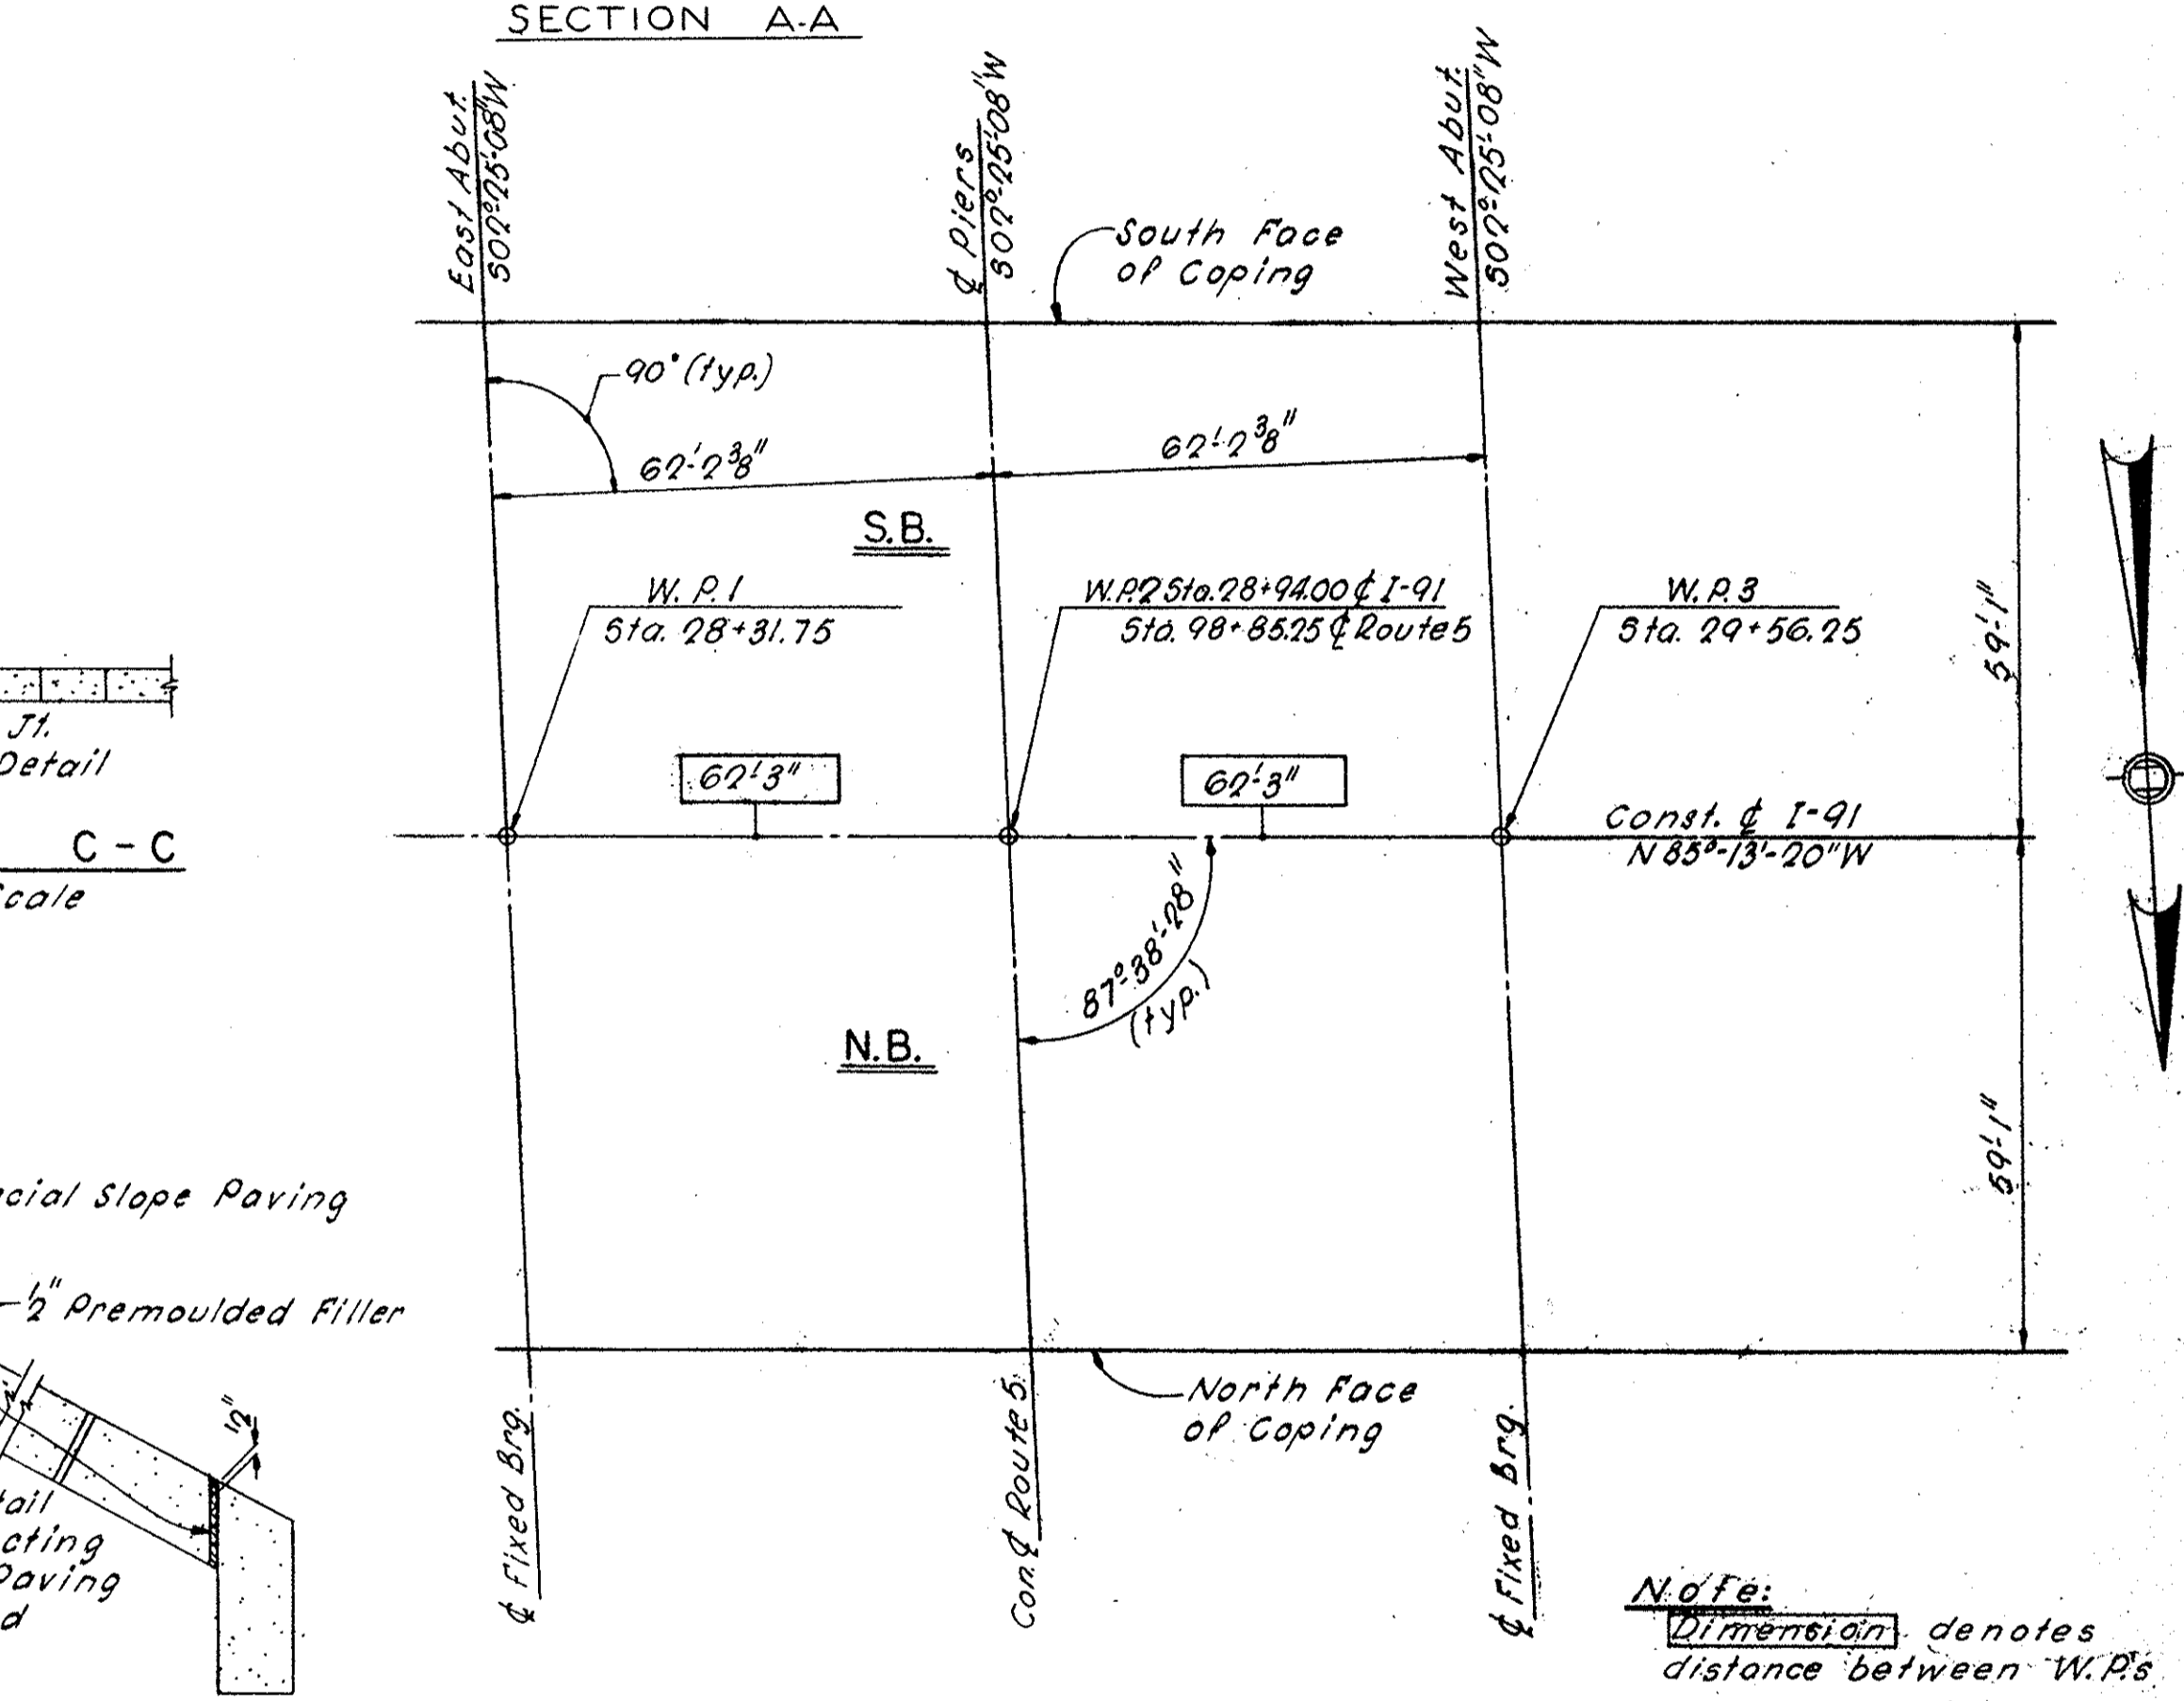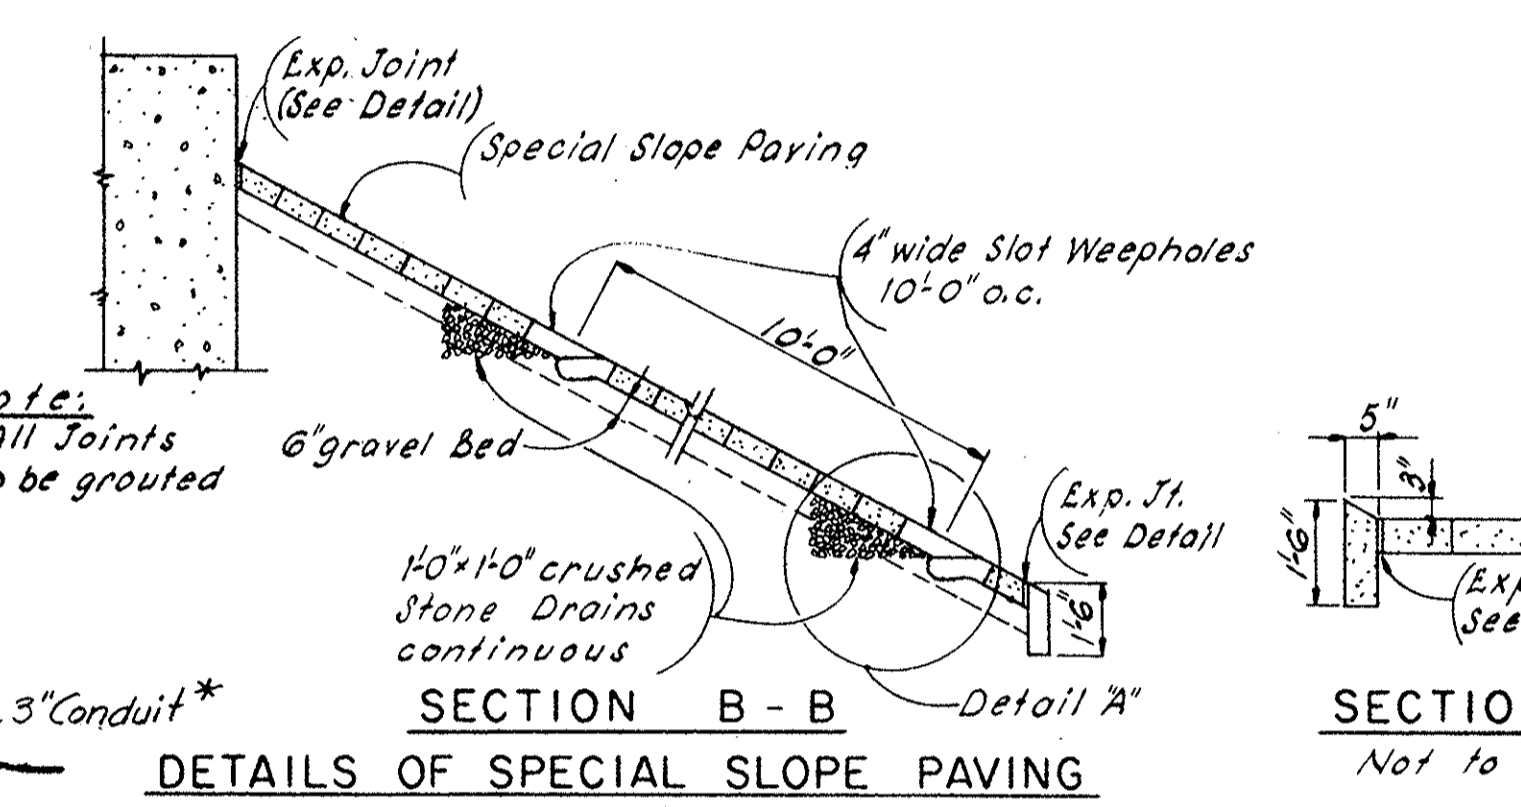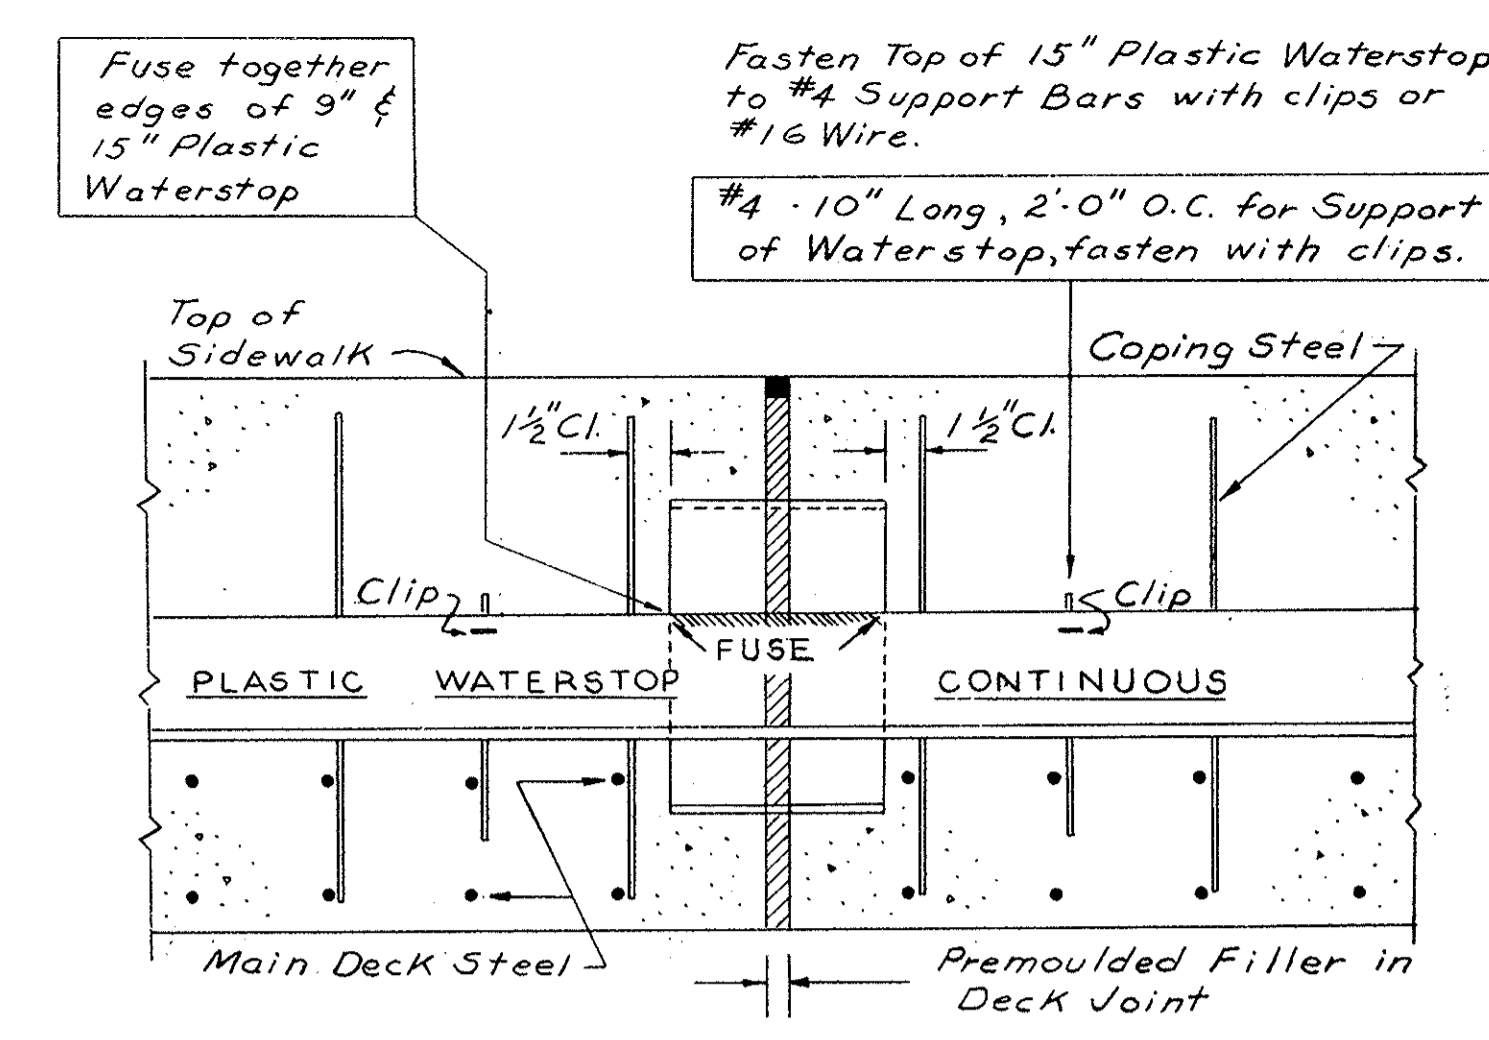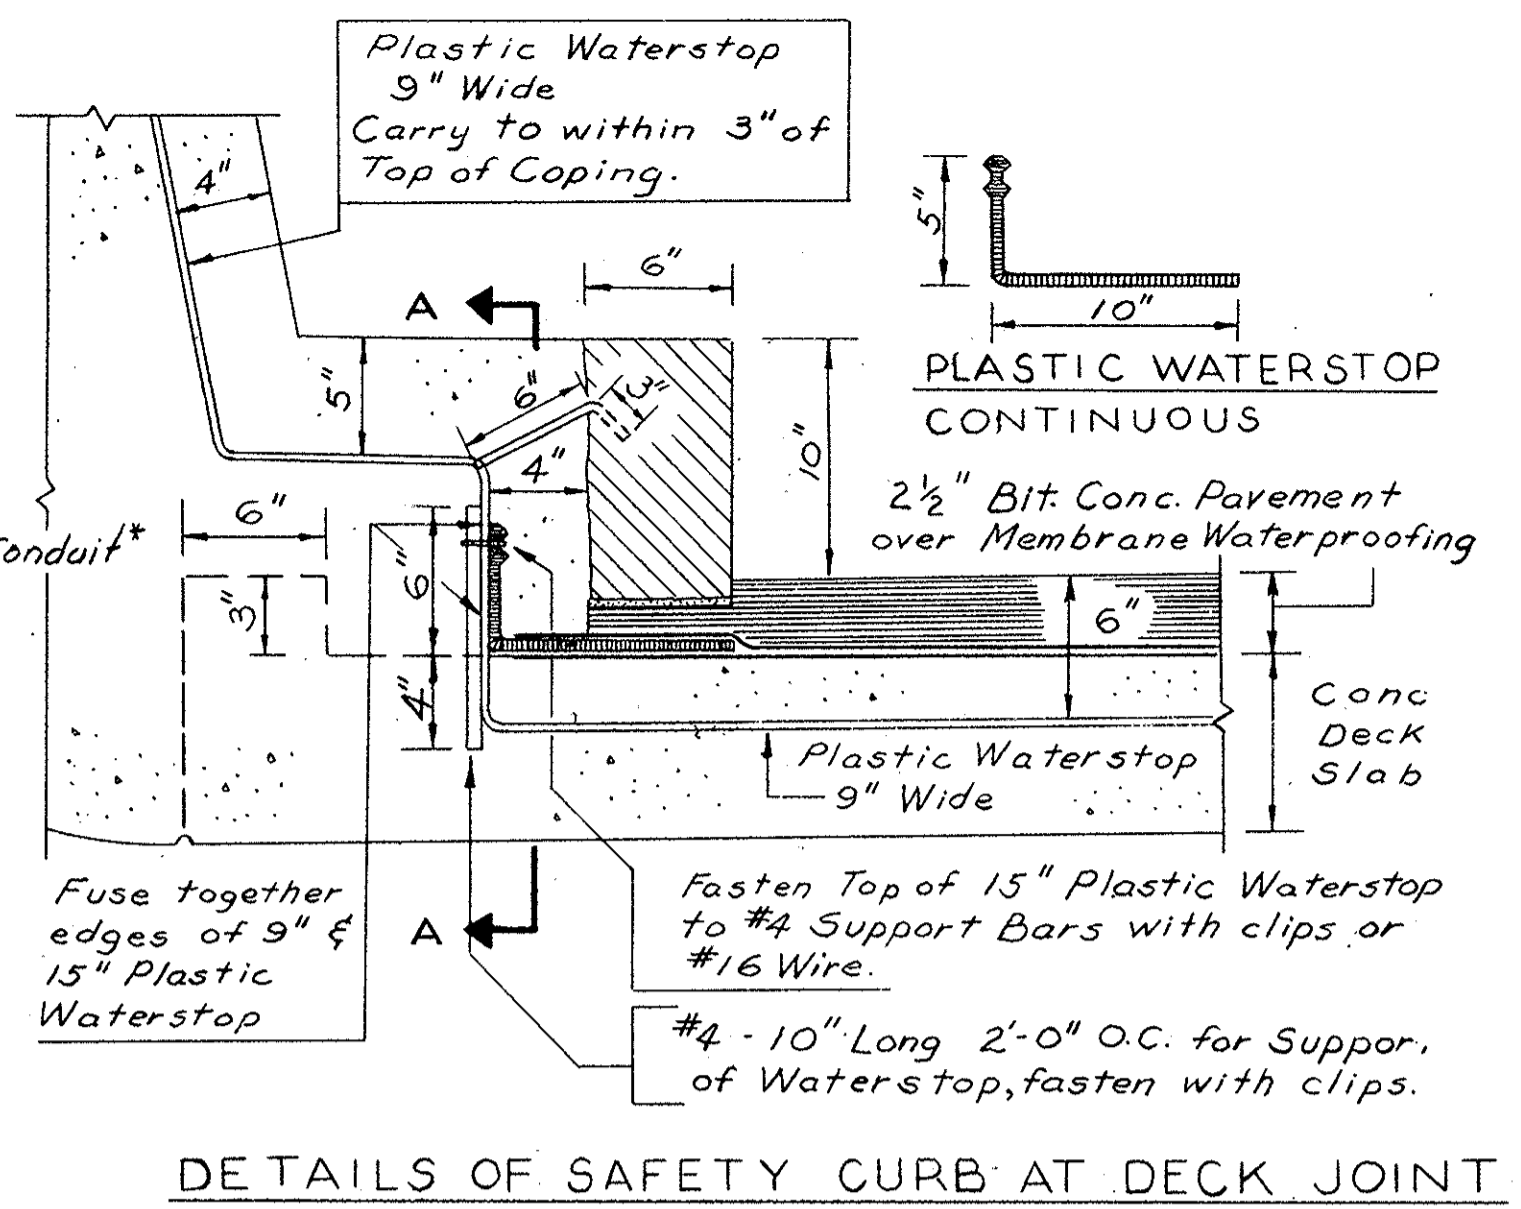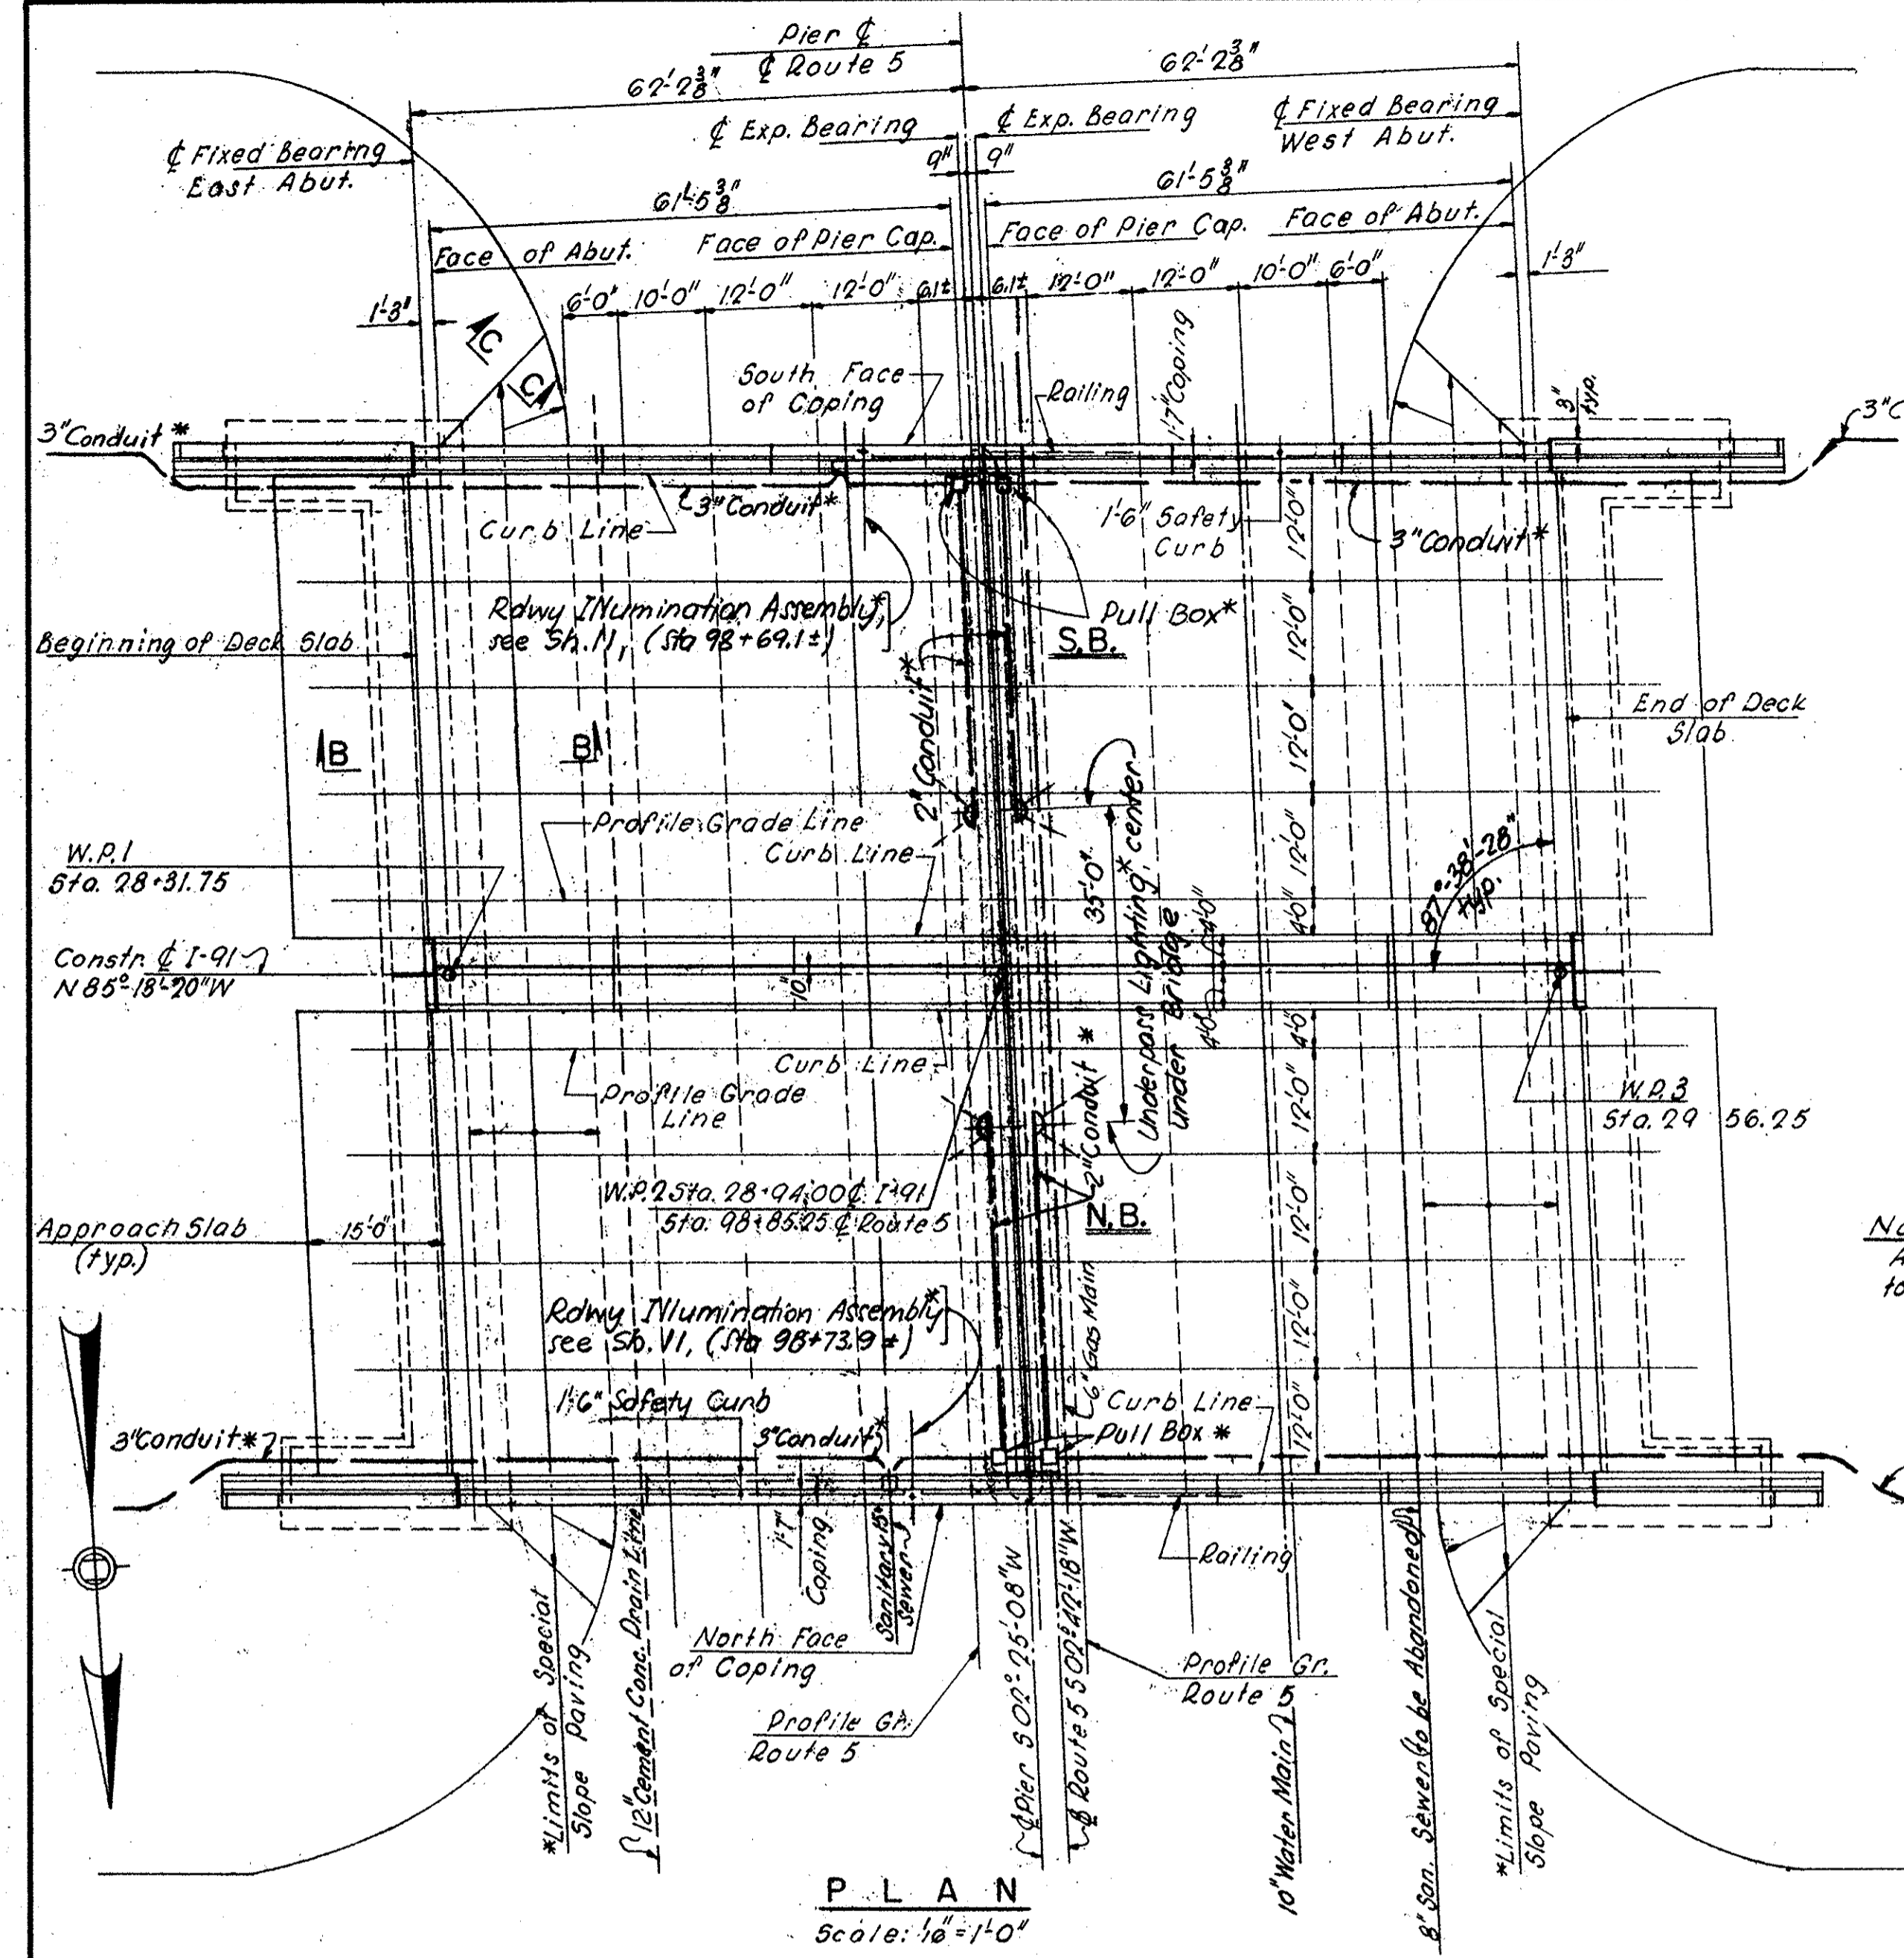

Note: Dimension denotes distance between W.P.s

Note: For Striation Details See Sheet 5

Note: \* denotes item not included in Bridge Estimate. For Rail Post spacing & other details see sheet 10. All horizontal dimensions are square. R.G. indicates Profile Grade








APRIL 9, 1966	ISSUED FOR CONSTRUCTION
DATE	DESCRIPTION
	USE ONLY PRINTS OF LATEST DATE



WINGWALL ELEVATIONS

Wingwall	El. "A"	El. "B"	El. "C"
North East	85.90	86.03	66.50
South East	85.92	86.06	66.50
North West	85.26	85.14	66.50
South West	85.28	85.16	66.50



Note: Date & Seal to be located at the inside faces of S.W. & N.E. Wingwalls. Fill shall be placed and thoroughly compacted to the Grade of the Bottom of the Wings; or where no Fill is Required Below the Wings, the Concrete shall be Placed Upon Undisturbed Soil.

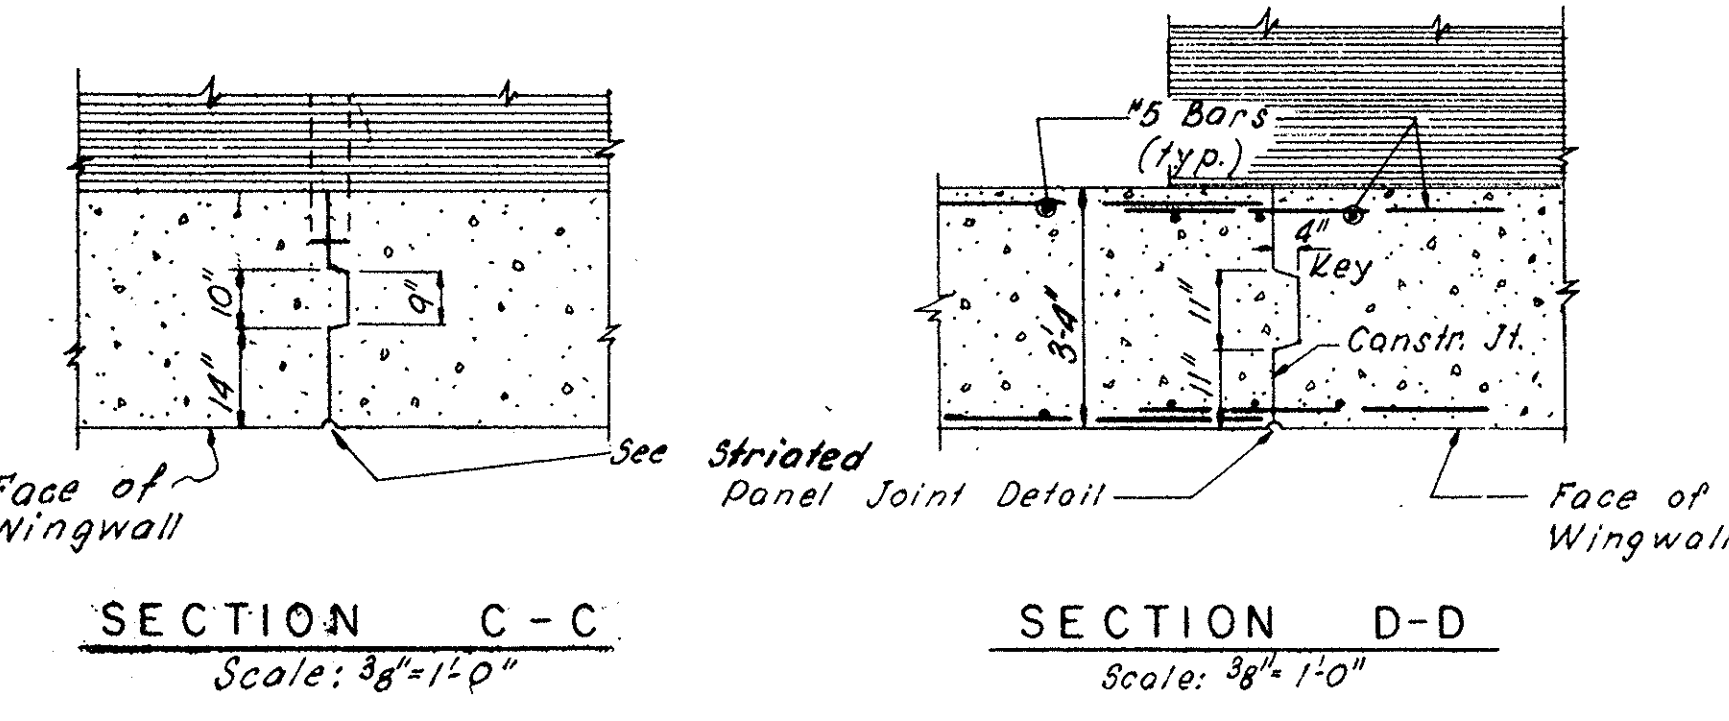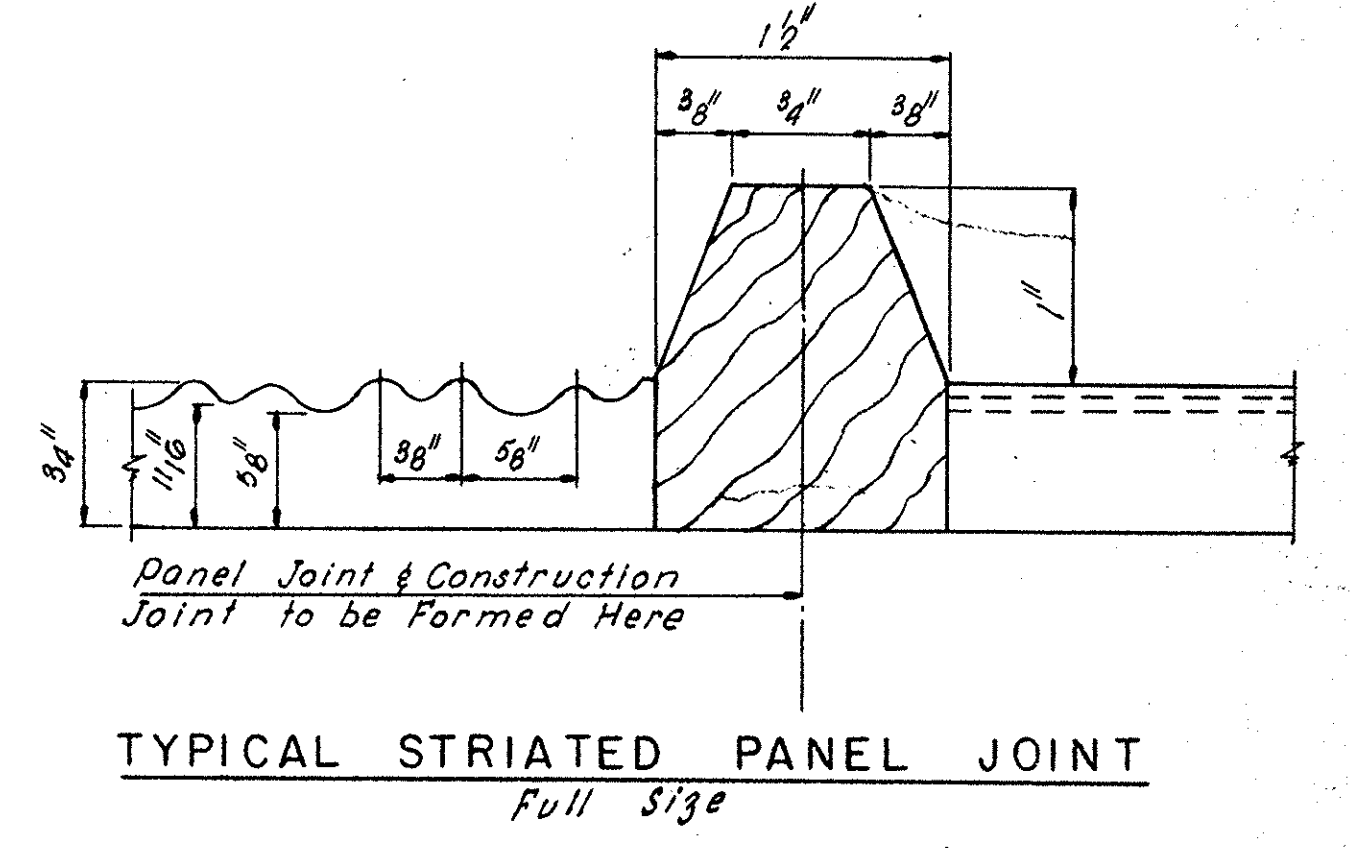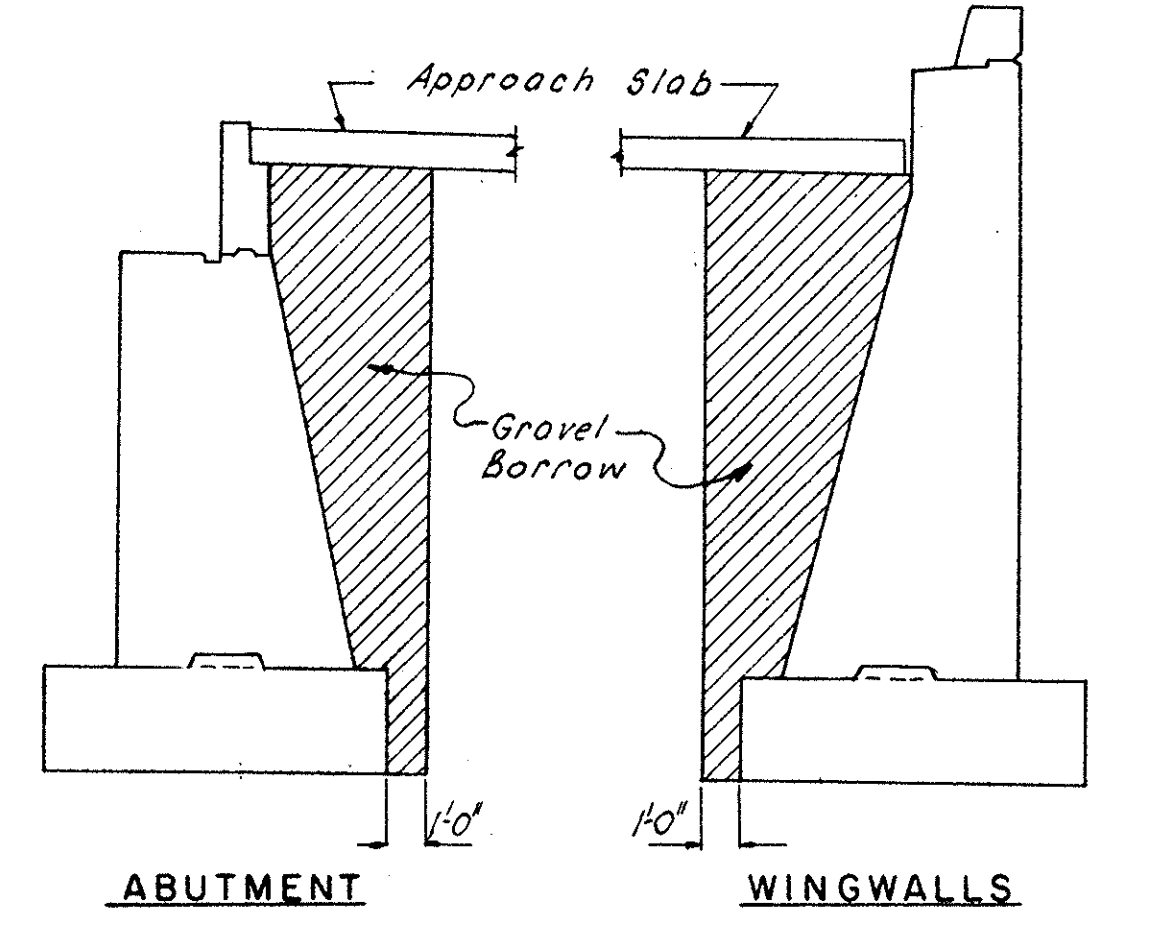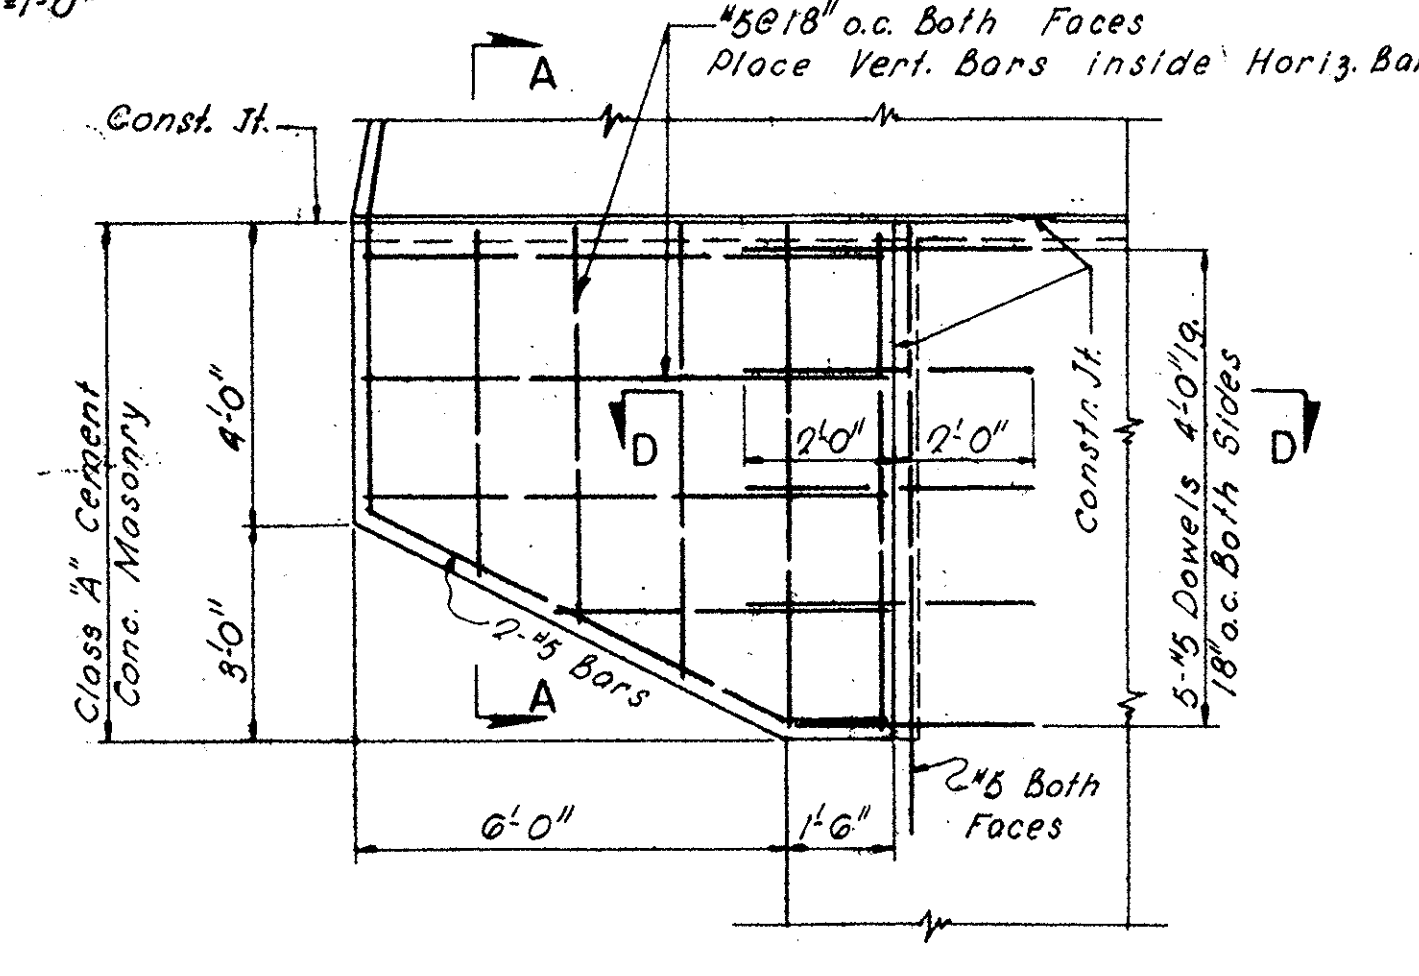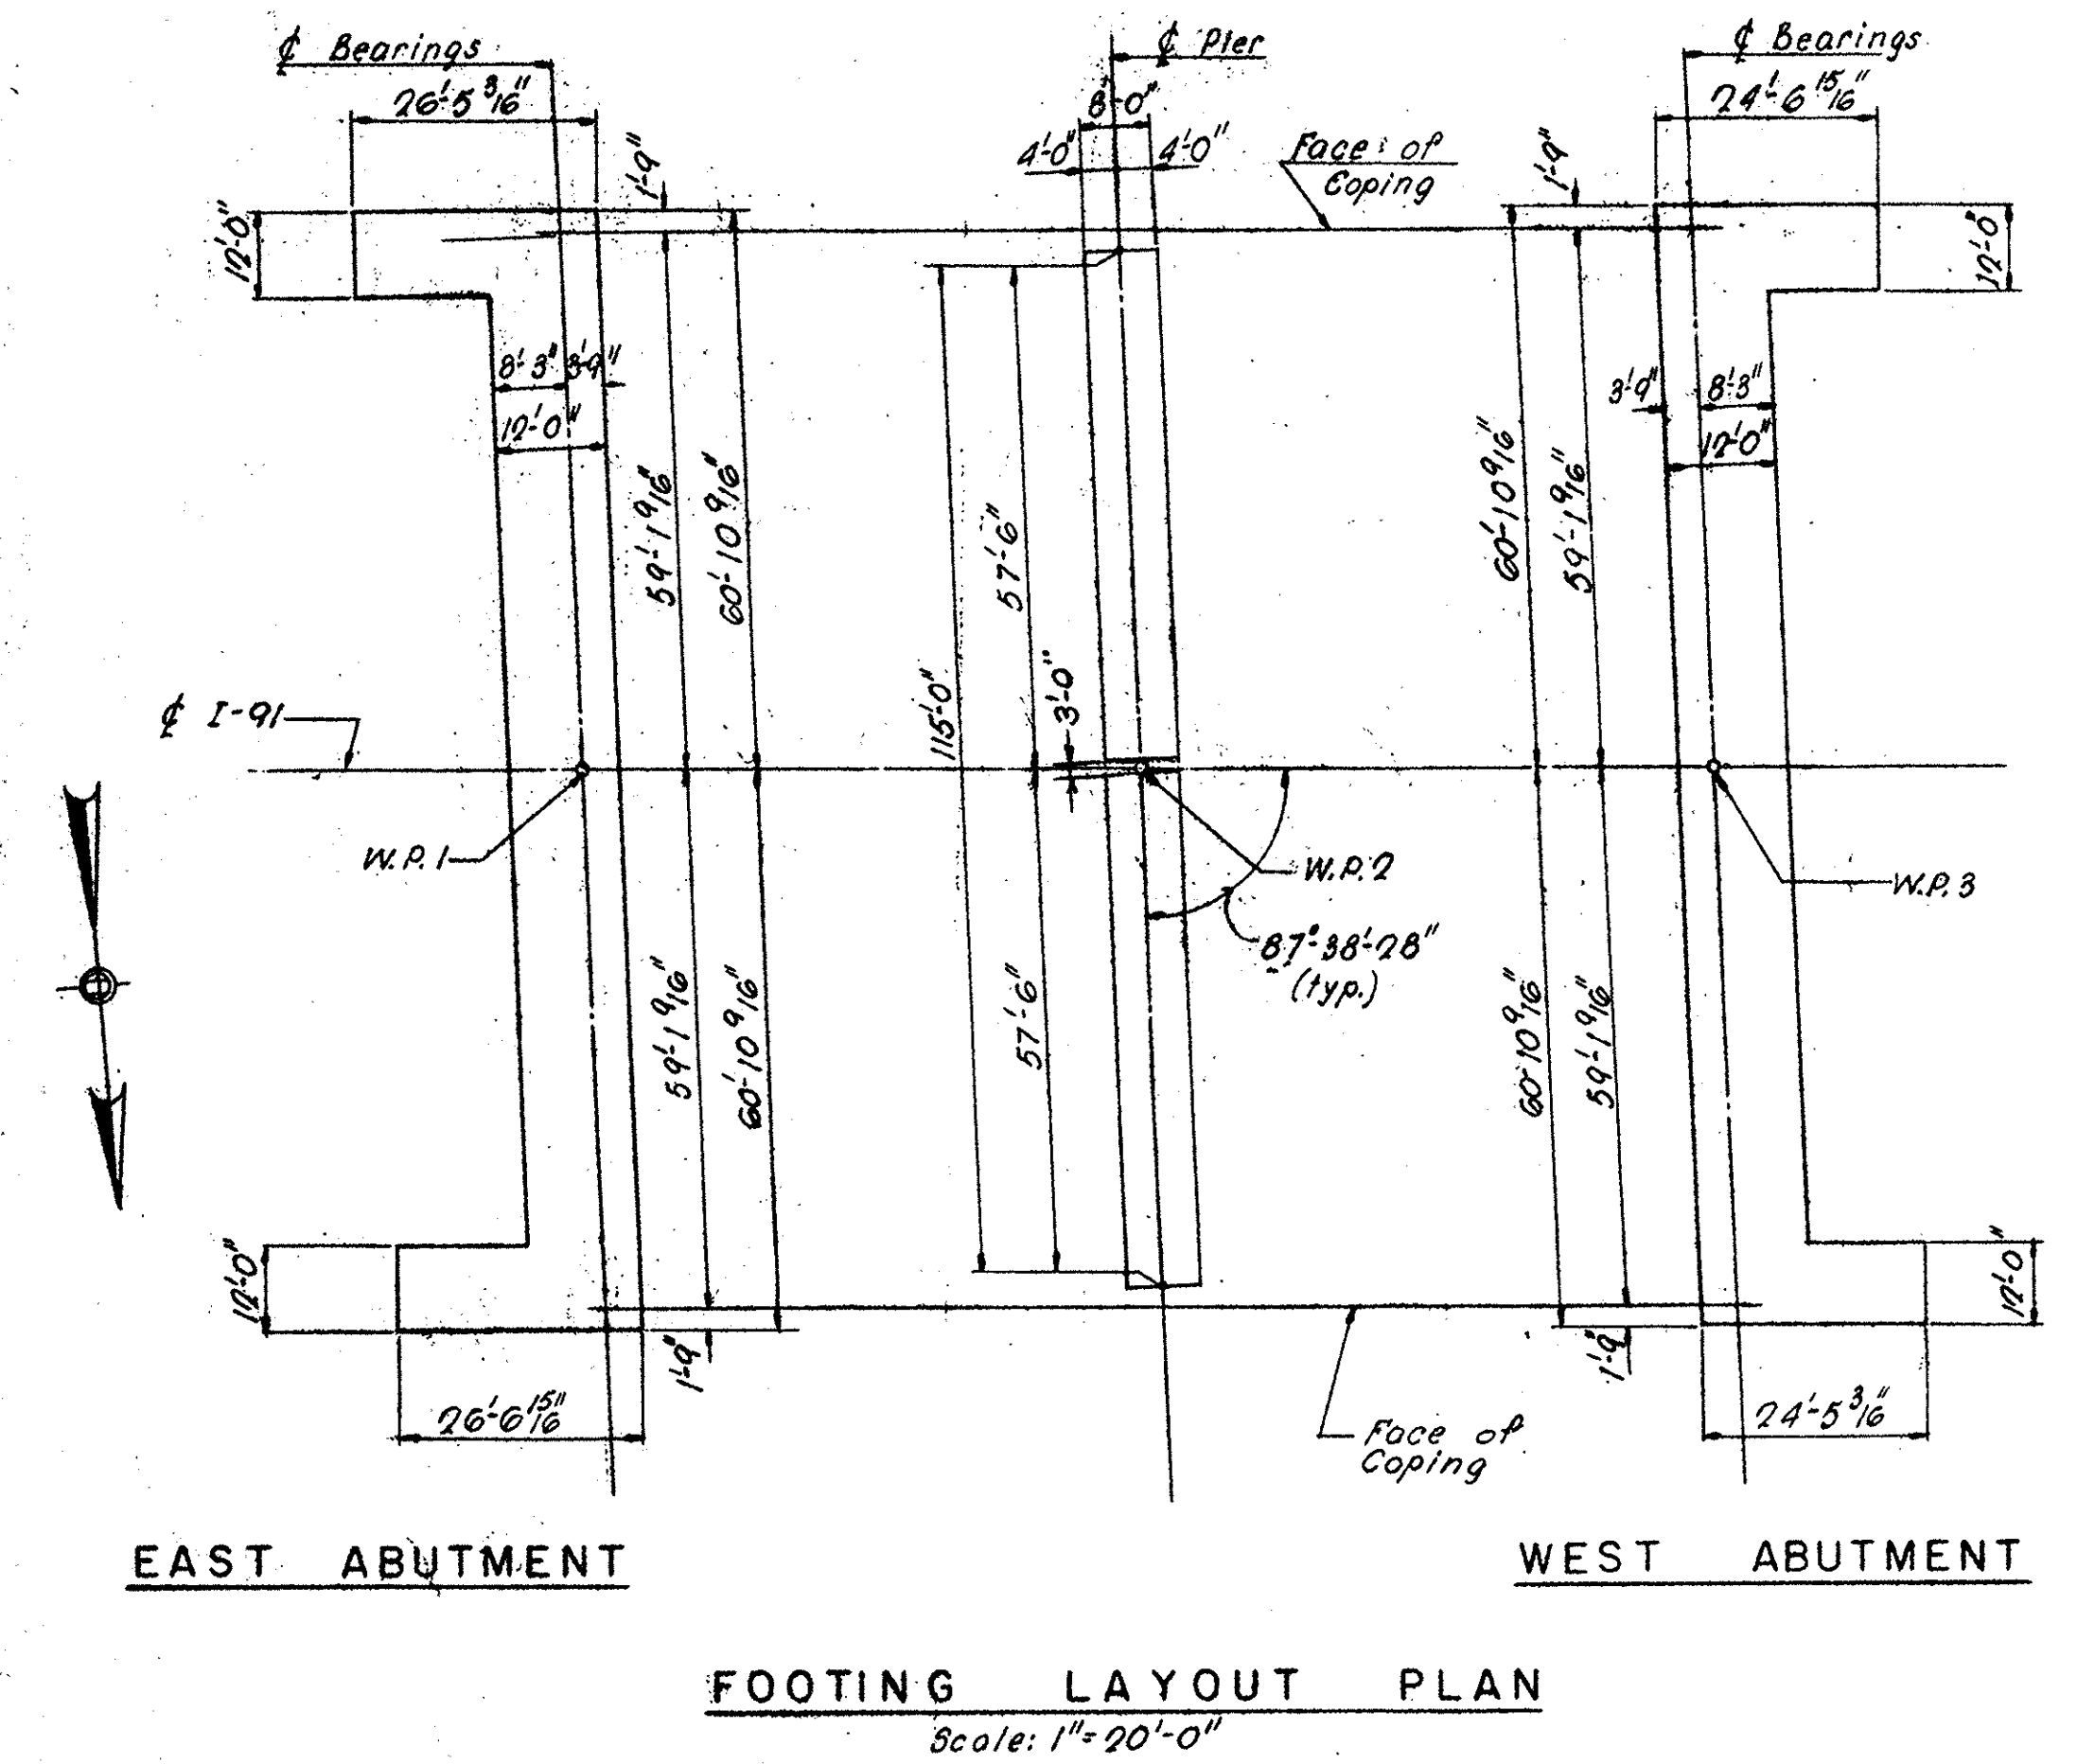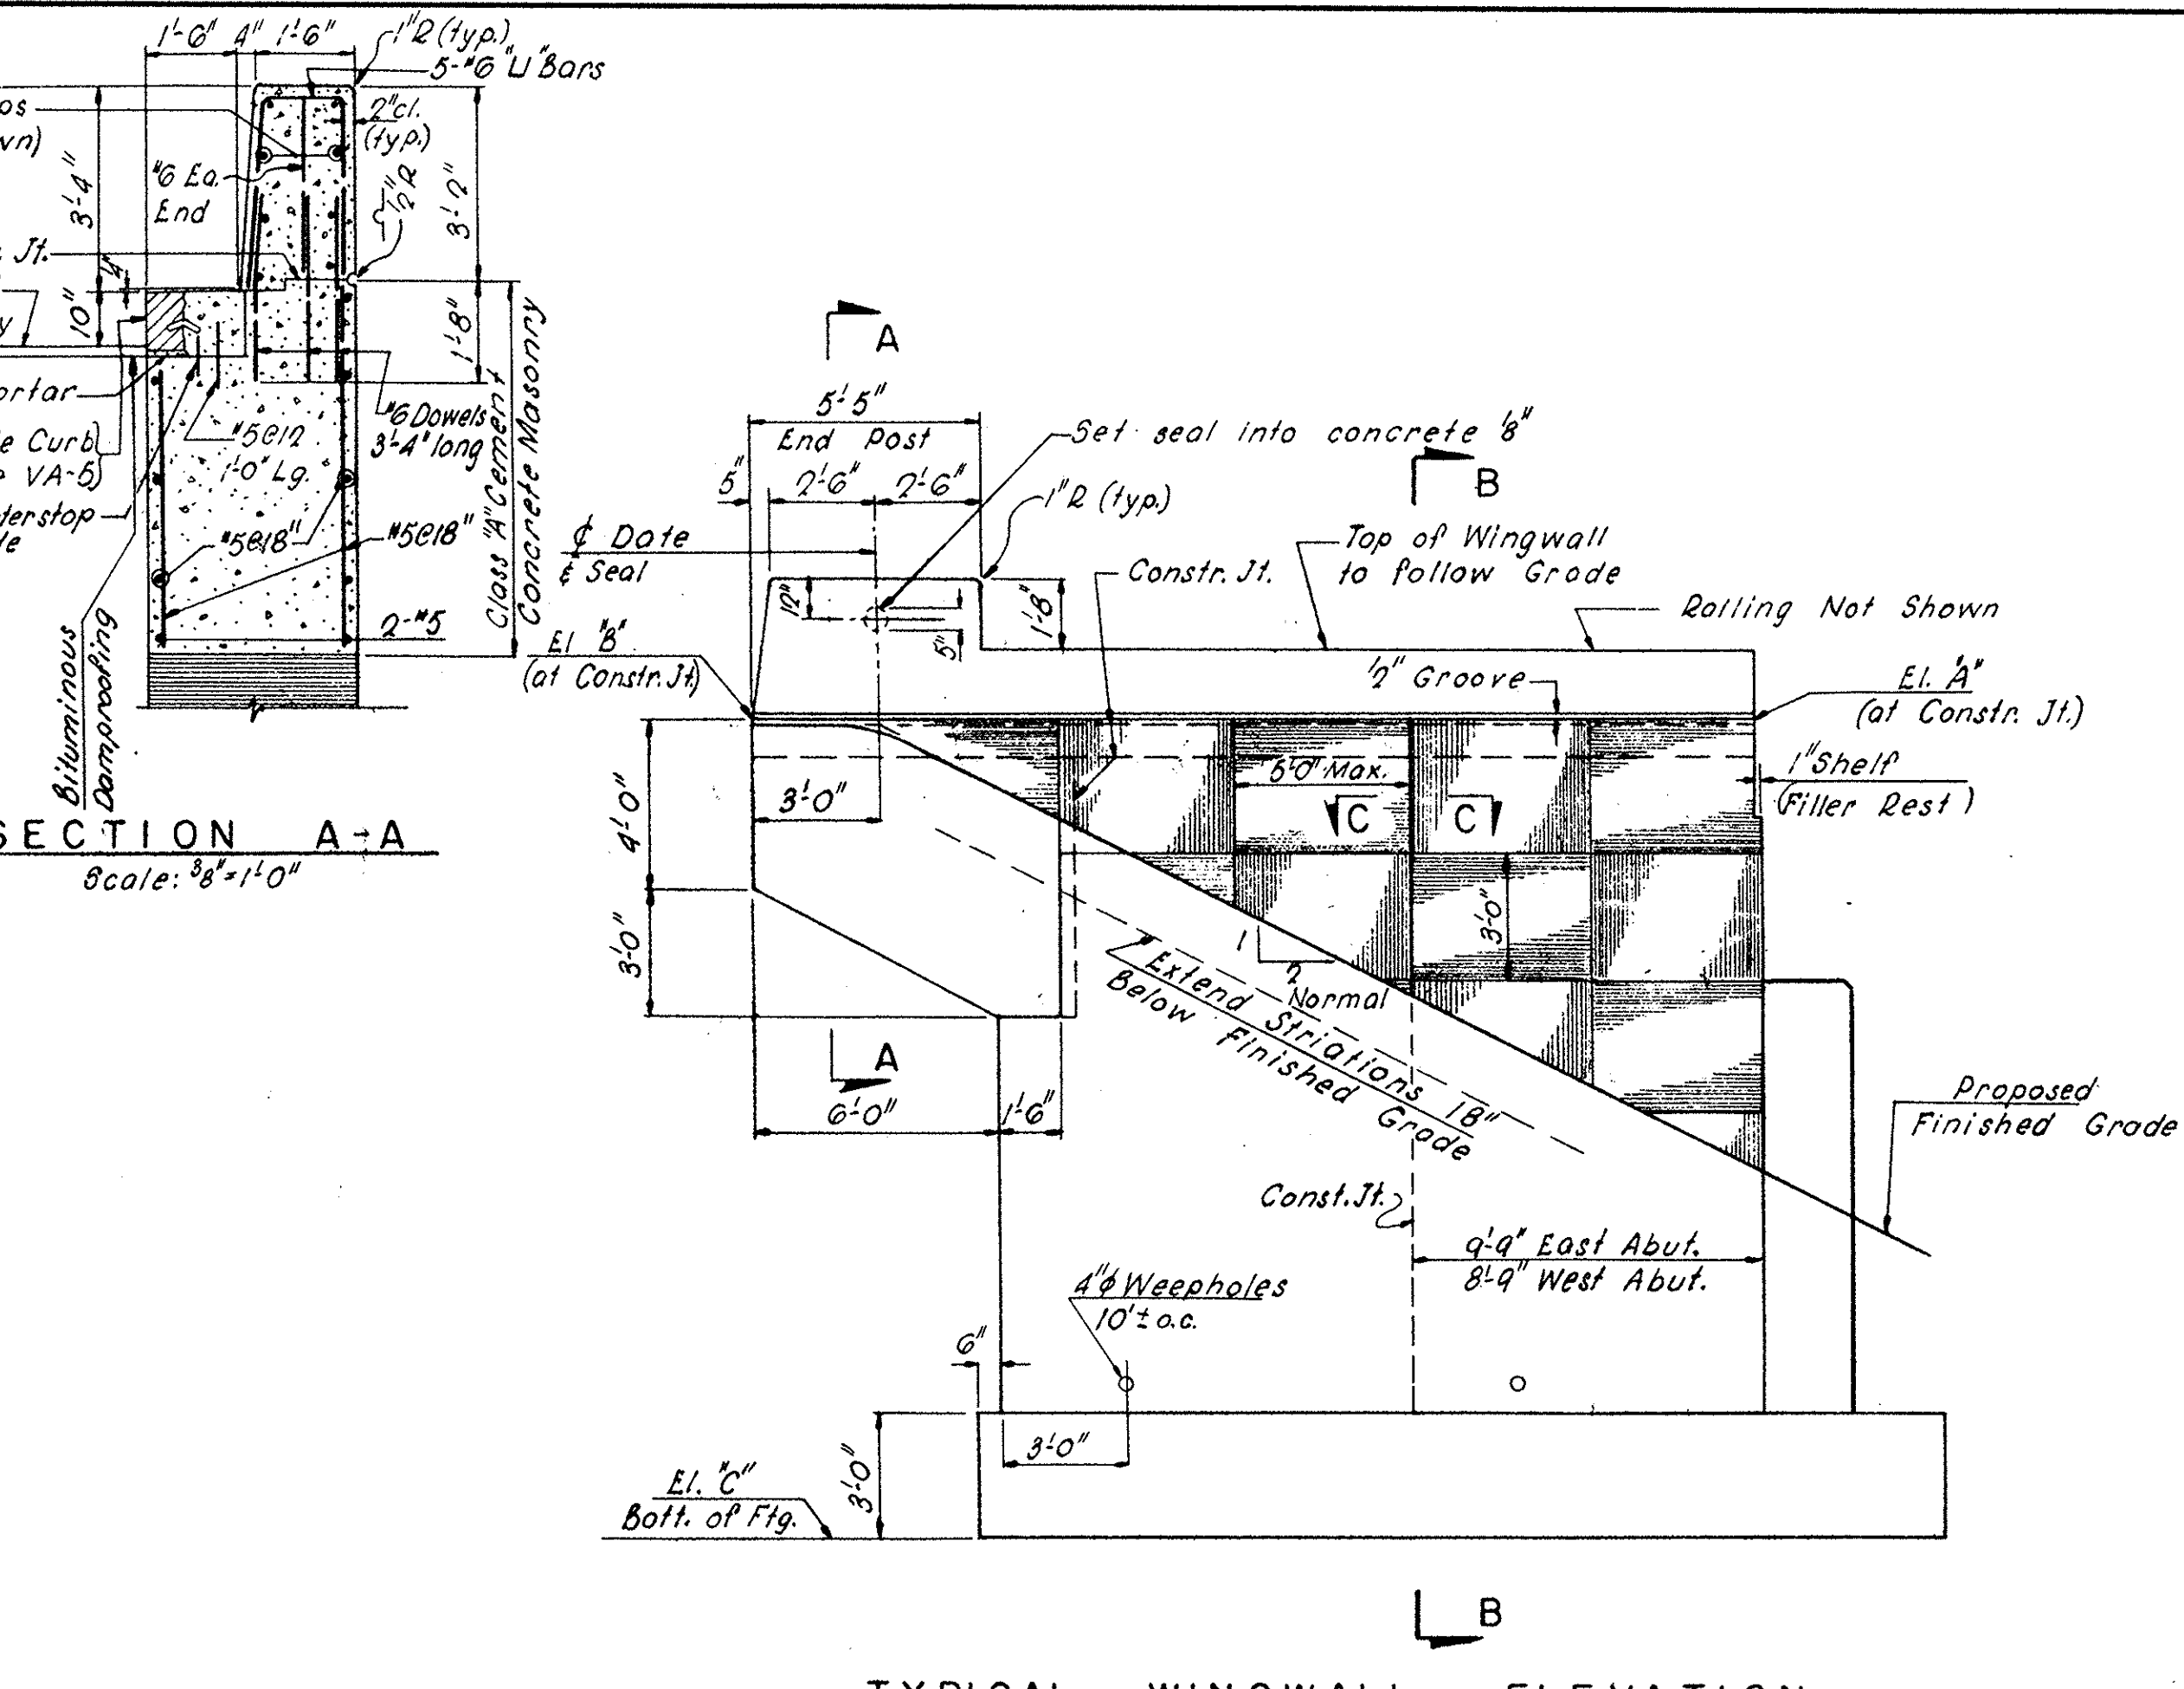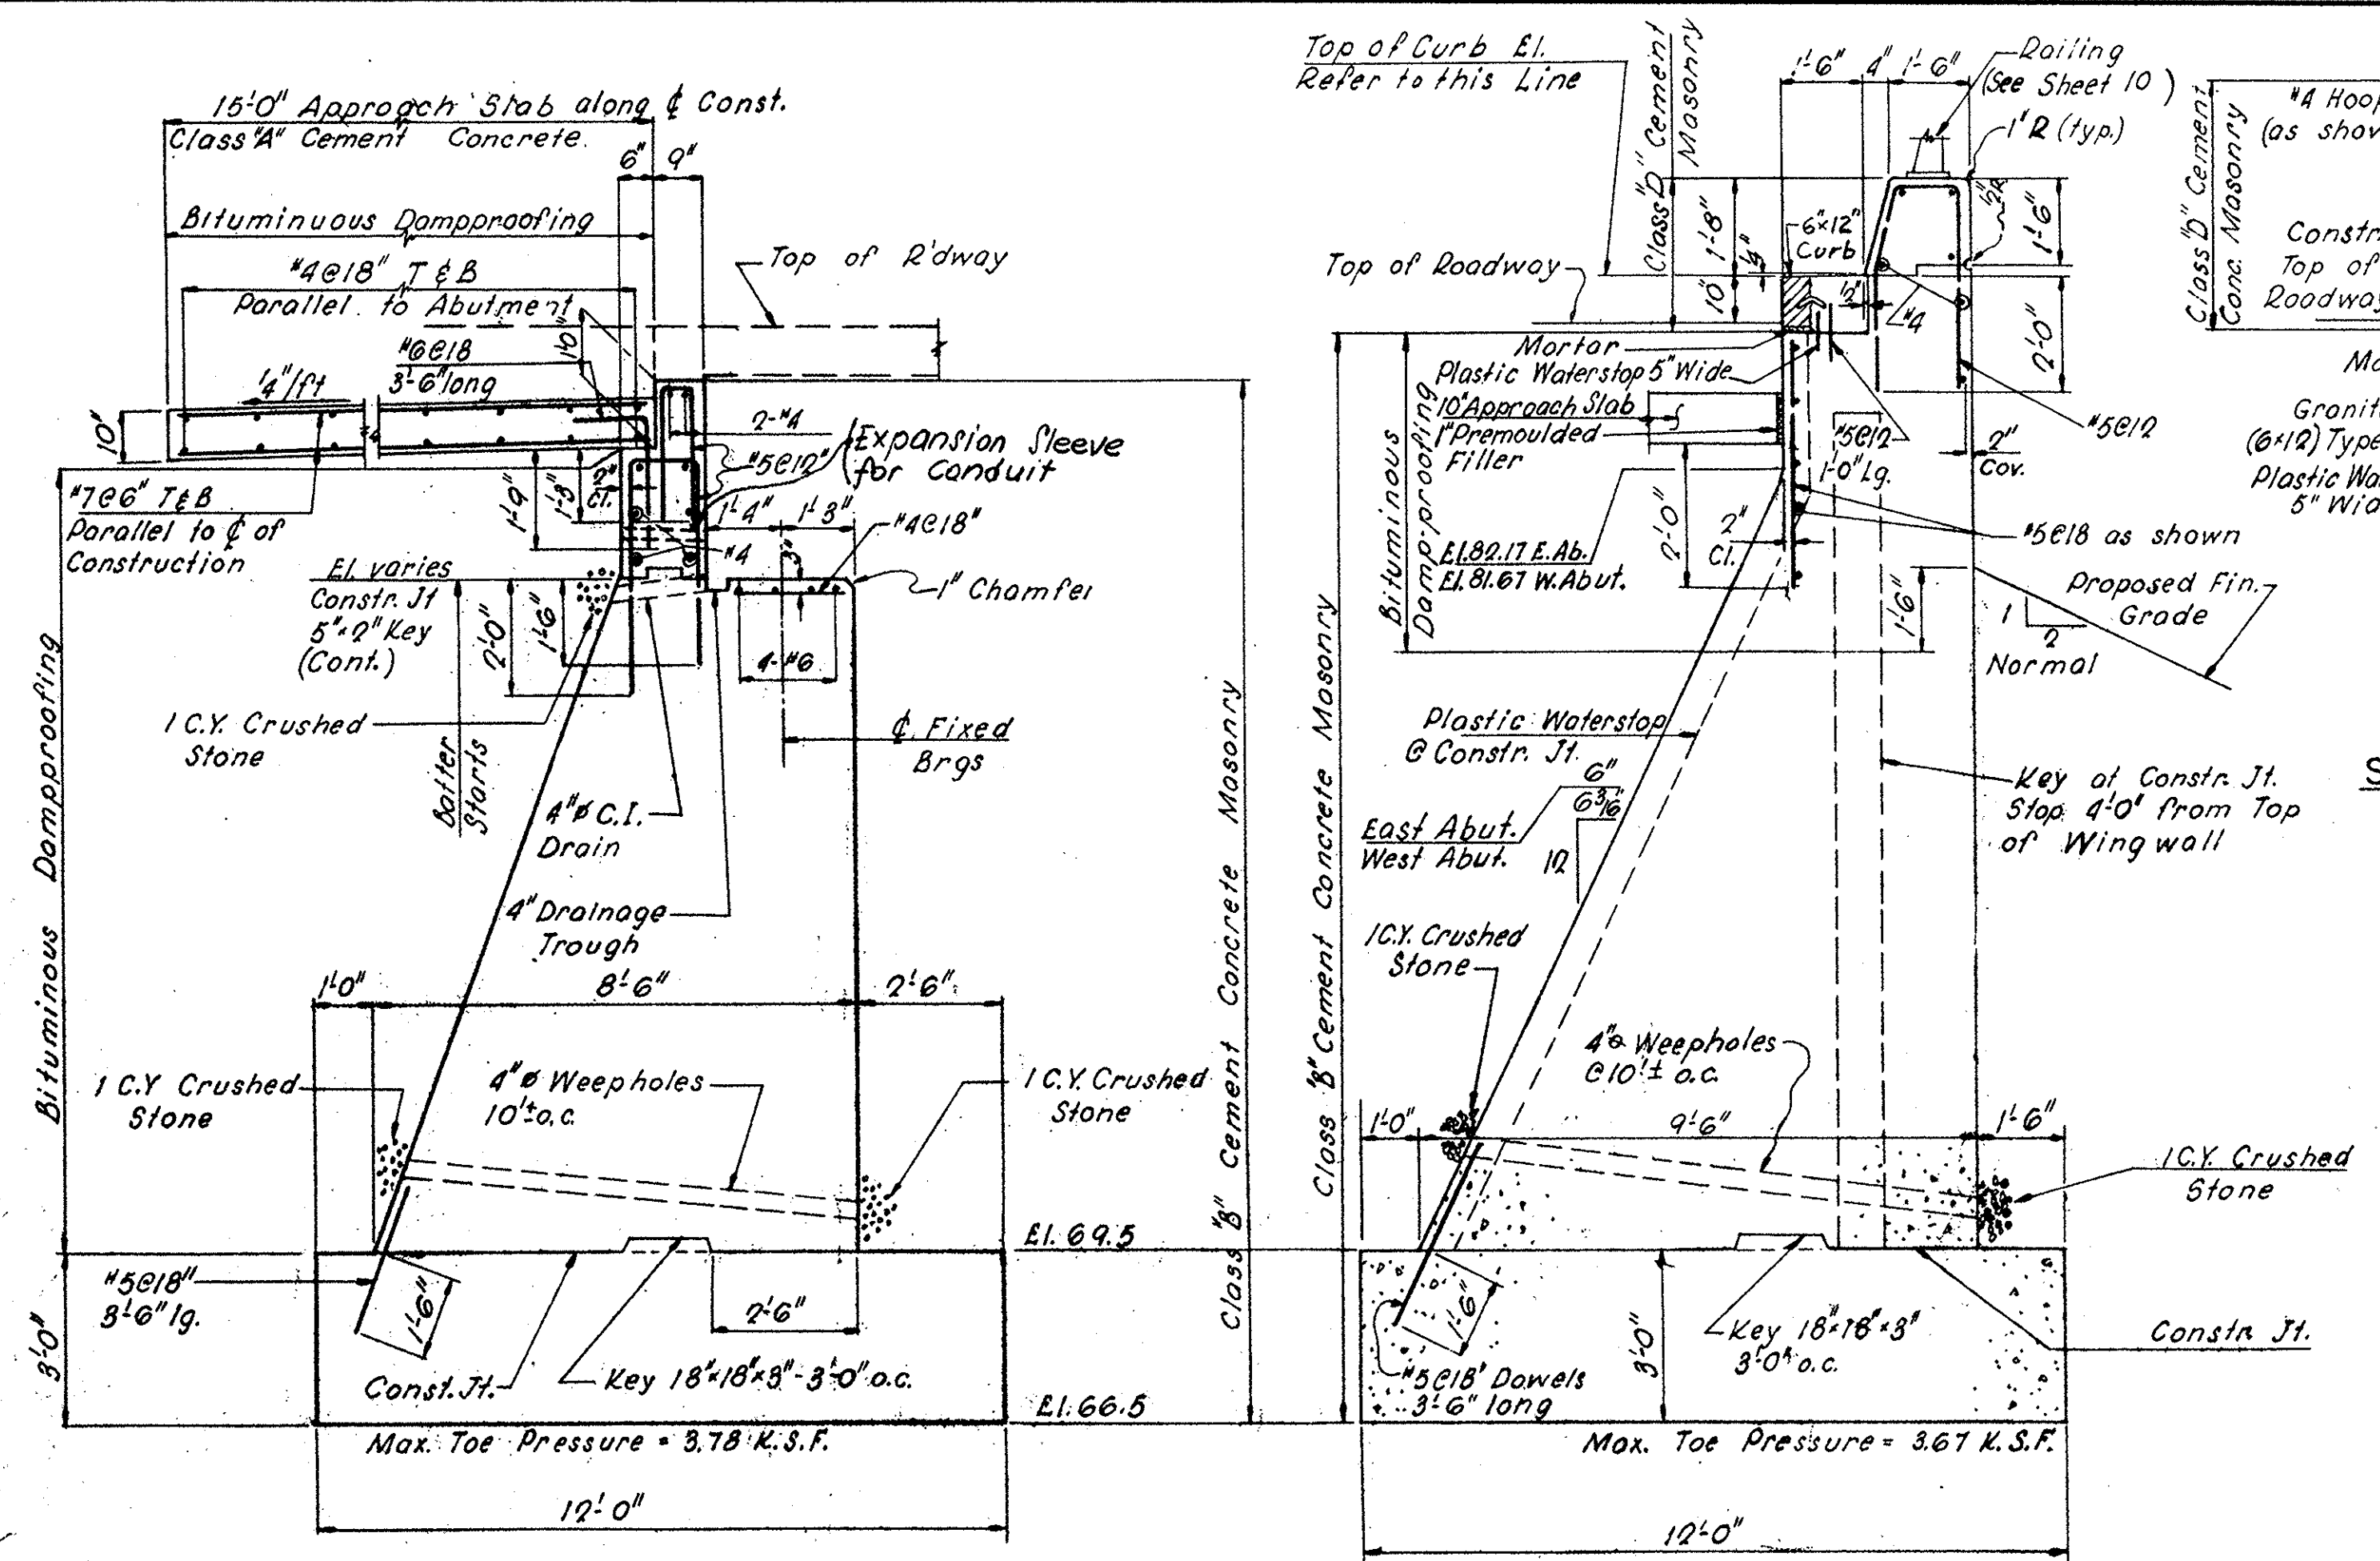







APRIL 9, 1966	ISSUED FOR CONSTRUCTION
DATE	DESCRIPTION
	USE ONLY PRINTS OF LATEST DATE





PUB. NO.	STATE	FED. AID PROJ. NO.	FISCAL YEAR	SHEET NO.	TOTAL SHEETS
1	MASS.	1-91-1(54)9	19	86	188

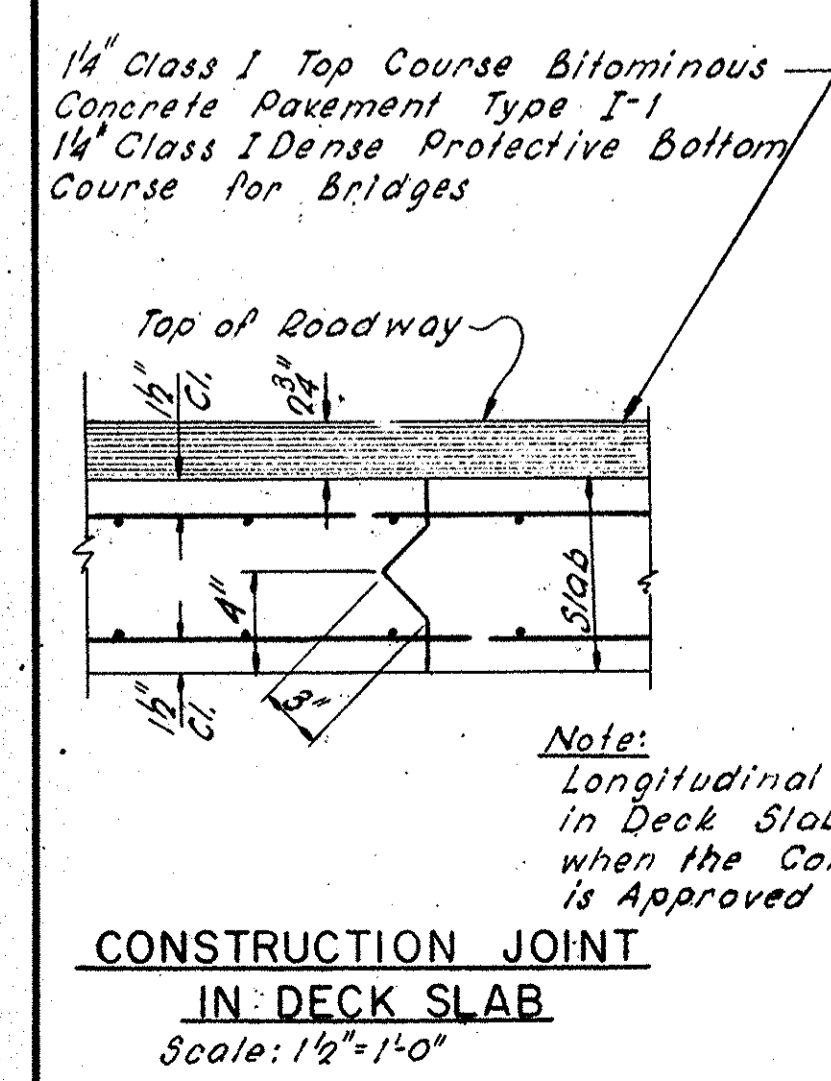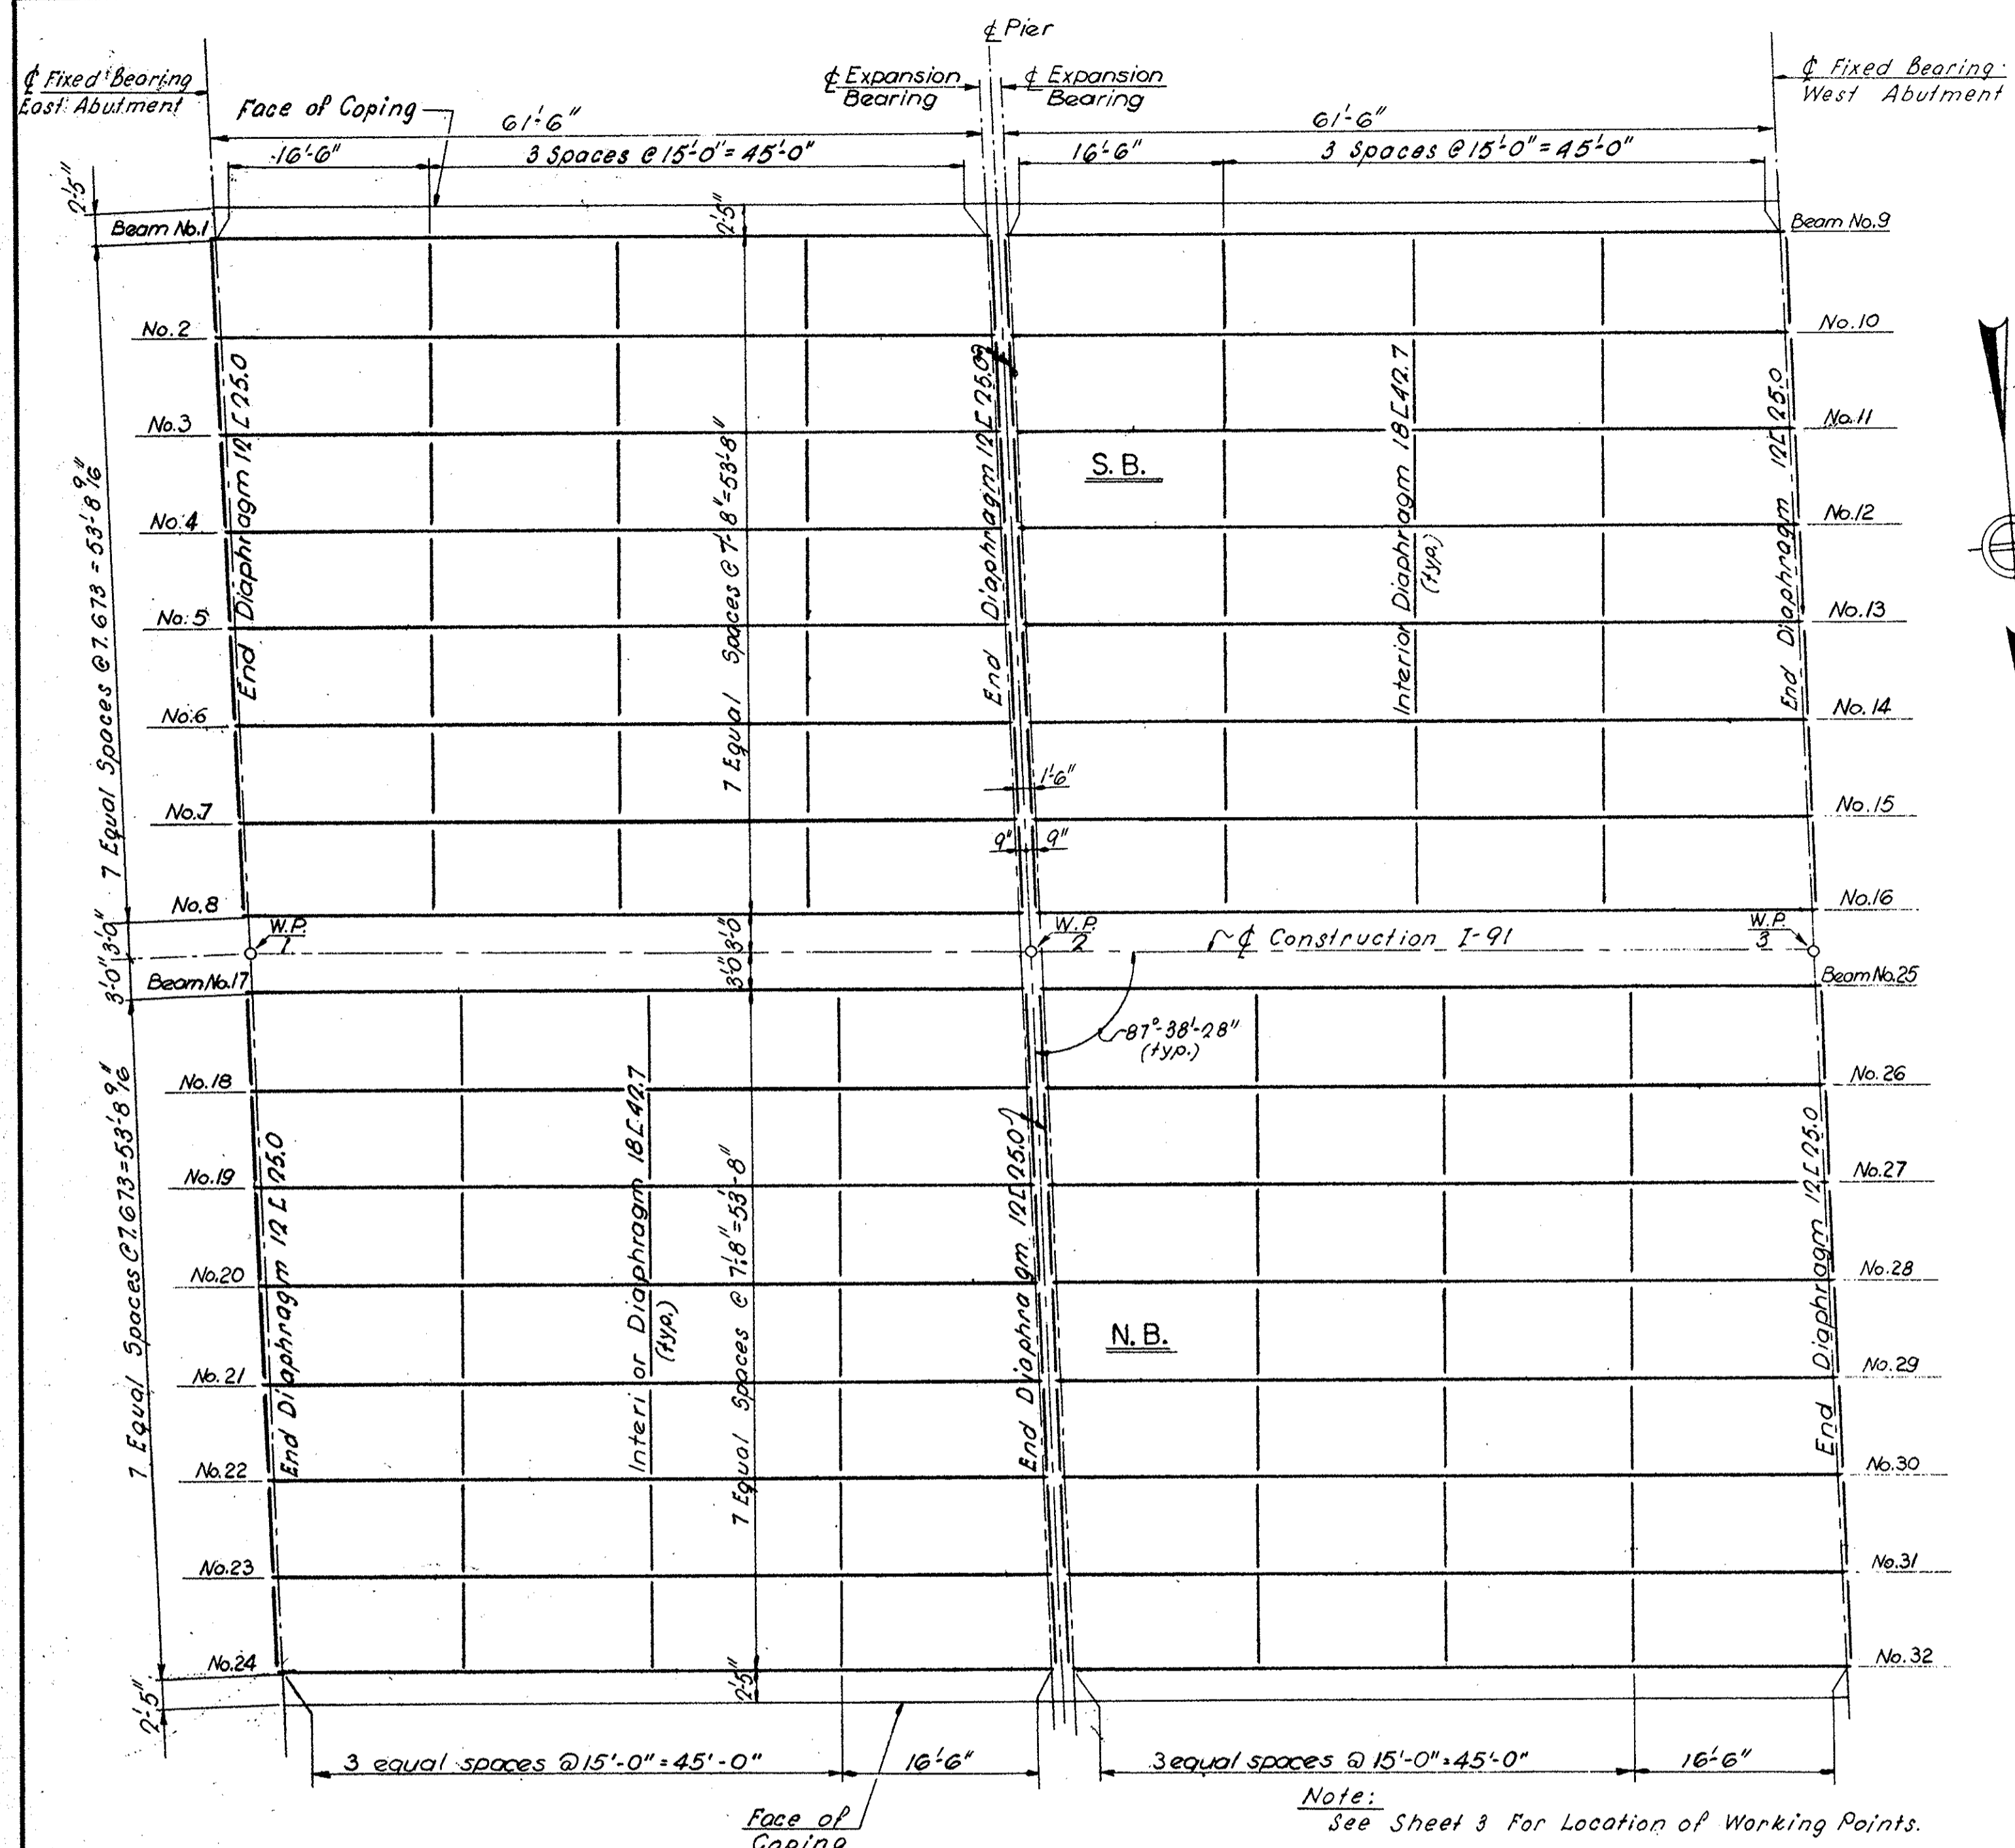


Note: Longitudinal construction joint in Deck Slab may be omitted when the Contractor's Proposed Method of Construction is Approved by the Engineer in Writing.

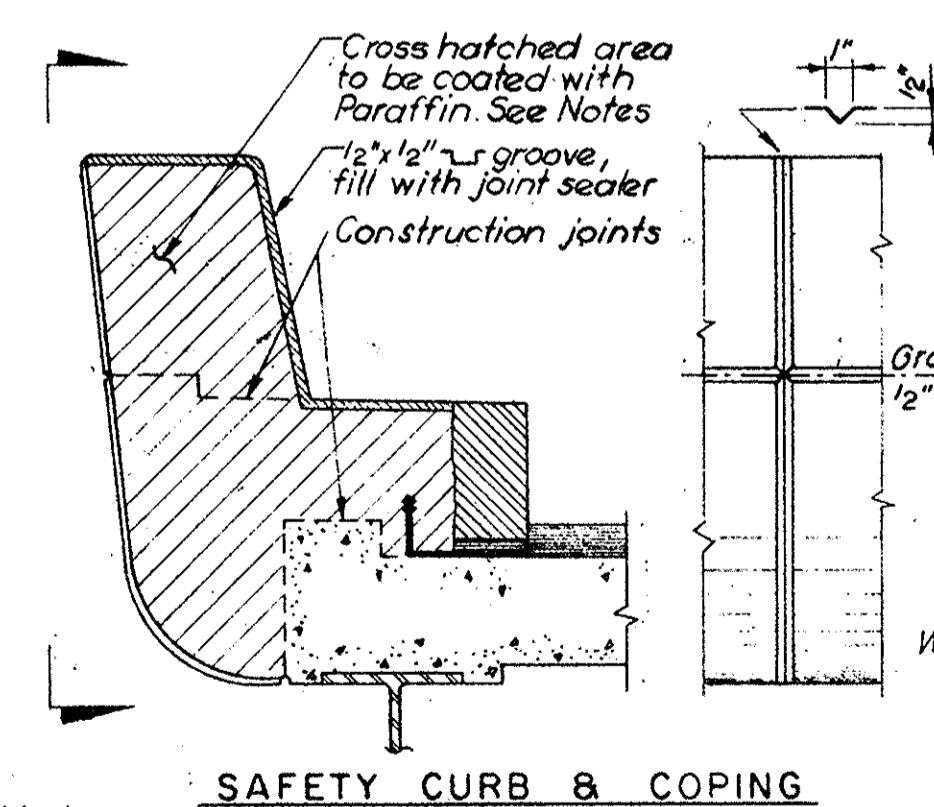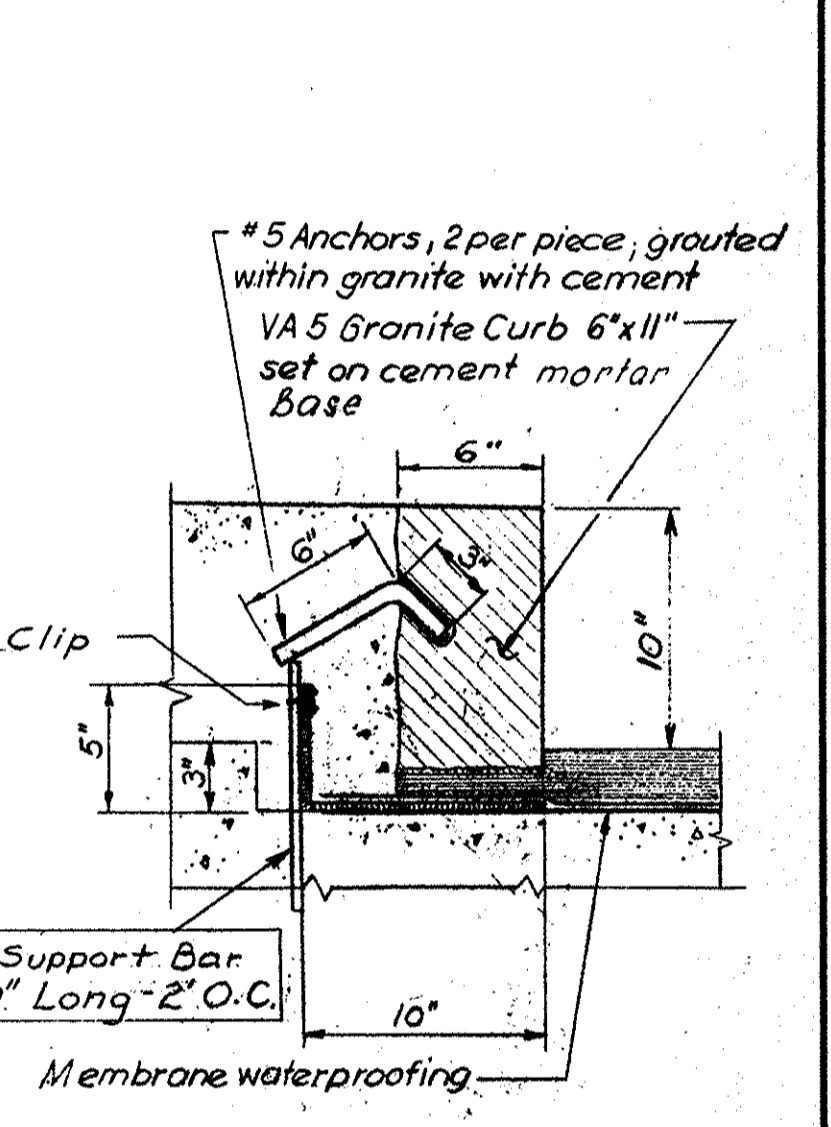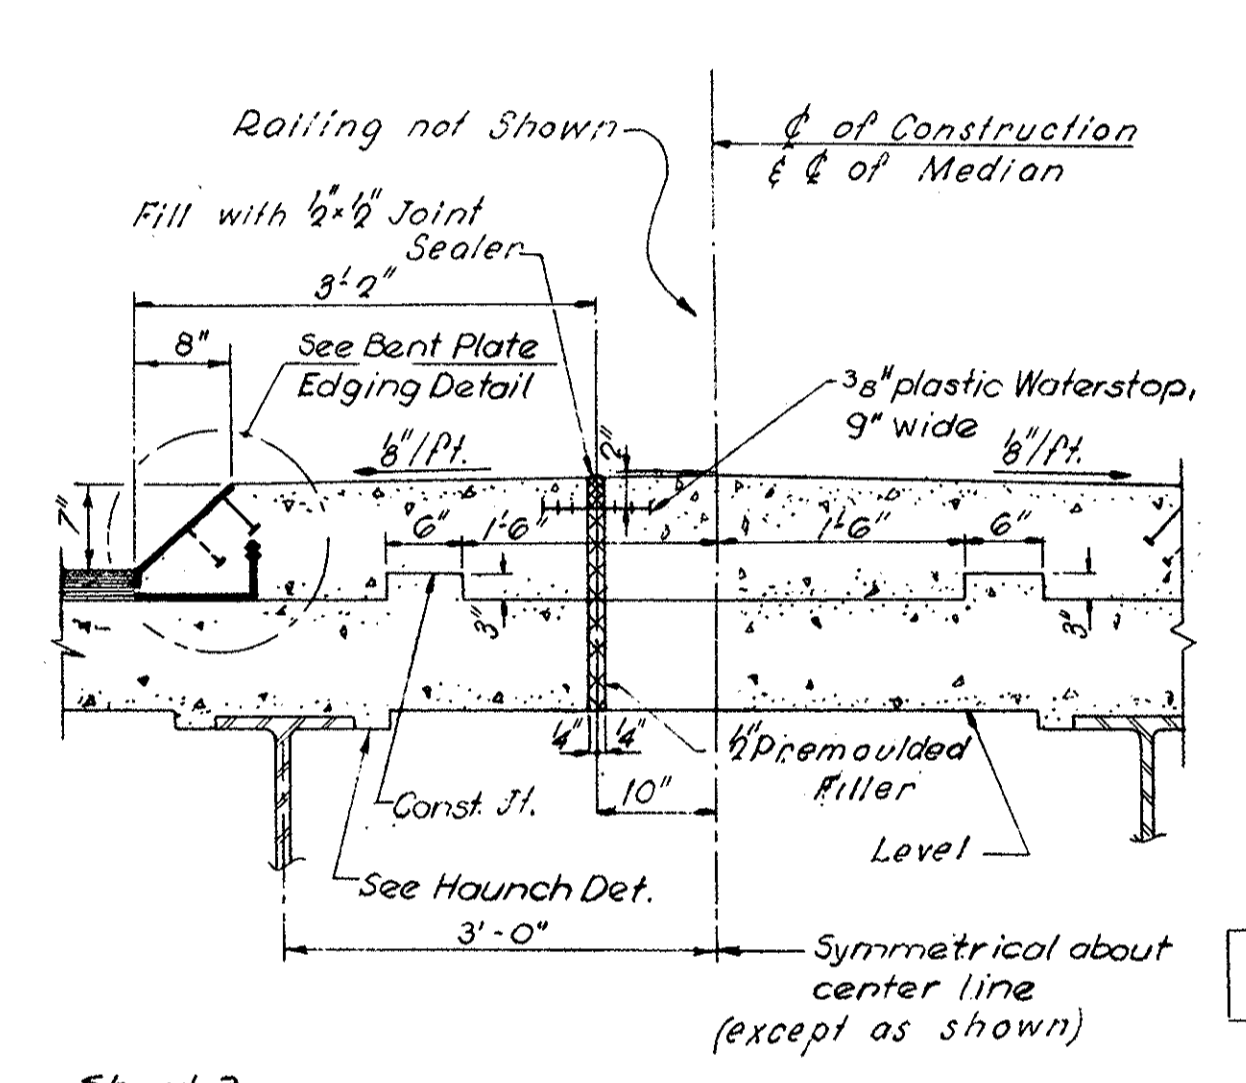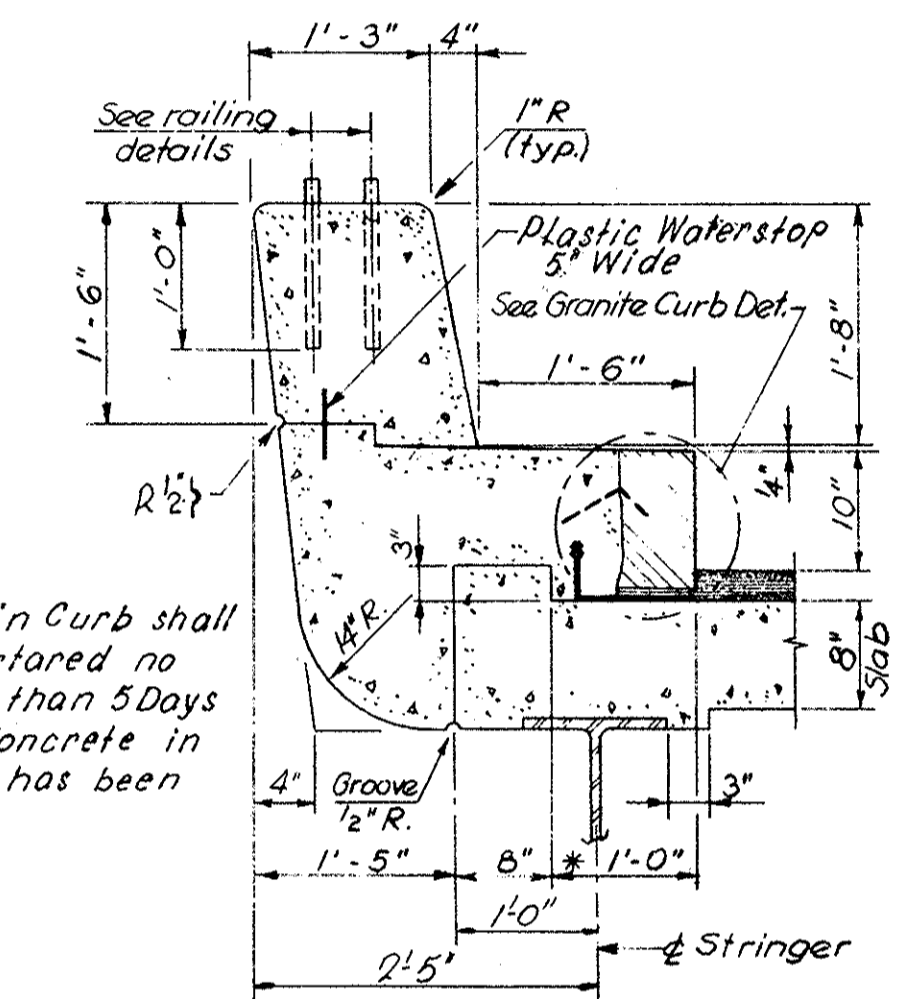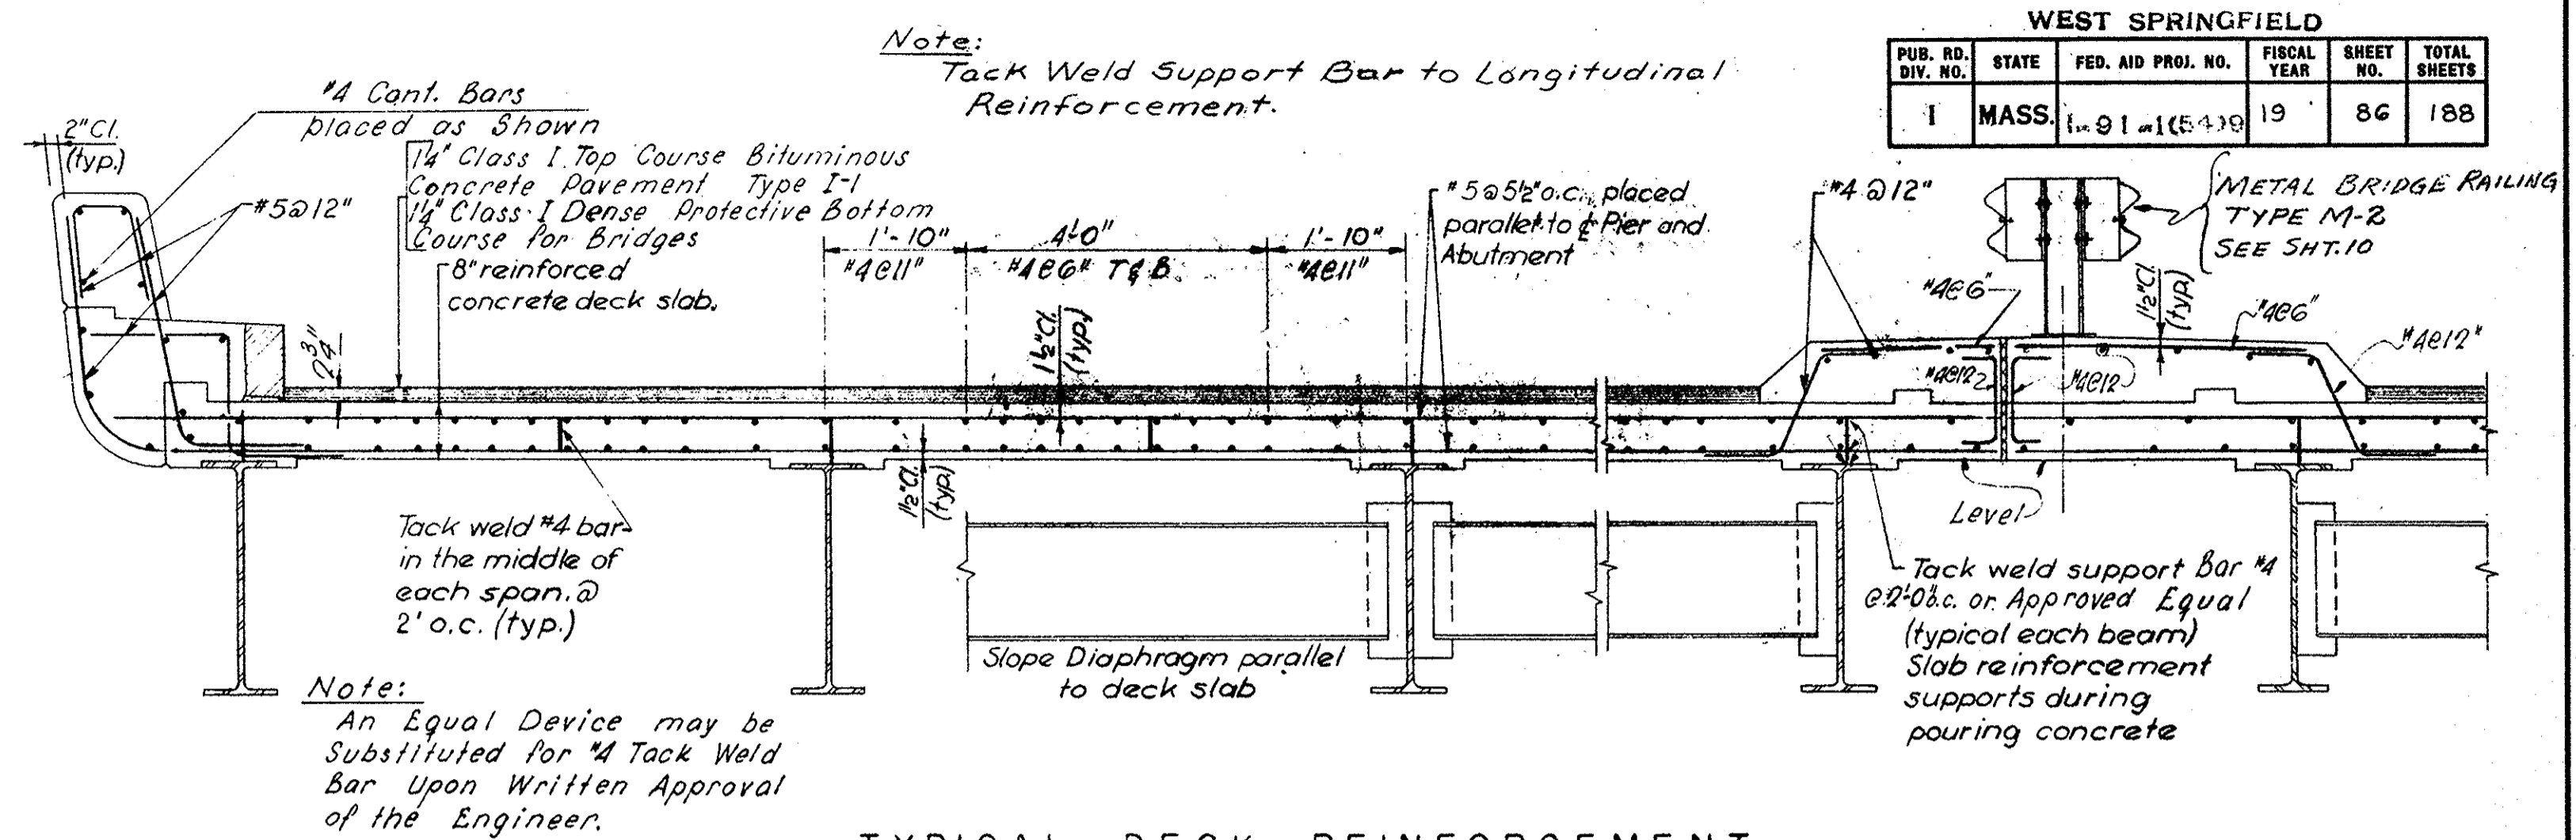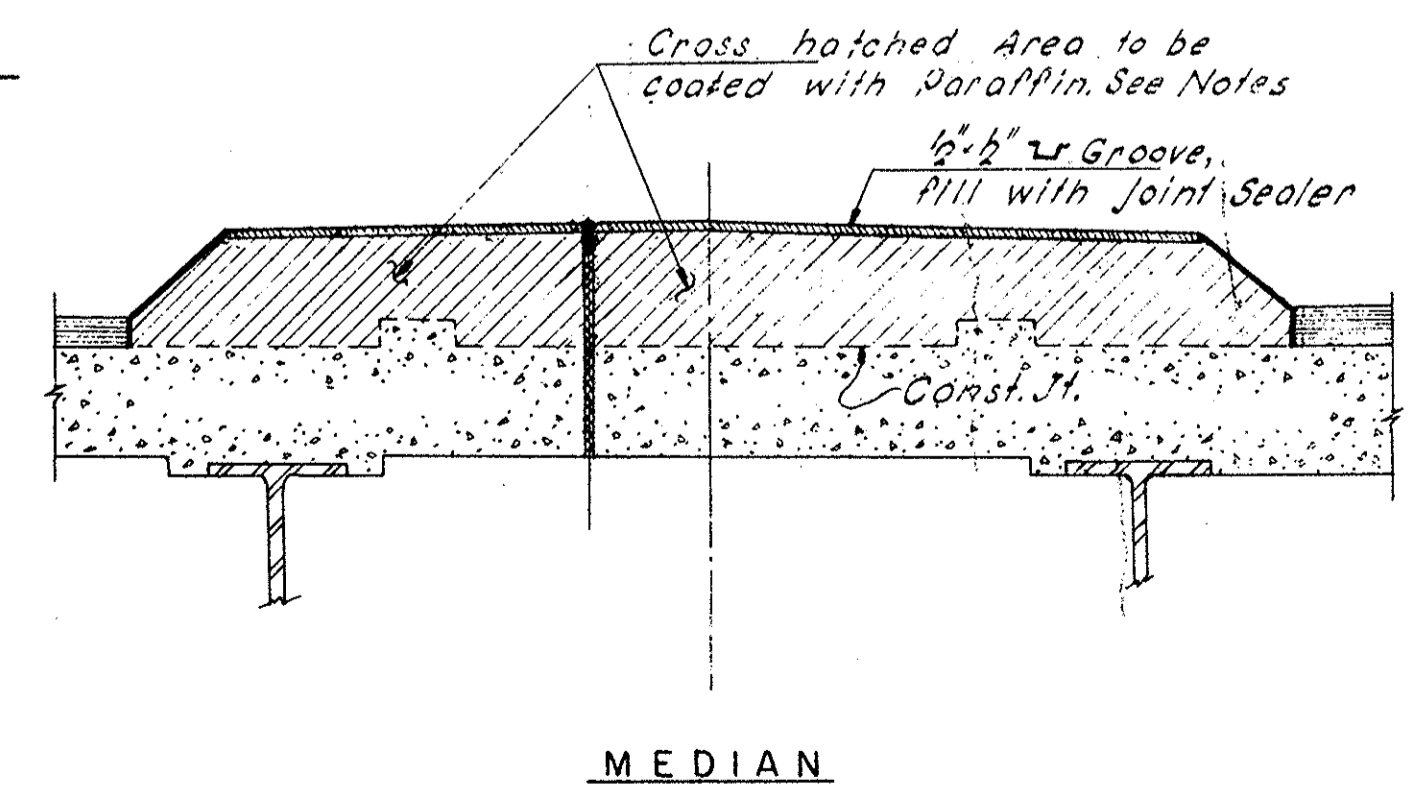

- Notes:
- Safety Curb and Coping shall be poured in alternate sections and shall have a curing period of not less than 5 days between pours.
  - For Spacing of Joints see Sheet 10.
  - Ends of bars to be 2" clear of joint.
  - Longitudinal bars in Curb and Coping are not to be carried through the joints.
  - Joint sealer to be same color as concrete
  - Joints to be square to face of Coping.
  - Flashing to be continuous thru Paraffin Joint.
  - A Mortared Joint in the Curb shall be placed at each Paraffin Joint.

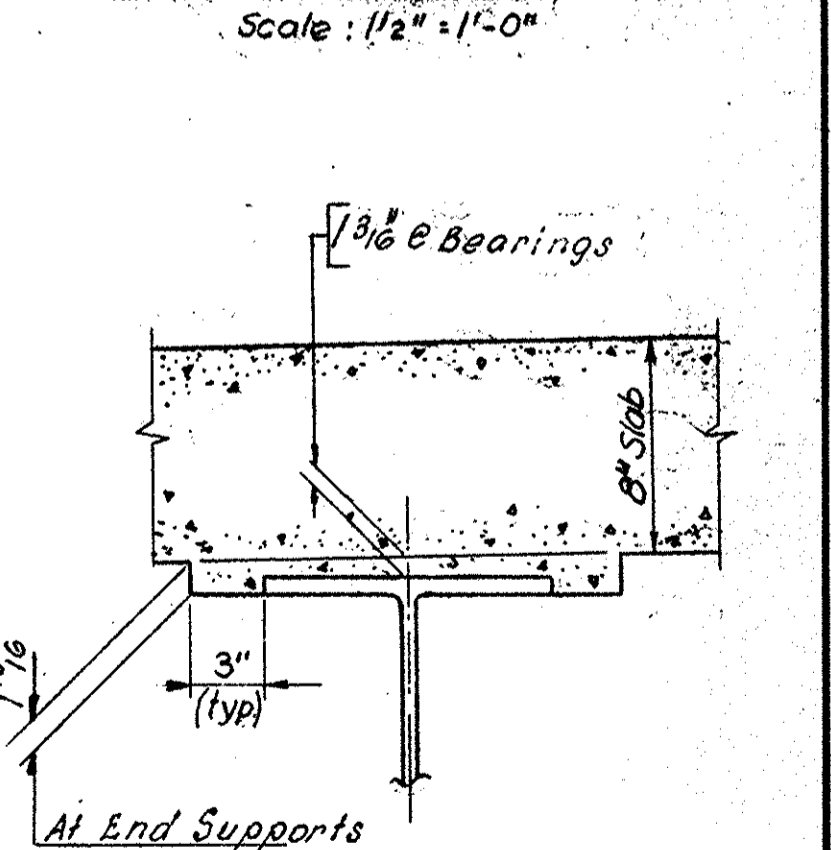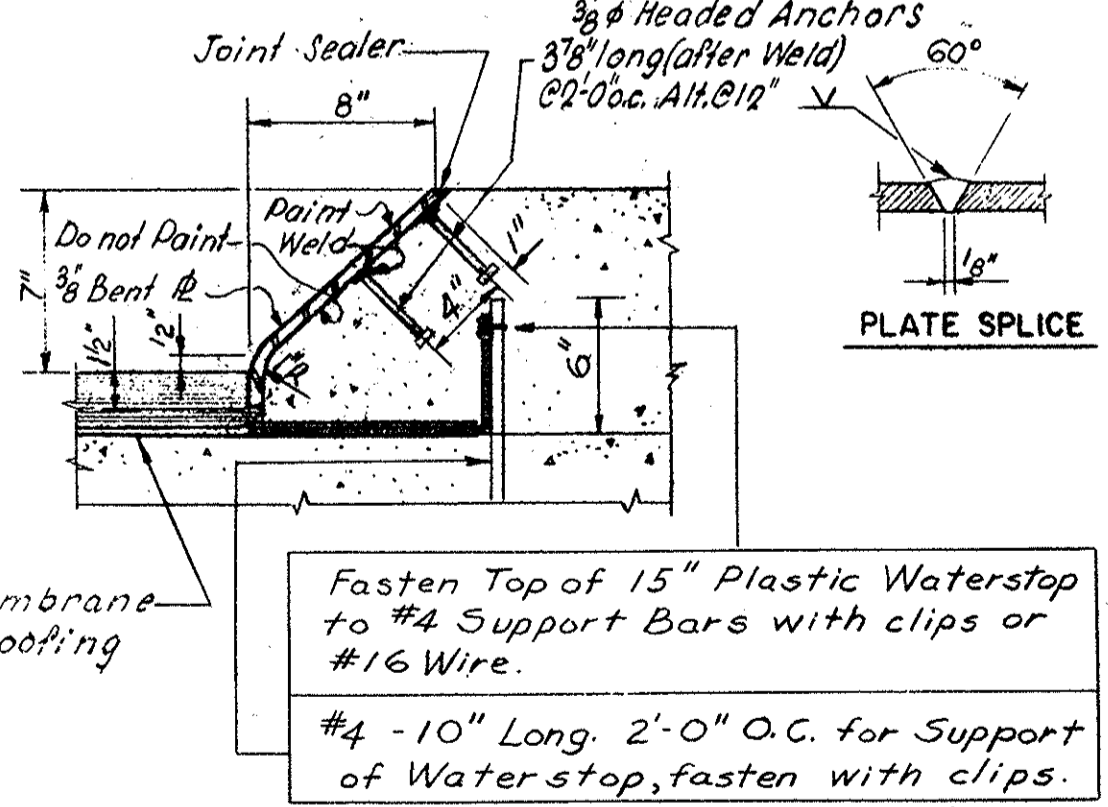


APRIL 9, 1966	ISSUED FOR CONSTRUCTION
DATE	DESCRIPTION
	USE ONLY PRINTS OF LATEST DATE

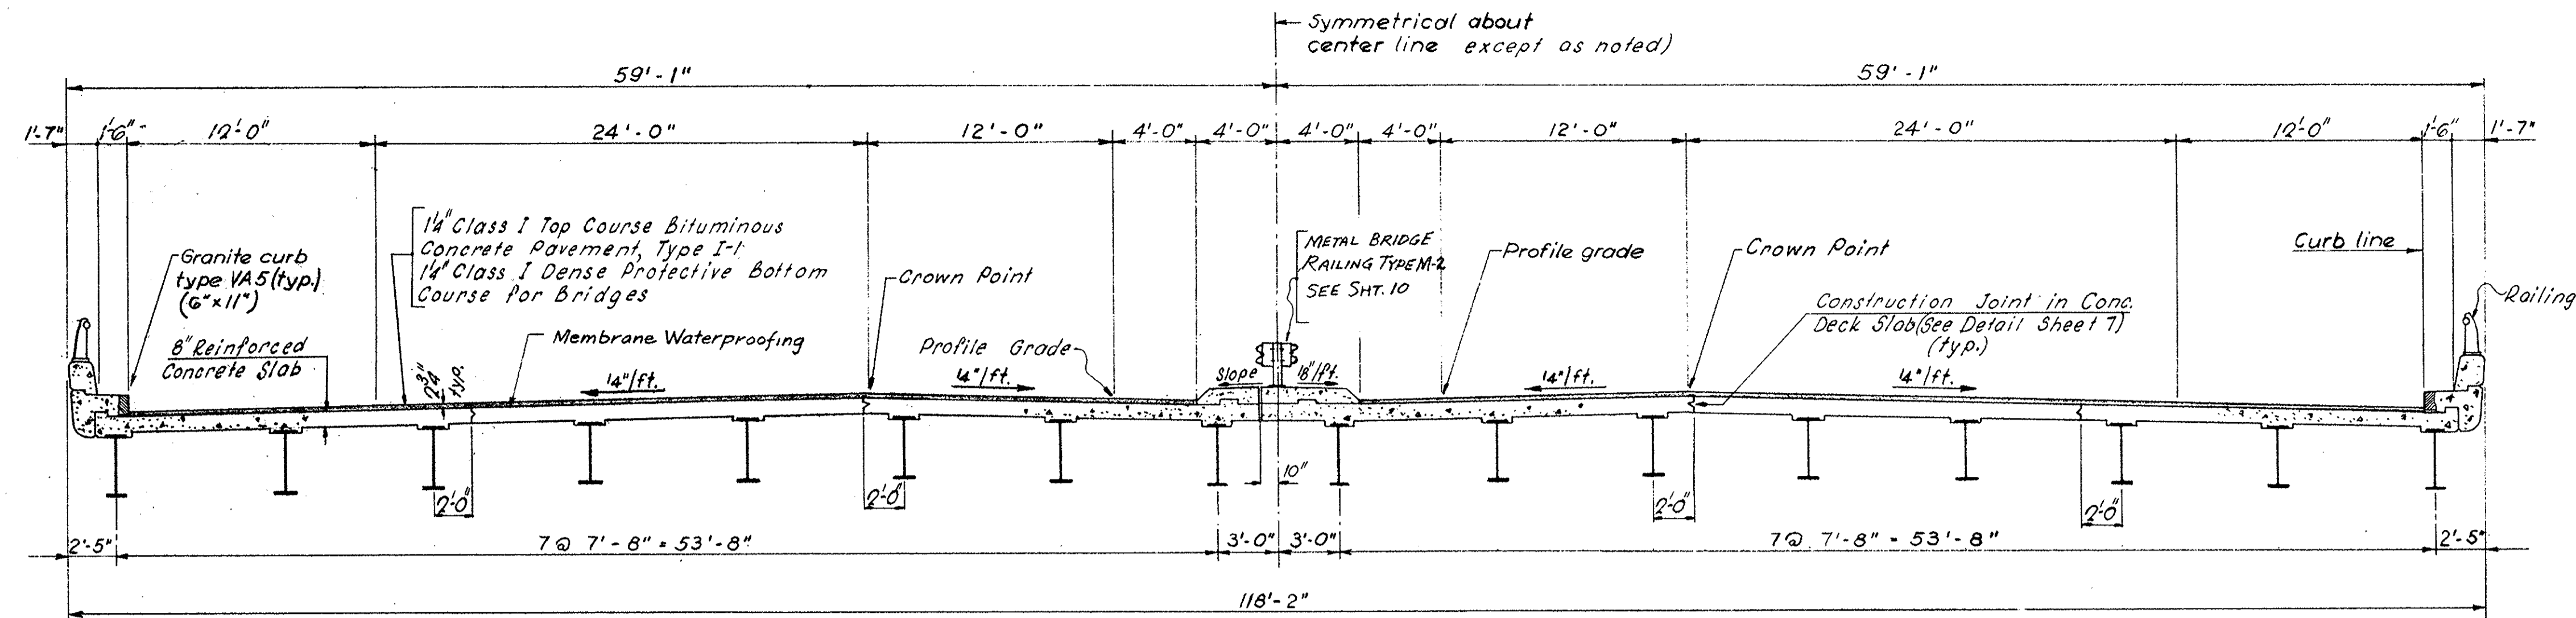

Note:  
All Concrete to be Class 'D'  
Cement Concrete Masonry

TYPICAL CROSS SECTION  
Scale: 3/16" = 1'-0"

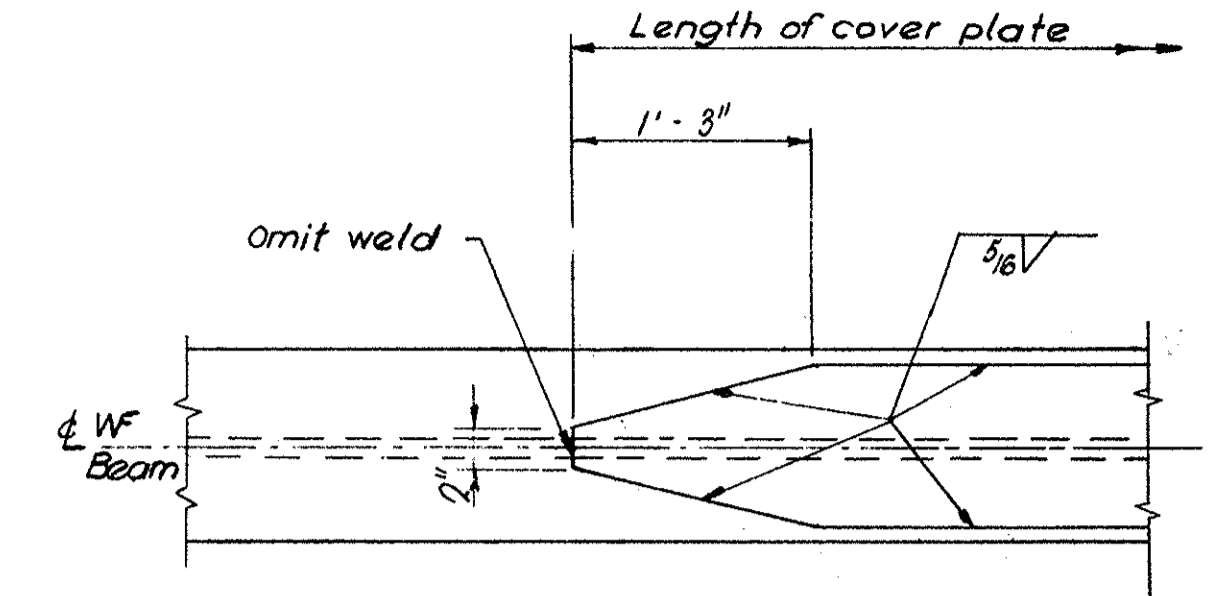


Notes:  
Preparation of material for welding shall conform to art. 402, A.W.S. 1963.  
Assembly of material for welding shall conform to art. 403, A.W.S. 1963.

COVER PLATE DETAIL  
Not to Scale

BEAM NO.	†DEFLECTION DUE TO CONCRETE SLAB			TOTAL DEAD LOAD DEFLECTIONS			CAMBER AT MID SPAN
	1/4 SPAN	1/2 SPAN	3/4 SPAN	1/4 SPAN	1/2 SPAN	3/4 SPAN	
1	3/8"	7/16"	3/8"	3/4"	15/16"	3/4"	1 7/16"
2	1/2"	1 1/16"	1/2"	3/4"	1"	3/4"	1 1/2"
3							
4							
5							
6							
7	1/2"	1 1/16"	1/2"	3/4"	1"	3/4"	1 1/2"
8	7/16"	9/16"	7/16"	3/4"	1"	3/4"	1 1/2"
9	3/8"	7/16"	3/8"	3/4"	15/16"	3/4"	1 7/16"
10	1/2"	1 1/16"	1/2"	3/4"	1"	3/4"	1 1/2"
11							
12							
13							
14							
15	1/2"	1 1/16"	1/2"	3/4"	1"	3/4"	1 1/2"
16	7/16"	9/16"	7/16"	3/4"	1"	3/4"	1 1/2"
17	1/2"	1 1/16"	1/2"	3/4"	1 1/16"	3/4"	1 1/2"
18	1/2"	1 1/16"	1/2"	3/4"	1"	3/4"	1 1/2"
19							
20							
21							
22							
23	1/2"	1 1/16"	1/2"	3/4"	1"	3/4"	1 1/2"
24	3/8"	7/16"	3/8"	3/4"	15/16"	3/4"	1 7/16"
25	1/2"	1 1/16"	1/2"	3/4"	1 1/16"	3/4"	1 1/2"
26	1/2"	1 1/16"	1/2"	3/4"	1"	3/4"	1 1/2"
27							
28							
29							
30							
31	1/2"	1 1/16"	1/2"	3/4"	1"	3/4"	1 1/2"
32	3/8"	7/16"	3/8"	3/4"	15/16"	3/4"	1 7/16"

† The Deflection due to Concrete Slab is 80% of the theoretical Value and is intended for the use of Resident Engineer only.

DESIGN ELEVATIONS ALONG TOP FLANGE				
EAST BEARING	1/4 SPAN	1/2 SPAN	3/4 SPAN	WEST BEARING
83.90	83.91	83.86	83.75	83.60
84.06	84.07	84.02	83.91	83.76
84.22	84.23	84.18	84.07	83.91
84.38	84.38	84.33	84.23	84.07
84.54	84.54	84.49	84.39	84.23
84.62	84.63	84.58	84.48	84.32
84.46	84.47	84.42	84.32	84.16
84.30	84.30	84.25	84.15	84.00
83.59	83.59	83.54	83.44	83.28
83.75	83.75	83.70	83.60	83.44
83.90	83.91	83.86	83.76	83.60
84.06	84.07	84.02	83.92	83.76
84.22	84.23	84.18	84.07	83.91
84.31	84.32	84.27	84.16	84.00
84.15	84.15	84.11	84.00	83.84
83.99	83.99	83.94	83.84	83.68
84.30	84.31	84.26	84.16	83.99
84.46	84.46	84.42	84.31	84.15
84.62	84.62	84.57	84.47	84.31
84.53	84.53	84.48	84.38	84.22
84.36	84.37	84.32	84.22	84.06
84.20	84.21	84.16	84.06	83.90
84.04	84.05	84.00	83.89	83.74
83.88	83.88	83.83	83.73	83.57
83.98	83.99	83.95	83.84	83.68
84.14	84.15	84.10	84.00	83.84
84.30	84.31	84.26	84.15	83.99
84.21	84.22	84.07	84.06	83.90
84.05	84.06	84.01	83.90	83.74
83.89	83.89	83.85	83.74	83.58
83.73	83.73	83.68	83.58	83.42
83.56	83.57	83.52	83.41	83.26

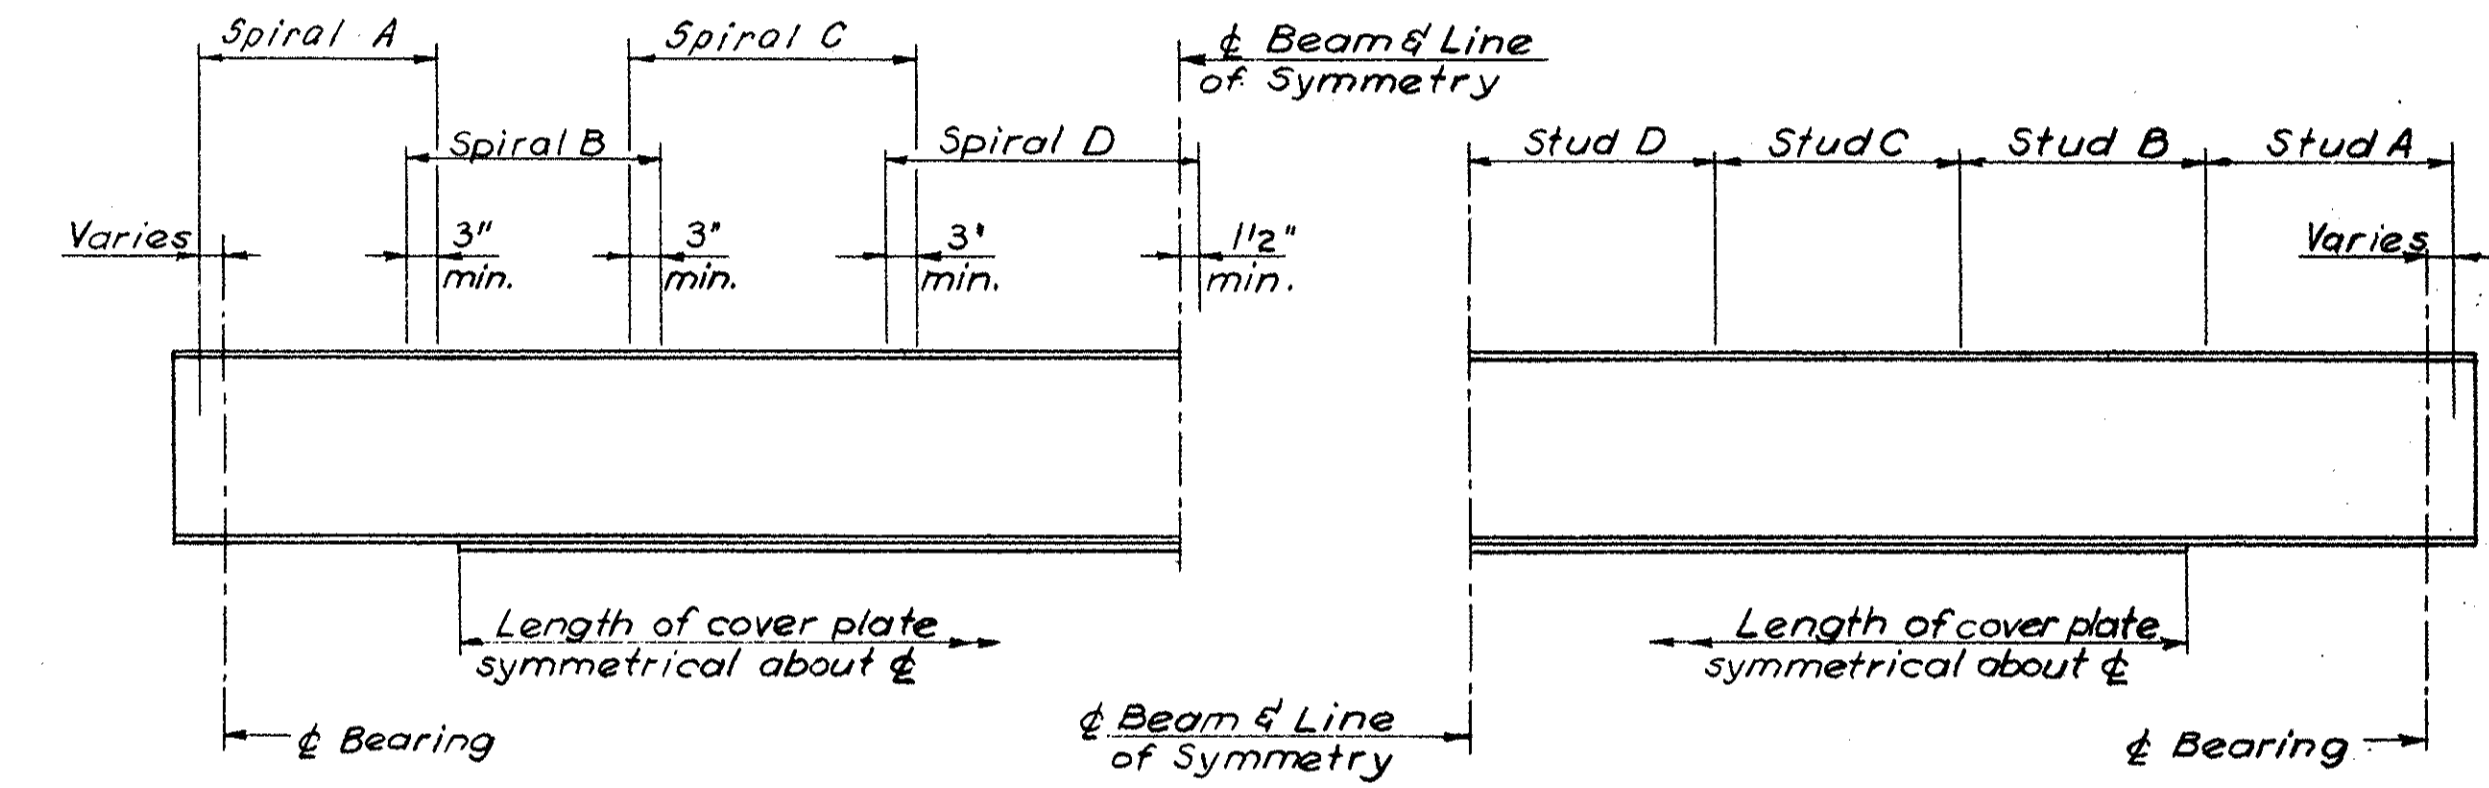


SPAN	BEAM NO	SIZE	LENGTH C-C BEARINGS	BOTTOM COVER PLATE	2-5/8" φ SPIRAL SHEAR CONNECTORS								3-3/4" φ STUD SHEAR CONNECTORS									
					SPIRAL A		SPIRAL B		SPIRAL C		SPIRAL D		STUD A		STUD B		STUD C		STUD D			
					LENGTH	PITCH	LENGTH	PITCH	LENGTH	PITCH	LENGTH	PITCH	LENGTH	PITCH	LENGTH	PITCH	LENGTH	PITCH	LENGTH	PITCH		
SPAN 1	1	36W135	61'-6"	10x16x46-6"	8'-4"	5"	7'-7"	6 1/2"	7'-1"	8 1/2"	8'-9"	10'-2"	8'-4"	4"	7'-4"	5 1/2"	7'-0"	7"	8'-3"	9"		
	2-7				8'-4"	8'-0"	7'-4"	8"	8'-4"	10"	8'-4"	4"	7'-11"	5"	6'-5"		8'-3"					
	8				7'-6"	7'-7"	6 1/2"	7'-4 1/2"	8 1/2"	8'-9"	10'-2"	9'-4 1/2"	4 1/2"	7'-0"	6"	6'-10 1/2"		8'-3"				
	17				8'-4"	7'-7"	6 1/2"	7'-1"	8 1/2"	8'-9"	10'-2"	8'-4"	4"	7'-4"	5 1/2"	7'-0"		8'-3"				
SPAN 2	18-23			10x16x47-6"	8'-4"		8'-0"	6"	7'-4"	8"	8'-4"	10"	8'-4"	4"	7'-11"	5"	6'-5"		8'-3"			
	24			10x16x46-6"	8'-4"		7'-7"	6 1/2"	7'-1"	8 1/2"	8'-9"	10'-2"	8'-4"	4"	7'-4"	5 1/2"	7'-0"		8'-3"			
	9			10x16x46-6"	8'-4"		7'-7"	6 1/2"	7'-1"	8 1/2"	8'-9"	10'-2"	8'-4"	4"	7'-4"	5 1/2"	7'-0"		8'-3"			
	10-15			10x16x47-6"	8'-4"		8'-0"	6"	7'-4"	8"	8'-4"	10"	8'-4"	4"	7'-11"	5"	6'-5"		8'-3"			
	16			10x16x46-6"	7'-6"		7'-7"	6 1/2"	7'-1 1/2"	8 1/2"	8'-9"	10'-2"	9'-4 1/2"	4 1/2"	7'-0"	6"	6'-10 1/2"		7'-11"			
	25			10x16x47-6"	8'-4"		7'-7"	6 1/2"	7'-1"	8 1/2"	8'-9"	10'-2"	8'-4"	4"	7'-4"	5 1/2"	7'-0"		8'-3"			
	26-31			10x16x47-6"	8'-4"		8'-0"	6"	7'-4"	8"	8'-4"	10"	8'-4"	4"	7'-11"	5"	6'-5"		8'-3"			
	32			10x16x46-6"	8'-4"	5"	7'-7"	6 1/2"	7'-1"	8 1/2"	8'-9"	10'-2"	8'-4"	4"	7'-4"	5 1/2"	7'-0"	7"	8'-3"	9"		

Notes:  
1. Ends of all beams shall be fabricated so that under full dead load the Ends will be plumb.  
2. The table of Design Elevations along top flange is for the use of the Resident Engineer in the field for comparison of:  
a) Elevations along top flange of stringers in place and -  
b) the design elevations tabulated.  
3. Any Welded Joint Prepared by American Welding Society Specifications for Welded Highway and Railway Bridges (1963 Edition) will be acceptable in the Fabrication of the Structural Steel.






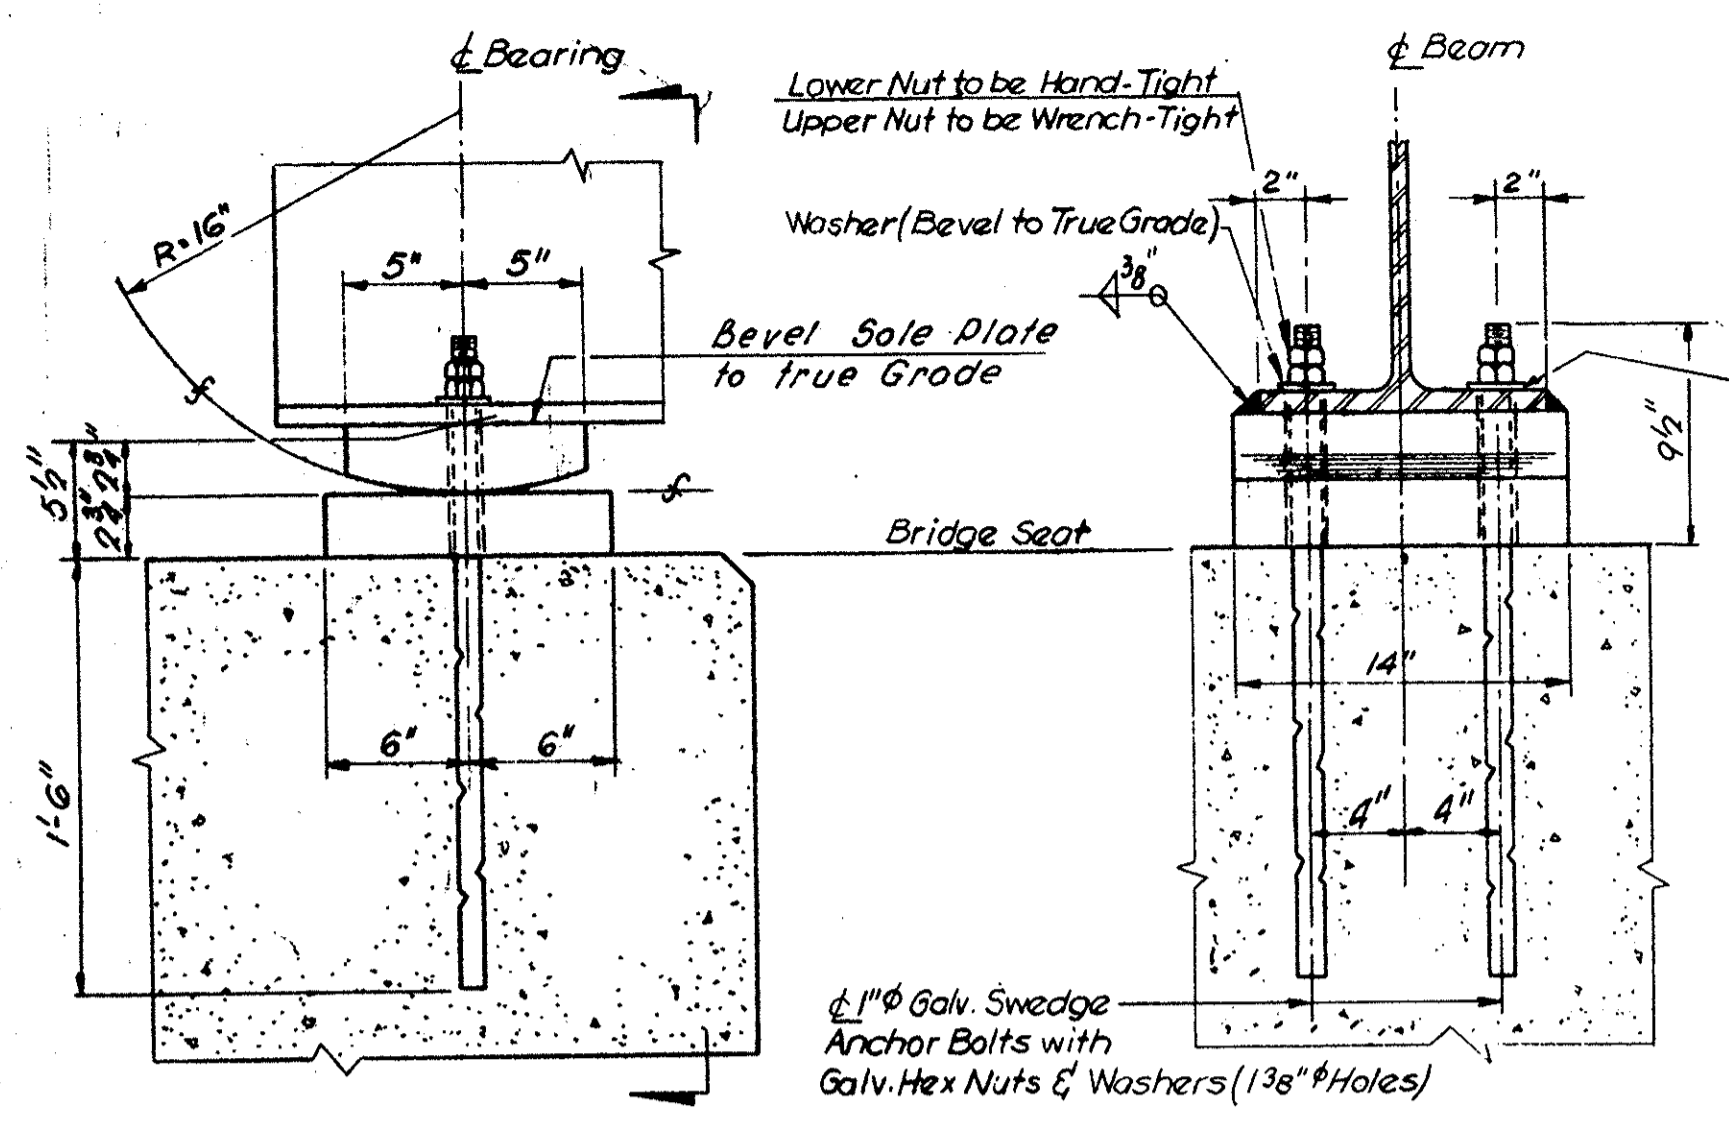


**FIXED BEARINGS**  
Scale 1/2" = 1'-0"


- Notes**
- Masonry Plates and Sole Plates to be ASTM A36 Steel.  $\delta$  denotes ASA 125 microinches or finer.
  - The finished surfaces shall meet the American Standard's Association surface roughness requirements as defined in ASA B46-1, surface roughness, waviness and lay, Part I.
  - Anchor Bolts to be set by template and placed before concrete is poured.
  - Masonry Plate to have full bearing and to be adjusted for level before placing the stringers on bearing assembly.

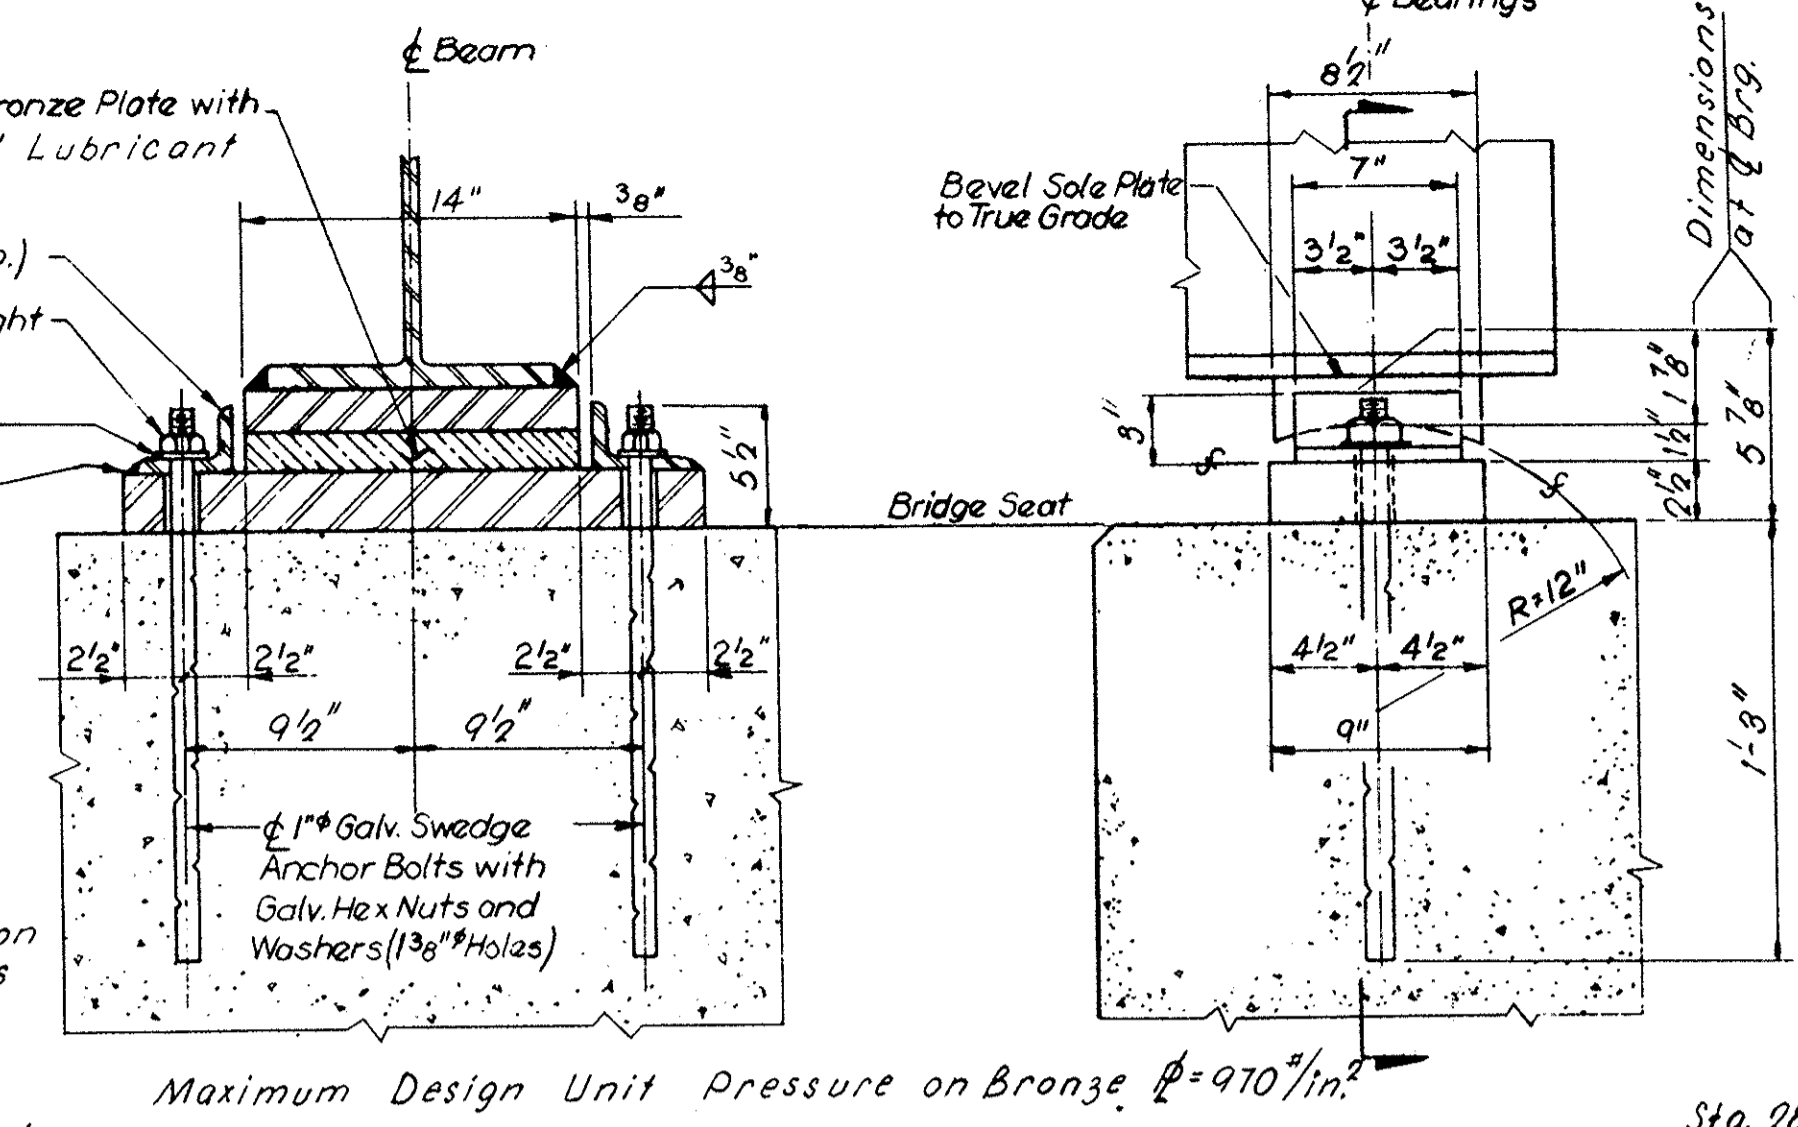

**EXPANSION BEARINGS**  
Scale 1/2" = 1'-0"

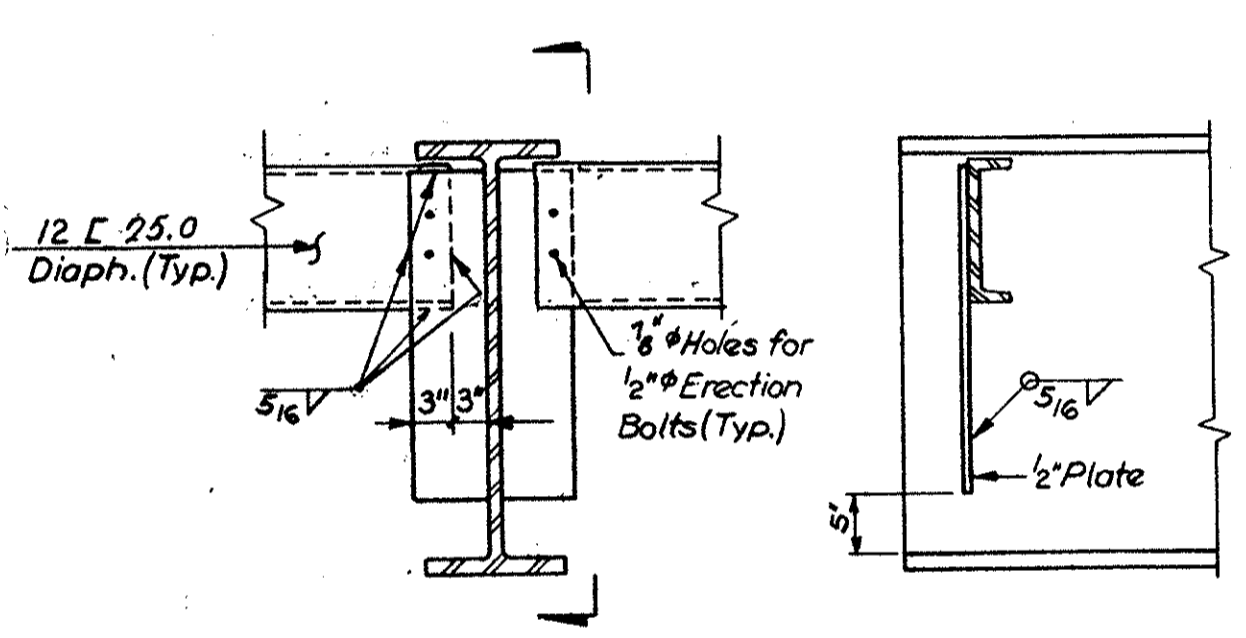


**END DIAPHRAGM**

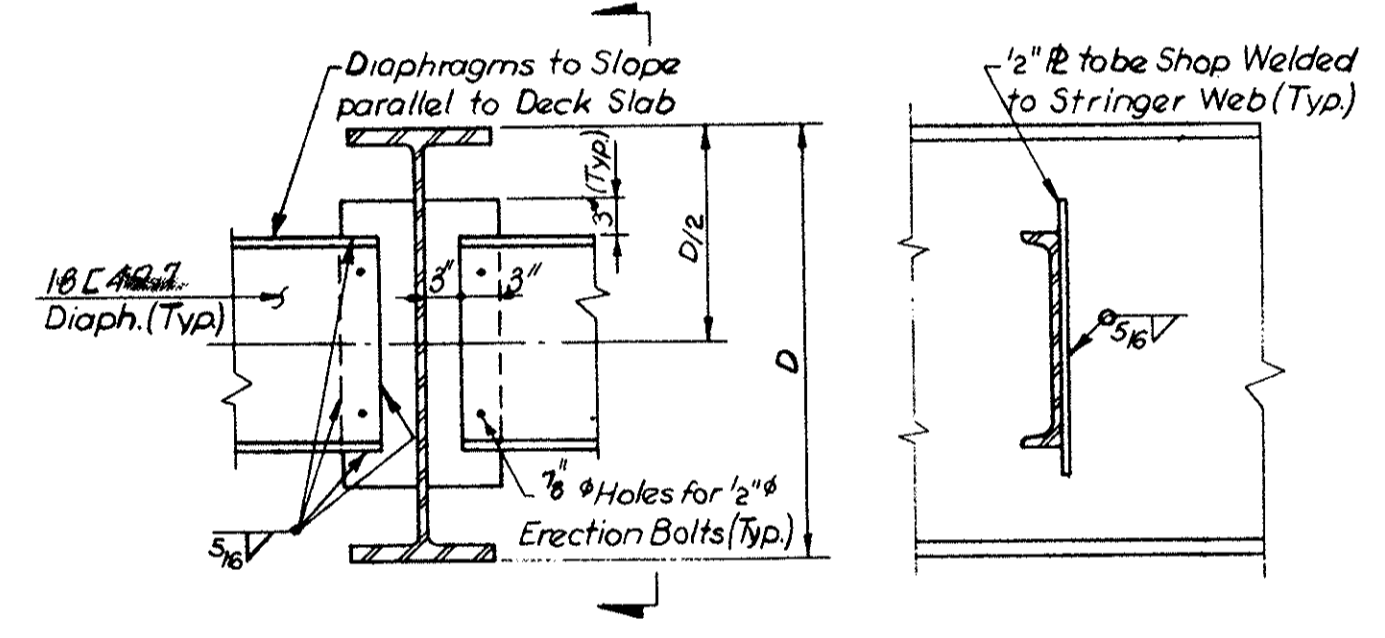


**INTERIOR DIAPHRAGM**


**TYPICAL DIAPHRAGM CONNECTIONS**  
Scale 3/4" = 1'-0"

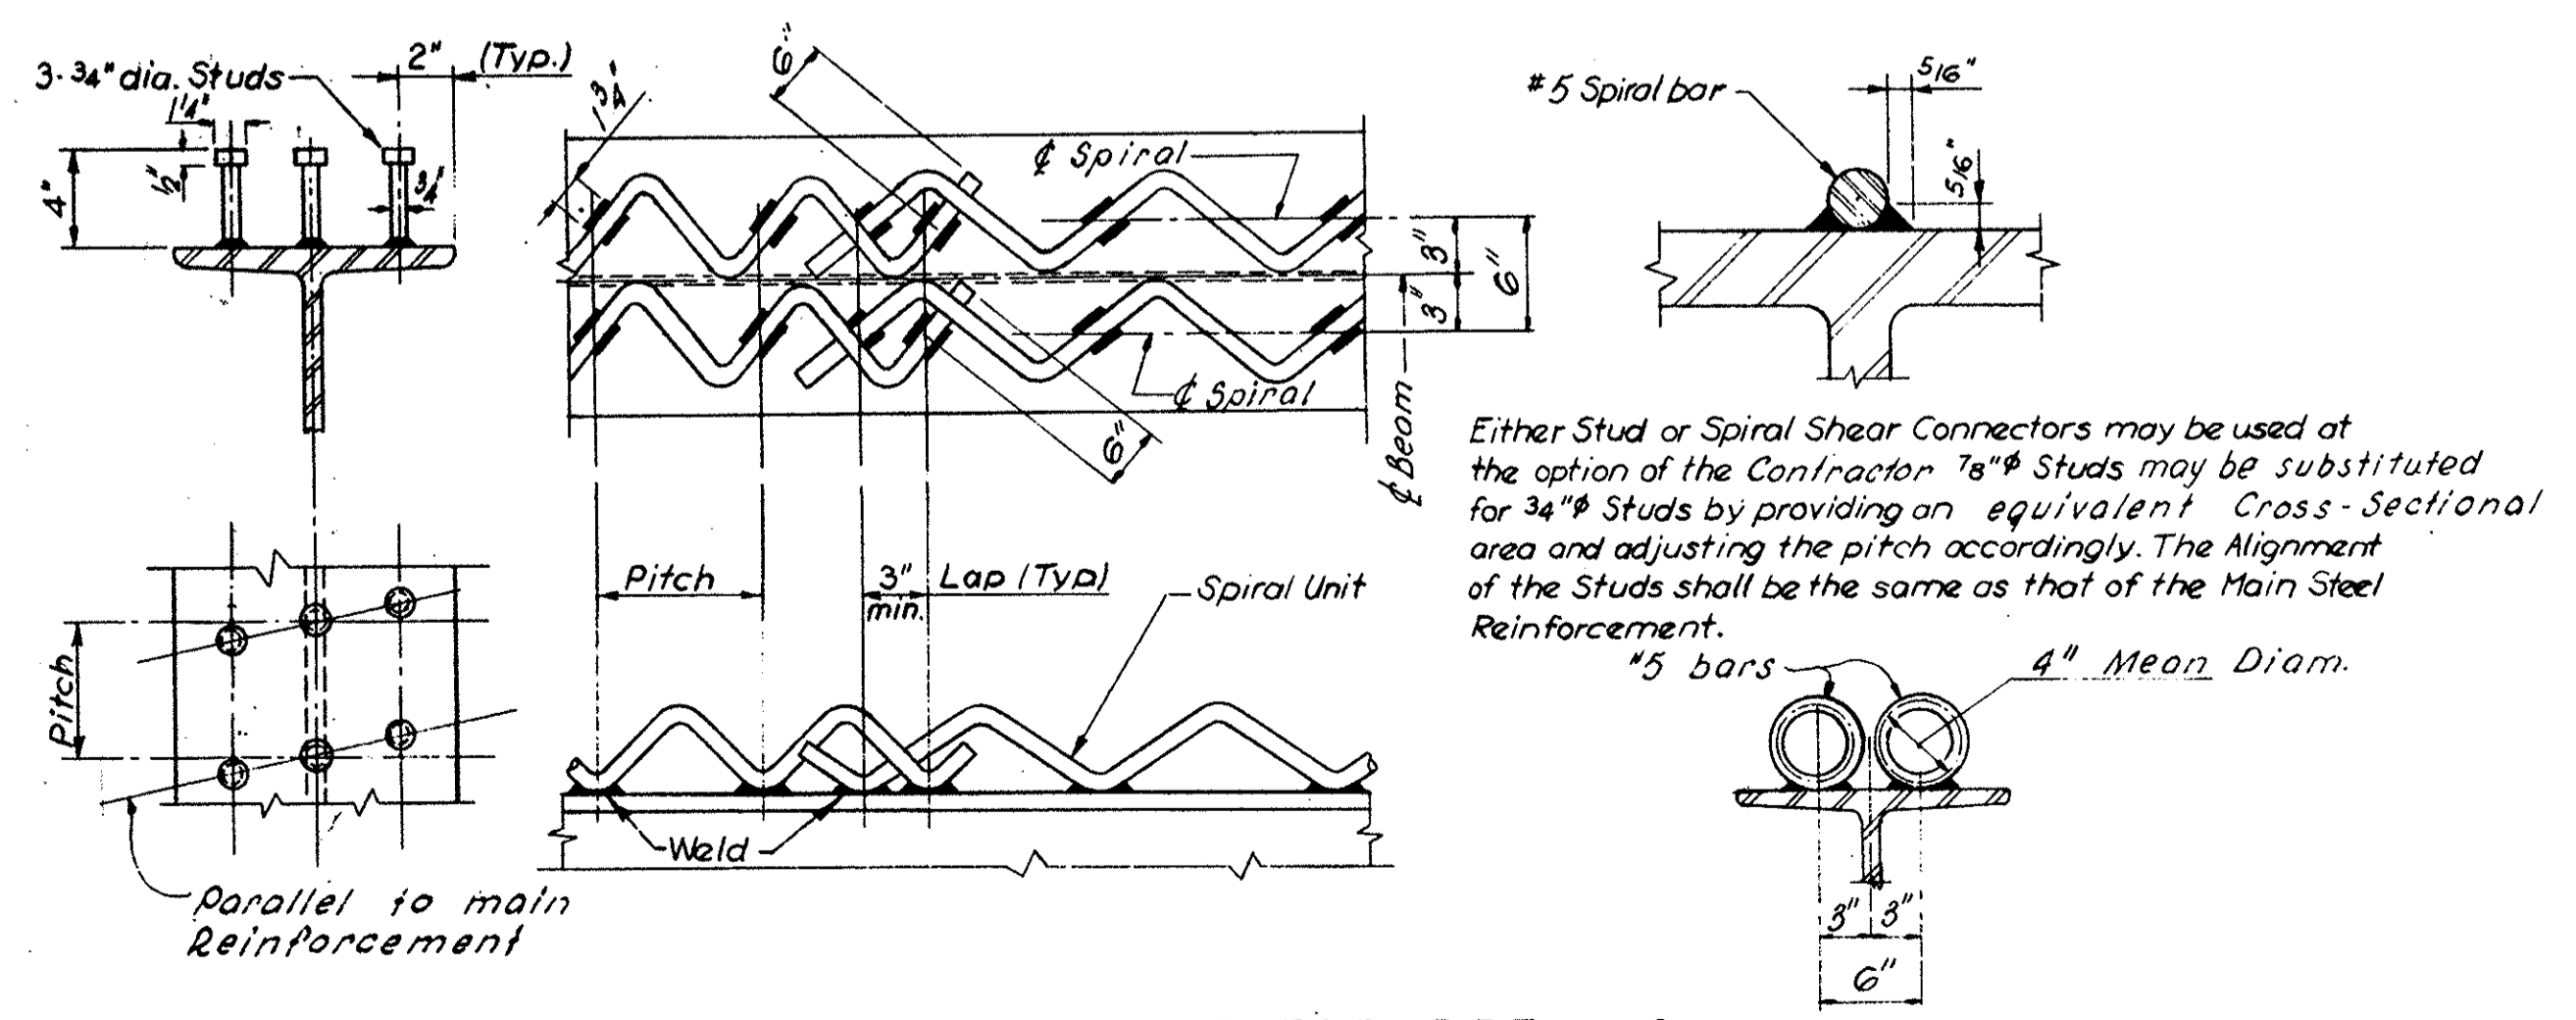


**Shear Connector Details**  
No Scale

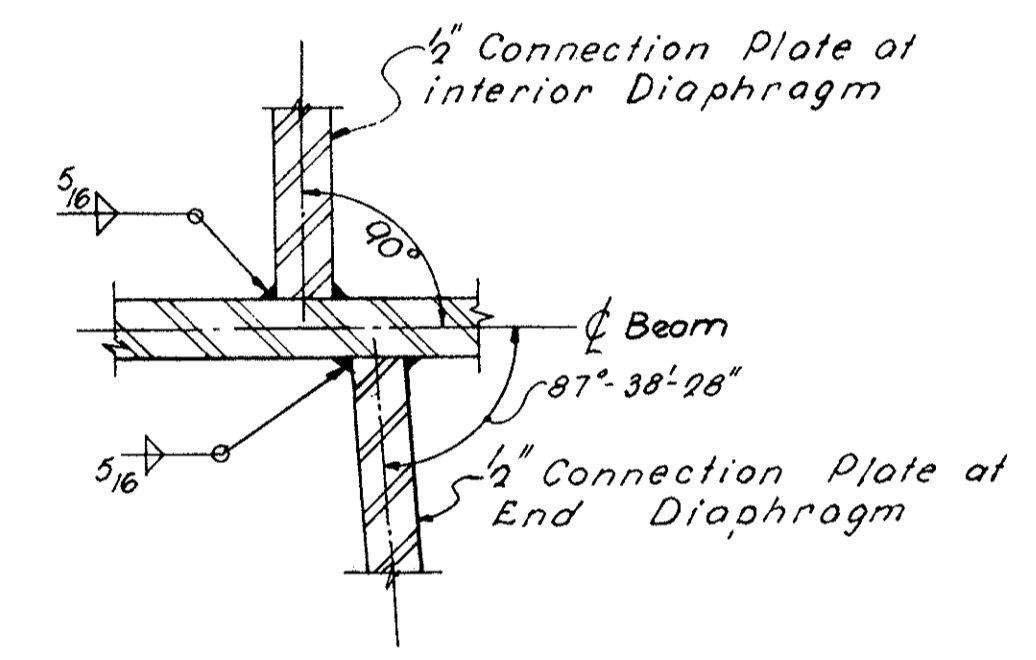

**CONNECTION PLATE DETAIL**

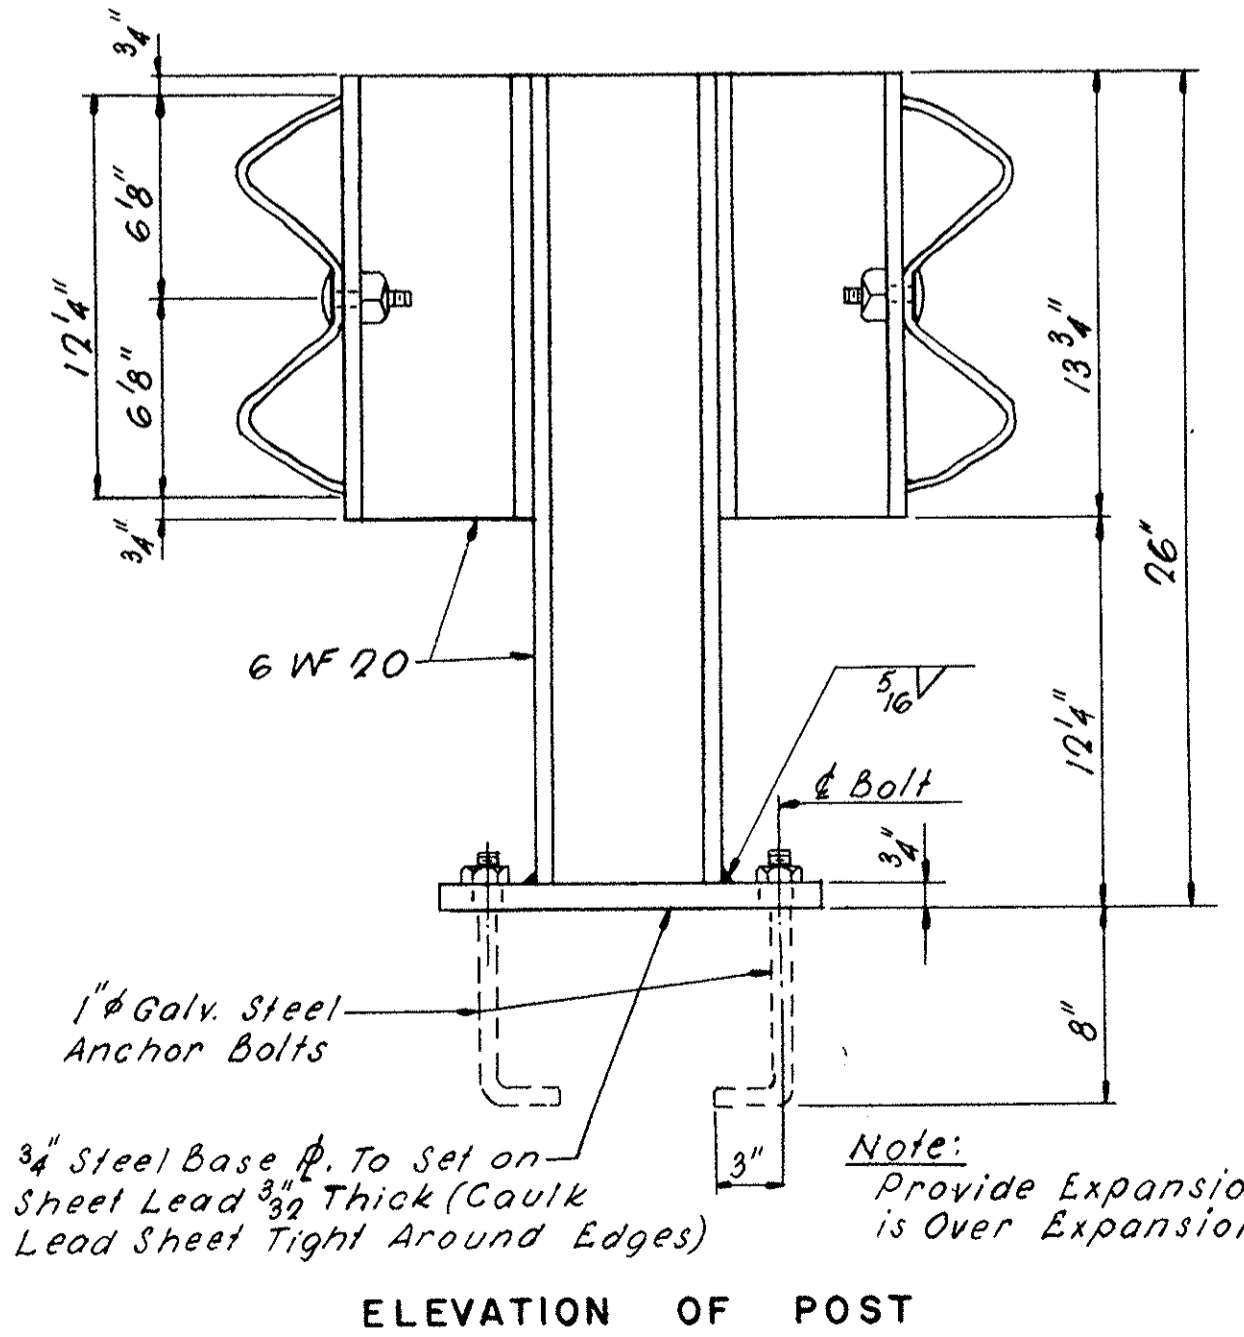


**ELEVATION OF POST**  
**METAL BRIDGE RAILING - TYPE M-2**  
Scale: 1" = 0'-6"

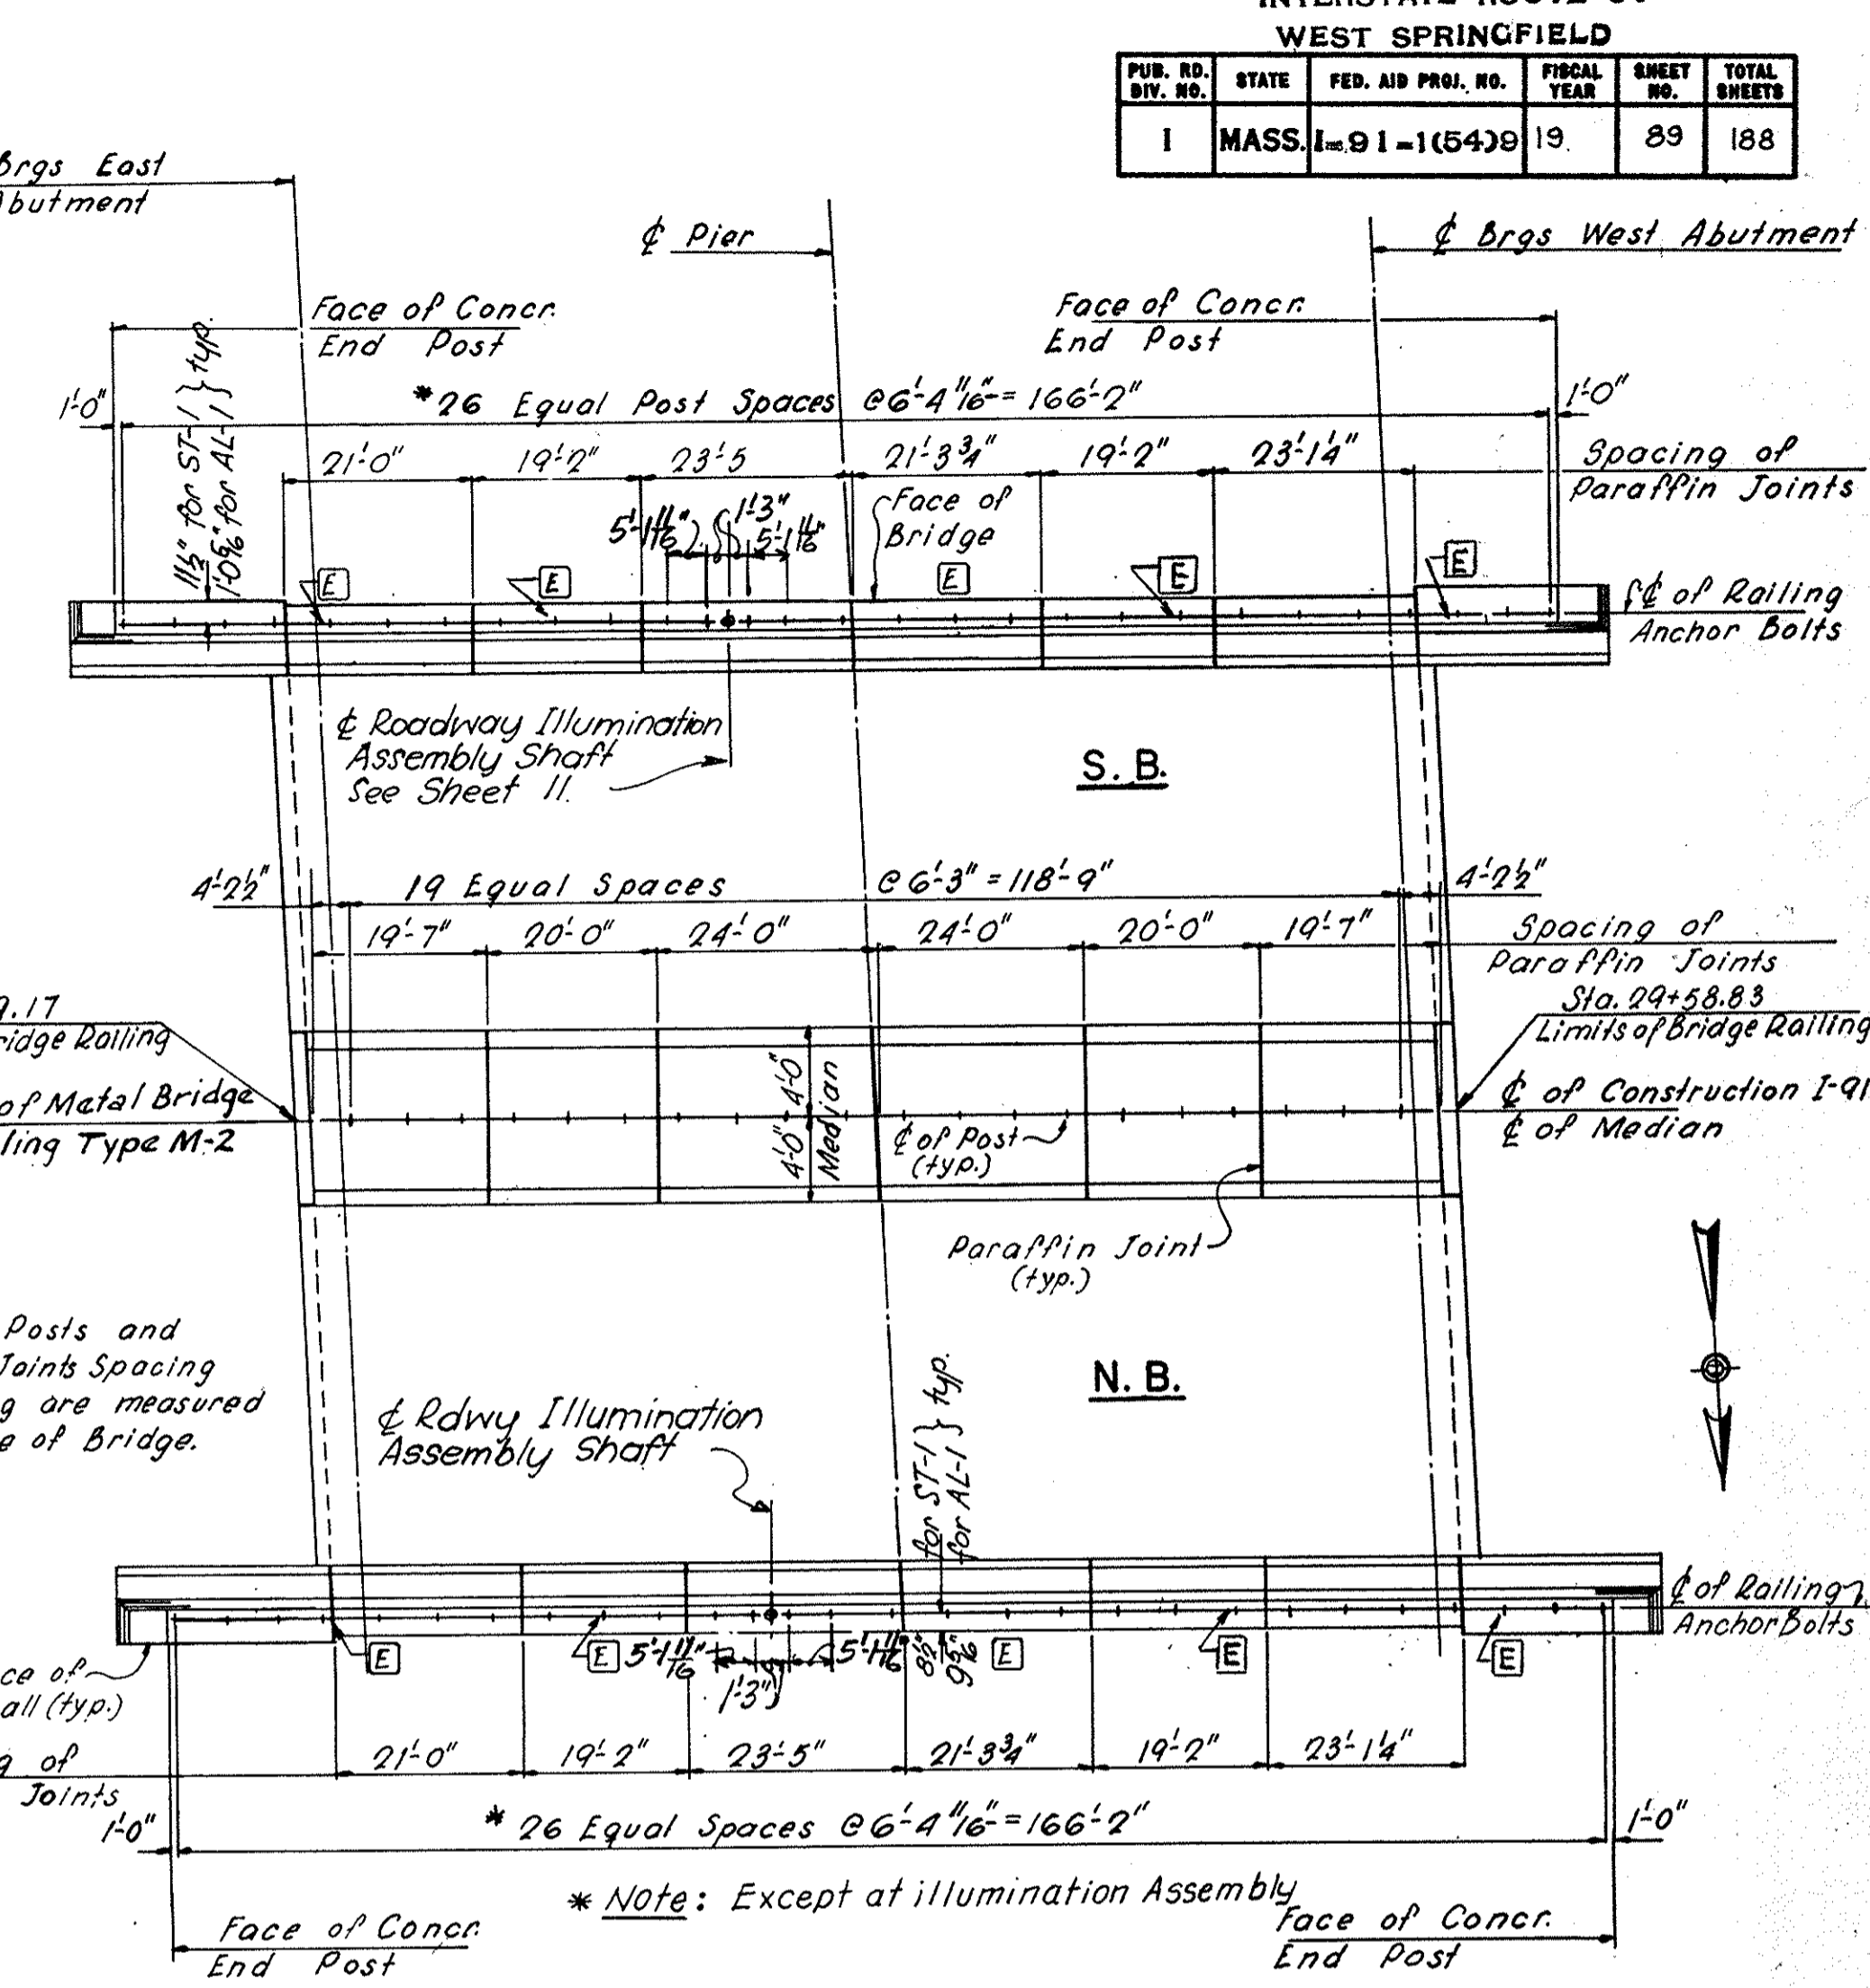

Note: Railing Posts and Paraffin Joints Spacing at Coping are measured along Face of Bridge.

Denotes Location of Expansion Joint in Rail for Metal Bridge Railing Type ST-1 or AL-1. For Details see Standard Railing Sheets. Expansion in Rails To Be At Arrow Side of Post.








**RAILING POST & PARAFFIN JOINT LAYOUT PLAN**  
Not to Scale

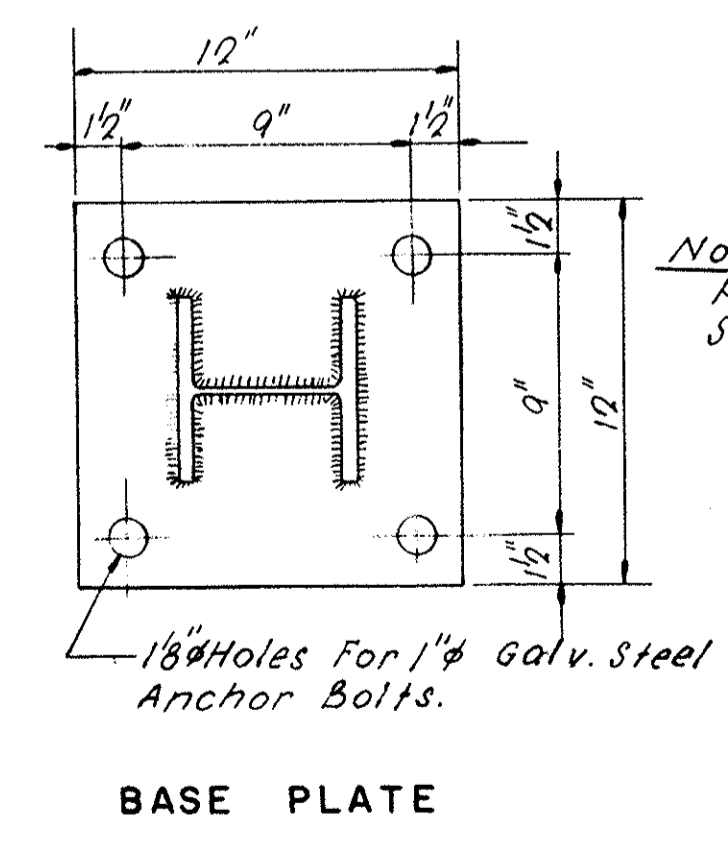

**BASE PLATE**

APRIL 9, 1966	ISSUED FOR CONSTRUCTION
DATE	DESCRIPTION
USE ONLY PRINTS OF LATEST DATE	

PUB. DIV. NO.	STATE	FED. AID PROJ. NO.	FISCAL YEAR	SHEET NO.	TOTAL SHEETS
1	MASS.	I-91-1(54)9		90	188

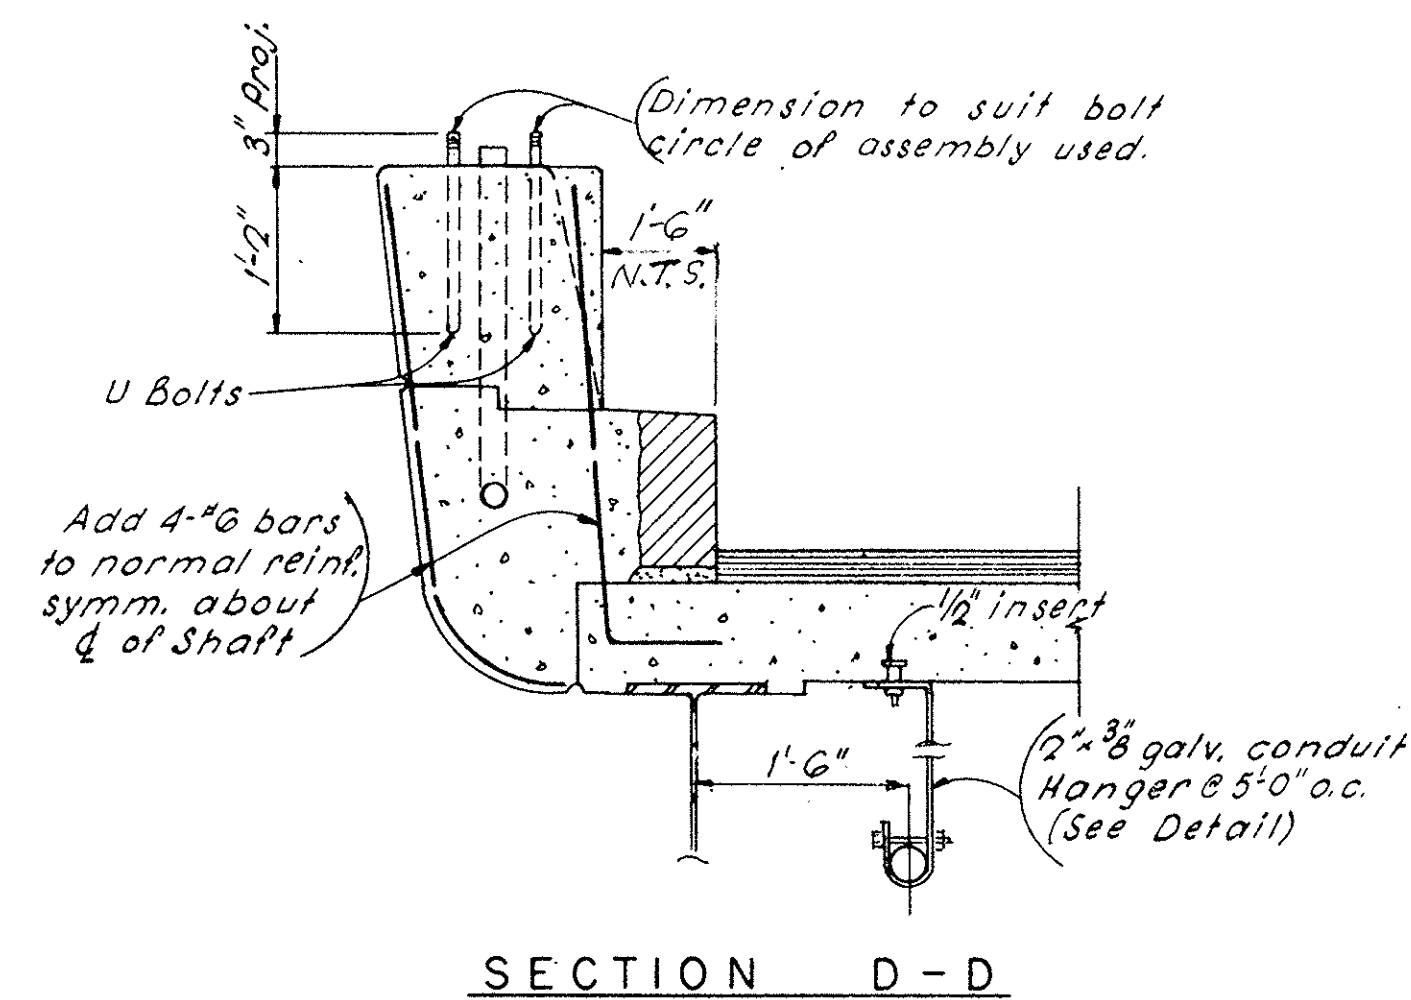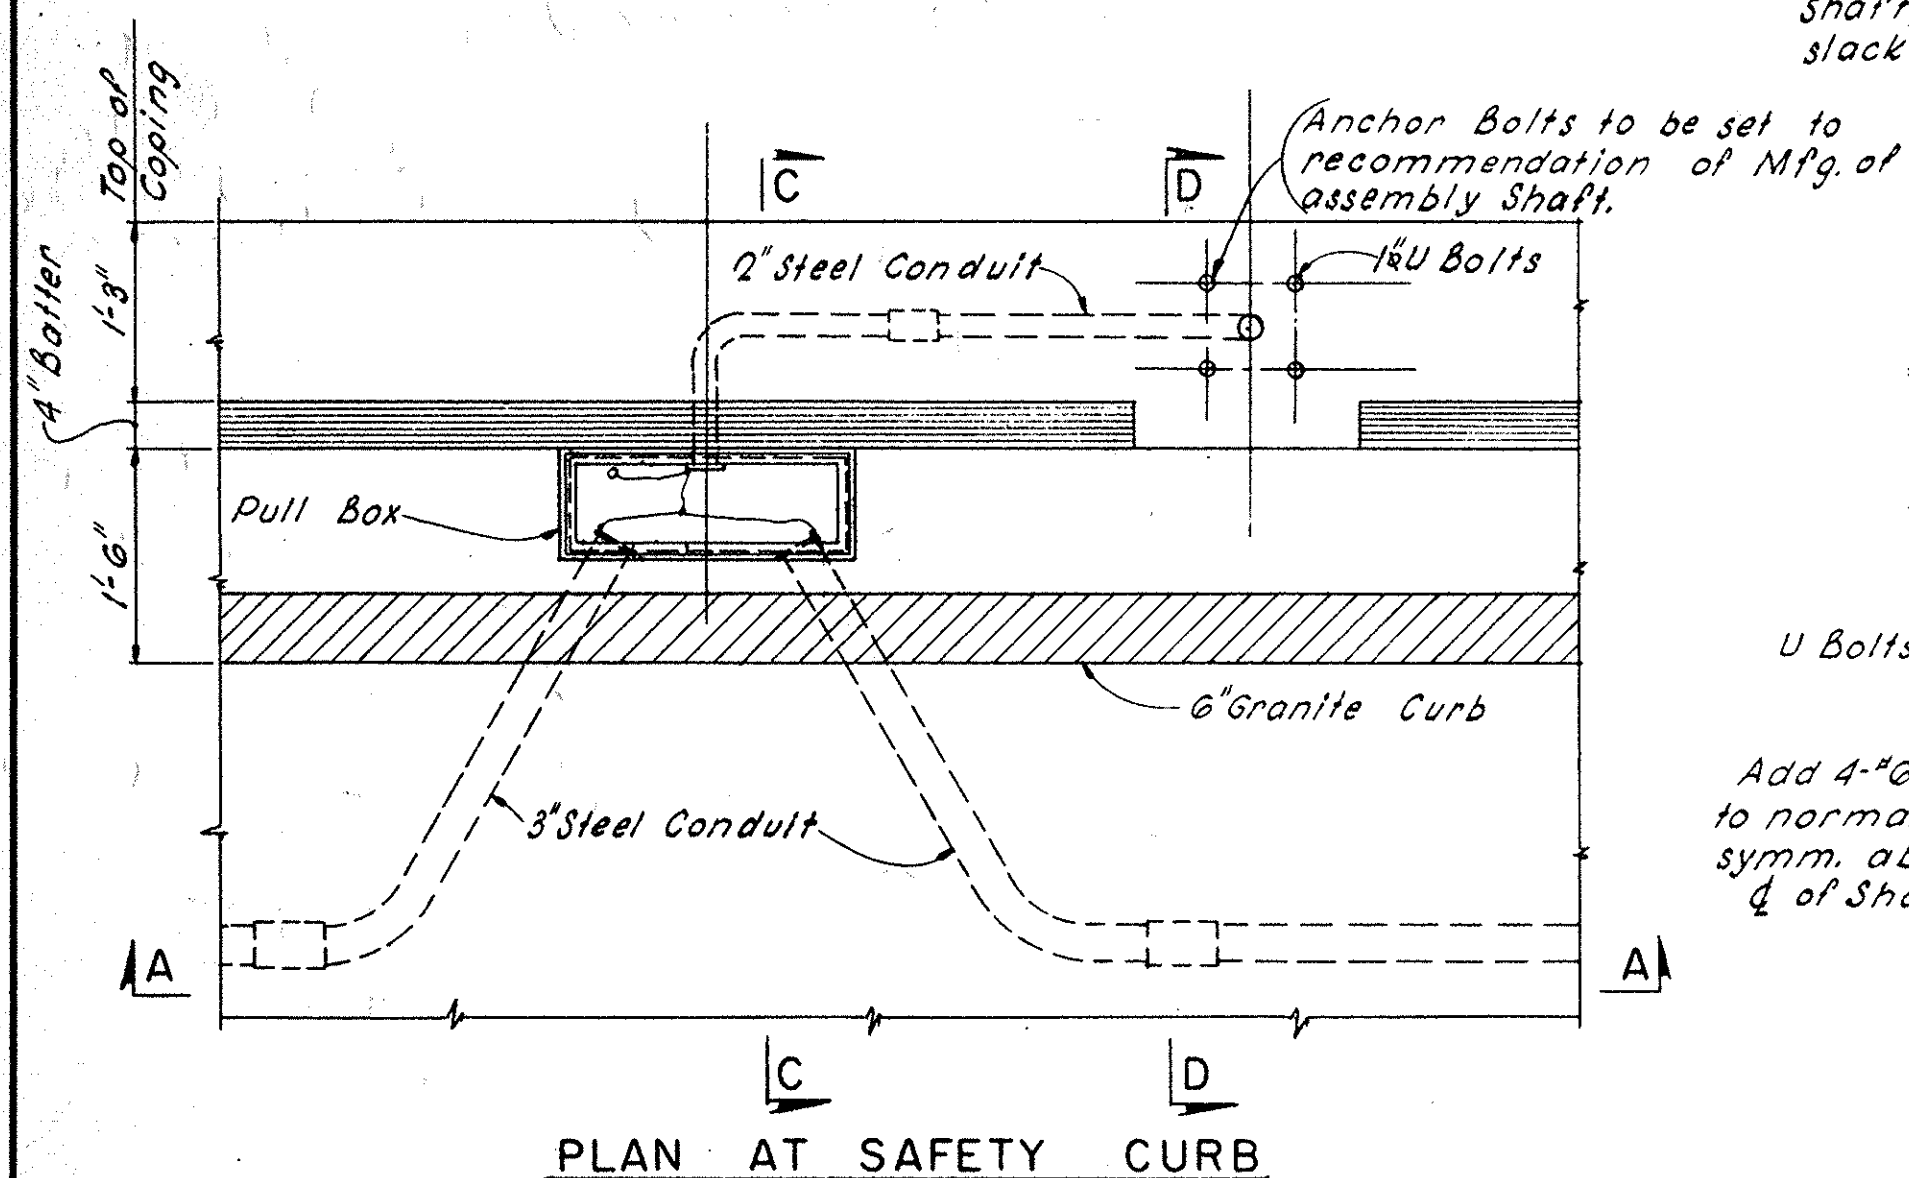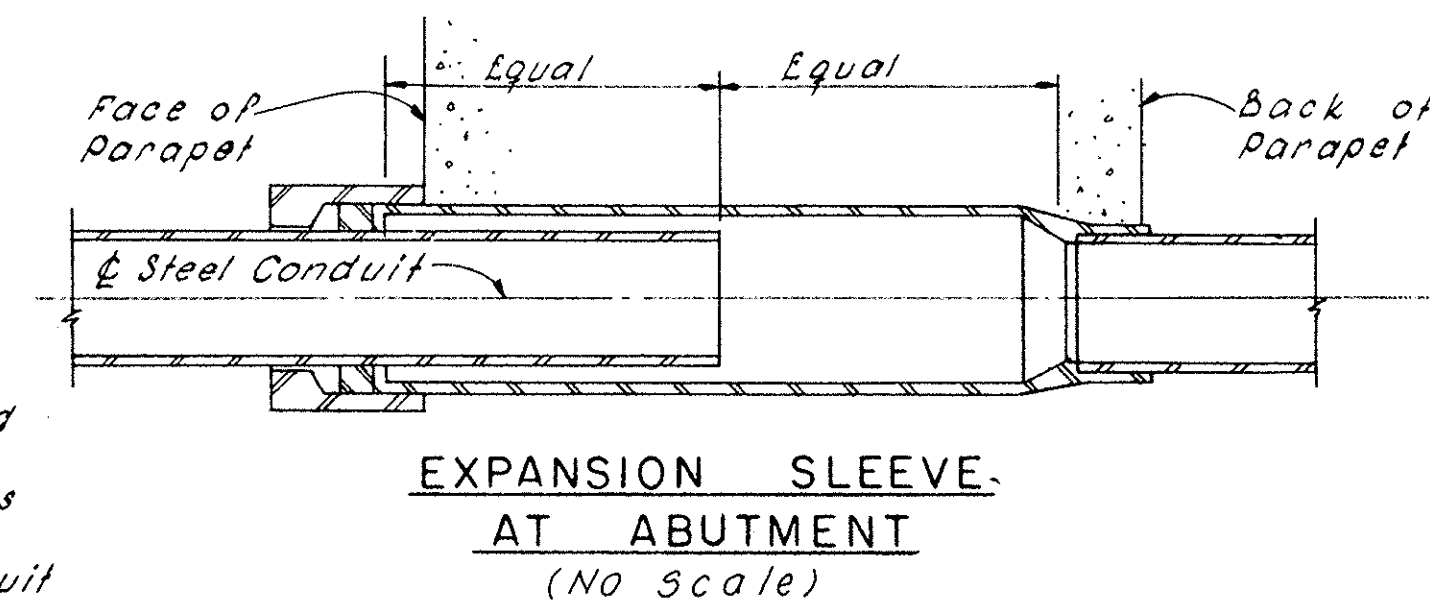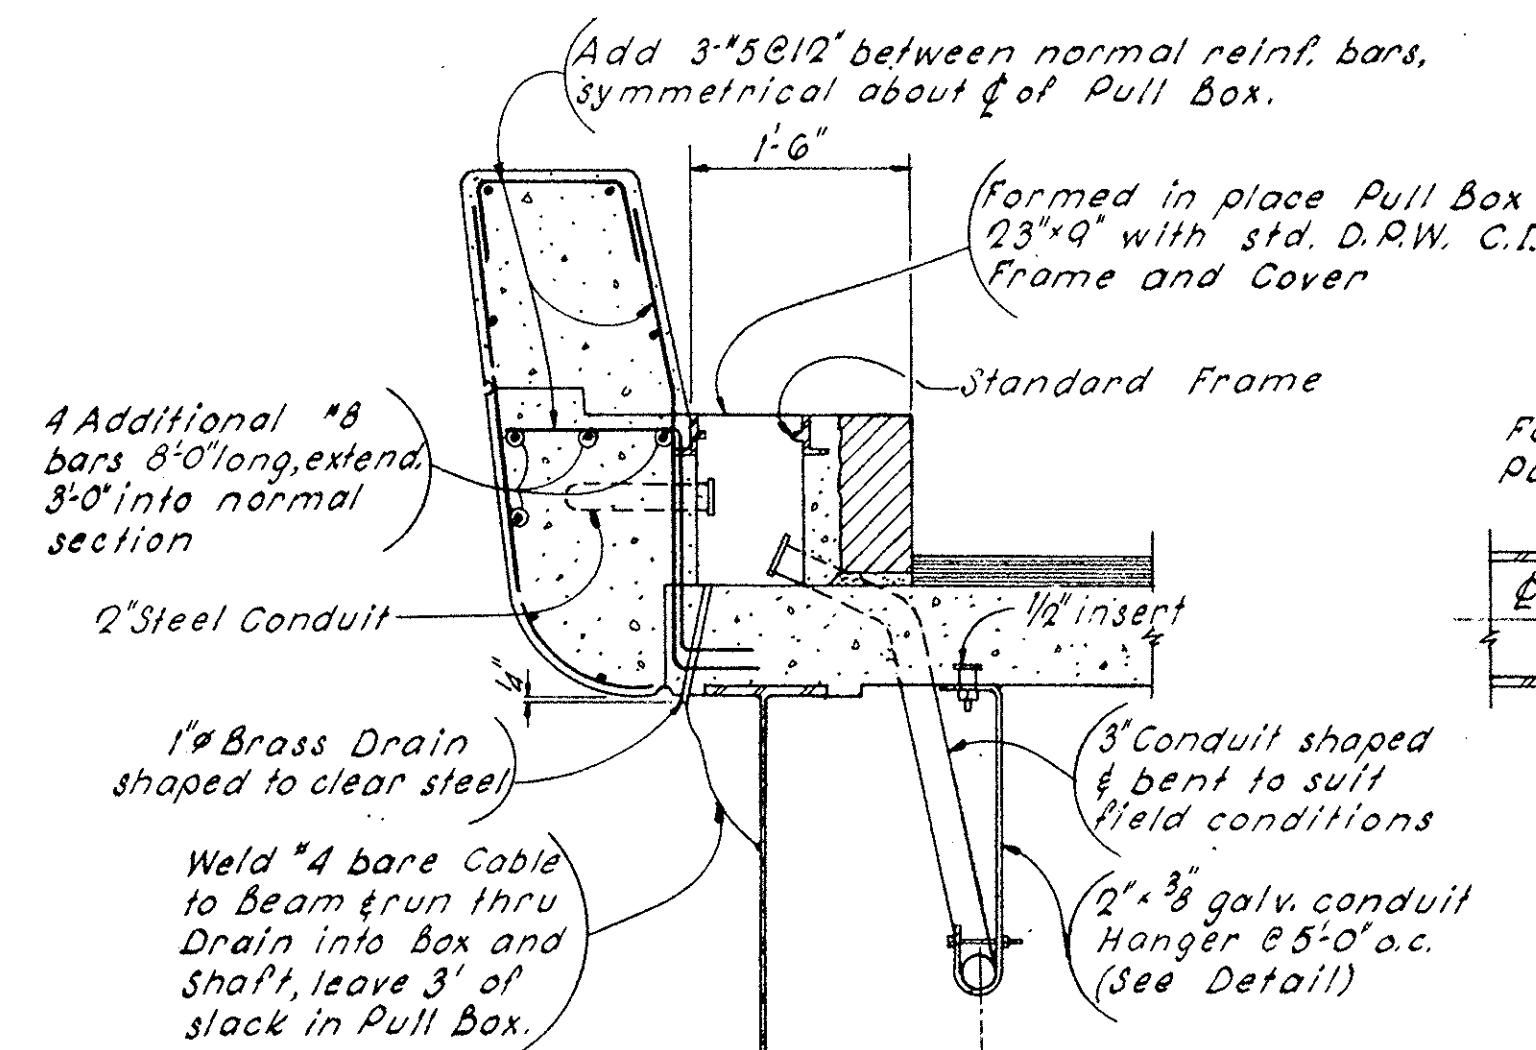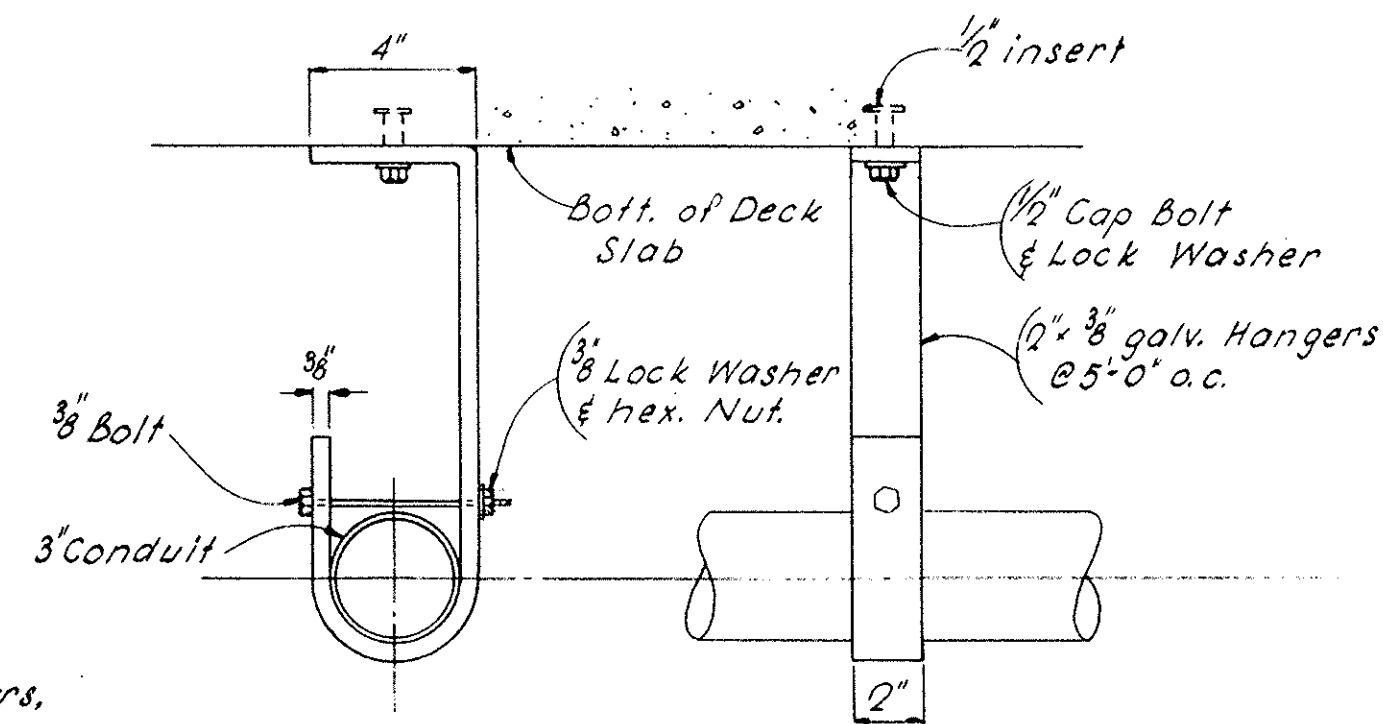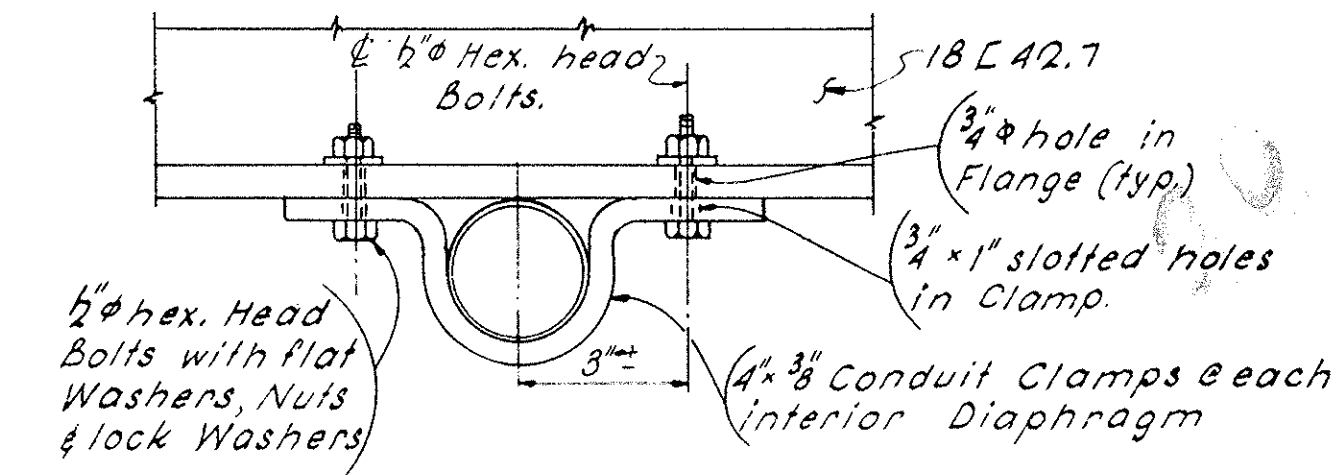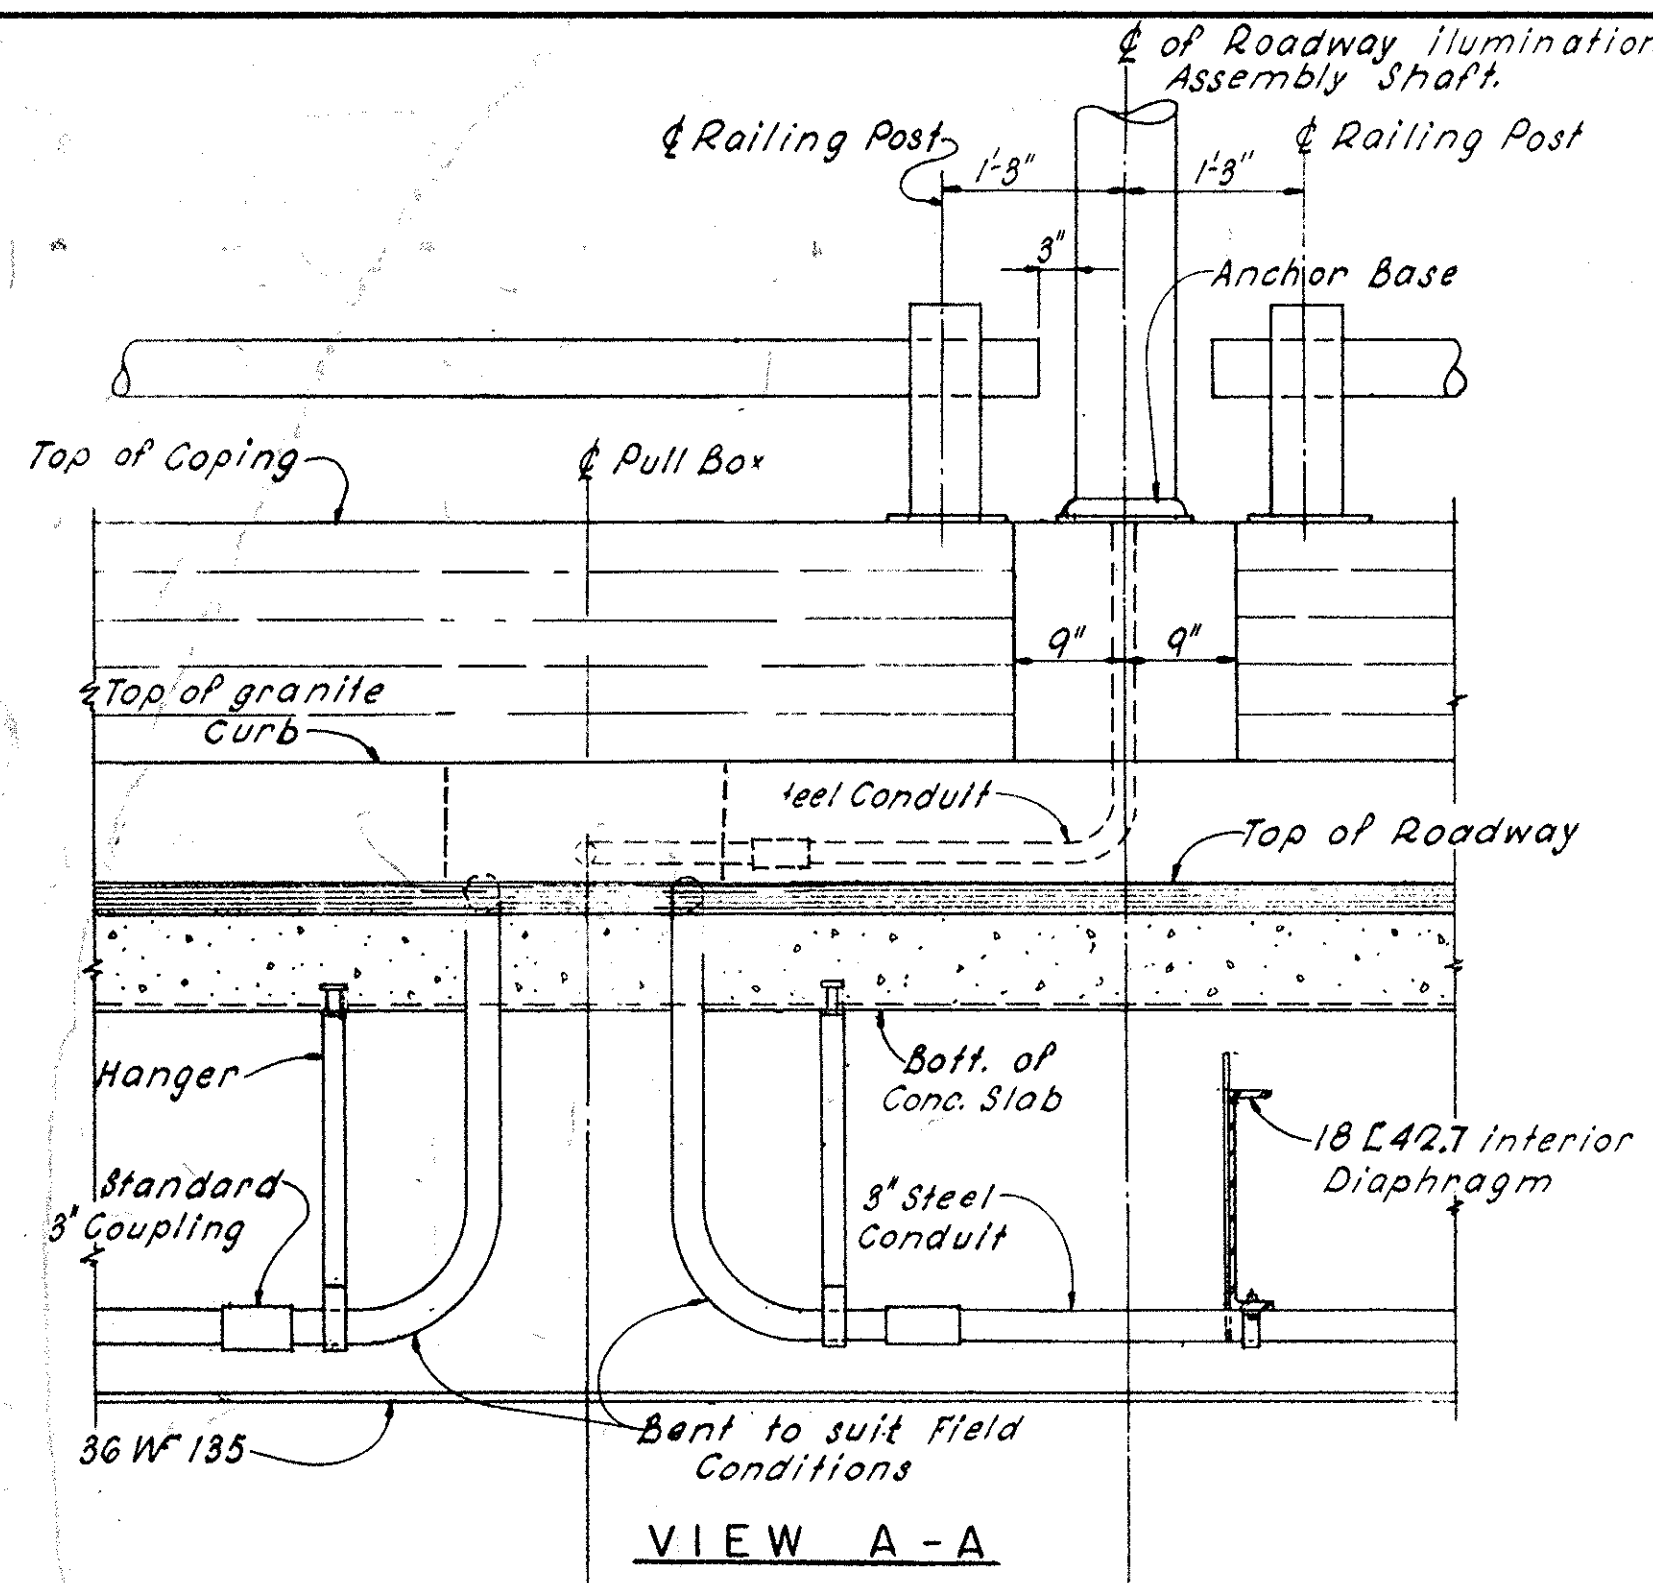

ROADWAY ILLUMINATION ASSEMBLY DETAILS


Scale: 3/4" = 1'-0" Except as noted

APRIL 9, 1966	ISSUED FOR CONSTRUCTION
DATE	DESCRIPTION
	USE ONLY PRINTS OF LATEST DATE

WEST SPRINGFIELD / CHICOPEE  
INTERSTATE 91 / ROUTE 5

STATE	FED. AID PROJ. NO.	SHEET NO.	TOTAL SHEETS
MA	NHP(NHS)-091S(305)X	37	39
PROJECT FILE NO.		608600	

BRIDGE PLAN AND ELEVATION

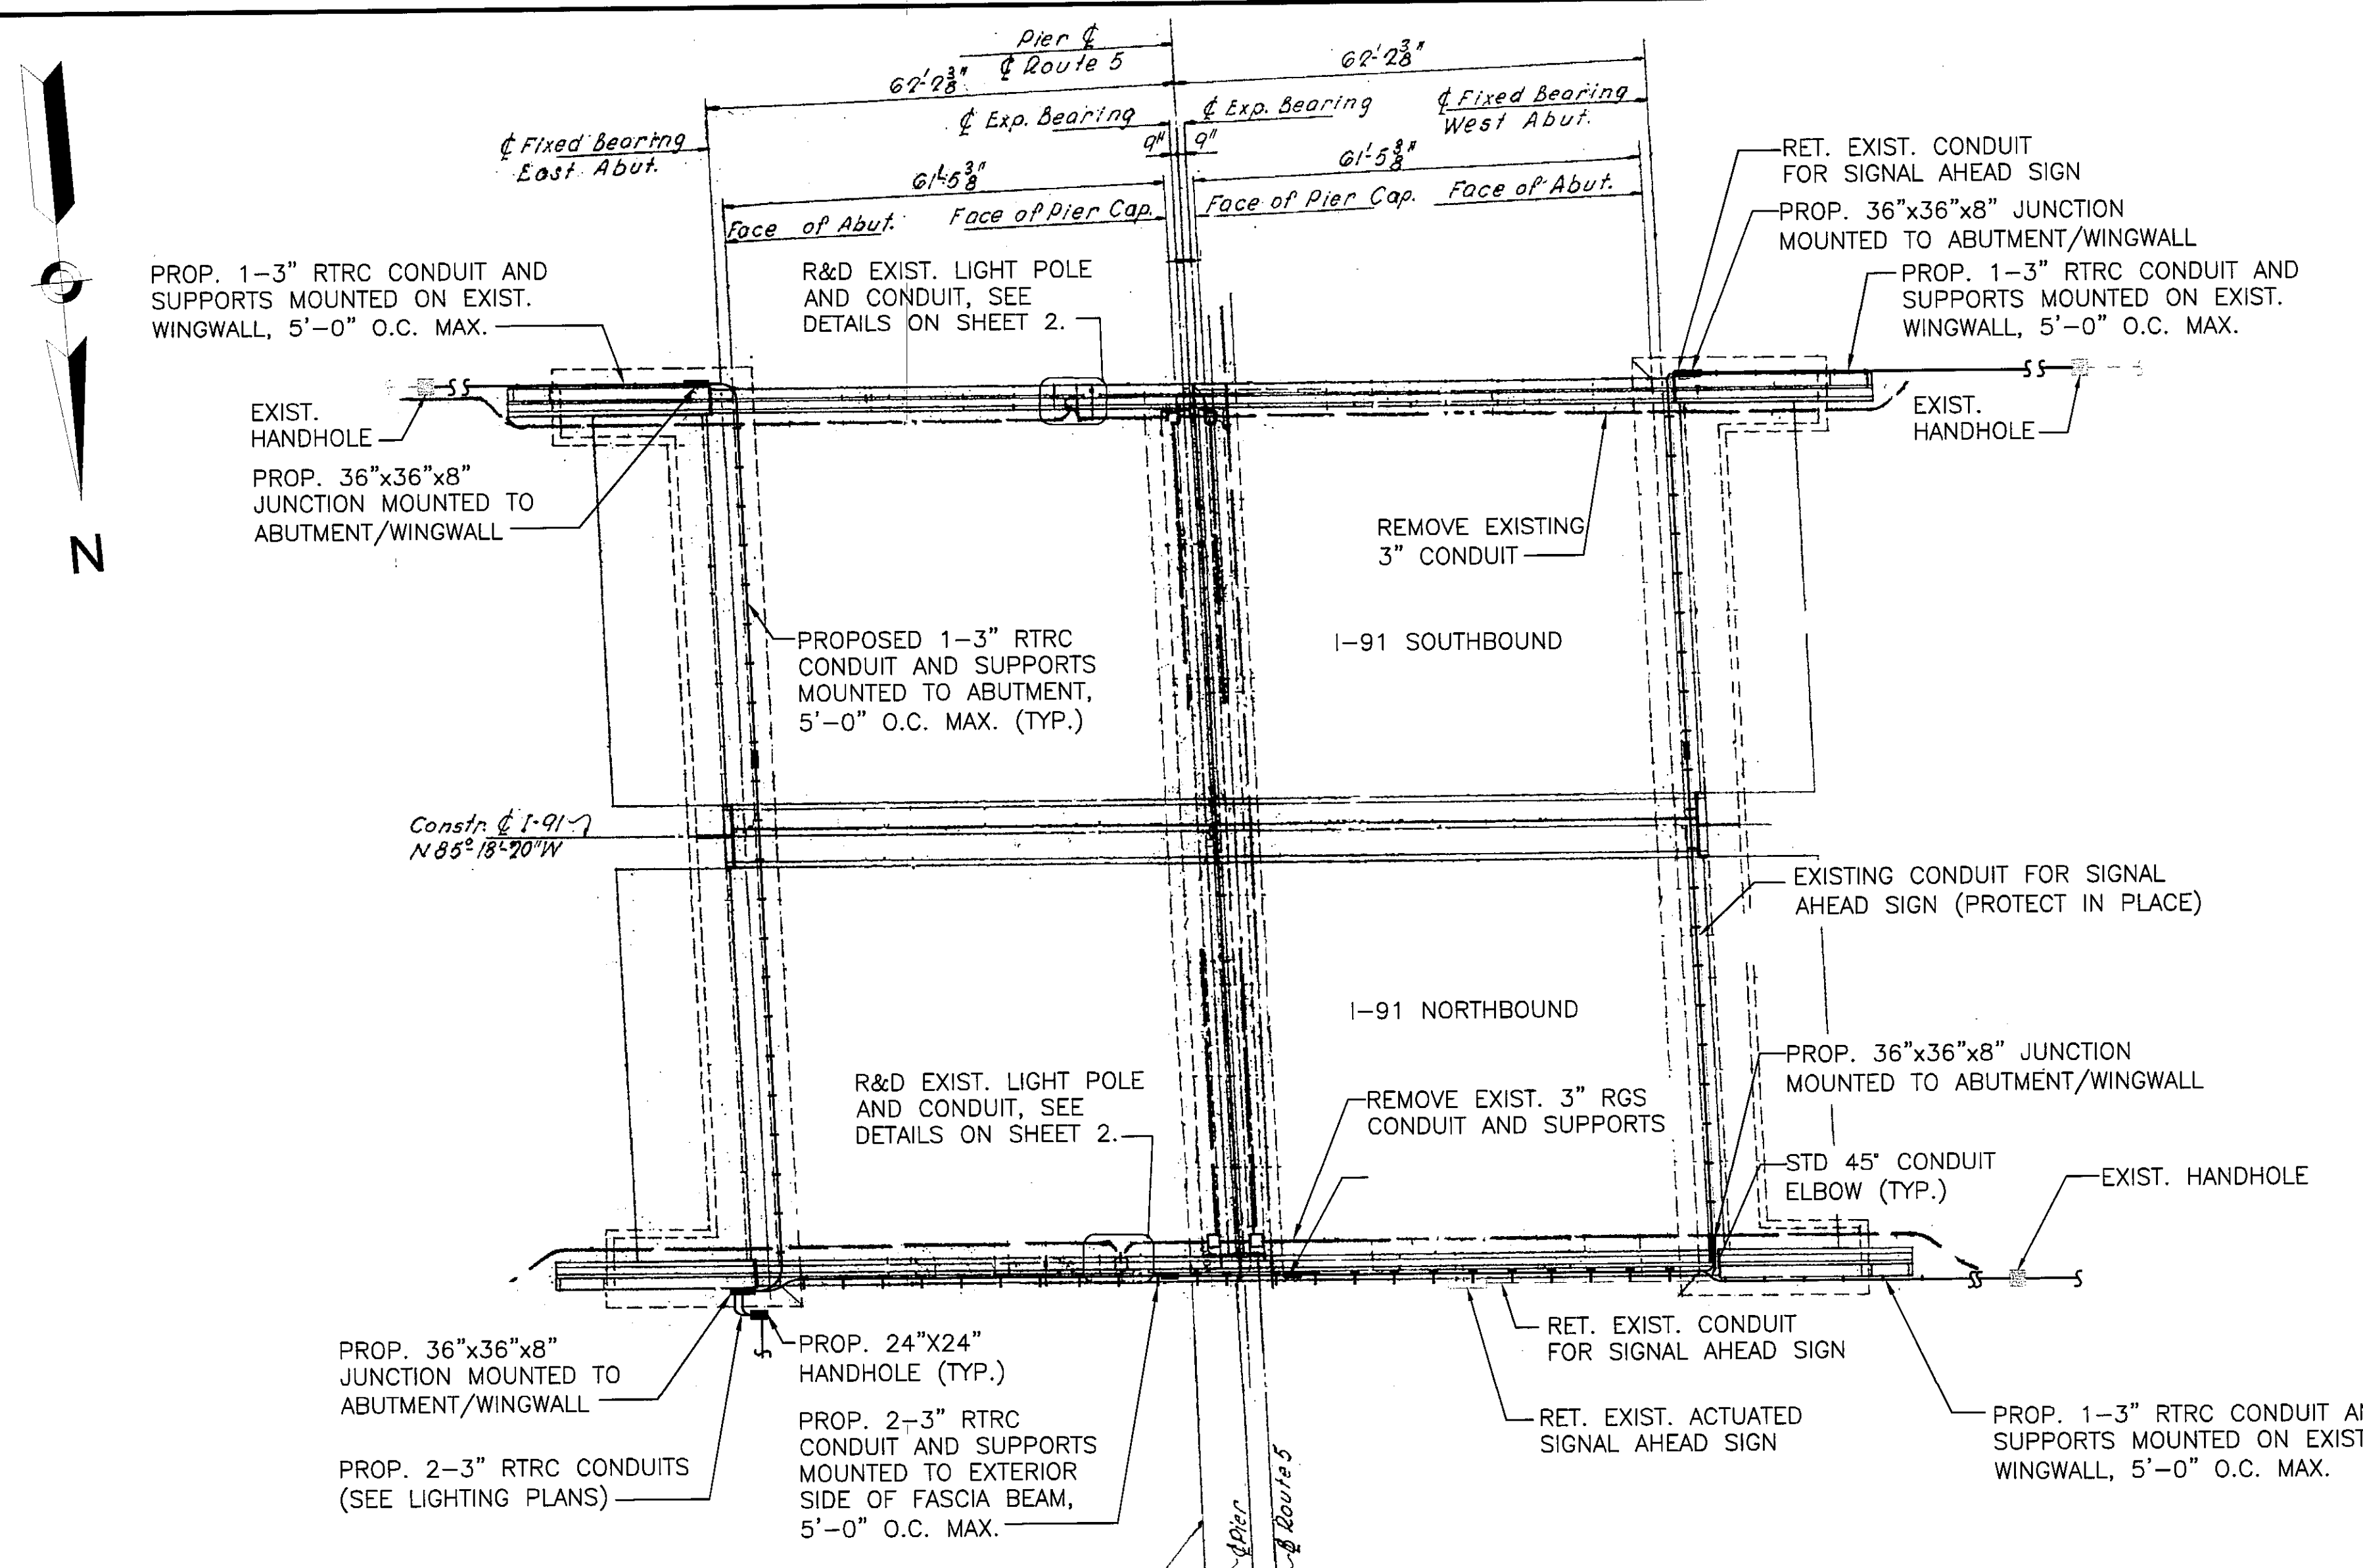

**PLAN**  
SCALE: 1/8" = 1'-0"

**ESTIMATED QUANTITIES**  
(NOT GUARANTEED)

CLEAN AND PAINT STRUCTURAL STEEL.....	30 SF
STEEL THRIE BEAM BRIDGE RAIL REMOVED AND RESET.....	40 FT
ELECTRICAL CONDUIT REMOVED AND DISPOSED.....	250 FT
3 INCH ELECTRICAL CONDUIT - RTRC.....	680 FT
JUNCTION BOX - 36X36X8 INCHES - STAINLESS STEEL.....	4 FT
WIRE TYPE 8 NO. 2 DIRECT BURIAL.....	7920 FT
HIGHWAY LIGHTING POLE AND LUMINAIRE REMOVED & DISCARDED....	2 EA
STRUCTURAL STEEL - STAINLESS STEEL.....	400 LB
METAL BRIDGE RAILING REMOVED AND RESET.....	80 FT
METAL BRIDGE RAILING (1 RAIL), ALUMINUM (TYPE AL-1).....	6 FT

**DESIGN**

CONDUIT SUPPORT DESIGN IN ACCORDANCE WITH THE AMERICAN INSTITUTE OF STEEL CONSTRUCTION (AISC) STEEL CONSTRUCTION MANUAL, 14TH EDITION. MAXIMUM SUPPORT SPACING AND MATERIALS IN ACCORDANCE WITH MASSDOT STANDARD, SUPPLEMENTAL, AND INTERIM SPECIFICATIONS.

**EXISTING BRIDGE PLANS**

PLANS FOR EXISTING BRIDGE NUMBER W-21-047 (BIN 10W) CAN BE FOUND AT THE MASSACHUSETTS DEPARTMENT OF TRANSPORTATION - HIGHWAY DIVISION, 10 PARK PLAZA, BOSTON, MASSACHUSETTS.

EXISTING PLAN, ELEVATION, BASELINE STATIONING, AND UTILITIES SHOWN WERE TAKEN FROM RECORD BRIDGE DRAWINGS. THE CONTRACTOR SHALL FIELD VERIFY ALL RELEVANT DIMENSIONING AND DETAILS PRIOR TO CONSTRUCTION OR ORDERING OF MATERIAL.

**DEMOLITION**

PRIOR TO CONSTRUCTION, THE CONTRACTOR SHALL SUBMIT TO THE ENGINEER FOR APPROVAL ALL PROPOSED CONSTRUCTION METHODS, EQUIPMENT, CONSTRUCTION SEQUENCE PLANS, AND MATERIAL TO PERFORM THE WORK.

ALL MODIFICATIONS TO PROPOSED WORK SHOWN ON THE PLANS SHALL BE SUBMITTED TO THE ENGINEER FOR REVIEW AND APPROVAL PRIOR TO COMMENCING WORK.

THE CONTRACTOR SHALL EXERCISE CAUTION TO AVOID DAMAGING EXISTING BRIDGE AND ANY COMPONENTS TO REMAIN, AND SHALL BE RESPONSIBLE FOR REPAIRING ANY DAMAGE CAUSED DURING DEMOLITION AND CONSTRUCTION.

EMPLOY TEMPORARY SHIELDING AS REQUIRED TO PROTECT SURROUNDING ROADWAY FROM FALLING OBJECTS AND CONSTRUCTION DEBRIS. DURING CONSTRUCTION THE ENGINEER MAY REVIEW SHIELDING AND DETERMINE WHETHER ADEQUATE PROTECTION HAS BEEN PROVIDED BY THE CONTRACTOR. IF DEEMED NOT ACCEPTABLE, WORK WILL BE SUSPENDED UNTIL ADEQUATE PROTECTION IS PROVIDED.

**SCALES**

SCALES NOTED ON THE PLANS ARE NOT APPLICABLE TO REDUCED SIZE PRINTS. DIVIDE SCALED BY 2 FOR HALF-SIZE PRINTS.

**TRAFFIC MANAGEMENT**

REFER TO THE TRAFFIC MANAGEMENT PLANS FOR STAGED CONSTRUCTION SEQUENCING AND PROPOSED TRAFFIC MAINTENANCE THROUGHOUT ALL STAGES OF CONSTRUCTION.

**ELECTRICAL WORK**

REFER TO THE LIGHTING PLANS FOR ADDITIONAL GENERAL NOTES REGARDING PROJECT ELECTRICAL WORK.

**EXISTING UTILITIES**

THE CONTRACTOR SHALL VERIFY THE LOCATION OF ALL EXISTING UTILITIES PRIOR TO DEMOLITION AND THE COMMENCEMENT OF EXCAVATION ACTIVITIES. THE CONTRACTOR SHALL PROTECT ALL EXISTING UTILITIES DURING CONSTRUCTION AND SHALL COORDINATE WORK WITH THE UTILITY COMPANIES PERFORMING WORK IN THE SAME AREA.

THE CONTRACTOR SHALL NOTIFY DIG-SAFE (1-888-344-7233) AT LEAST 72 BUSINESS HOURS BEFORE CONSTRUCTION BEGINS.

THE CONTRACTOR SHALL DE-ENERGIZE ALL ELECTRICAL CIRCUITS IN CONDUITS THAT ARE IN AREAS TO BE DEMOLISHED. THE CONTRACTOR SHALL ALSO VERIFY AS NEEDED THE LOCATIONS OF EXISTING REBAR AND ELECTRICAL CONDUIT TO AVOID DAMAGE DURING CONSTRUCTION.

**EXPANSION ANCHORS**

UNLESS NOTED OTHERWISE, EXPANSION ANCHORS SHALL BE 3/8" STAINLESS STEEL WITH A MINIMUM ALLOWABLE TENSILE CAPACITY OF 2 KIPS AND MINIMUM SHEAR CAPACITY OF 2.5 KIPS IN 3000 PSI CONCRETE WITH A FACTOR OF SAFETY OF 4.0 USED FOR DESIGN. THE CONTRACTOR SHALL SUBMIT PROPOSED SYSTEM TO THE ENGINEER FOR REVIEW AND APPROVAL PRIOR TO INSTALLATION.

**STRUCTURAL STEEL FOR CONDUIT SUPPORTS:**

STRUCTURAL STEEL MATERIALS SHALL MEET THE FOLLOWING REQUIREMENTS:

- ANGLES, PLATES: ASTM A276
- BOLTS: ASTM F593
- COLD-FORMED CHANNELS: ASTM A240
- NUTS: ASTM F594
- WASHERS: ASTM A240

STRUCTURAL STEEL FOR CONDUIT AND EQUIPMENT SUPPORTS AND ALL HARDWARE INCLUDING BOLTS, NUTS, AND WASHERS SHALL BE TYPE 316 STAINLESS STEEL UNLESS NOTED OTHERWISE.

SHOP CONNECTIONS SHALL BE WELDED, UNLESS NOTED OTHERWISE.

ALL WELDING SHALL BE PERFORMED BY CERTIFIED WELDERS APPROVED BY THE STATE OF MASSACHUSETTS AND SHALL CONFORM TO THE LATEST EDITION OF THE AWS STRUCTURAL WELDING CODES INCLUDING AWS D1.1 (STEEL) AND AWS D1.6 (STAINLESS STEEL).


NO FIELD WELDING SHALL BE PERMITTED, UNLESS NOTED OTHERWISE ON THE PLANS.

INSULATING NEOPRENE WASHERS AND BUSHINGS SHALL BE PROVIDED IN BOLTED CONNECTIONS MADE BETWEEN STAINLESS STEEL COMPONENTS AND DISSIMILAR MATERIALS.

ALL U-BOLT NUTS FOR CONDUIT SUPPORT CONNECTION SHALL BE NYLOCK TYPE AND HAND TIGHTENED.

**LEGEND:**

- LIMITS OF DEMOLITION

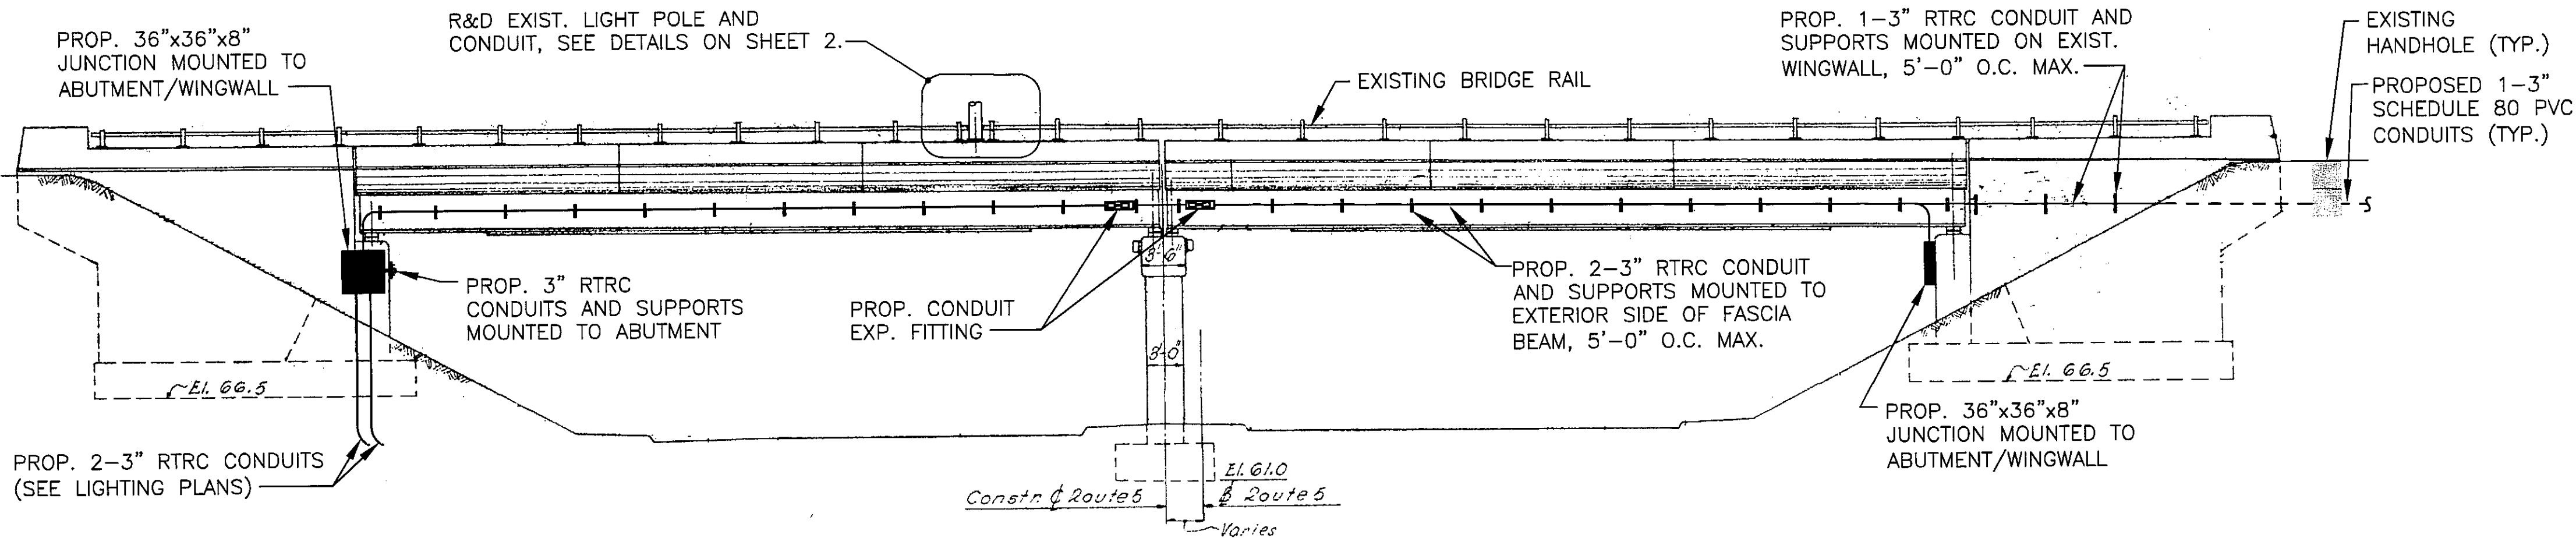

**NORTH ELEVATION**  
SCALE: 1/8" = 1'-0"

**JACOBS**  
100 ST. JAMES AVENUE  
8TH FLOOR  
BOSTON, MA 02116

DEC. 8, 2018 ISSUED FOR CONSTRUCTION

**massDOT**  
Massachusetts Department of Transportation  
Highway Division

**PROPOSED BRIDGE REHABILITATION  
WEST SPRINGFIELD**

INTERSTATE 91  
OVER ROUTE 5


MASSACHUSETTS DEPARTMENT OF TRANSPORTATION  
HIGHWAY DIVISION  
10 PARK PLAZA BOSTON, MASS

*Thomas A. D. Palop*  
TITLE: Chief Engineer


37\_608600\_BR1(W21047).DWG 4-Feb-2019

STATE	FED. AID PROJ. NO.	SHEET NO.	TOTAL SHEETS
MA	NHP(NHS)-091S(305)X	38	39
PROJECT FILE NO.		608600	

**LIGHT SUPPORT DETAILS**

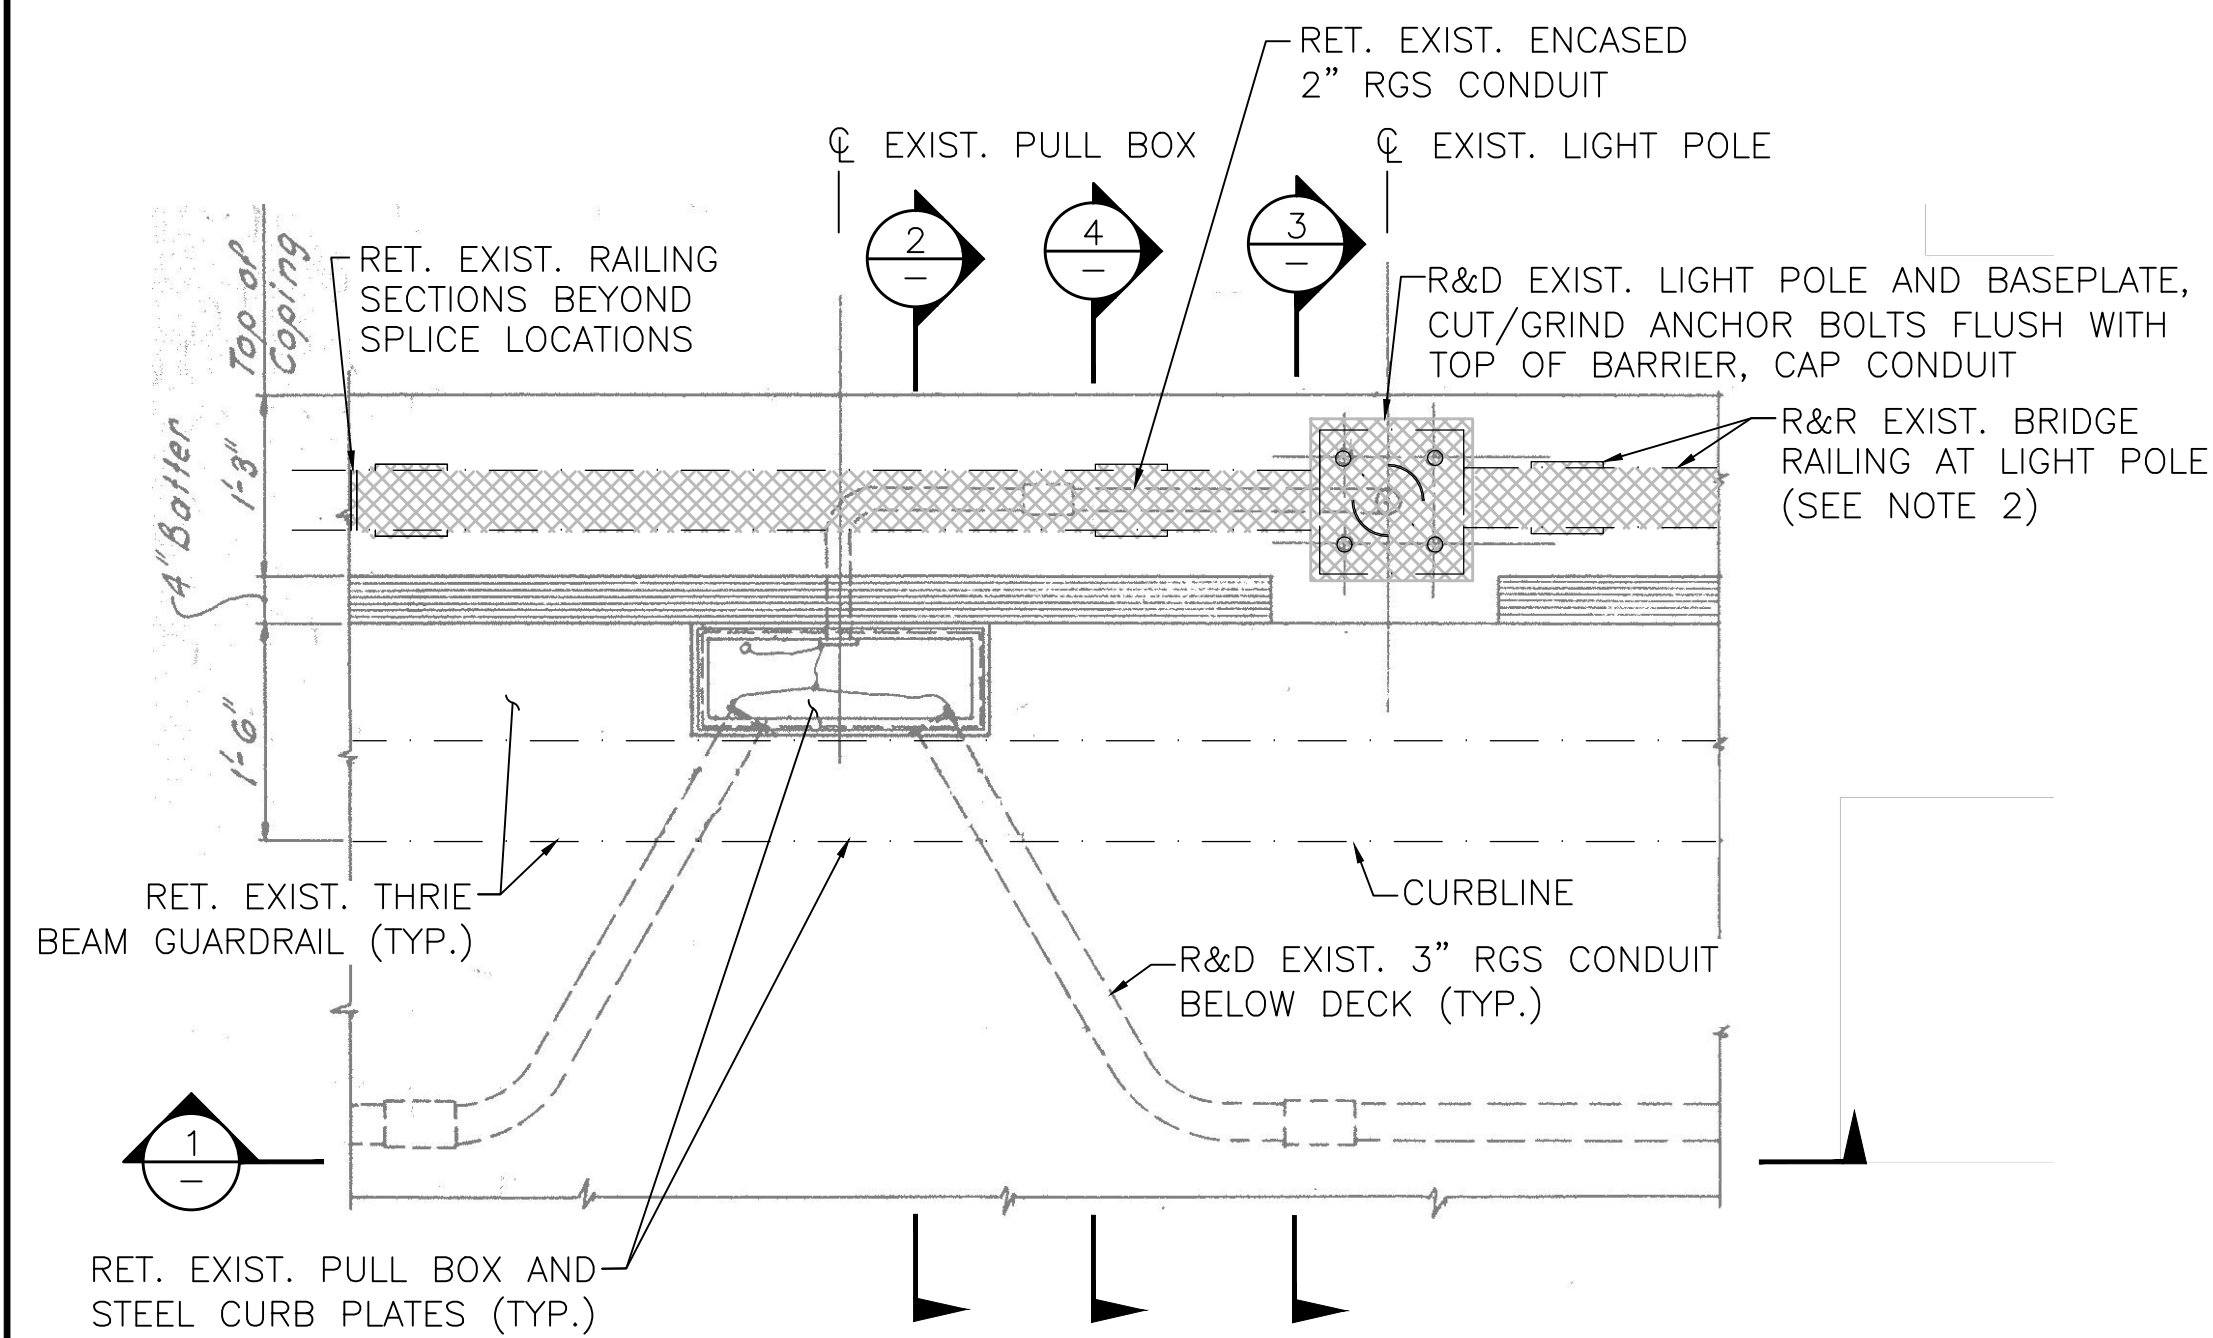

**PARTIAL PLAN AT EXISTING LIGHT POLE**  
SCALE: 3/4" = 1'-0"

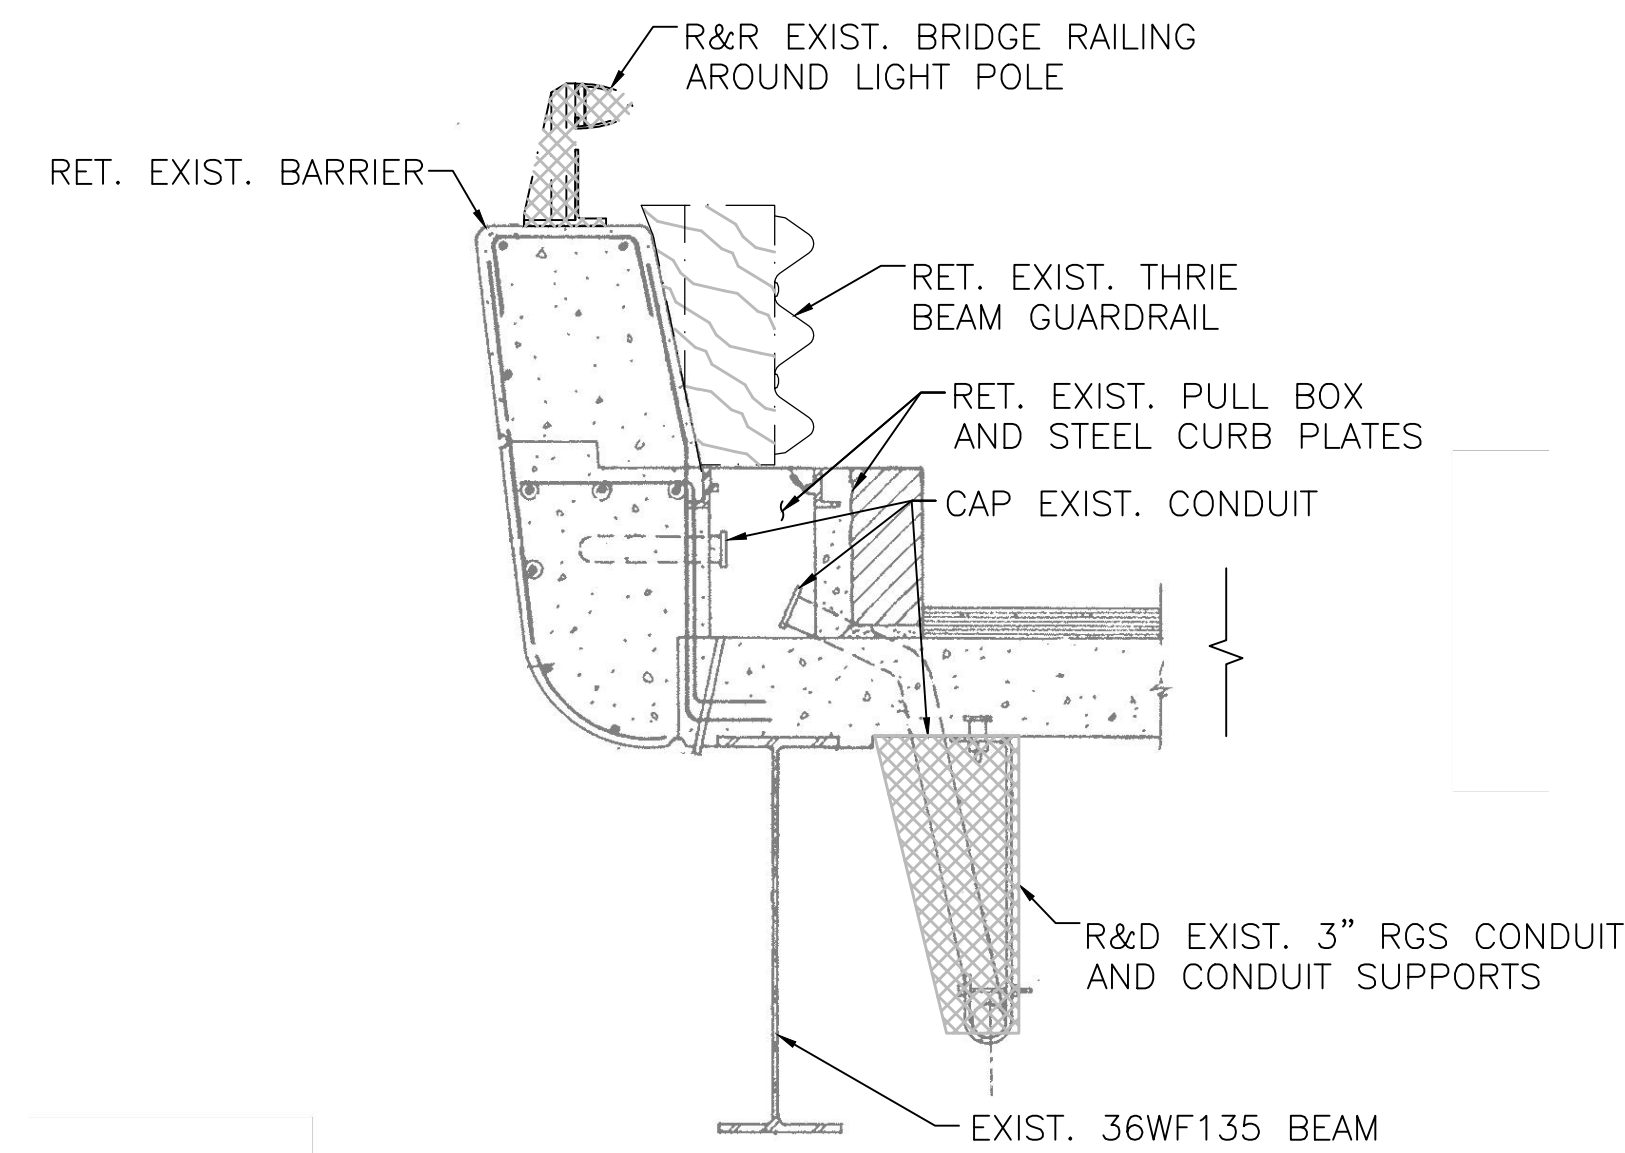


**SECTION THROUGH EXISTING PULLBOX** (2)  
SCALE: 3/4" = 1'-0"

**NOTES:**

1. FOR GENERAL NOTES, SEE SHEET 1 OF 3.
2. PROPOSED BRIDGE RAILING SHALL BE REINSTALLED CONTINUOUS AT AREAS OF EXISTING LIGHT POLE REMOVAL. CONTRACTOR SHALL FIELD VERIFY RAILING SECTION LENGTHS, SPLICE LOCATIONS, AND POST LOCATIONS TO DETERMINE WHAT COMPONENTS AND LOCATIONS CAN BE REUSED. SHOP DRAWINGS SHALL BE SUBMITTED TO THE ENGINEER FOR APPROVAL OF MATERIALS AND PROPOSED LAYOUT PRIOR TO RAILING REINSTALLATION.


**LEGEND:**

LIMITS OF DEMOLITION

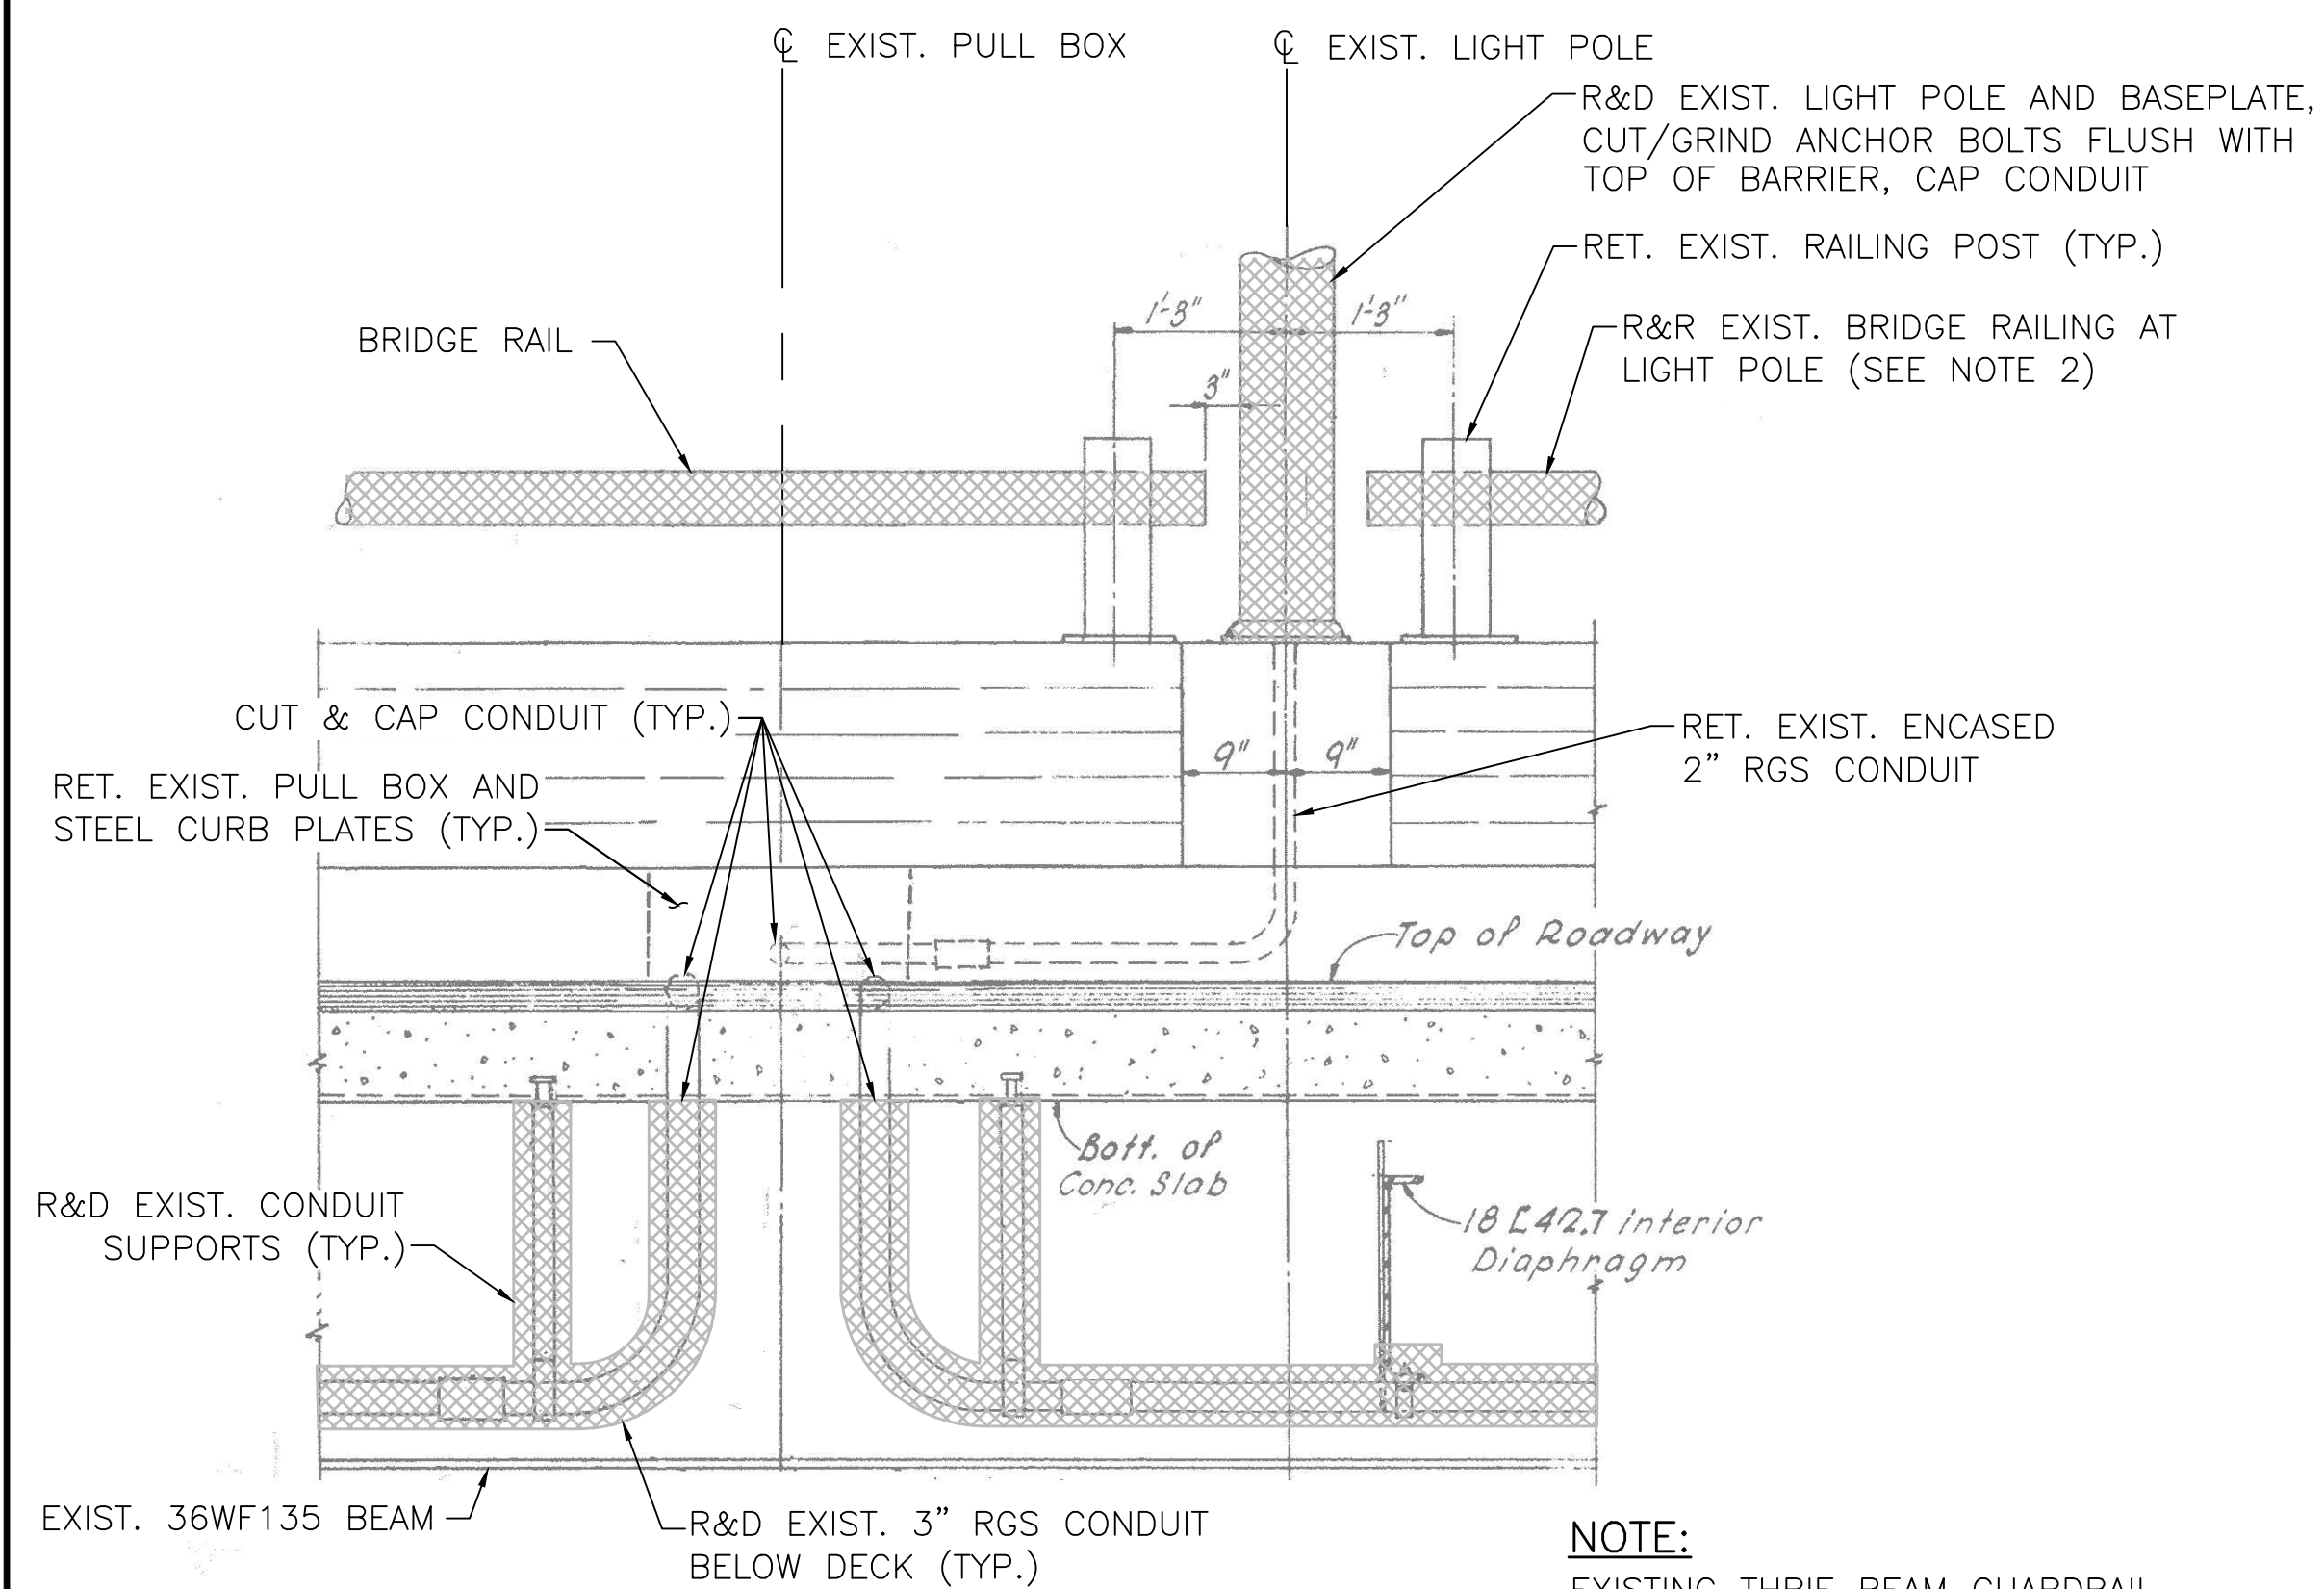


**SECTION AT EXISTING LIGHT POLE** (1)  
SCALE: 3/4" = 1'-0"

**NOTE:**  
EXISTING THRIE BEAM GUARDRAIL NOT SHOWN FOR CLARITY.

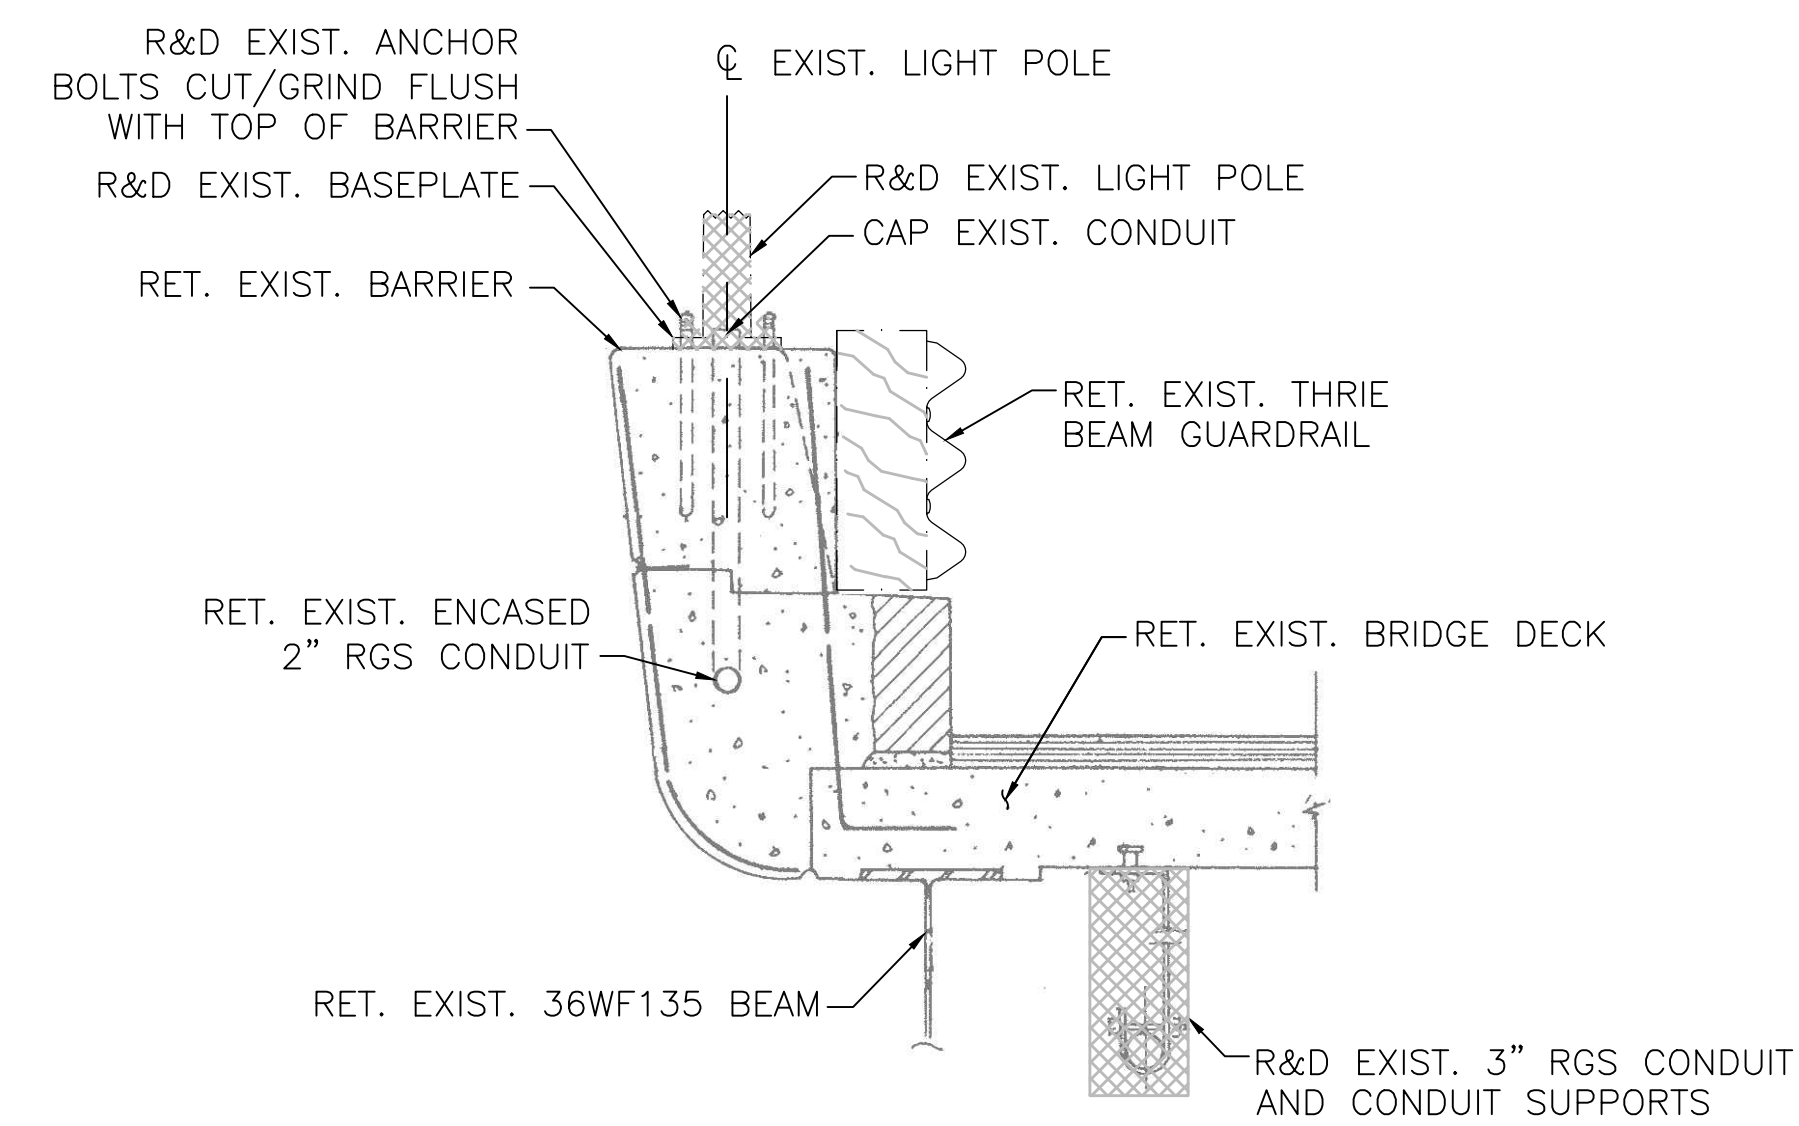

**SECTION THROUGH EXISTING LIGHT POLE BASE** (3)  
SCALE: 3/4" = 1'-0"

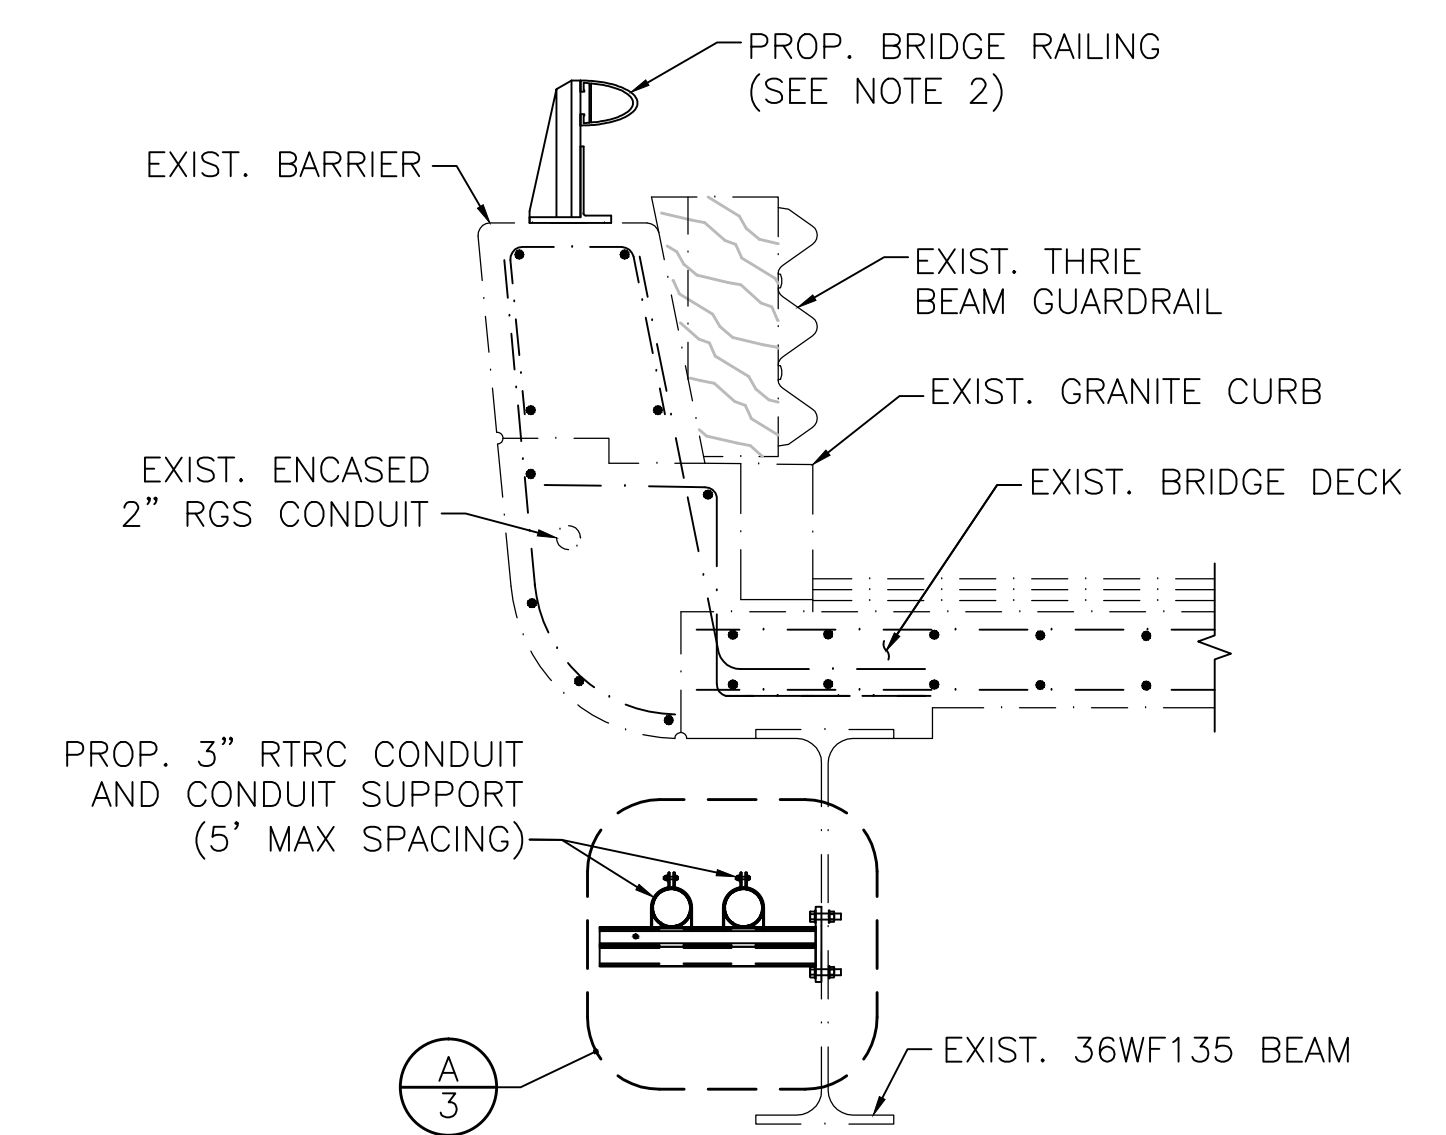

**PROPOSED SECTION** (4)  
SCALE: 3/4" = 1'-0"


DEC. 8, 2018	ISSUED FOR CONSTRUCTION
DATE	DESCRIPTION
USE ONLY PRINTS OF LATEST DATE	

STATE	FED. AID PROJ. NO.	SHEET NO.	TOTAL SHEETS
MA	NHP(NHS)-091S(305)X	39	39
PROJECT FILE NO.		608600	


PROPOSED CONDUIT SUPPORT DETAILS

NOTE:


- FOR GENERAL NOTES, SEE SHEET 1 OF 3.

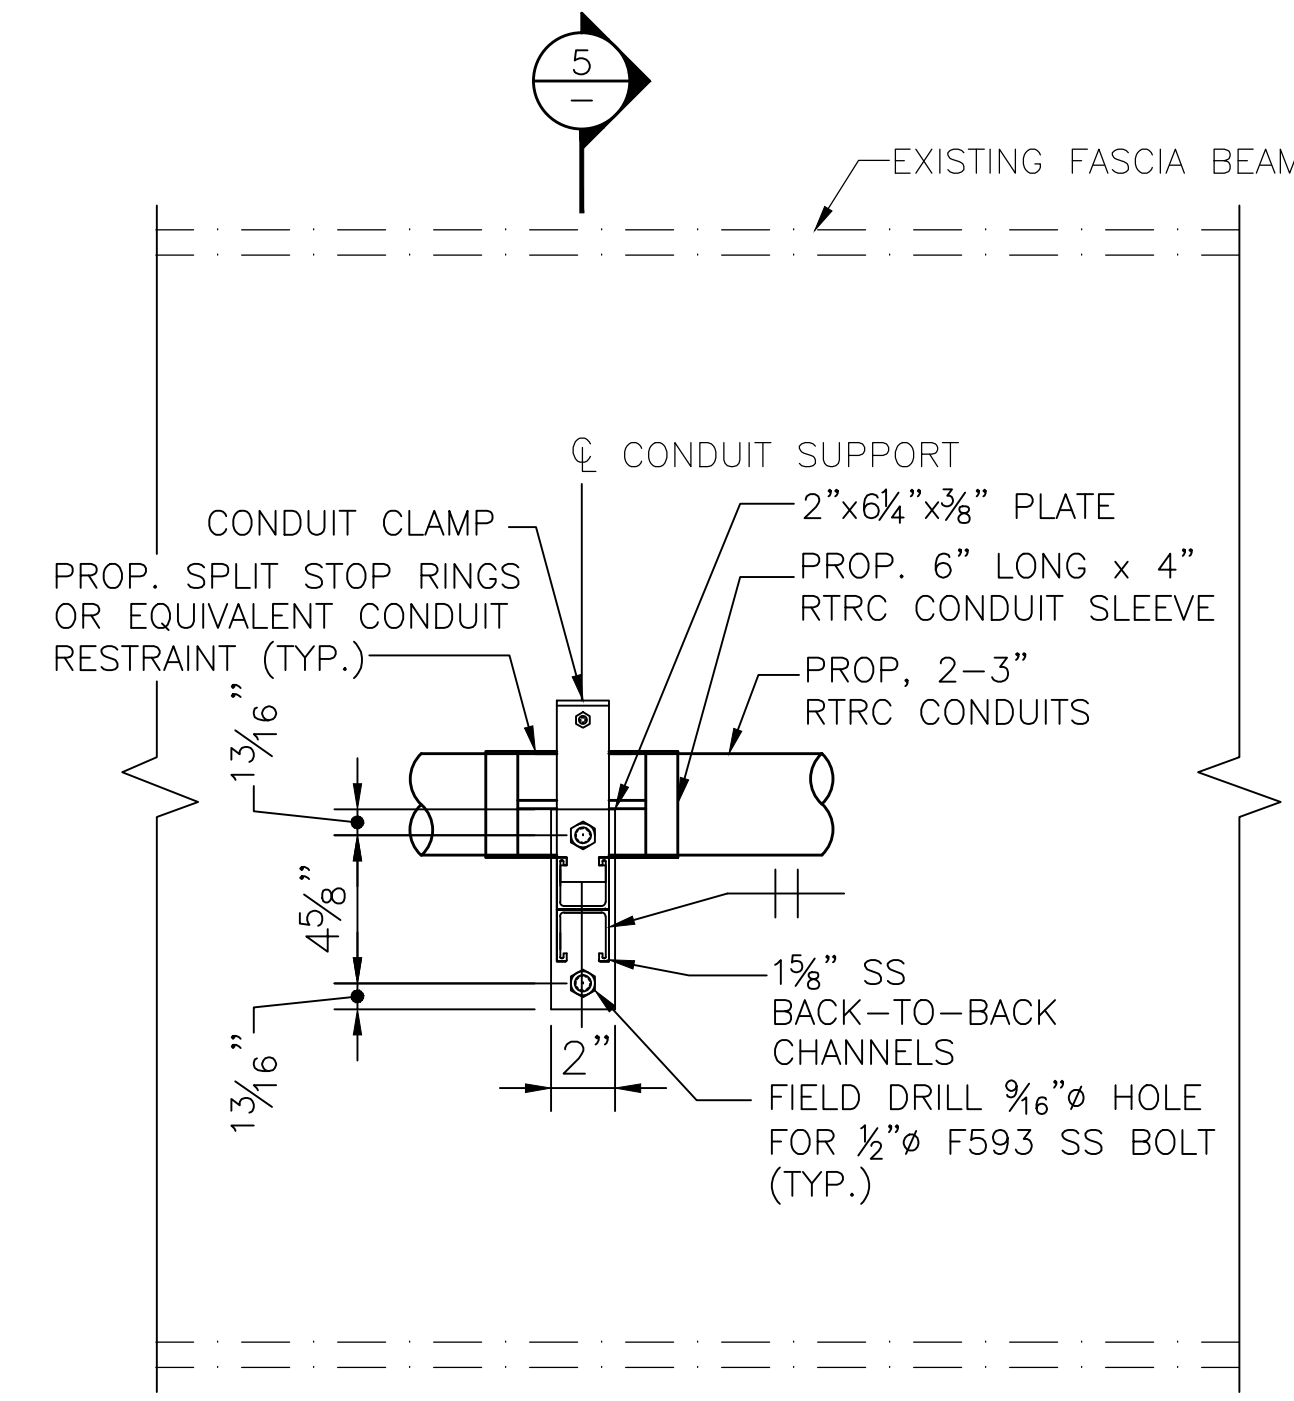


BRIDGE CONDUIT SUPPORT DETAIL  
NTS

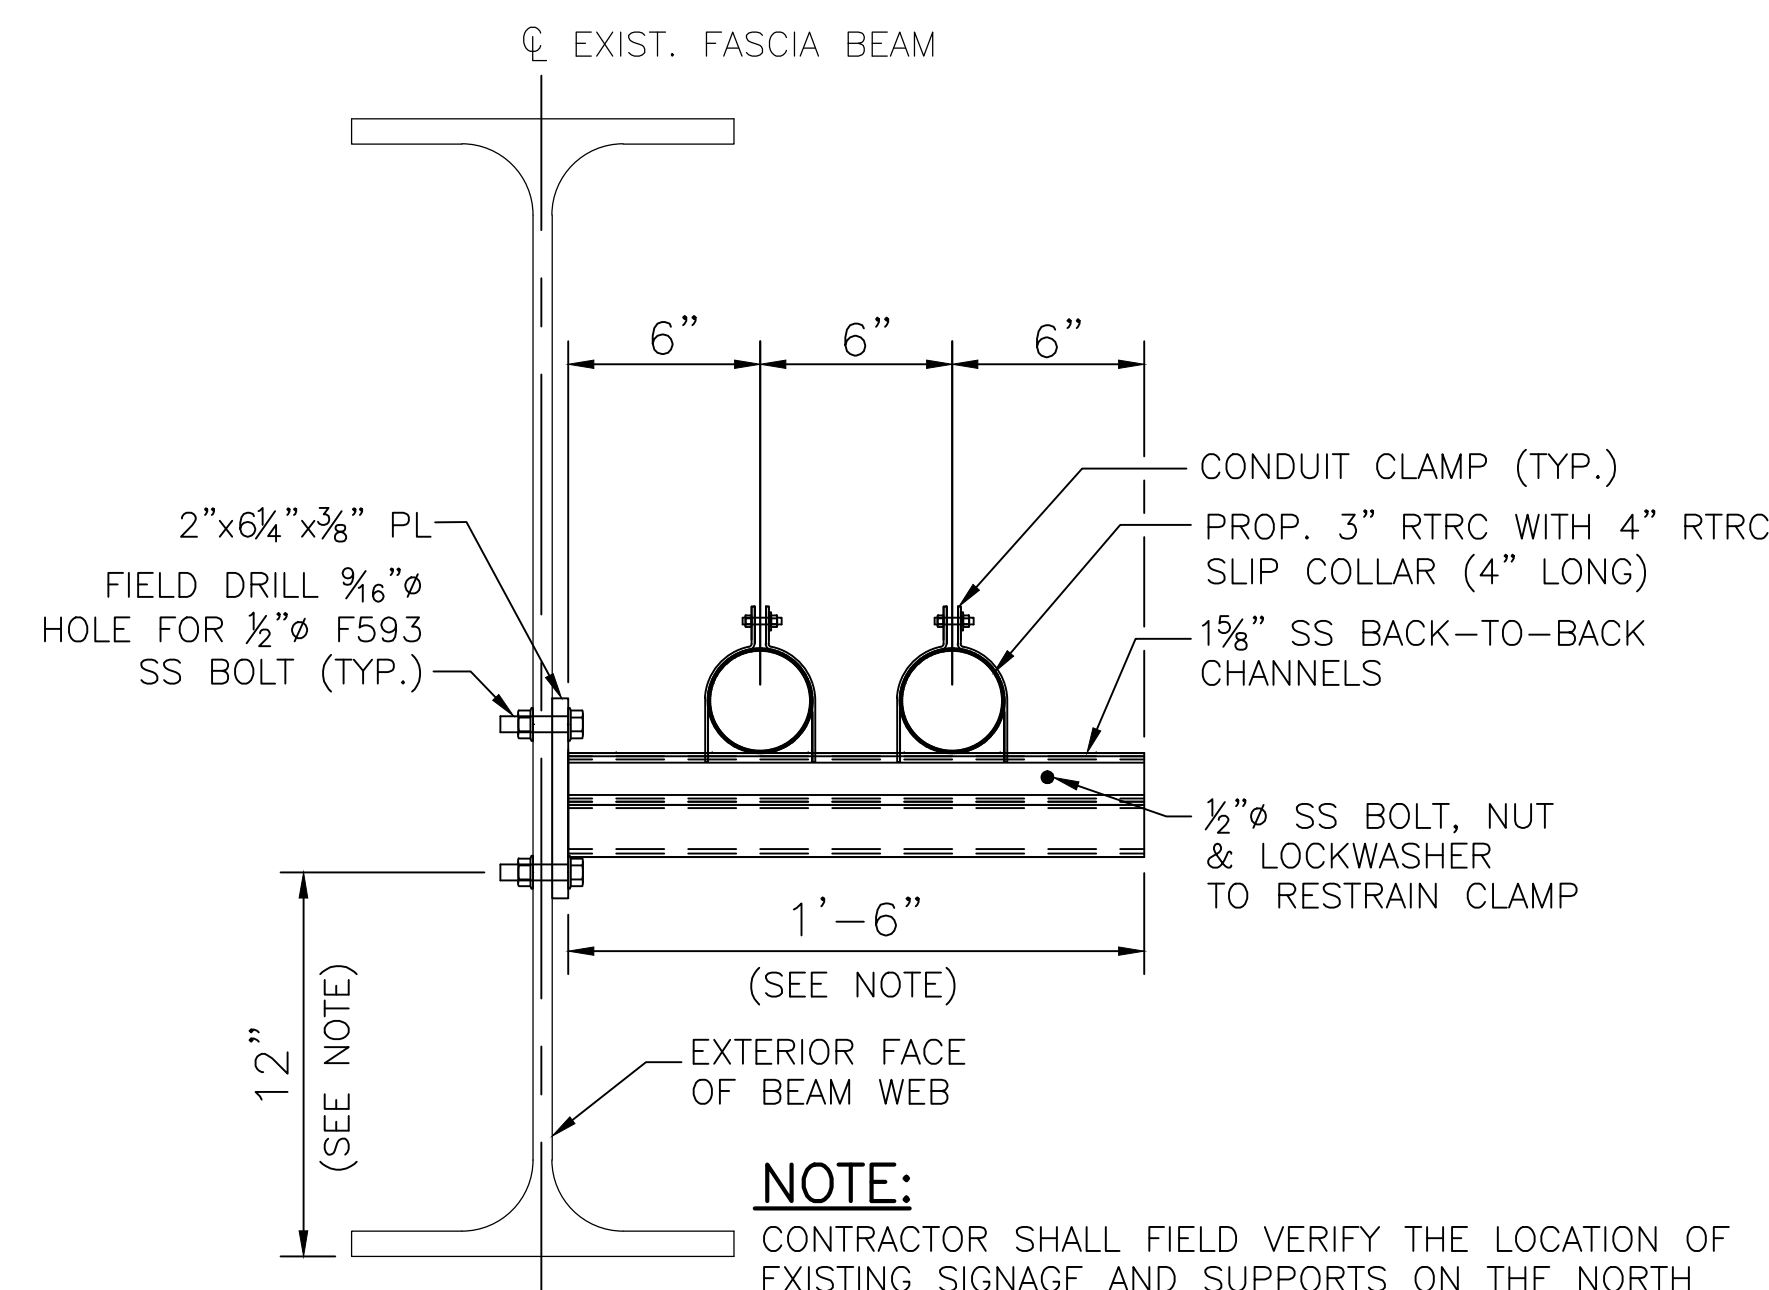

SECTION 5-1  
NTS

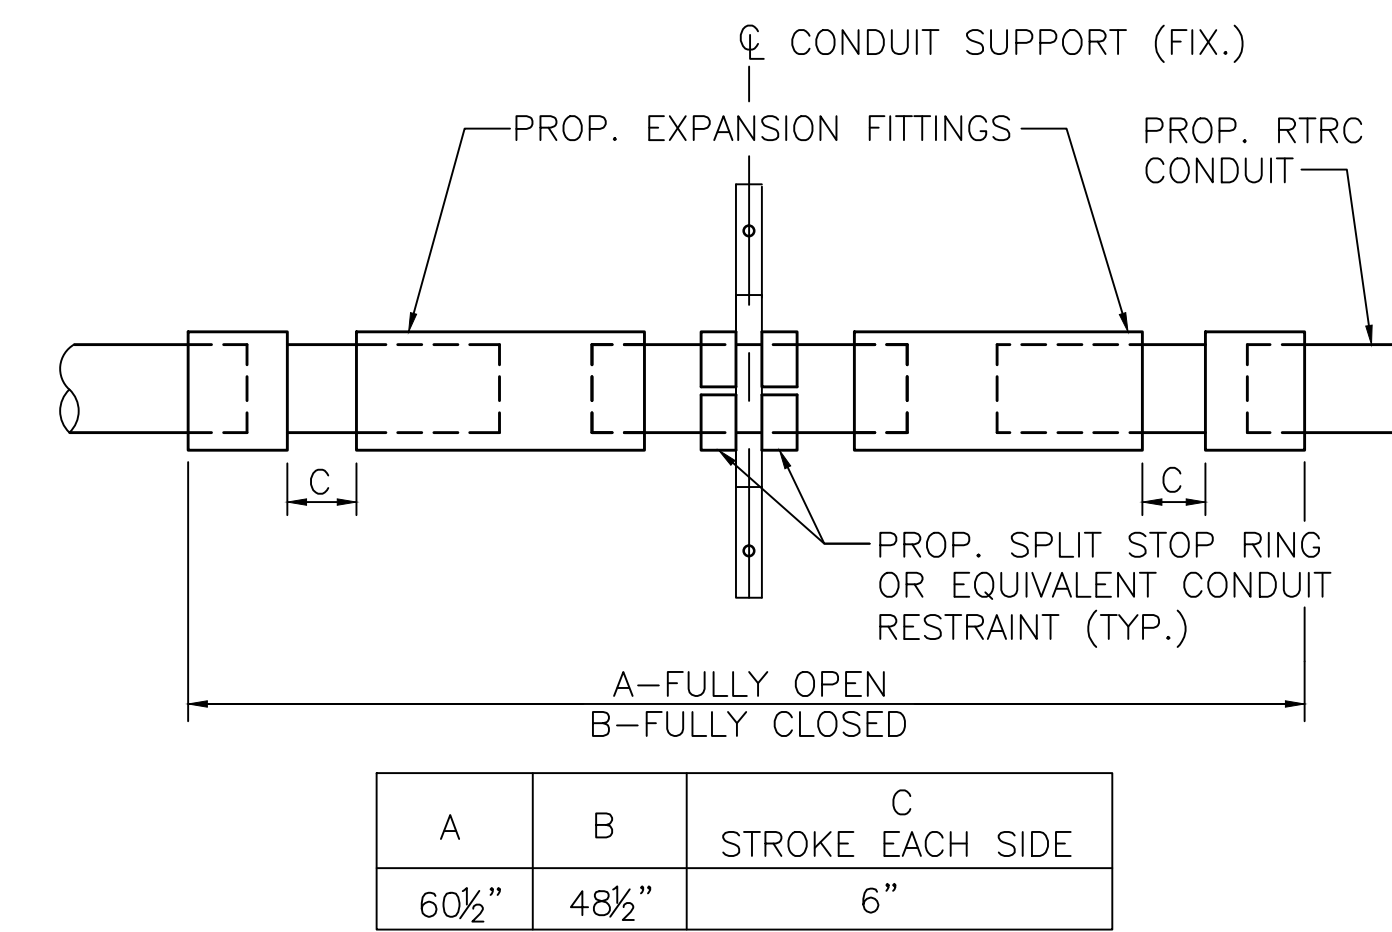


CONDUIT EXPANSION JOINT ASSEMBLY  
NTS

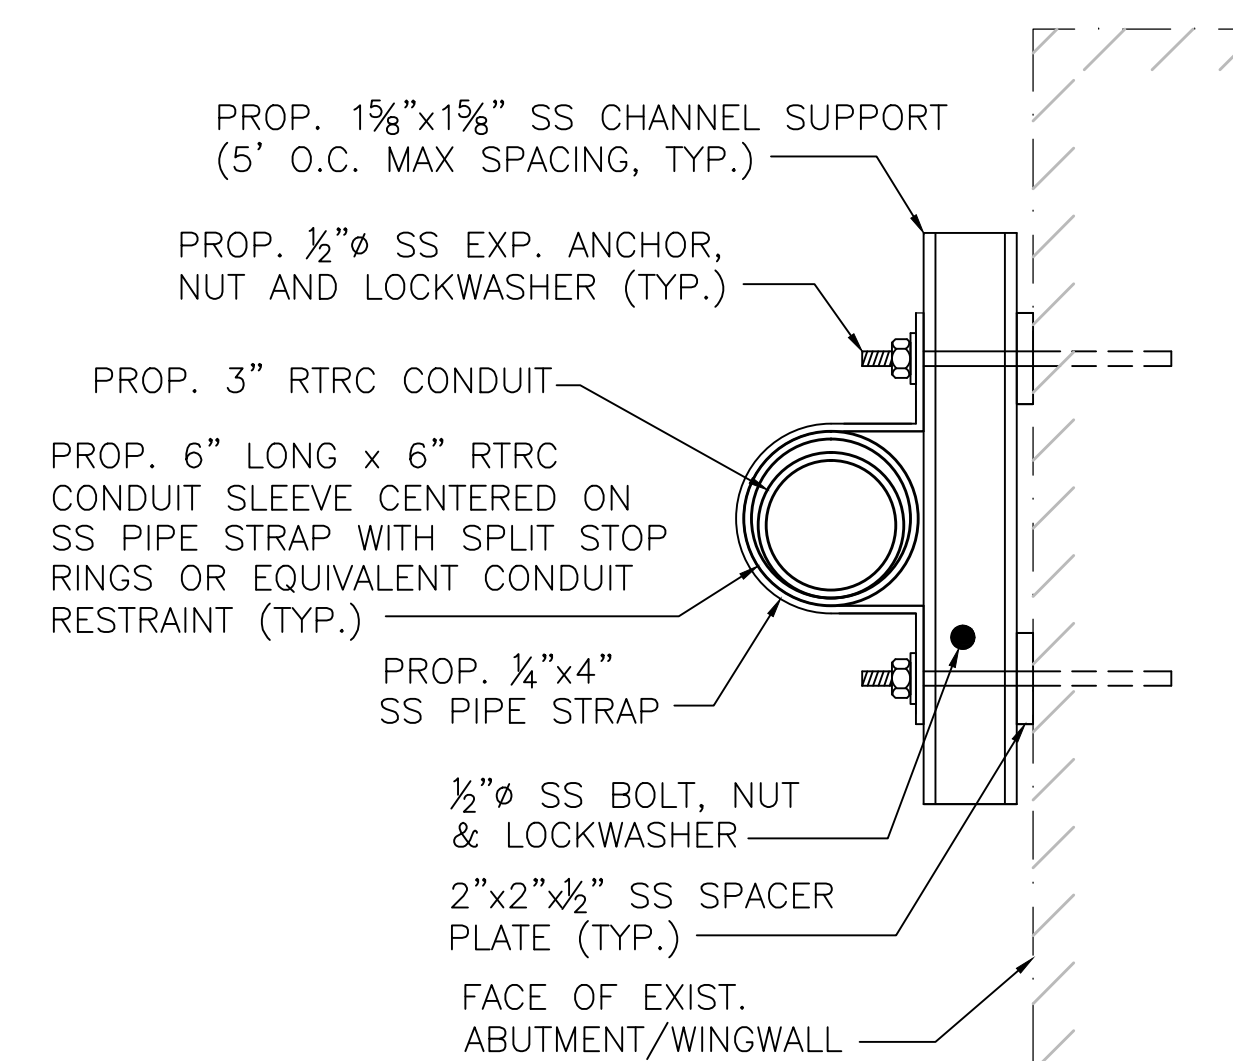

ABUTMENT/WINGWALL CONDUIT SUPPORT DETAIL  
NTS


DEC. 8, 2018	ISSUED FOR CONSTRUCTION
DATE	DESCRIPTION
USE ONLY PRINTS OF LATEST DATE	

STRUCTURAL REPAIRS - DISTRICT 2  
 MIG CORPORATION  
 CONTRACT NO. 42404  
 WORK ORDER NO. 08

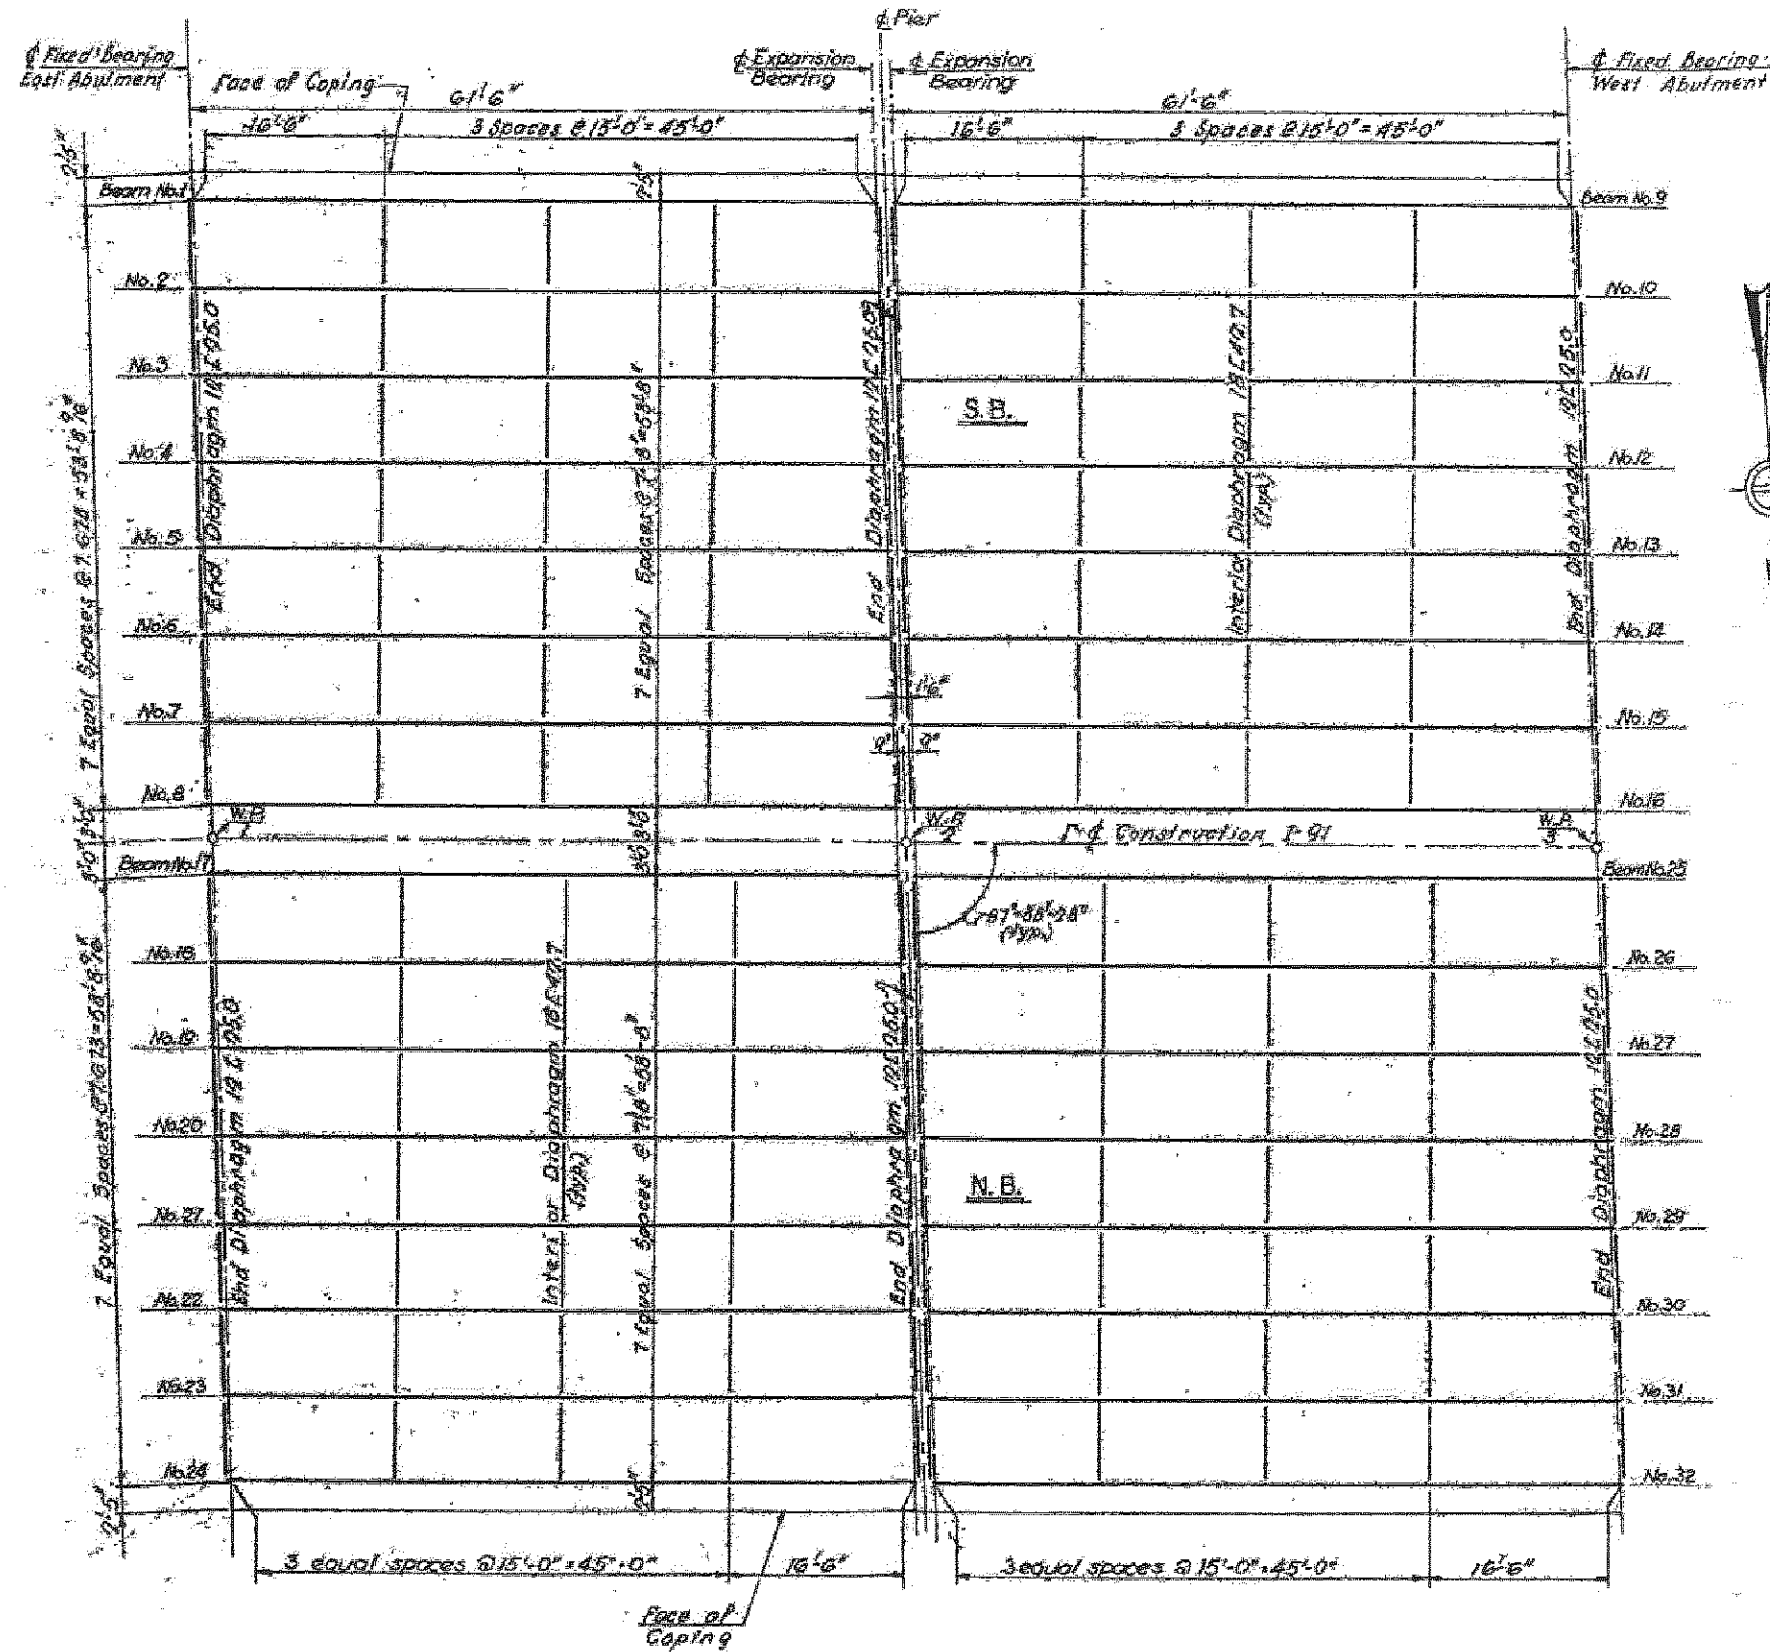


COMMONWEALTH OF MASSACHUSETTS  
 EDWARD T. BAUMANN  
 STRUCTURAL  
 No. 41257  
 Edward T. Baumann

DATE: 04/27/06

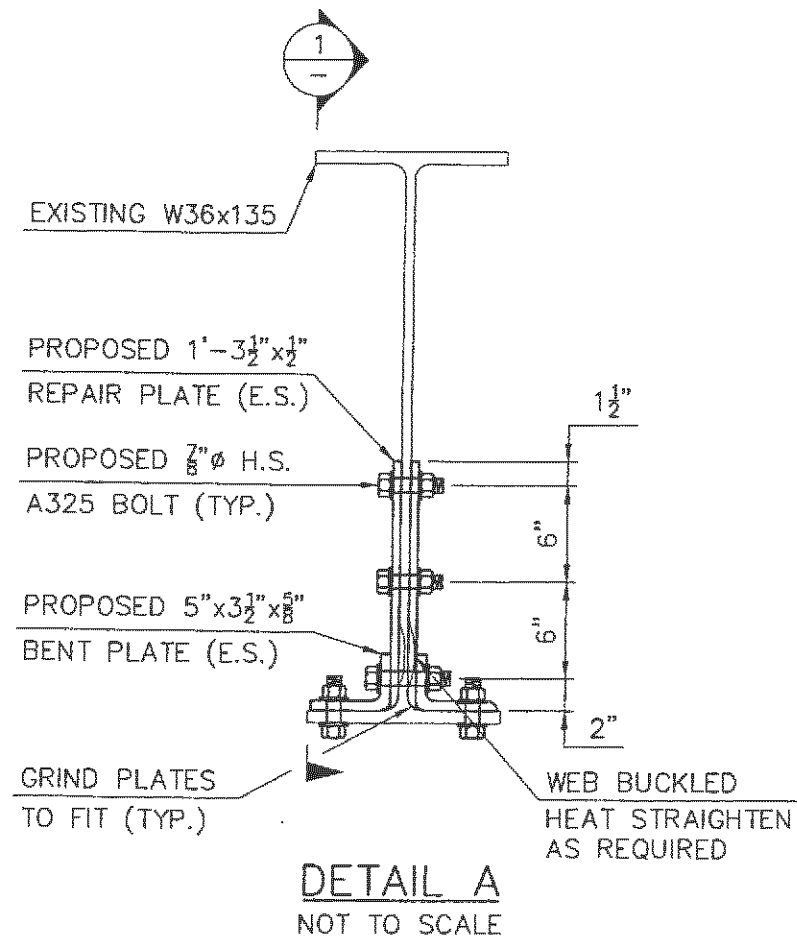

CUT EXPOSED PORTION  
OF EXISTING CONNECTION  
PLATES AS INDICATED TO  
CLEAR PROPOSED  
PLATES AND GRIND  
SMOOTH TO WEB

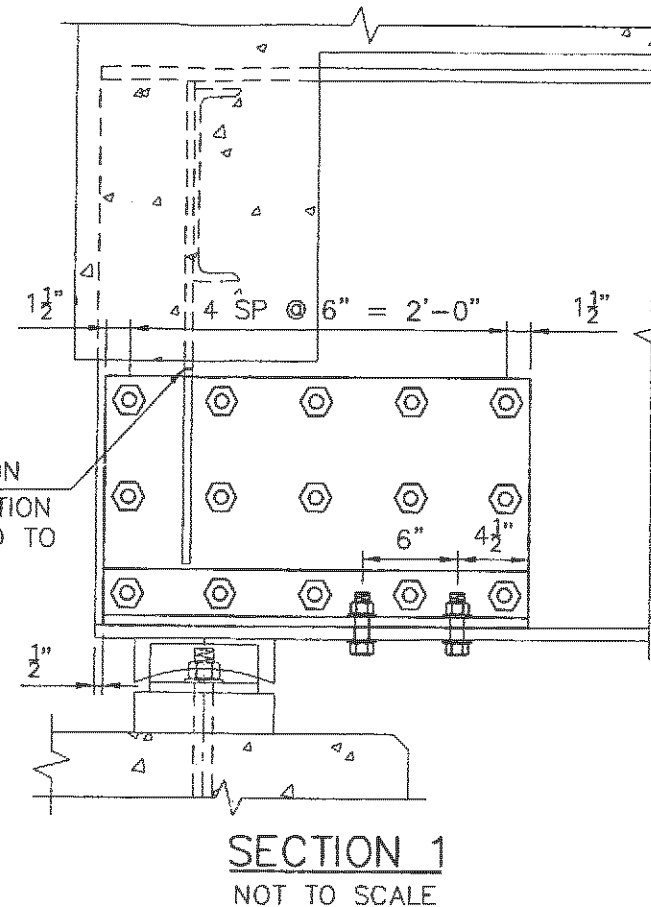

### REPAIR NOTES:

1. THE CONTRACTOR SHALL ASSUME THAT THE COATINGS ON THE STEEL CONTAIN LEAD, UNLESS OTHERWISE DETERMINED BY TESTING. THE CONTRACTOR SHALL CERTIFY IN WRITING TO THE ENGINEER THE RESULTS OF ALL TESTING, AND SHALL ALSO CERTIFY THAT ANY LEAD COATED STEEL REMOVED FROM THE PROJECT WAS NOT REUSED OR BURIED, BUT WAS SENT TO A SCRAP METAL RECYCLING FACILITY.
2. ALL AREAS THAT ARE TO RECEIVE REPAIR ELEMENTS SHALL BE WIRE BRUSHED CLEANED OF ALL RUST AND HAVE ALL LOOSE, DELAMINATED, OR FLAKING STEEL REMOVED TO PROVIDE A SMOOTH SURFACE THAT WILL ALLOW UNIFORM CONTACT OF THE PROPOSED AND EXISTING ELEMENTS (SSPC-SP3).
3. PRIOR TO CUTTING OR BURNING OF ANY PAINTED STEEL SURFACES, THE CONTRACTOR MUST CHEMICALLY REMOVE THE ENTIRE COATING DOWN TO BARE METAL. THE PAINT COATING MUST BE REMOVED IN AN AREA PRESCRIBED BY A 6" MINIMUM OFFSET FROM THE REQUIRED CUT. THE CONTRACTOR SHALL INSTALL PROPER SHIELDING AND/OR TARPULINS UNDER THE LEAD REMOVAL OPERATIONS IN ORDER TO CATCH ALL DEBRIS GENERATED DURING THIS PROCEDURE.
4. ALL PROPOSED STEEL SHALL BE AASHTO M270 GRADE 36 (ASTM A-36).
5. ALL STRUCTURAL STEEL ELEMENTS AND HIGH STRENGTH BOLTS SHALL BE PAINTED IN ACCORDANCE WITH SUBSECTION 960.63 OF THE MASSHIGHWAY STANDARD SPECIFICATIONS FOR HIGHWAYS AND BRIDGES.
6. LIMITS OF STEEL DETERIORATION AND EXISTING DIMENSIONS SHALL BE FIELD VERIFIED PRIOR TO FABRICATION.
7. BOLTS SHALL BE SUFFICIENTLY LONG SUCH THAT THREADS OF BOLTS WILL NOT BE IN THE SHEAR PLANE.

DATE: 04/27/06

DETAIL A  
STRUCTURAL REPAIRS FOR  
BRIDGE NO. W-21-047 (10W)

**PURCELL**  
ASSOCIATES

Eastern Harbor Office Park  
50 Redfield Street, Suite 102  
Boston, MA 02122  
Tel. (617) 288-0900  
FAX (617) 265-8739

1-91 SOUTHBOUND & NORTHBOUND  
OVER ROUTE 5 - RIVERDALE STREET  
WEST SPRINGFIELD, MASSACHUSETTS

SK-2 OF 2

**GENERAL NOTES:**


- GENERAL DESIGN IN ACCORDANCE WITH THE AMERICAN ASSOCIATION OF STATE HIGHWAY AND TRANSPORTATION OFFICIALS STANDARD SPECIFICATIONS FOR HIGHWAY BRIDGES, 17TH EDITION, 2002, FOR HS20 LOADING.
- ALL WORK SHALL BE IN ACCORDANCE WITH THE RELEVANT PROVISIONS OF THE 2023 EDITION OF THE MASSDOT STANDARD SPECIFICATIONS FOR HIGHWAYS AND BRIDGES AND THE CONTRACT SPECIAL PROVISIONS.
- THESE DRAWINGS WERE FORMATTED FOR 24"x36" PLAN SHEETS. SCALES NOTED ON THE DRAWINGS ARE NOT APPLICABLE TO REDUCED SIZE PRINTS.
- EXISTING STRUCTURE DIMENSIONS AND DETAILS ARE ACCORDING TO ORIGINAL CONSTRUCTION DRAWINGS, OBSERVATION, AND FIELD MEASUREMENTS AND ARE NOT GUARANTEED. THE CONTRACTOR SHALL DETERMINE AND ESTABLISH ALL DIMENSIONS AND EXISTING DETAILS NECESSARY FOR COMPLETION OF ALL WORK BY FIELD MEASUREMENT (I.E. BEARING LOCATIONS, EXISTING REPAIRS, ETC.) THE CONTRACTOR SHALL BE RESPONSIBLE FOR THE ADEQUACY AND ACCURACY THEREOF, AND SHALL NOT ORDER ANY MATERIAL OR COMMENCE ANY FABRICATION UNTIL THEY HAVE MADE THE REQUIRED MEASUREMENTS ON THE ACTUAL STRUCTURE AND THE EXTENT OF THE PROPOSED WORK HAS BEEN APPROVED BY THE ENGINEER.
- THE CONTRACTOR SHALL TAKE ALL PRECAUTIONS NECESSARY NOT TO DAMAGE UTILITIES, EQUIPMENT, STRUCTURES, OR THOSE PORTIONS OF THE SUPERSTRUCTURE THAT ARE TO REMAIN IN PLACE, THAT ARE TO BE REUSED, OR THAT ARE TO REMAIN THE PROPERTY OF OTHERS. ANY PORTION OF THE SUPERSTRUCTURE AND SUBSTRUCTURE TO REMAIN WHICH BECOMES DAMAGED AS A RESULT OF THE CONTRACTOR'S OPERATIONS SHALL BE REPAIRED TO THE SATISFACTION OF THE ENGINEER AND AT THE CONTRACTOR'S EXPENSE.
- WELDING AND FABRICATION OF STEEL SHALL CONFORM TO THE RELEVANT PROVISIONS OF THE AASHTO ASD STANDARD SPECIFICATIONS FOR HIGHWAY BRIDGES, THE ANSI/AASHTO/AWS D1.5 BRIDGE WELDING CODE, AND THE MASSACHUSETTS STANDARD SPECIFICATIONS FOR HIGHWAYS AND BRIDGES.
- ALL PAINTING AND PREPARATION WORK SHALL BE PERFORMED IN ACCORDANCE WITH SECTION 961 - MAINTENANCE PAINTING OF STEEL BRIDGES OF THE MASSDOT STANDARD SPECIFICATIONS FOR HIGHWAYS AND BRIDGES AND THE CONTRACT SPECIAL PROVISIONS. THE LIMITS OF PAINTING SHALL EXTEND 6" BEYOND THE LIMITS OF THE BEAM END REPAIRS OR 5'-0" FROM THE BEAM END, WHICHEVER IS GREATER. ALL REPAIRS, CLEANING, AND PAINT AREAS SHALL INCLUDE THE BEARINGS.
- NO REPAIRS SHALL COMMENCE UNTIL ALL MEASUREMENTS HAVE BEEN MADE AND MATERIAL ARE ON HAND FOR THE REPAIR
- THE CONTRACTOR SHALL ASSUME THE COATING ON THE STEEL CONTAINS LEAD UNLESS OTHERWISE DETERMINED BY TESTING. THE CONTRACTOR SHALL CERTIFY IN WRITING TO THE ENGINEER THAT RESULTS OF ALL TESTING, AND SHALL ALSO CERTIFY THAT ANY LEAD COATED STEEL REMOVED FROM THE PROJECT WAS PROPERLY DISPOSED OF.

**MATERIALS:**


- ALL STRUCTURAL STEEL FOR BEAM END REPAIRS SHALL CONFORM TO AASHTO M270 GRADE 36 OR GRADE 50. THE STEEL SHALL BE CONSIDERED A MAIN MEMBER AND CONFORM TO THE CHARPY V-NOTCH REQUIREMENTS OF AASHTO M270 ZONE T2. ALL NEW STRUCTURAL STEEL SHALL BE SHOP PRIMED. PRIMER USED MUST BE NEPCOAT APPROVED, USED WITH A NEPCOAT APPROVED INTERMEDIATE AND TOPCOAT SYSTEM, AND HAVE A SLIP COEFFICIENT OF CLASS B.
- ALL BOLTS SHALL BE 3/4" HIGH STRENGTH BOLTS (H.S.) IN 1 1/8" HOLES. THE BOLTS SHALL CONFORM TO ASTM F3125, GRADE 325, TYPE 1 AND NUTS AND WASHERS SHALL CONFORM TO AASHTO M291 (ASTM A563) AND M293 (ASTM F436) RESPECTIVELY. ALL BOLTS SHALL BE MECHANICALLY GALVANIZED IN ACCORDANCE WITH ASTM B695 CLASS 50. NUTS AND WASHERS SHALL BE MECHANICALLY GALVANIZED BY THE SAME PROCESS. NUTS SHALL BE LUBRICATED WITH A LUBRICANT CONTAINING A VISIBLE DYE. BOLTS, NUTS AND WASHERS SHALL BE FIELD PAINTED AFTER INSTALLATION.

**TRAFFIC:**

TRAFFIC CONTROL SHALL BE IN ACCORDANCE WITH AN APPROVED TRAFFIC MANAGEMENT PLAN DEVELOPED BY OTHERS

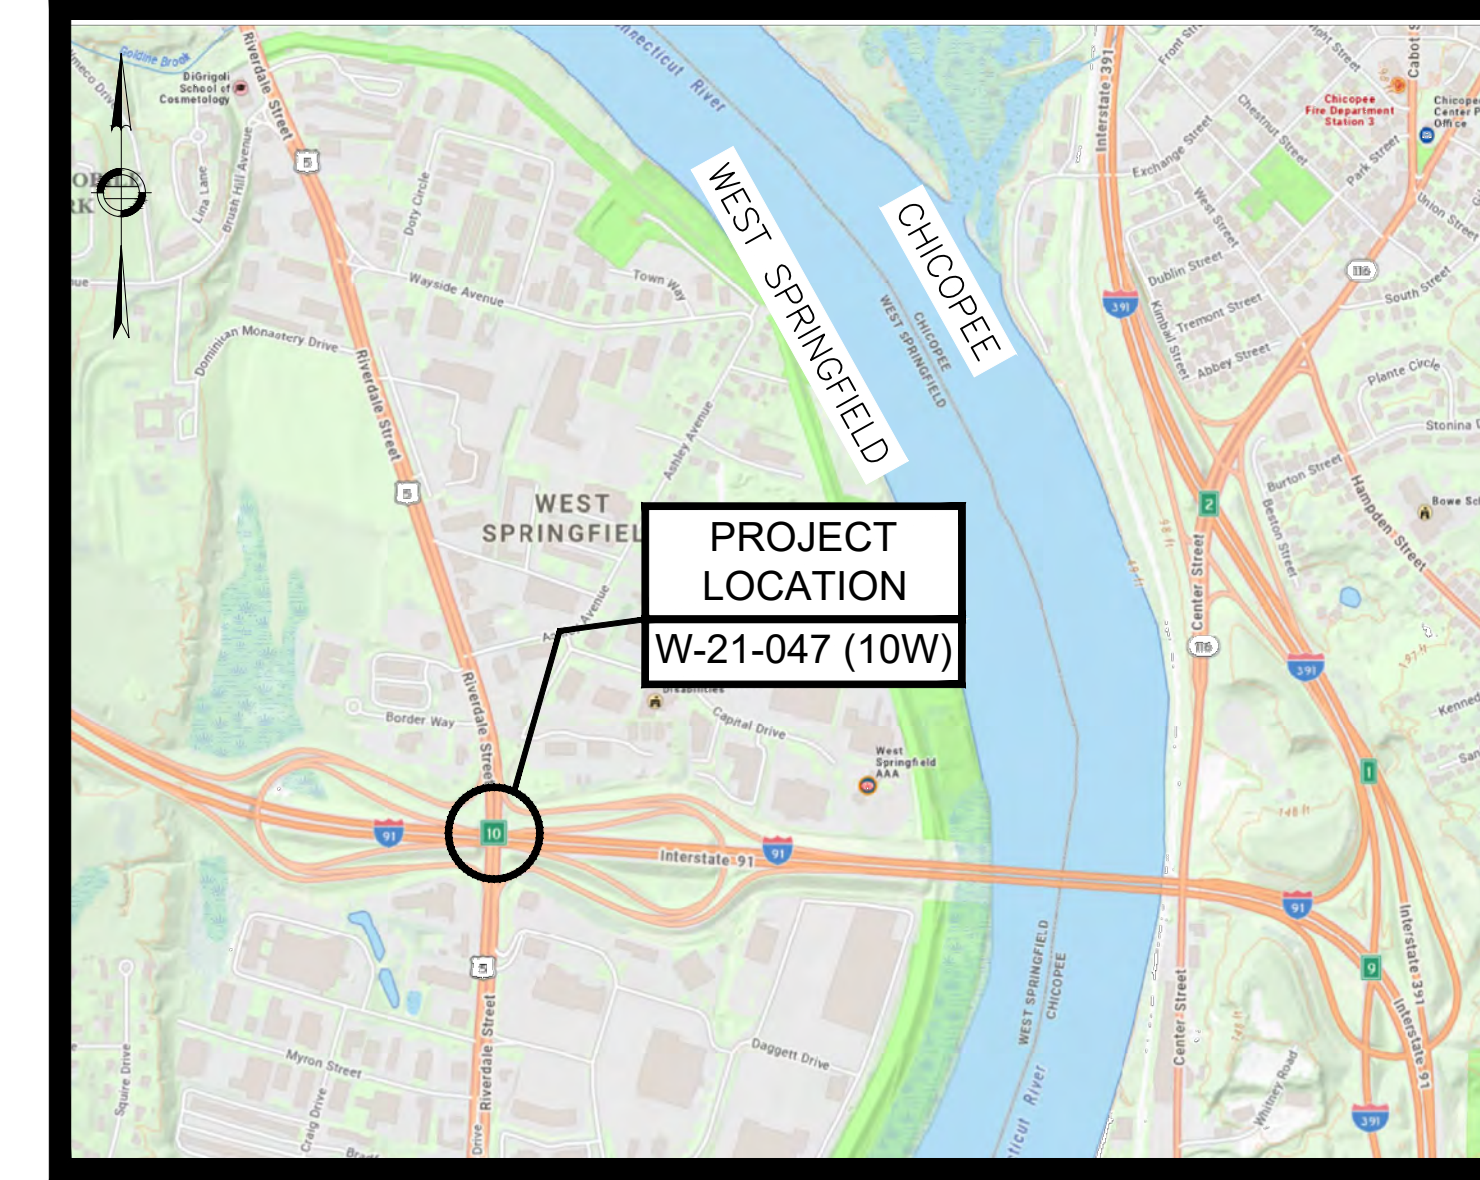

**LOCUS PLAN**  
NOT TO SCALE

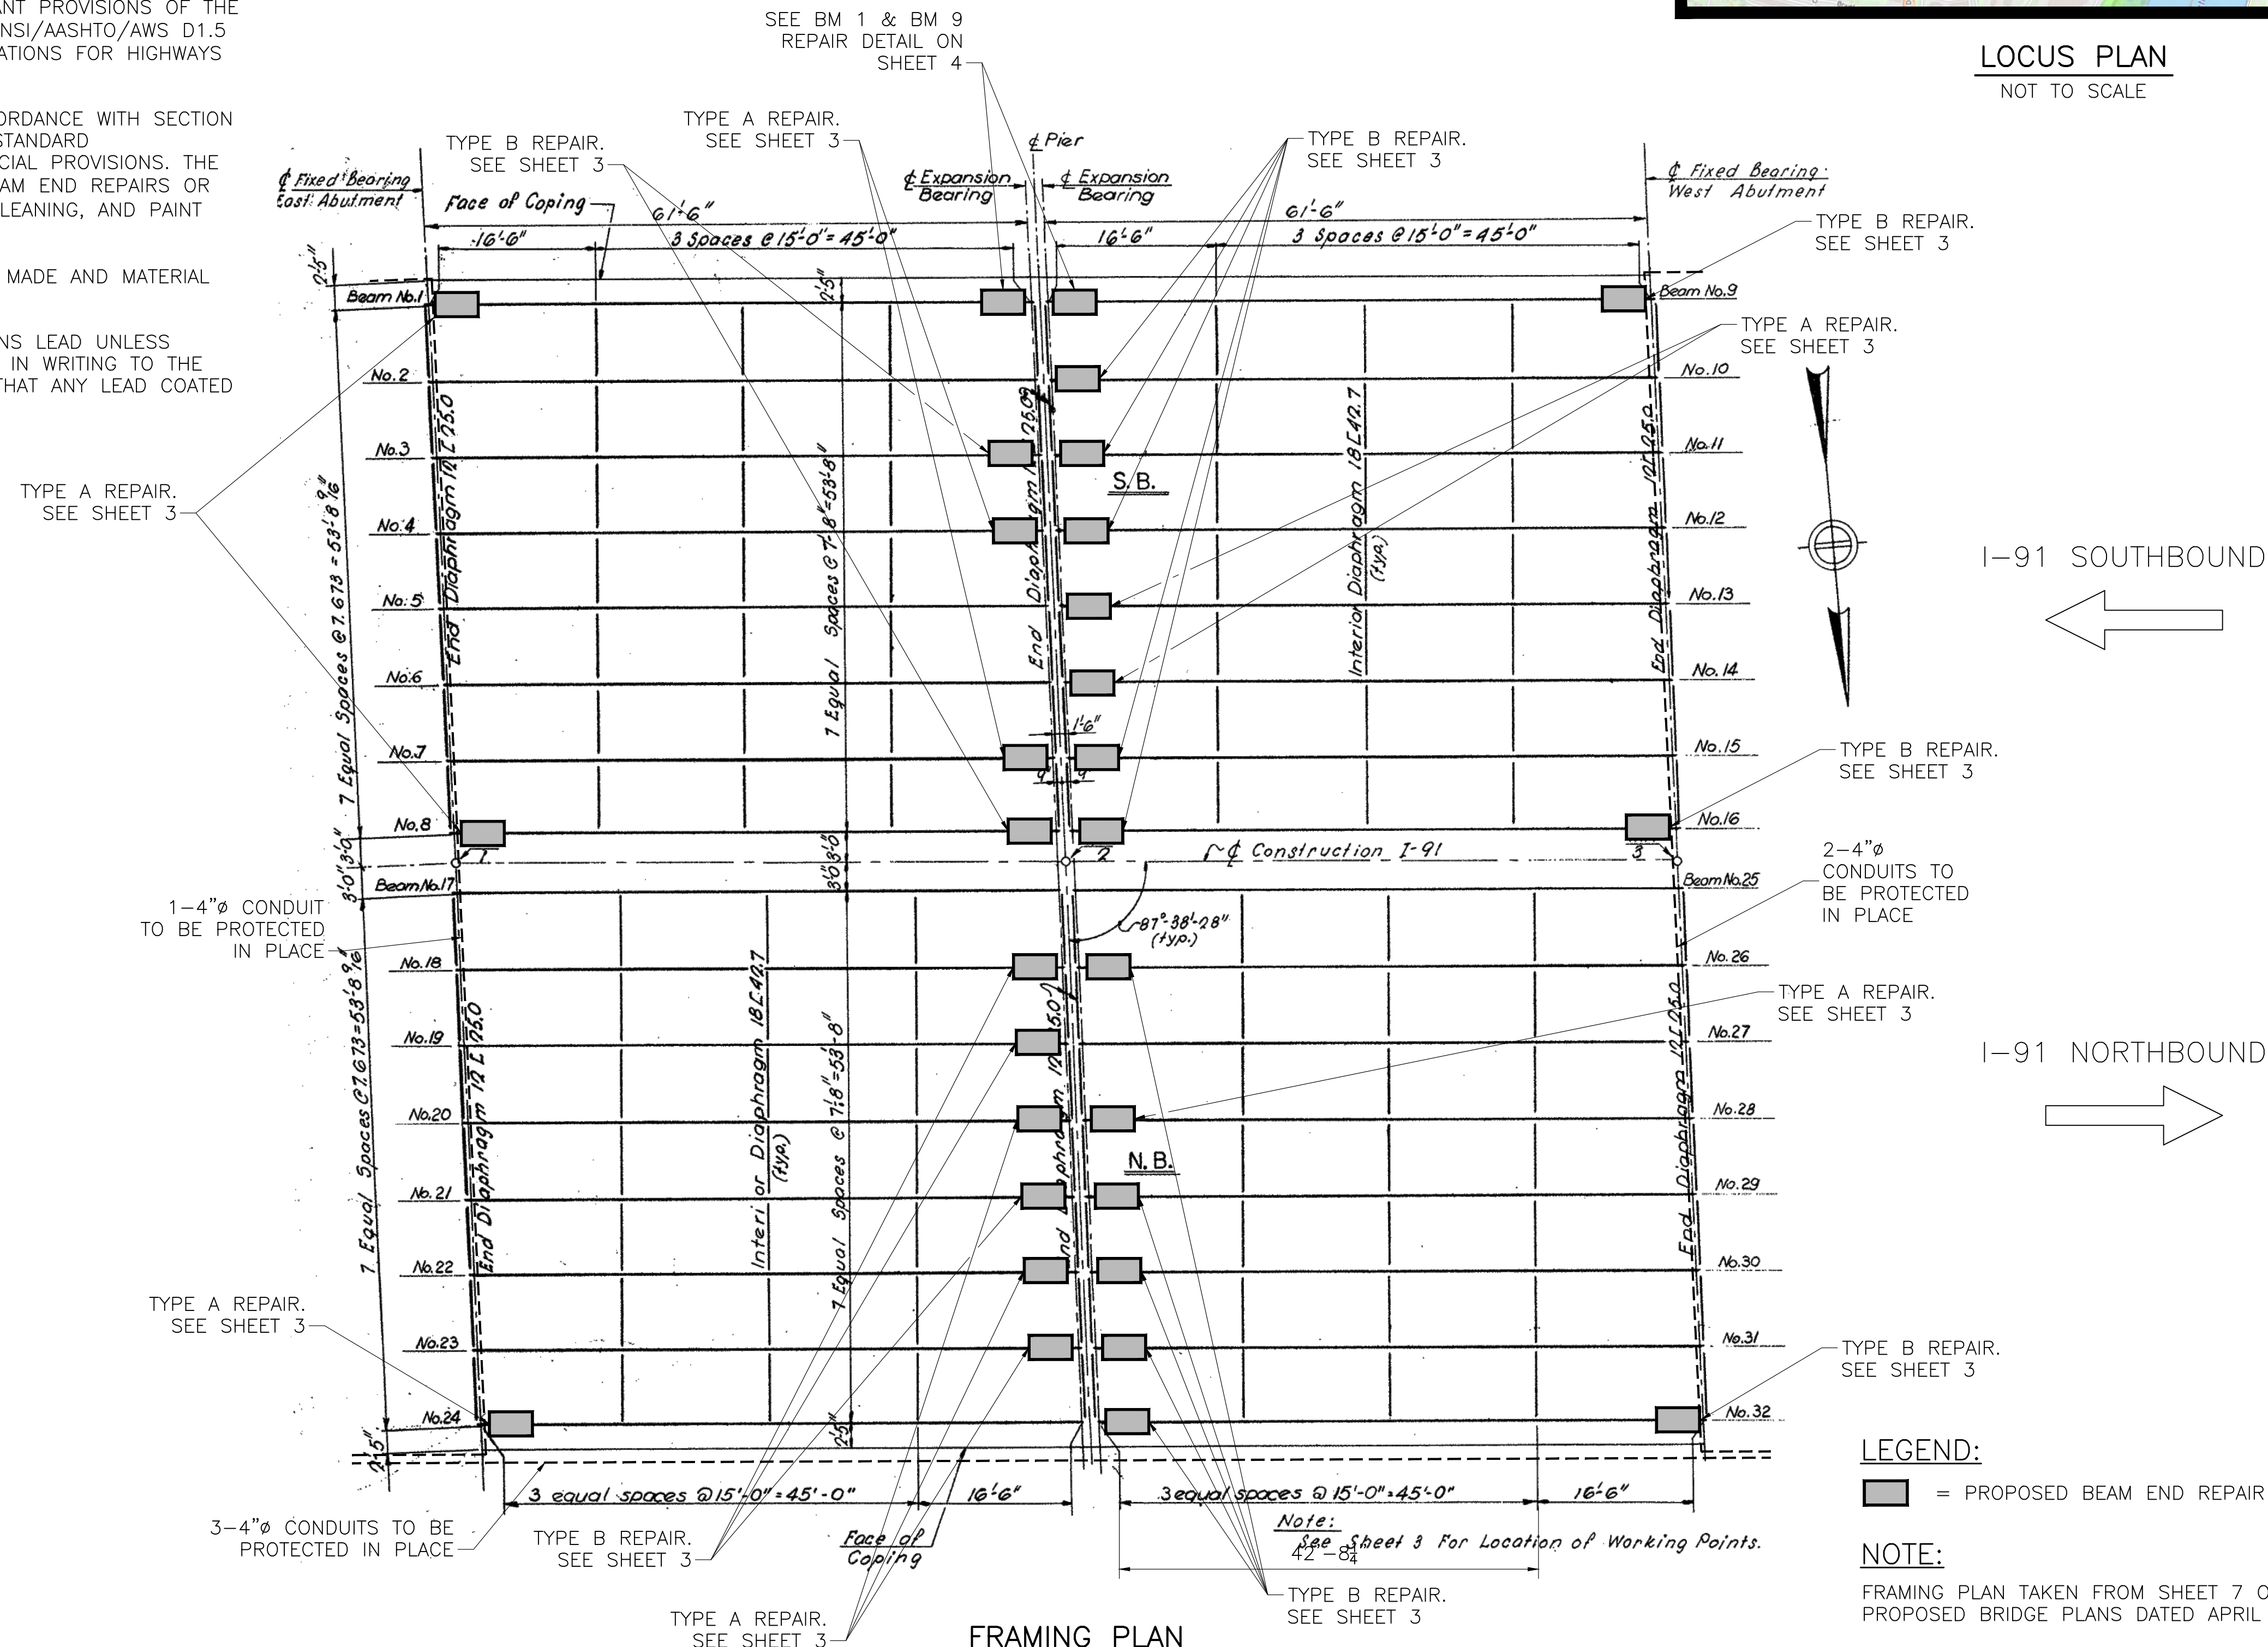

**FRAMING PLAN**

SCALE: 3/32" = 1'-0"

**LEGEND:**

■ = PROPOSED BEAM END REPAIR LOCATION AND TYPE

**NOTE:**

FRAMING PLAN TAKEN FROM SHEET 7 OF 11 OF PROPOSED BRIDGE PLANS DATED APRIL 9, 1966.

**Contract 120828**  
**Project 612791**

✓ Approved	Revise and resubmit
Approved as noted, Resubmission not required	Not Approved
District 2 NORTHAMPTON	
Signed:  Date: October 17, 2023	
1. Approval of shop drawings indicates conformance with the concept of this project and general compliance with the contract documents. 2. Contractor is responsible for all dimensions and quantities, and for the details of fabrication, construction, and coordination of all trades and subcontractors. 3. Approval does not authorize changes to contract requirements unless authorized by prior letter or change order.	

63 KENDRICK STREET  
NEEDHAM, MA 02494  
781-355-7100  
781-355-7101 (FAX)



DATE	DRW. BY	CALC. BY	APPR. BY	DESCRIPTION
10/16/2023	SSV	SSV	JAC	ISSUED FOR CONSTRUCTION
10/16/2023	SSV	SSV	JAC	REV.1 MASSDOT COMMENTS ADDRESSED



**BEAM END REPAIR PLANS**  
SPS NEW ENGLAND INC.  
BEAM END REPAIR PLANS  
W-21-047 (10W)  
I-91 OVER ROUTE 5 (RIVERDALE ST.)

**LOCUS MAP AND FRAMING PLAN**



**BEAM END REPAIR NOTES:**

- CONTRACTOR SHALL FIELD VERIFY ALL REPAIR PLATE AND ANGLE DIMENSIONS AFTER CLEANING AND PAINTING OPERATIONS AND PRIOR TO ORDERING REPAIR STEEL.
- NO REPAIRS SHALL COMMENCE UNTIL ALL MATERIALS ARE ON HAND FOR A REPAIR.
- THE CONTRACTOR SHALL ASSUME ALL EXISTING COATINGS CONTAIN LEAD UNLESS OTHERWISE DETERMINED BY TESTING. ALL DEBRIS CREATED BY CLEANING AND PAINTING OPERATIONS SHALL BE PROPERLY CONTAINED AND DISPOSED OF.
- PAINT AND SURFACE PREPARATION SHALL CONFORM TO THE REQUIREMENTS OF CONTRACT SPECIAL PROVISIONS. THE CONTACT SURFACES SHALL BE FREE OF PAINT, OIL, AND GREASE. THE CONTACT SURFACES OF THE BOLTED PARTS WERE DESIGNED AS A CLASS B SLIP CRITICAL CONNECTION. PRIMER SHALL BE ON THE NEPCOAT QUALIFIED PRODUCTS LIST AND HAVE A SLIP COEFFICIENT OF CLASS B.
- ENGINEER TO INSPECT CLEANED REPAIR AREA AND VERIFY REPAIR LIMITS BASED ON CONDITIONS EXPOSED BY CLEANING. IF IT IS DETERMINED, AFTER CLEANING, THAT THE LIMITS OF REPAIRS NEED TO BE EXTENDED, THE CLEANING AND PAINTING MAY BE EXTENDED AT THE DISCRETION OF THE ENGINEER.
- CONTRACTOR SHALL GRIND ALL PLATES AND SHAPES AS REQUIRED TO CLEAR THE FILLET OF THE EXISTING BEAM FLANGES.
- THE BEAM SHALL BE INSPECTED FOR DAMAGE DUE TO CONTRACTOR OPERATIONS. ANY DAMAGE BY THE CONTRACTOR SHALL BE REPAIRED AT THE CONTRACTORS' EXPENSE.
- EPOXY REPAIR COMPOUND SHALL BE APPLIED TO PRIOR TO BOLTED REPAIR STEEL INSTALLATION.
- IN THE CASE THAT ANY STEEL REPAIR ANGLE INTERFERES WITH THE EXISTING ANCHOR BOLT, A LEG OF THE ANGLE CAN BE COPED TO PROVIDE CLEARANCE AROUND THE EXISTING ANCHOR BOLT.
- THE CONTRACTOR SHALL MAKE TEMPLATES FROM THE PROPOSED STEEL LOCATING ALL HOLES FOR H.S. BOLTS. THE TEMPLATES SHALL BE LOCATED AND HELD SECURELY IN PLACE ON THE EXISTING STRUCTURE AND THE LOCATIONS OF ALL HOLES SUB DRILLED TO  $\frac{1}{8}$ " $\phi$ .
- THE PROPOSED STEEL REPAIR PLATES AND SHAPES SHALL BE SECURED IN PLACE WITH POSITIONING BOLTS, INSTALLED SNUG TIGHT TO ENSURE THAT THE PROPOSED STEEL MAINTAINS ITS ALIGNMENT WITH THE EXISTING STEEL.
- ALL HOLES SHALL BE REAMED TO FULL SIZE,  $\frac{1}{8}$ " $\phi$ , IN THE ASSEMBLED POSITION. ADJUST LOCATION OF POSITIONING BOLTS AS REQUIRED TO COMPLETE ALL HOLES.
- AFTER ALL HOLES HAVE BEEN REAMED TO FULL SIZE, REMOVE THE PROPOSED STEEL AND APPLY A COATING OF EPOXY REPAIR COMPOUND TO ALL PITTED/DETERIORATED STEEL FAYING SURFACES (PLUS 1") OF THE EXISTING STEEL.
- SECURE THE PROPOSED STEEL WITH POSITIONING BOLTS AND ALLOW THE EPOXY COMPOUND TO CURE PRIOR TO INSTALLING THE  $\frac{7}{8}$ " $\phi$  H.S. BOLTS.
- FOR BOLTING OF REPAIR PLATES AND SHAPES, ALL BOLTS SHALL BE INSTALLED SNUG TIGHT. ONCE ALL BOLTS ARE INSTALLED THEY SHALL BE TIGHTENED TO THE PROPER PRETENSION LOAD FOLLOWING MASSDOT STANDARD PROCEDURE. FINAL TENSIONING SHALL BEGIN AT THE CENTER OF THE PLATES AND SHAPES AND THEN PROCEED OUTWARD FROM THE CENTER TO THE TWO ENDS.
- AFTER BOLTING IS COMPLETED, THE INTERMEDIATE AND TOP COATS OF PAINT SHALL BE APPLIED.
- PERIMETER OF ALL REPAIR PLATES AND ANGLES SHALL BE SEALED USING SILICONE CAULK UPON COMPLETION OF PAINTING OF REPAIRS.
- THE CONTRACTOR MAY PROPOSE AN ALTERNATE METHOD OF BOLT AND REPAIR PLATE INSTALLATION TO THAT DESCRIBED HEREIN. THE CONTRACTOR SHALL SUBMIT A DETAILED PROCEDURE DESCRIBING ALL STEPS NECESSARY TO ACCOMPLISH THE WORK FOR REVIEW AND APPROVAL BY THE ENGINEER.
- IF THERE ARE REVISIONS TO THE APPROVED PLANS, THE CONTRACTOR SHALL SUBMIT THESE CHANGES TO THE ENGINEER OF RECORD FOR REVIEW AND APPROVAL PRIOR TO CONSTRUCTION. ONCE THESE REVISIONS ARE APPROVED BY THE MASSDOT DESIGNER OF RECORD, THEY SHALL BE SUBMITTED TO MASSDOT FOR FILING.

**REPAIR COMPOUND NOTES:**


IN LOCATIONS WHERE HEAVY DETERIORATION HAS OCCURRED OR AS DIRECTED BY THE ENGINEER, EPOXY REPAIR FAIRING COMPOUND SHALL BE APPLIED OVER THE PRIME COAT AS FOLLOWS:

- THE EPOXY REPAIR COMPOUND SHALL BE APPLIED TO THE DETERIORATED AREAS IN STRICT ACCORDANCE WITH THE MANUFACTURER'S WRITTEN INSTRUCTIONS. THE CONTRACTOR SHALL SUBMIT TO THE ENGINEER OF RECORD FOR REVIEW AND APPROVAL THE METHODS, PROCEDURES, AND MATERIALS TO BE USED FOR THE WORK.
- THE REPAIR COMPOUND SHALL ONLY BE APPLIED TO THOSE AREAS OF THE EXISTING STEEL THAT EXHIBIT SEVERE SECTION LOSS TO COMPLETELY FILL THE IRREGULARITIES IN THE EXISTING STEEL SURFACES SUCH THAT NO VOIDS REMAIN BETWEEN THE PLIES OF THE EXISTING STEEL AND THE PROPOSED STRENGTHENING STEEL IN THE FINAL REPAIRED CONDITION.
- THE PROPOSED REPAIR STEEL SHALL BE PROPERLY POSITIONED AND BROUGHT INTO FIRM CONTACT WITHIN THE WORKING TIME LIMITS OF THE EPOXY REPAIR COMPOUND. THE REPAIR STEEL SHALL BE SECURED IN PLACE USING POSITIONING BOLTS TENSIONED TO A SNUG TIGHT CONDITION AND CLAMPS OR OTHER MECHANICAL MEANS TO BRING THE PLIES OF THE EXISTING STEEL AND NEW STEEL INTO FIRM CONTACT. WELDING IS NOT ALLOWED.
- ONCE THE PROPOSED STEEL HAS BEEN SECURED INTO POSITION WITH THE POSITIONING BOLTS, AND THE EPOXY COMPOUND HAS CURED, THE REMAINING H.S. BOLTS SHALL BE INSTALLED FOLLOWING THE PROCEDURE OUTLINED IN THE GENERAL NOTES.
- EPOXY COMPOUND FOR STRUCTURAL STEEL REPAIRS SHALL BE A SOLVENT FREE, MOISTURE TOLERANT, EPOXY PASTE ADHESIVE SYSTEM. THE EPOXY PASTE SHALL BE DEVELOPED SPECIFICALLY FOR FILLING, SMOOTHING, SEALING, OR FAIRING APPLICATIONS ON METALS. THE PASTE SHALL BE APPLIED IN STRICT ACCORDANCE WITH THE MANUFACTURER'S LATEST WRITTEN INSTRUCTIONS. AN ACCEPTABLE PRODUCT SHALL BE ONE OF THE FOLLOWING OR AN APPROVED EQUAL.

SIKADUR 31, HI-MOD GEL MANUFACTURED BY:  
SIKA CORPORATION  
201 POLITO AVENUE, LYNDHURST, NJ 07071  
800-933-7452  
201-933-6225  
WEBSITE: WWW.SIKAUSA.COM

DEVCON PLASTIC STEEL PUTTY (A) MANUFACTURED BY:  
ITW DEVCON  
30 ENDICOTT STREET, DANVERS, MA 01923  
800-933-8266  
WEBSITE: WWW.DEVCON.COM

FX-738 METAL FILLED EPOXY MANUFACTURED BY:  
SIMPSON STRONG-TIE  
PLEASANTON, CA 94588  
800-999-5099  
WEBSITE: WWW.STRONGTIE.COM

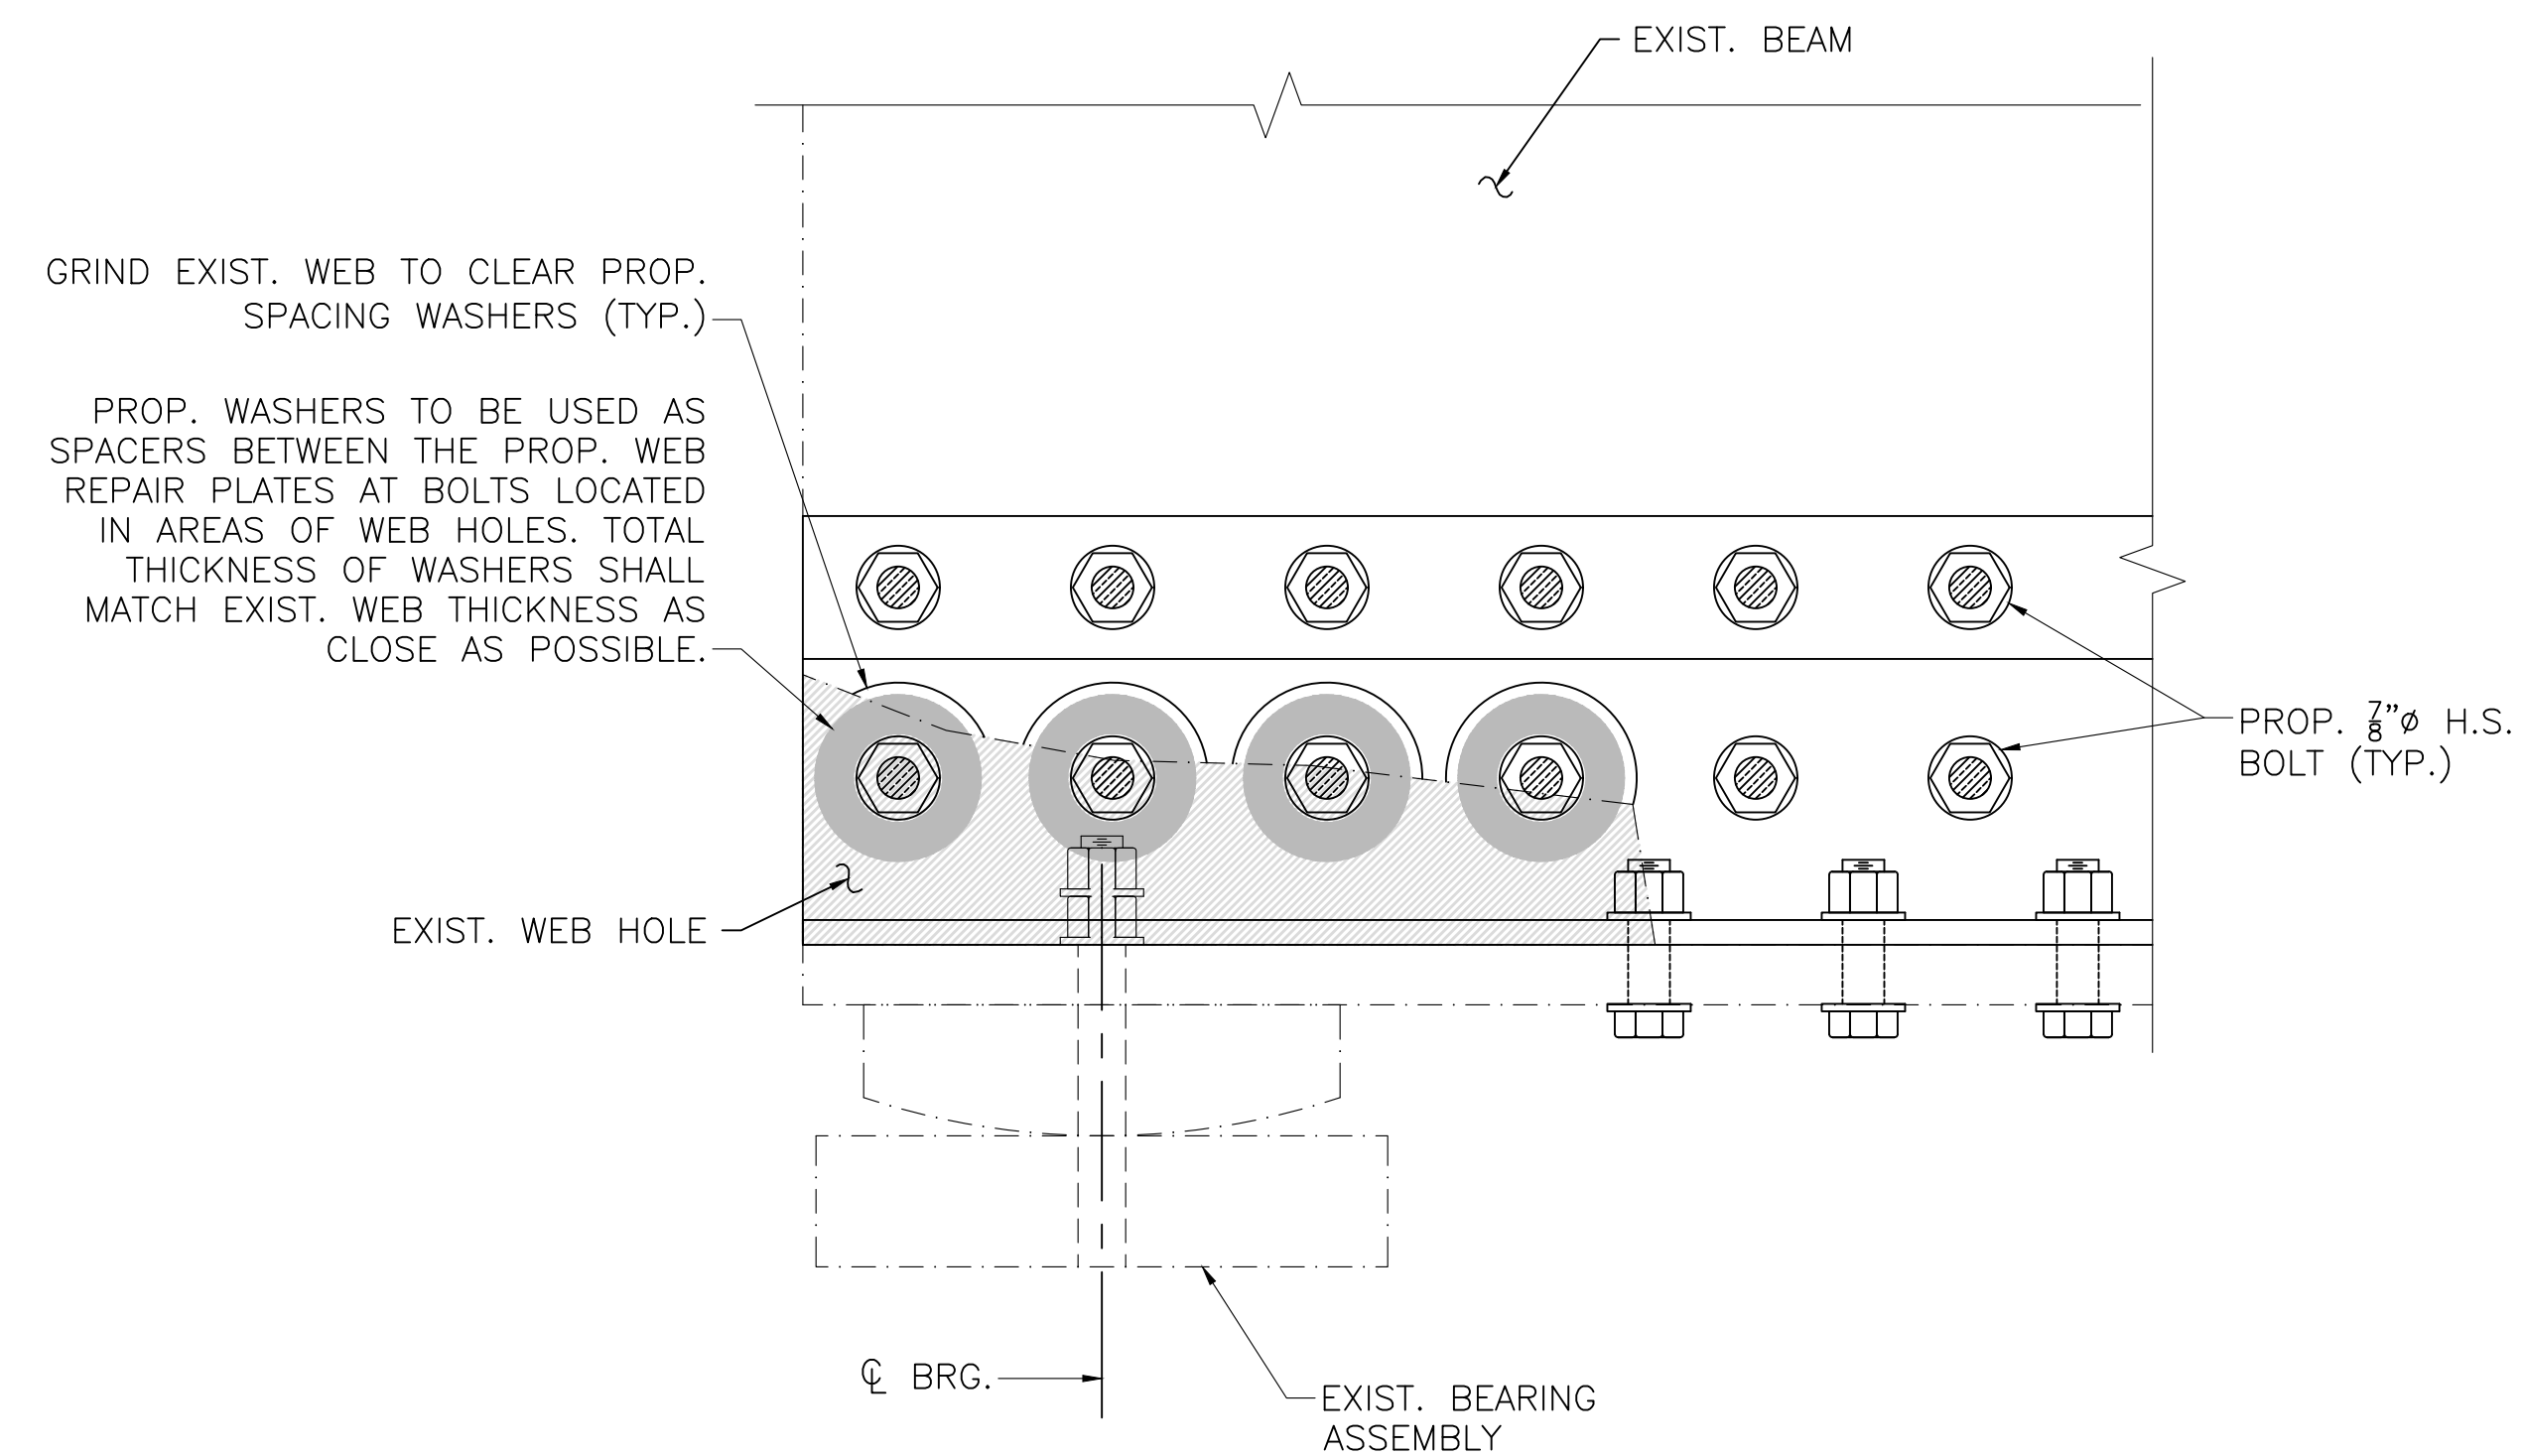

**TYPICAL BOLT INSTALLATION DETAIL AT LOCATIONS OF EXISTING WEB HOLES**

SCALE: 3" = 1'-0"

<input checked="" type="checkbox"/>	Approved	Revise and resubmit
<input type="checkbox"/>	Approved as noted, Resubmission not required	Not Approved

**massDOT**  
Highway Division  
District 2 NORTHAMPTON

Signed: *[Signature]* Date: **October 17, 2023**

- Approval of shop drawings indicates conformance with the concept of this project and general compliance with the contract documents.
- Contractor is responsible for all dimensions and quantities, and for the details of fabrication, construction, and coordination of all trades and subcontractors.
- Approval does not authorize changes to contract requirements unless authorized by prior letter or change order.

63 KENDRICK STREET  
NEEDHAM, MA 02484  
781-355-7100  
781-355-7101 (FAX)



DATE	DRW BY	CALC BY	APPRV. BY	DESCRIPTION
10/16/2023	SSV	SSV	SSV	ISSUED FOR CONSTRUCTION
	SSV	SSV	SSV	REV.1 MASSDOT COMMENTS ADDRESSED


REGISTERED PROFESSIONAL ENGINEER

DATE



**BEAM END REPAIR PLANS**  
SPS NEW ENGLAND INC.  
BEAM END REPAIR PLANS  
W-21-047 (10W)  
I-91 OVER ROUTE 5 (RIVERDALE ST.)

TYP. BEAM  
END REPAIR  
NOTES

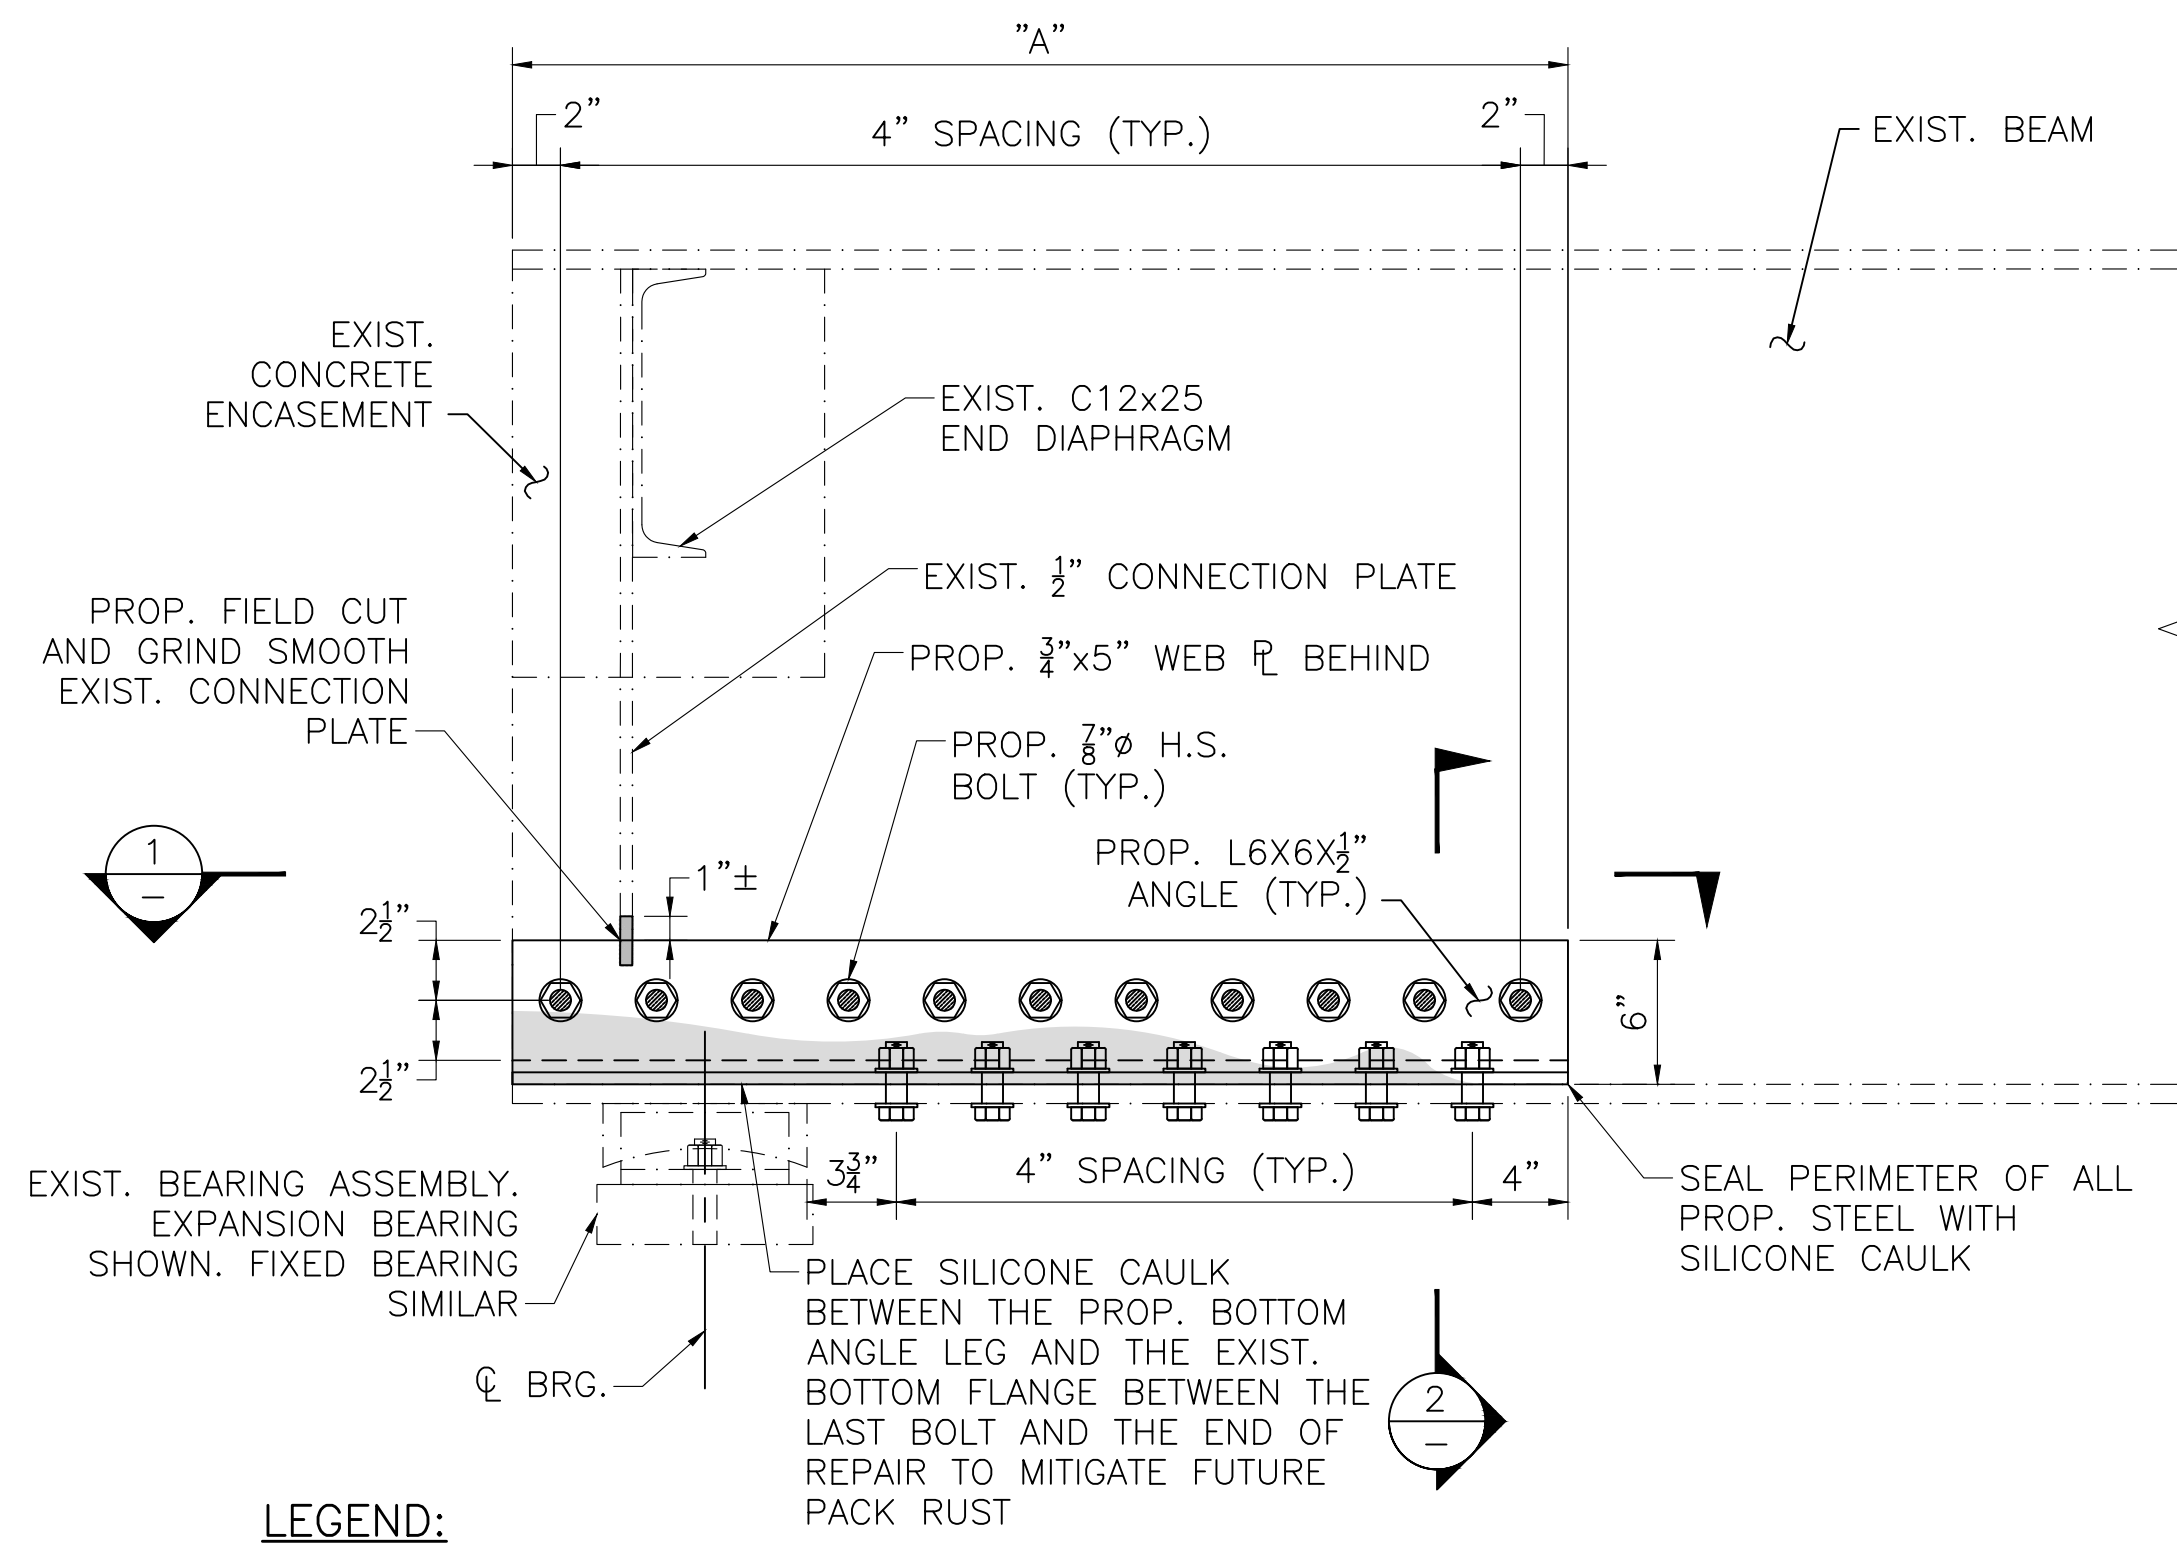

**LEGEND:**


■ = AREA OF DETERIORATION UP TO 3" HIGH

**NOTE:**

1. DECK NOT SHOWN FOR CLARITY.
2. AT LOCATIONS WHERE THE DECK DRAIN PIPES INTERFERE WITH THE INSTALLATION OF THE PROP. WEB REPAIR PLATES AND ANGLES, REMOVE EXIST. NON-WELDED CONDUIT CLAMPS AND RE-ATTACHED THEM AFTER INSTALLATION OF PROP. REPAIRS. A BIGGER CONDUIT CLAMP MAY BE REQUIRED.

**TYPE A REPAIR**

SCALE: 1/2" = 1'-0"

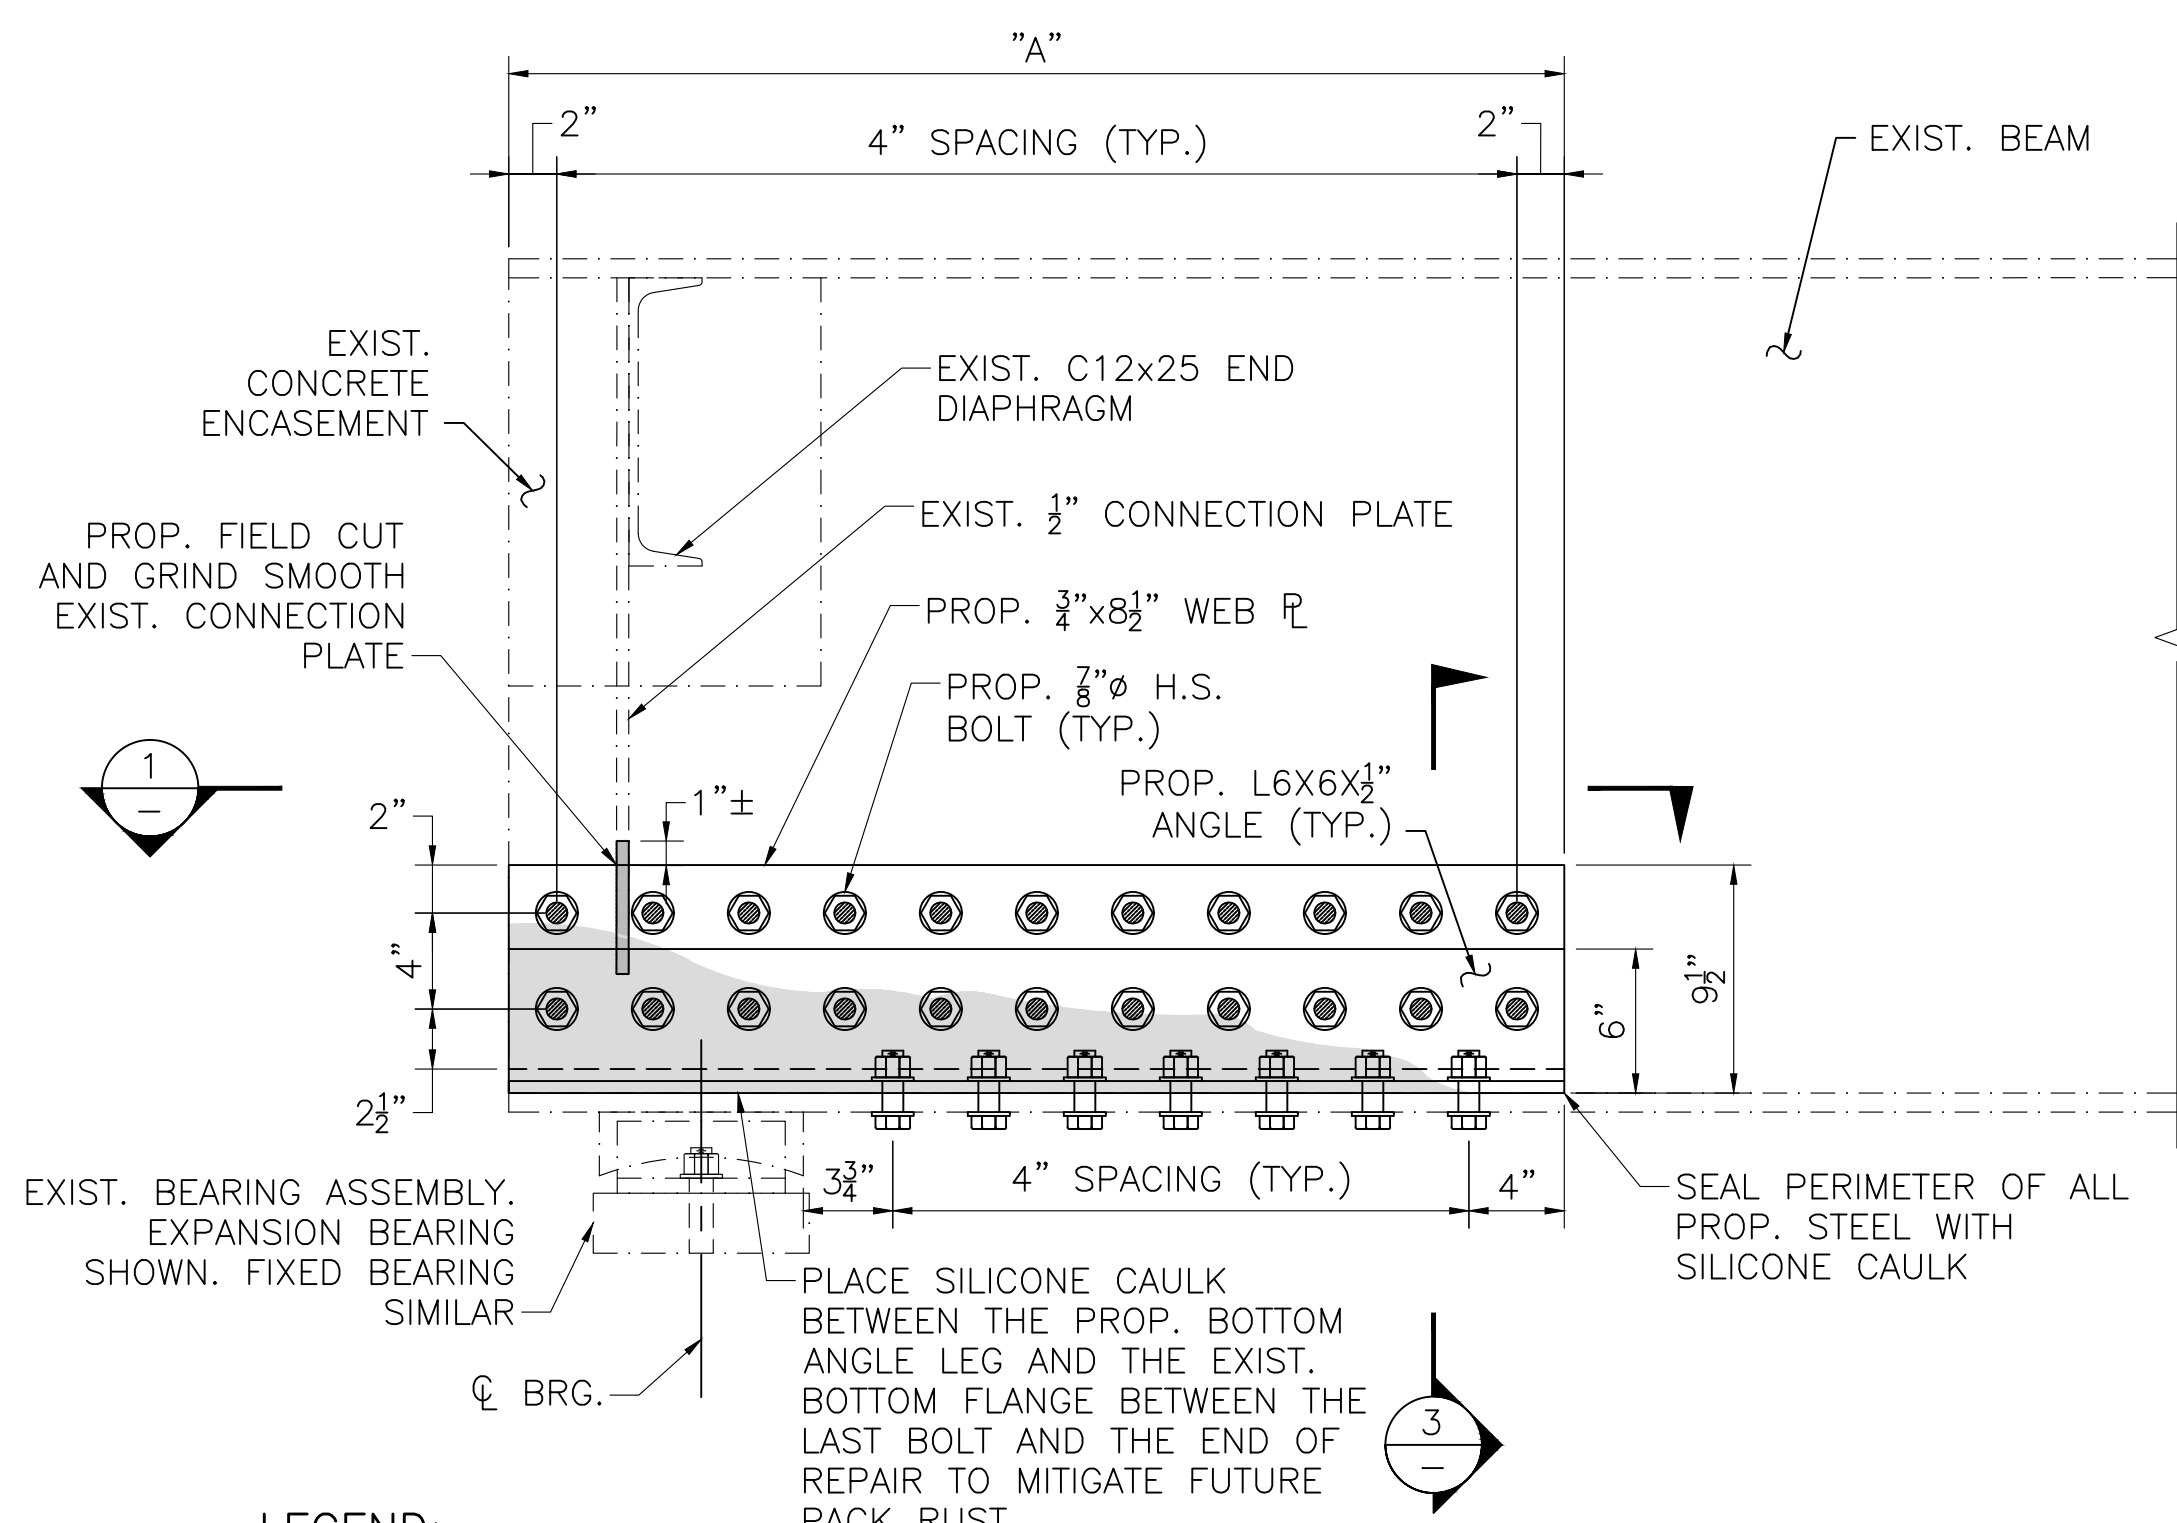

**LEGEND:**

■ = AREA OF DETERIORATION UP TO 7" HIGH

**NOTES:**

1. DECK NOT SHOWN FOR CLARITY.
2. AT LOCATIONS WHERE THE DECK DRAIN PIPES INTERFERE WITH THE INSTALLATION OF THE PROP. WEB REPAIR PLATES AND ANGLES, REMOVE EXIST. NON-WELDED CONDUIT CLAMPS AND RE-ATTACHED THEM AFTER INSTALLATION OF PROP. REPAIRS. A BIGGER CONDUIT CLAMP MAY BE REQUIRED.

**TYPE B REPAIR**


SCALE: 1/2" = 1'-0"

✓ Approved	Revise and resubmit
Approved as noted, Resubmission not required	Not Approved

**massDOT** District 2 NORTHAMPTON


Signed: *[Signature]* Date: **October 17, 2023**

1. Approval of shop drawings indicates conformance with the concept of this project and general compliance with the contract documents.
2. Contractor is responsible for all dimensions and quantities, and for the details of fabrication, construction, and coordination of all trades and subcontractors.
3. Approval does not authorize changes to contract requirements unless authorized by prior letter or change order.

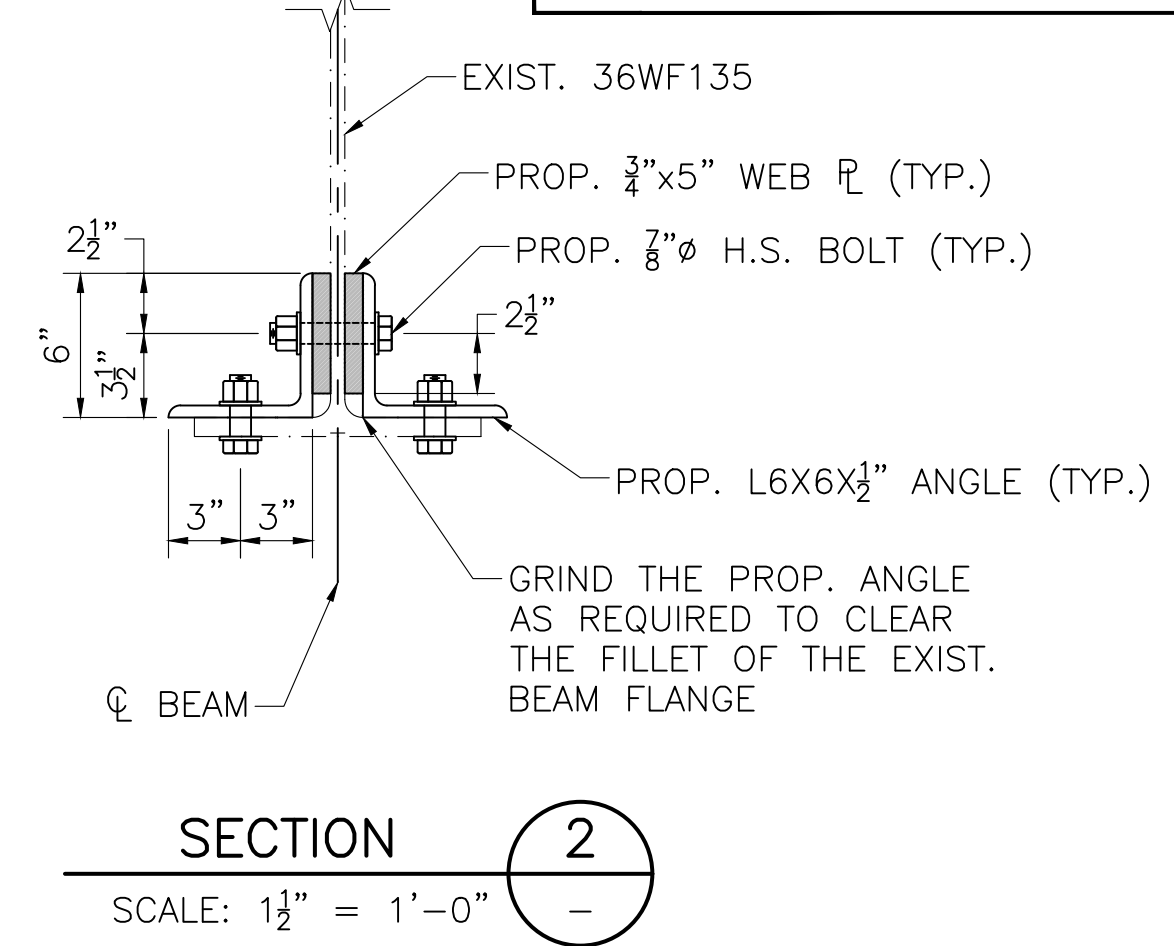


**SECTION 2**

SCALE: 1/2" = 1'-0"

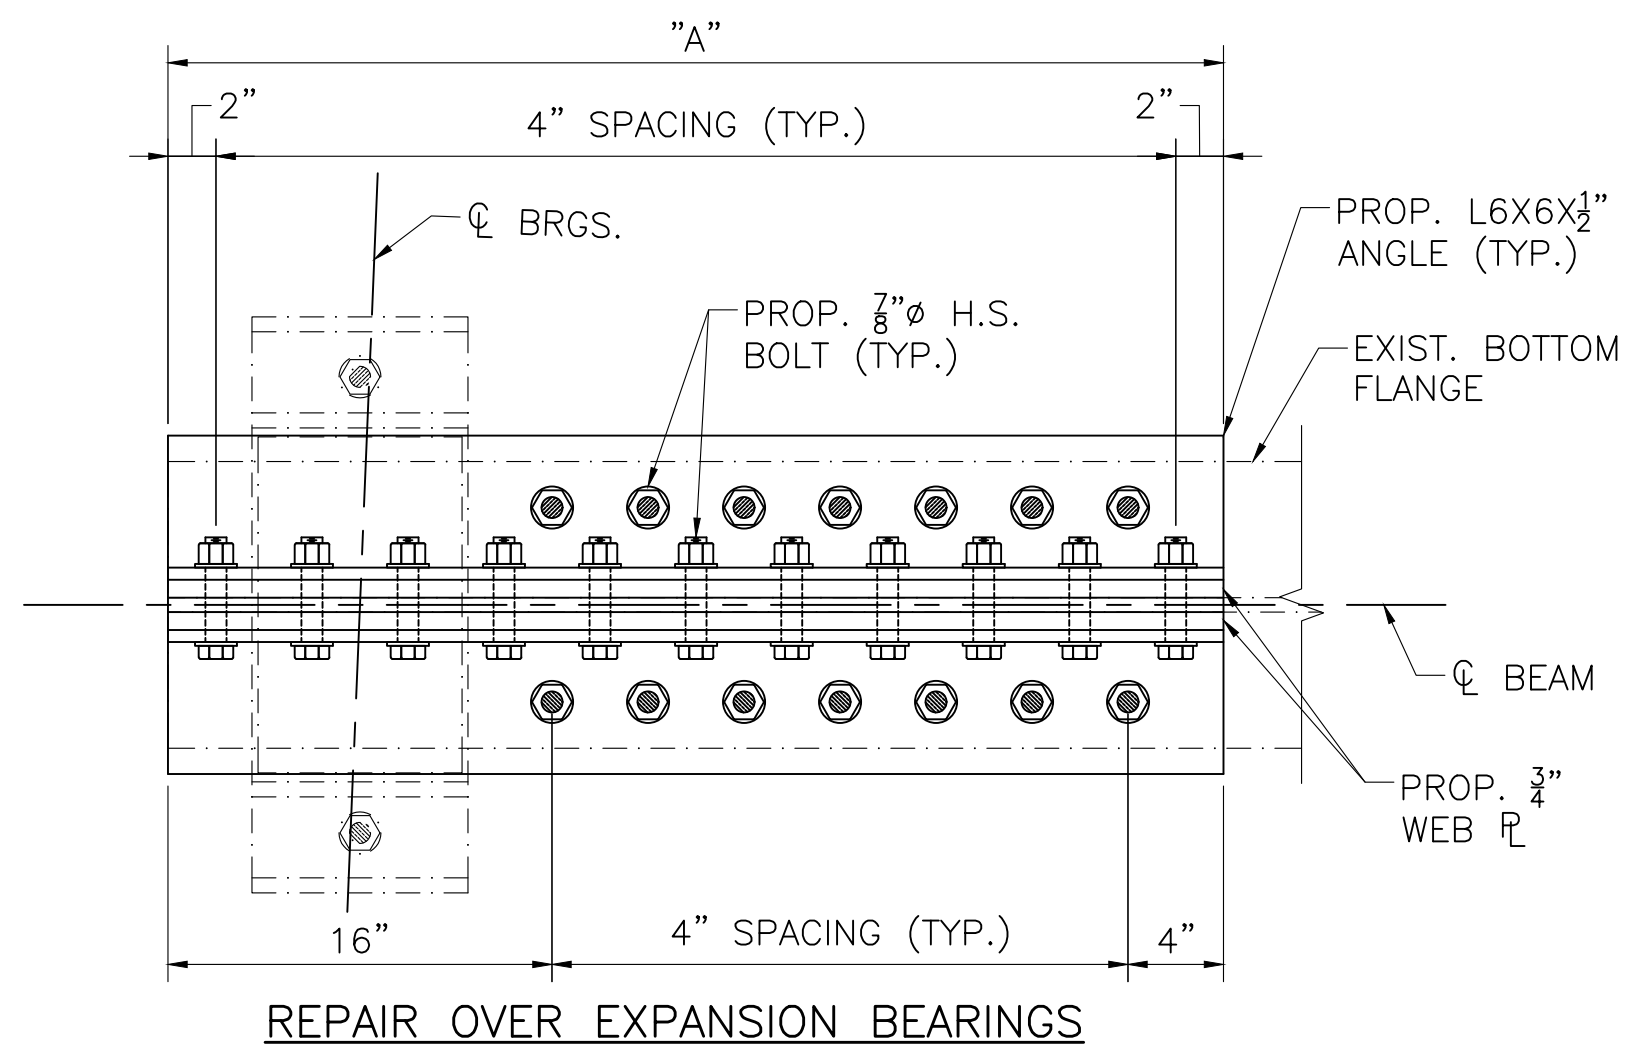


**REPAIR OVER EXPANSION BEARINGS**

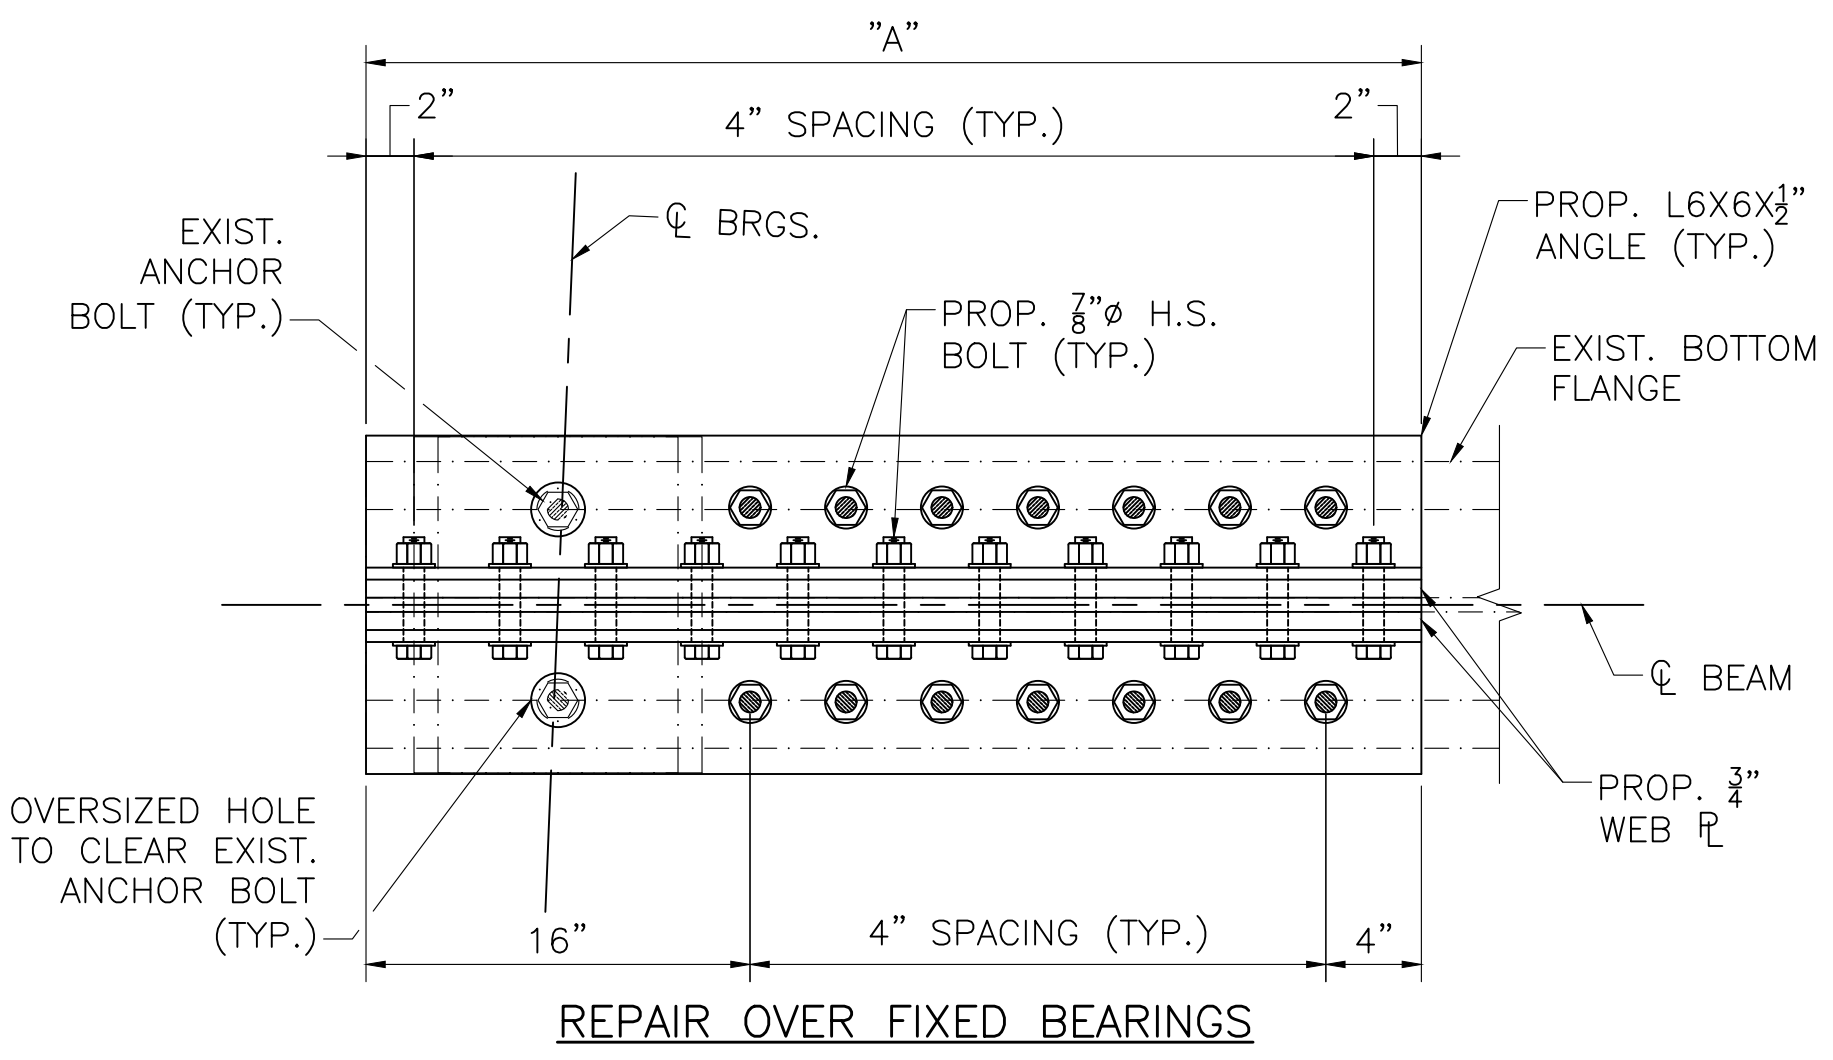

**REPAIR OVER FIXED BEARINGS**

**SECTION 1**

SCALE: 1/2" = 1'-0"

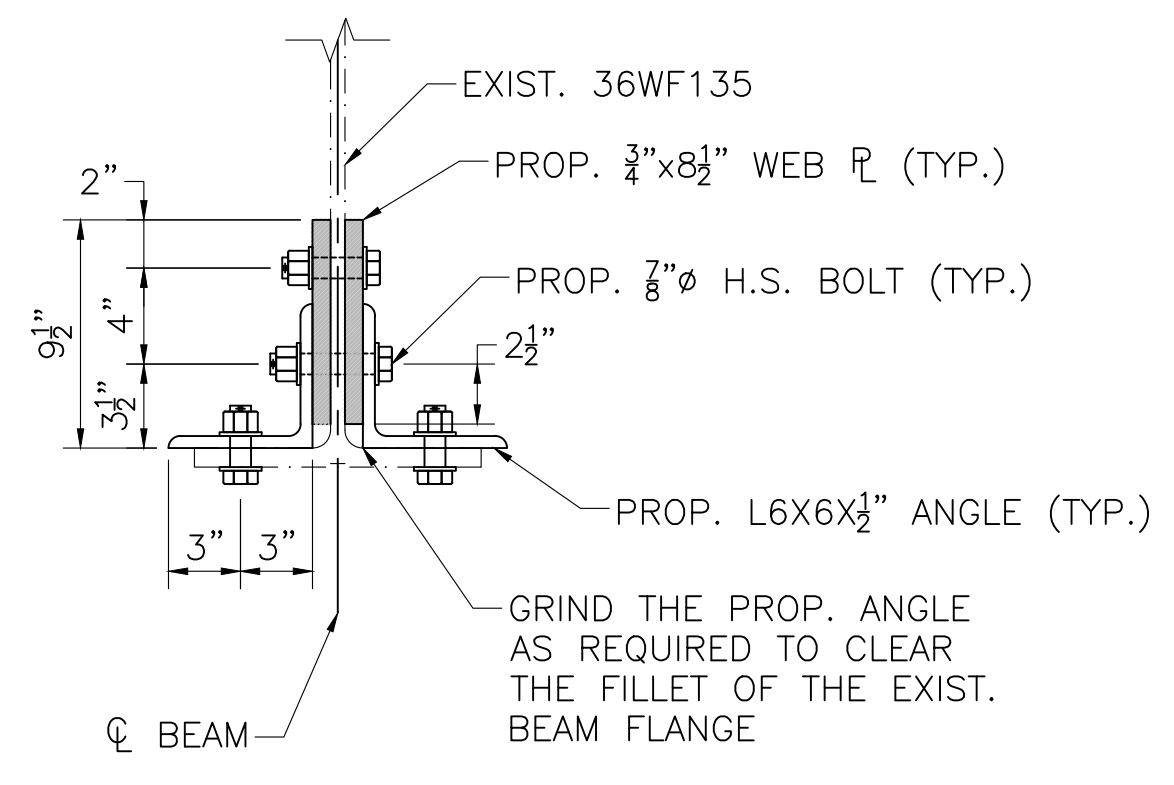

**SECTION 3**

SCALE: 1/2" = 1'-0"


TYPE A REPAIR DIMENSIONS		
	LOCATION	"A"
I-91- SOUTHBOUND	BM 1 AT E. ABUTMENT	13'-0"
	BM 8 AT E. ABUTMENT	5'-4"
	BM 4 AT PIER	5'-4"
	BM 7 AT PIER	4'-8"
	BM 13 AT PIER	5'-8"
I-91 NORTHBOUND	BM 14 AT PIER	6'-4"
	BM 24 AT E. ABUTMENT	5'-0"
	BM 20 AT PIER	3'-4"
	BM 22 AT PIER	4'-8"
	BM 23 AT PIER	2'-4"
	BM 28 AT PIER	4'-4"

TYPE B REPAIR DIMENSIONS		
	LOCATION	"A"
I-91- SOUTHBOUND	BM 3 AT PIER	5'-8"
	BM 8 AT PIER	1'-8"
	BM 10 AT PIER	8'-4"
	BM 11 AT PIER	11'-4"
	BM 12 AT PIER	6'-8"
	BM 15 AT PIER	5'-8"
	BM 16 AT PIER	4'-4"
	BM 9 AT W. ABUTMENT	3'-0"
	BM 16 AT W. ABUTMENT	4'-4"
	I-91 NORTHBOUND	BM 18 AT PIER
BM 19 AT PIER		3'-0"
BM 21 AT PIER		3'-0"
BM 26 AT PIER		8'-0"
BM 29 AT PIER		7'-8"
BM 30 AT PIER		6'-8"
	BM 31 AT PIER	4'-4"
	BM 32 AT PIER	4'-8"
	BM 32 AT W. ABUTMENT	14'-4"

DATE	DRW BY	CALC BY	APPR BY	ISSUED FOR	DESCRIPTION
10/16/2023	SSW	SSW	JAC	ISSUED FOR CONSTRUCTION	
10/16/2023	SSW	SSW	JAC	REV1	MISSOUR COMMENTS ADDRESSED

REGISTERED PROFESSIONAL ENGINEER

DATE

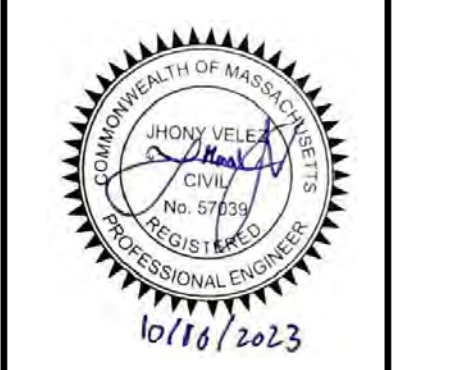


**BEAM END REPAIR PLANS**

SPS NEW ENGLAND INC.

BEAM END REPAIR PLANS  
W-21-047 (10W)  
I-91 OVER ROUTE 5 (RIVERDALE ST.)

**BEAM END REPAIR TYPE A & B**

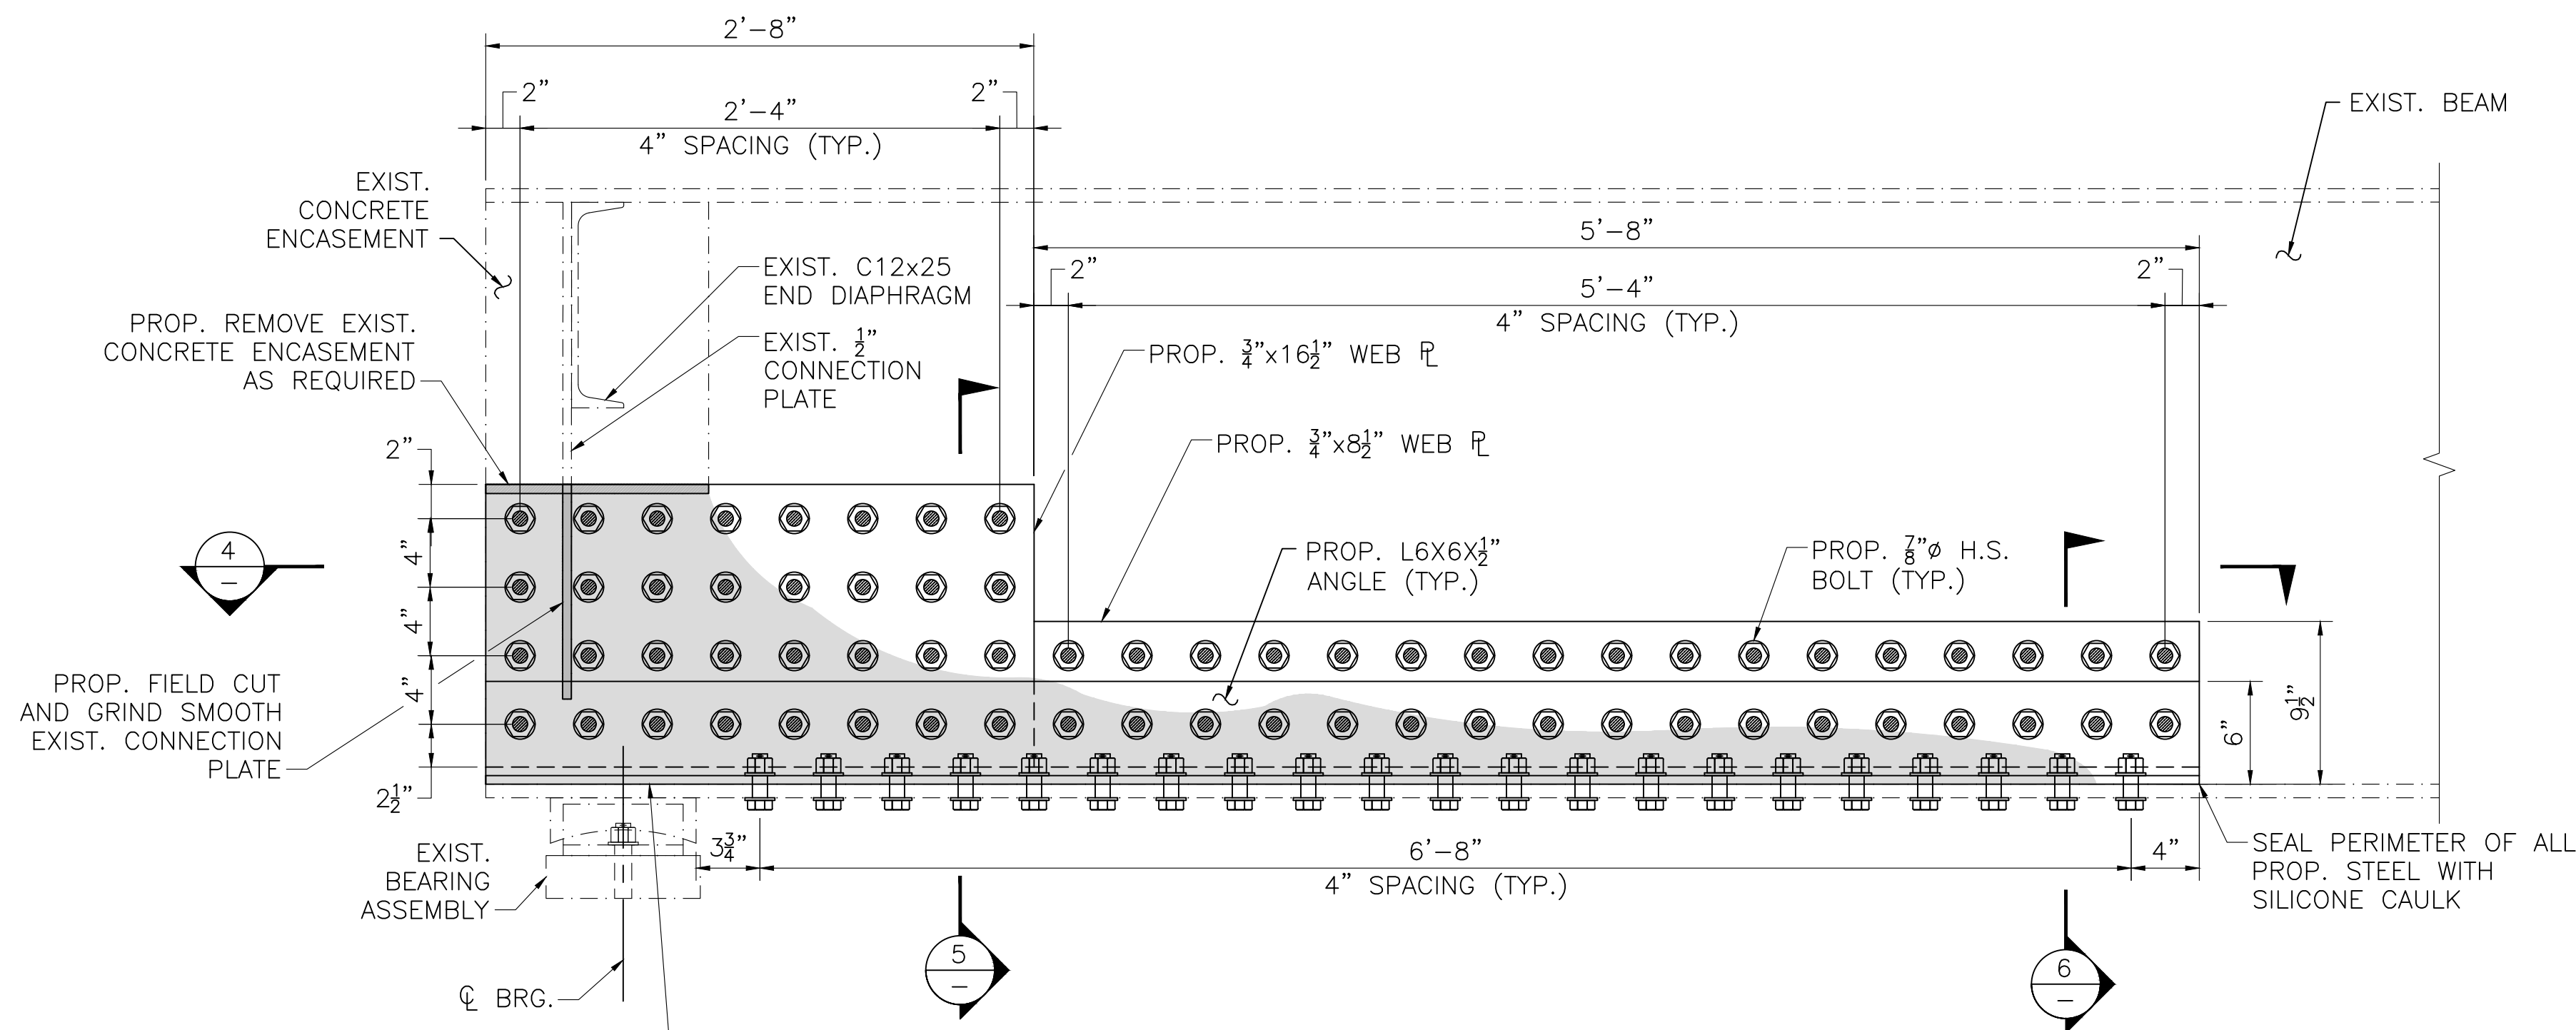

**LEGEND:**


■ = AREA OF DETERIORATION

**NOTE:**

1. DECK NOT SHOWN FOR CLARITY.
2. AT LOCATIONS WHERE THE DECK DRAIN PIPES INTERFERE WITH THE INSTALLATION OF THE PROPR. WEB REPAIR PLATES AND ANGLES, REMOVE EXIST. NON-WELDED CONDUIT CLAMPS AND RE-ATTACHED THEM AFTER INSTALLATION OF PROPR. REPAIRS. A BIGGER CONDUIT CLAMP MAY BE REQUIRED.


**BM 1 & BM 9 AT PIER REPAIR**

SCALE: 1 1/2" = 1'-0"

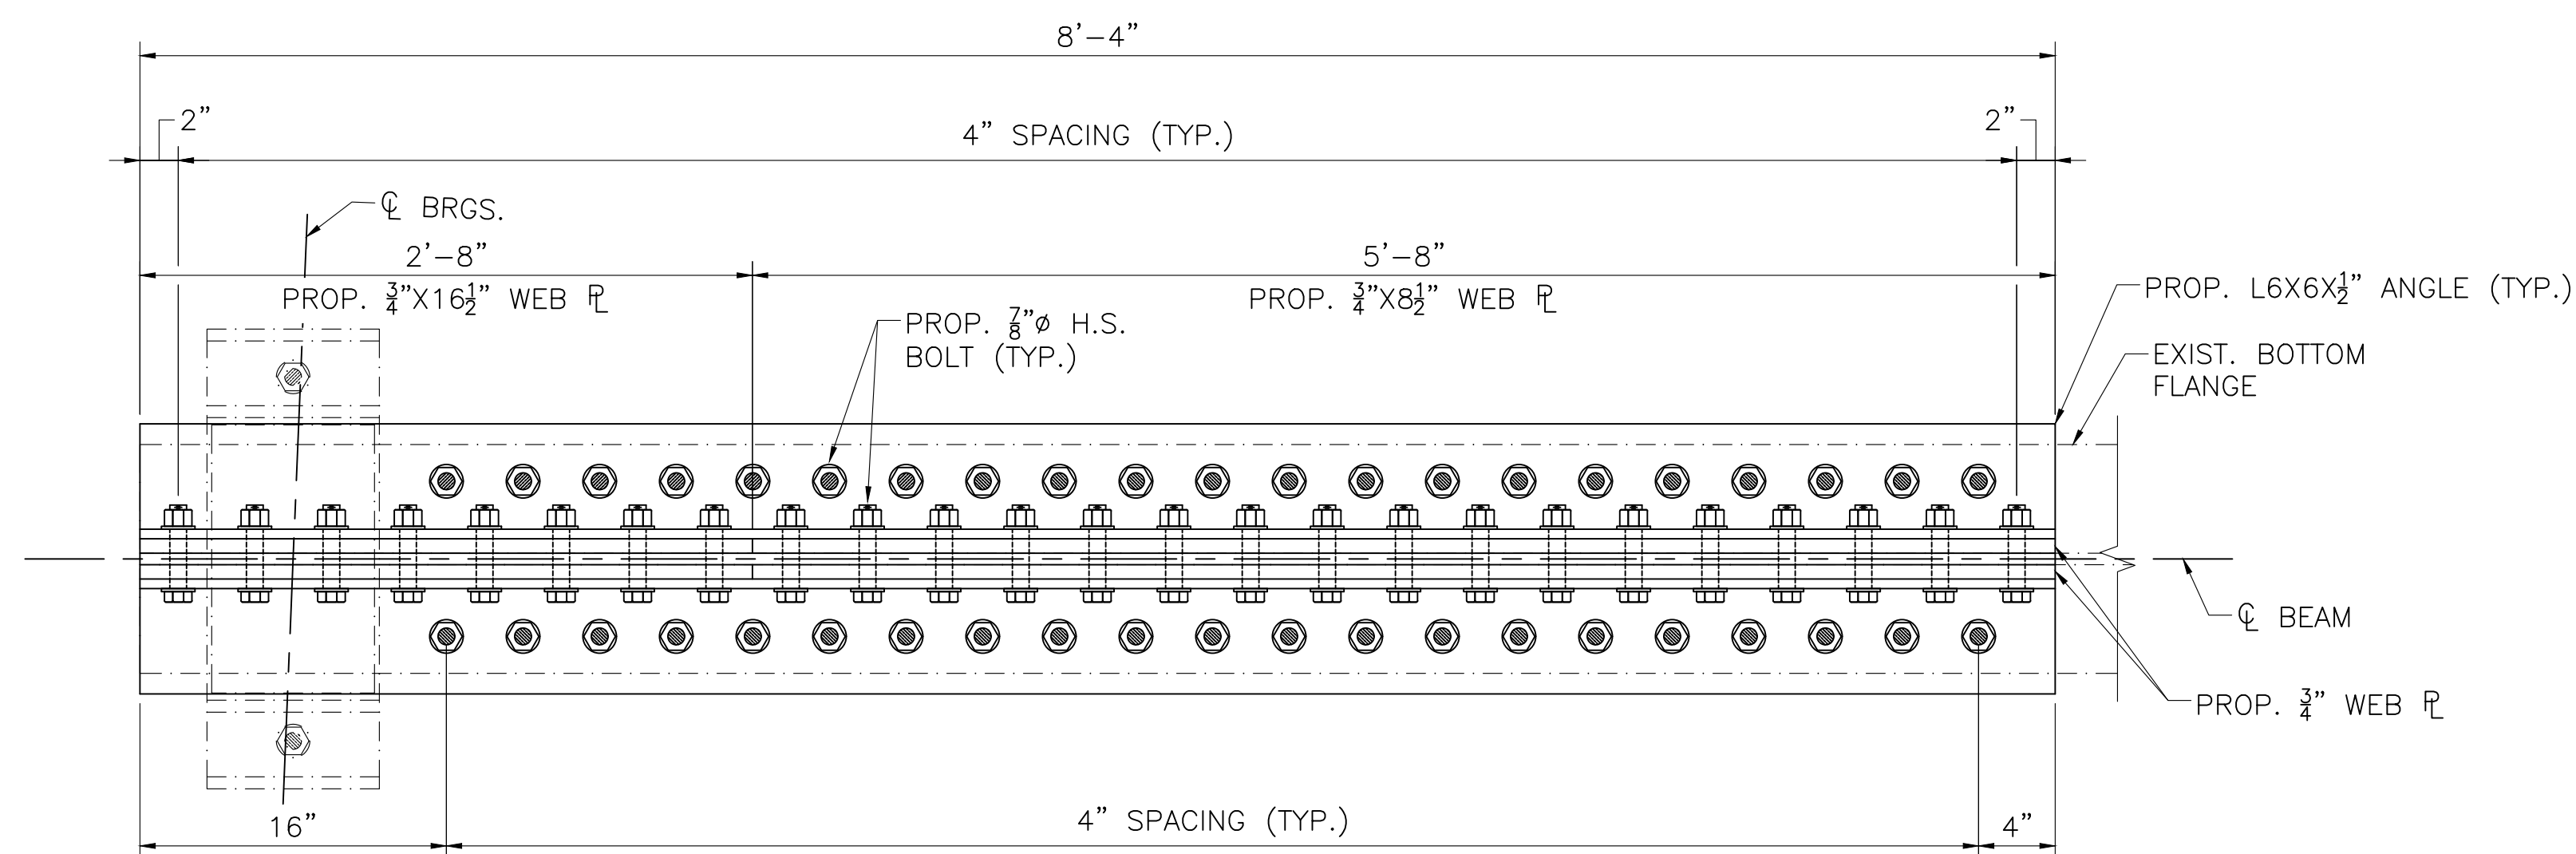


**SECTION 4**

SCALE: 1 1/2" = 1'-0"

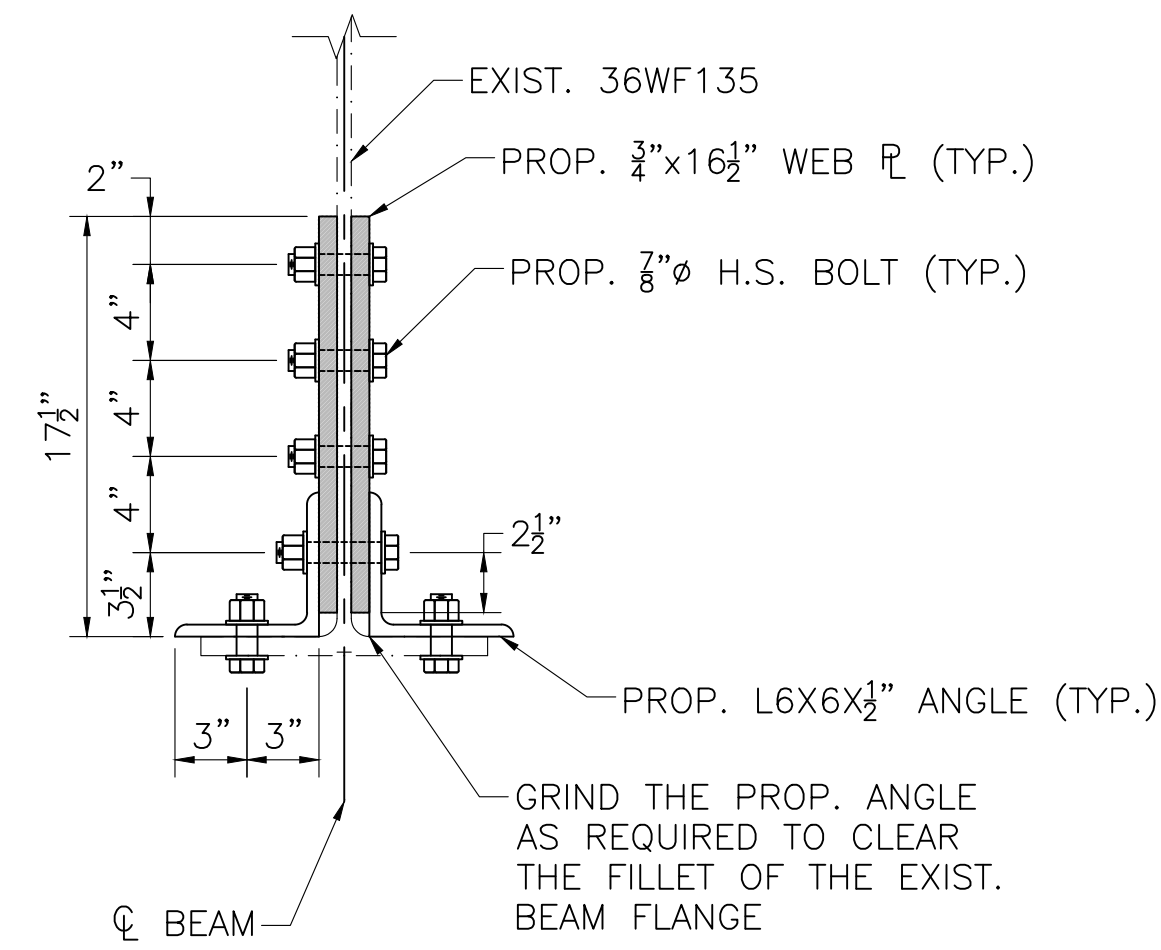

**SECTION 5**

SCALE: 1 1/2" = 1'-0"

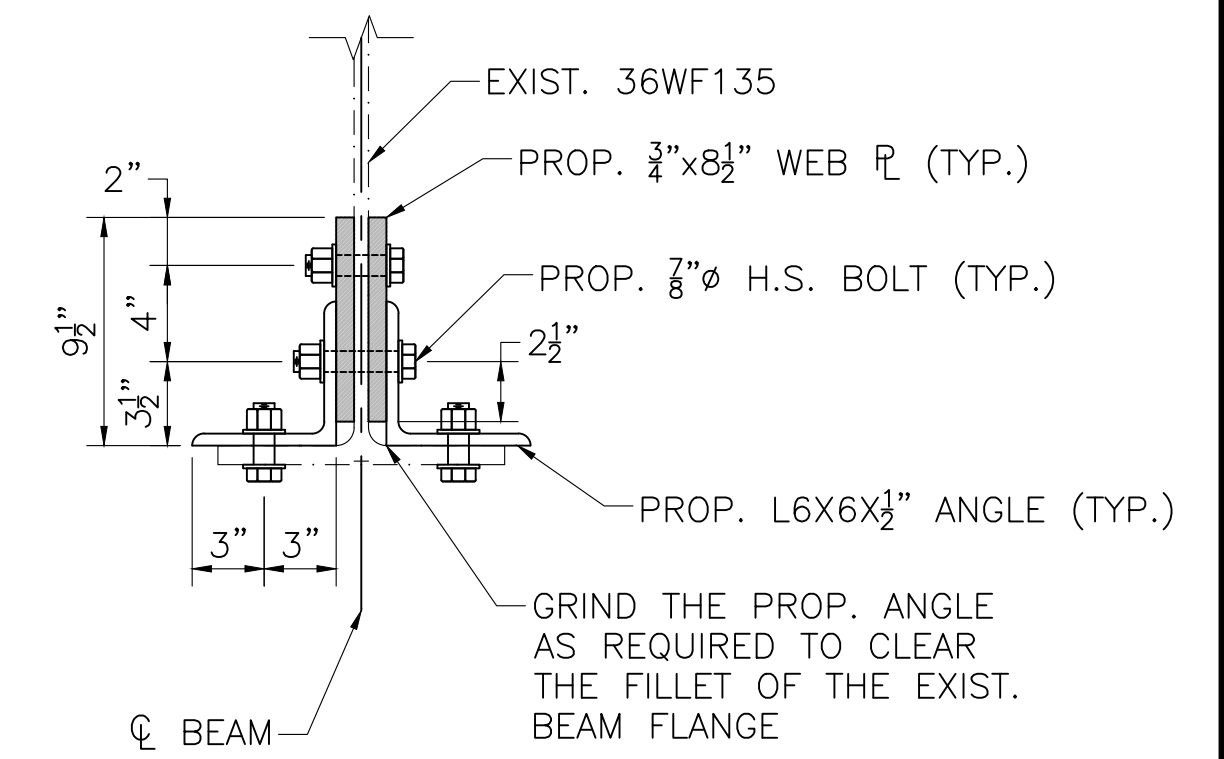

**SECTION 6**

SCALE: 1 1/2" = 1'-0"

<input checked="" type="checkbox"/>	Approved	Revise and resubmit
<input type="checkbox"/>	Approved as noted, Resubmission not required	Not Approved

**massDOT** Highway Division District 2 NORTHAMPTON

Signed: *[Signature]* Date: October 17, 2023

1. Approval of shop drawings indicates conformance with the concept of this project and general compliance with the contract documents.
2. Contractor is responsible for all dimensions and quantities, and for the details of fabrication, construction, and coordination of all trades and subcontractors.
3. Approval does not authorize changes to contract requirements unless authorized by prior letter or change order.

DATE	DRW BY	CALC BY	APPRV BY	DESCRIPTION
10/06/2023	SSW	SSW	JAC	ISSUED FOR CONSTRUCTION
10/19/2023	SSW	SSW	JAC	REV1: MESSOR COMMENTS ADDRESSED

REGISTERED PROFESSIONAL ENGINEER DATE








**BEAM END REPAIR PLANS**  
SPS NEW ENGLAND INC.  
BEAM END REPAIR PLANS  
W-21-047 (10W)  
I-91 OVER ROUTE 5 (RIVERDALE ST.)

**BEAM END REPAIR TYPE**  
C

INTERSTATE ROUTE 91 WEST SPRINGFIELD					
PUB. NO.	STATE	FED. AID PROJ. NO.	FISCAL YEAR	SHEET NO.	TOTAL SHEETS
1	MASS	I-91-1(64)B	19	57	188

**GENERAL NOTES**

- FOUNDATIONS**  
Foundations may be altered if necessary to suit Conditions encountered during Construction.
- DATE AND SEAL**  
To be located as shown on Sheet 6. A Sheet showing Size and Character of Numerals will be furnished. Seal to be furnished by the State and shall be set by the Contractor.
- DESIGN**  
In Accordance with the current AASHTO Specifications (1961 Edition) and Interim Specifications for H520-44 Loading, modified for military Loading.
- REINFORCEMENT**  
All Bars shall have Deformations conforming to A.S.T.M.A.-305. Unless otherwise shown on the Plans, Bars shall be lapped 70 diameters for Splices, except that Bars near the Top of Slab and Beams with more than 12 inches of Concrete under the Bars shall be lapped 35 diameters for Splices.
- BRIDGE RAILING**  
See Department Standard Plans dated May 1965, for Details of Bridge Railings, (1 Rail) Option
- SCALES**  
Scales noted on Plans are not applicable to reduced Size Prints. Divide Scales by 2 for 1/2-Size Prints.
- BENCH MARK**  
B.M.#7 - Top of Right outer Corner, Bottom Concrete Step, House #1162 Route 5, Sta. 101+38 & Route 5, 68' Rt. El. = 67.31. U.S.C. & G.S. Mean Sea Level of 1929.
- SURVEY BOOK NUMBERS**  
27361 & 27363.
- UNSUITABLE MATERIAL**  
All Unsuitable Material Shall be Removed Within the Limits of the Foundations of the Structure.
- ANCHOR BOLTS**  
All Anchor Bolts are to be Set by Template and Placed Before the Concrete is Poured.
- ESTIMATED QUANTITIES (NOT GUARANTEED)**
- | ITEM   | QUANTITIES   |
|--|--------------|
| Class 'B' Rock Excavation                          | 5 C.Y.       |
| Bridge Excavation                                  | 2360 C.Y.    |
| Gravel Borrow                                      | 1300 C.Y.    |
| Gravel Borrow for Bridge Foundations               | 2160 C.Y.    |
| Class I Bituminous Concrete Pavement, Type F1      | 55 Tons      |
| Class I Dense Protective Bottom Course for Bridges | 60 Tons      |
| Metal Bridge Railing (1 Rail) Option               | 229 L.F.     |
| Metal Bridge Railing - Type M-2                    | 71 L.F.      |
| Bridge Structure (W-21-45)                         | 1 L.S.       |
| Steel Reinforcement for Structures                 | 124,500 lbs. |
| Structural Steel                                   | 202,000 lbs. |
- The Following Quantities are Included in Item 539.01

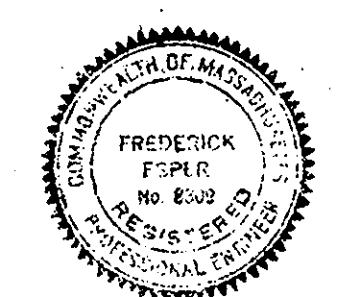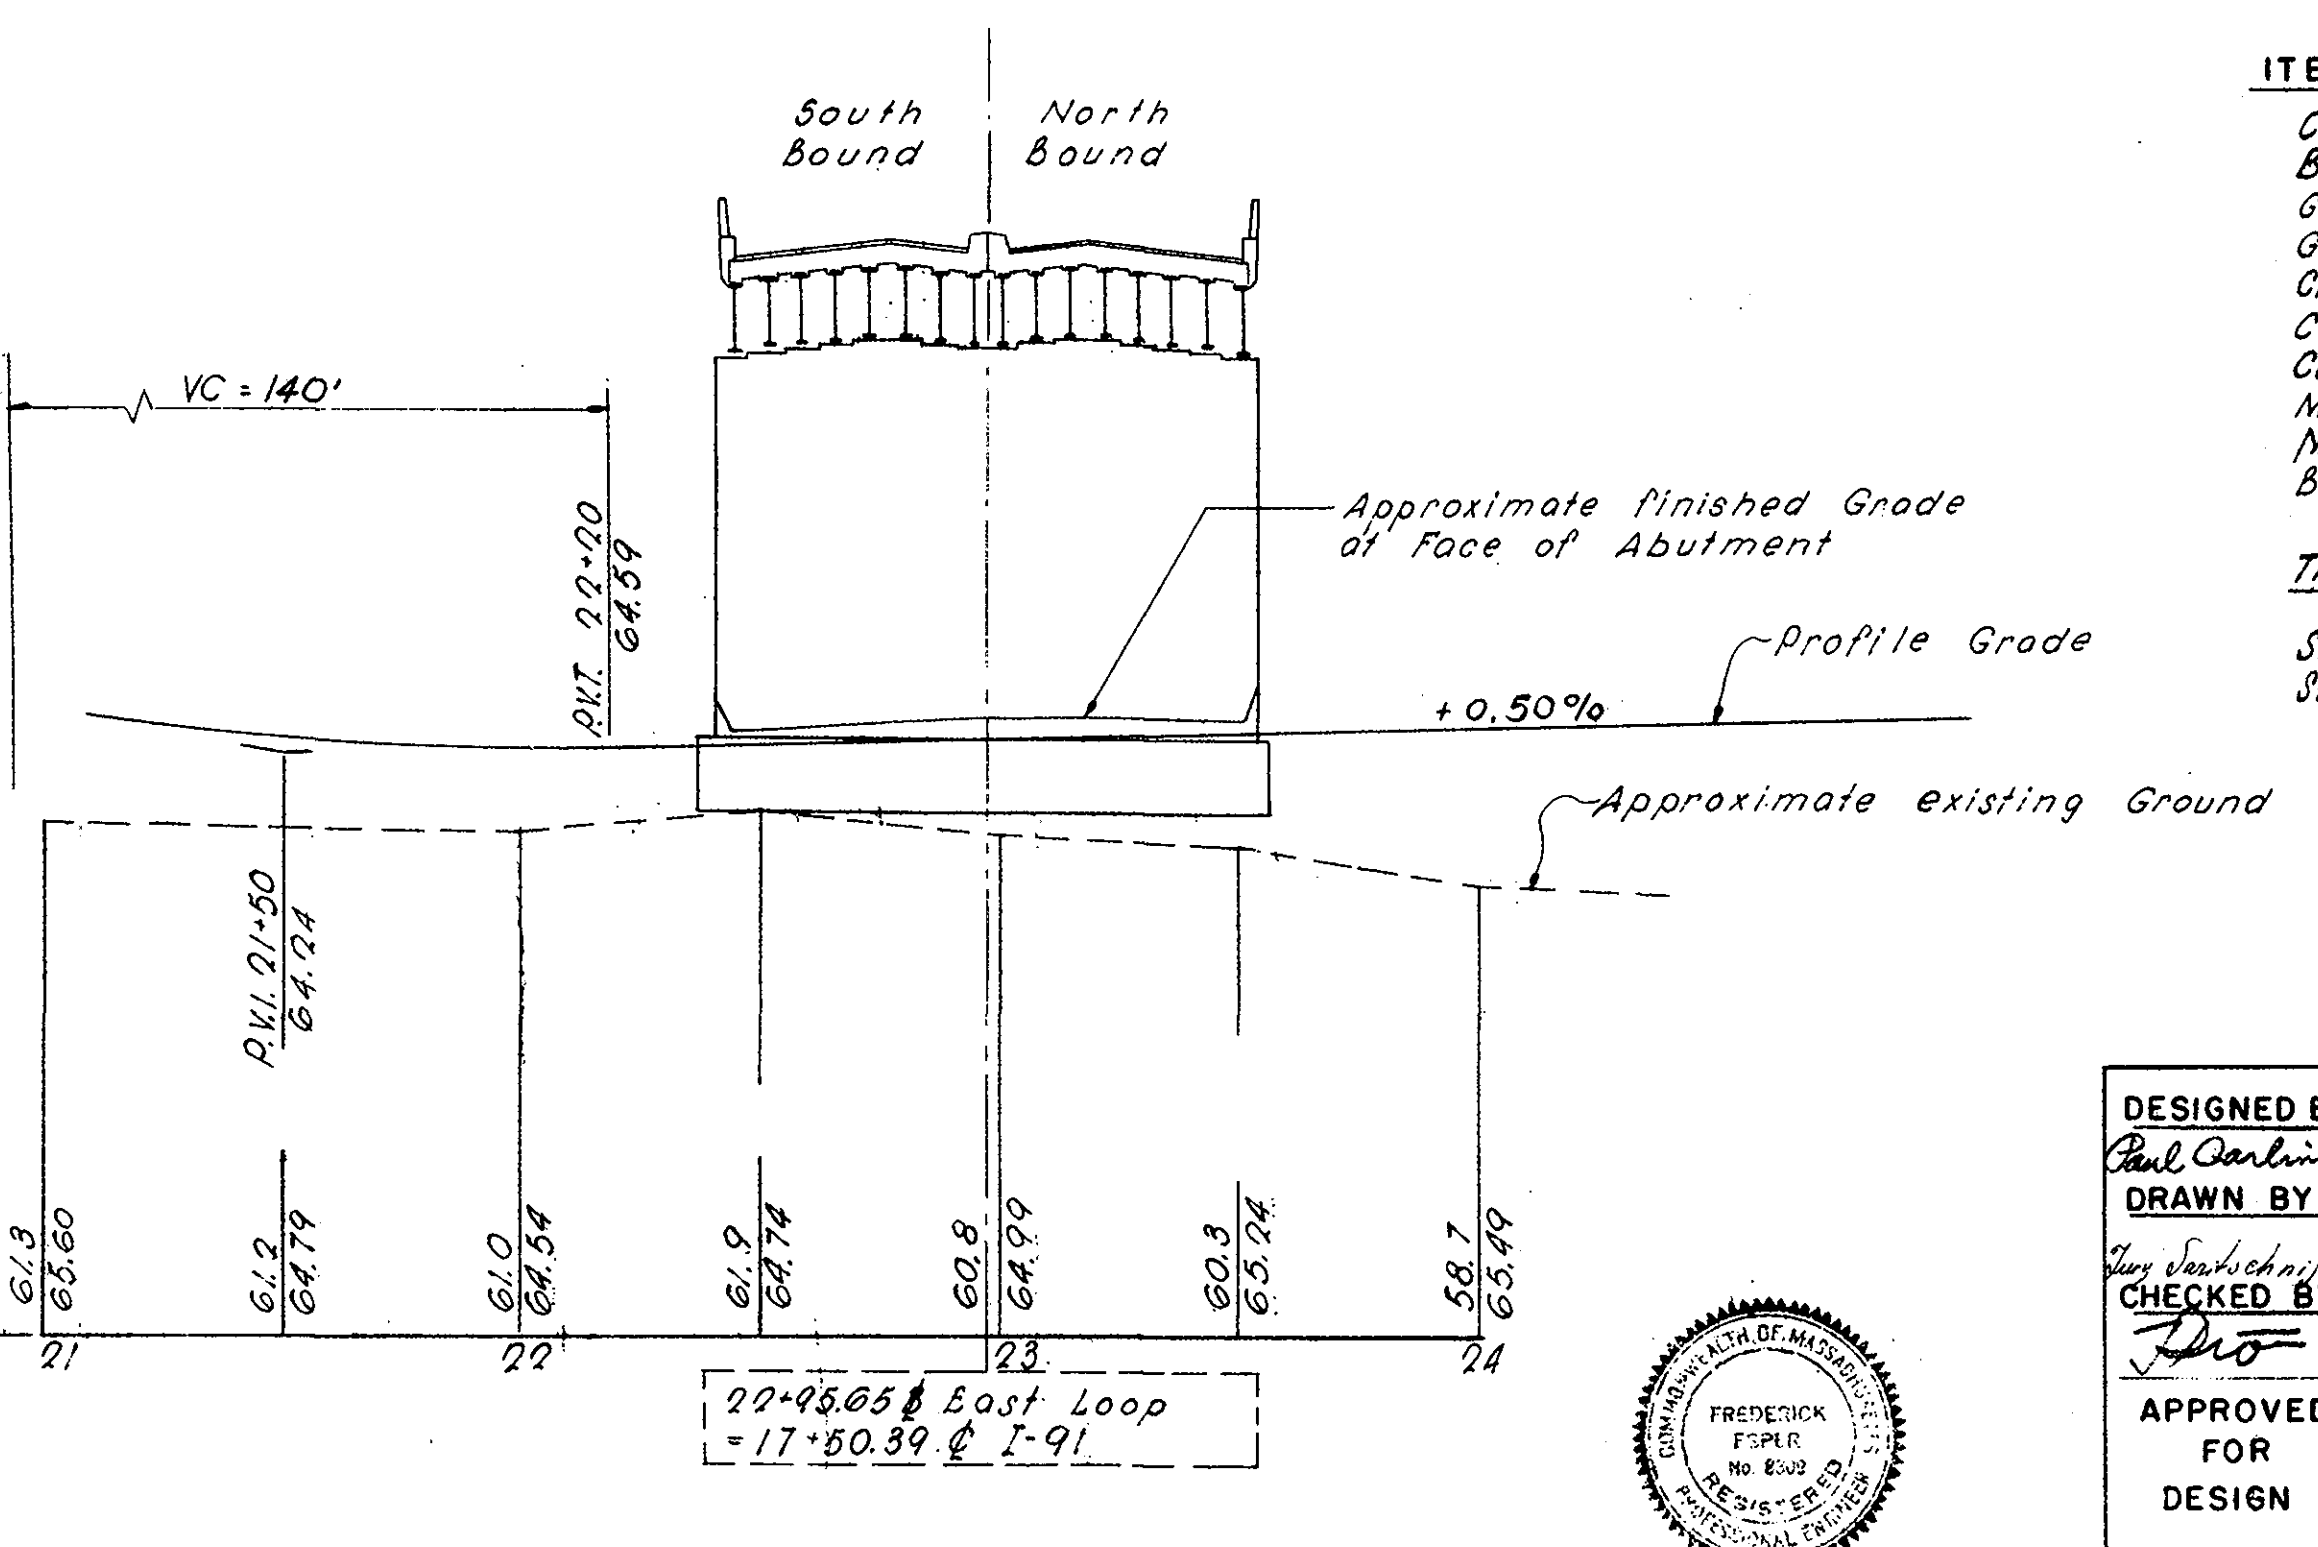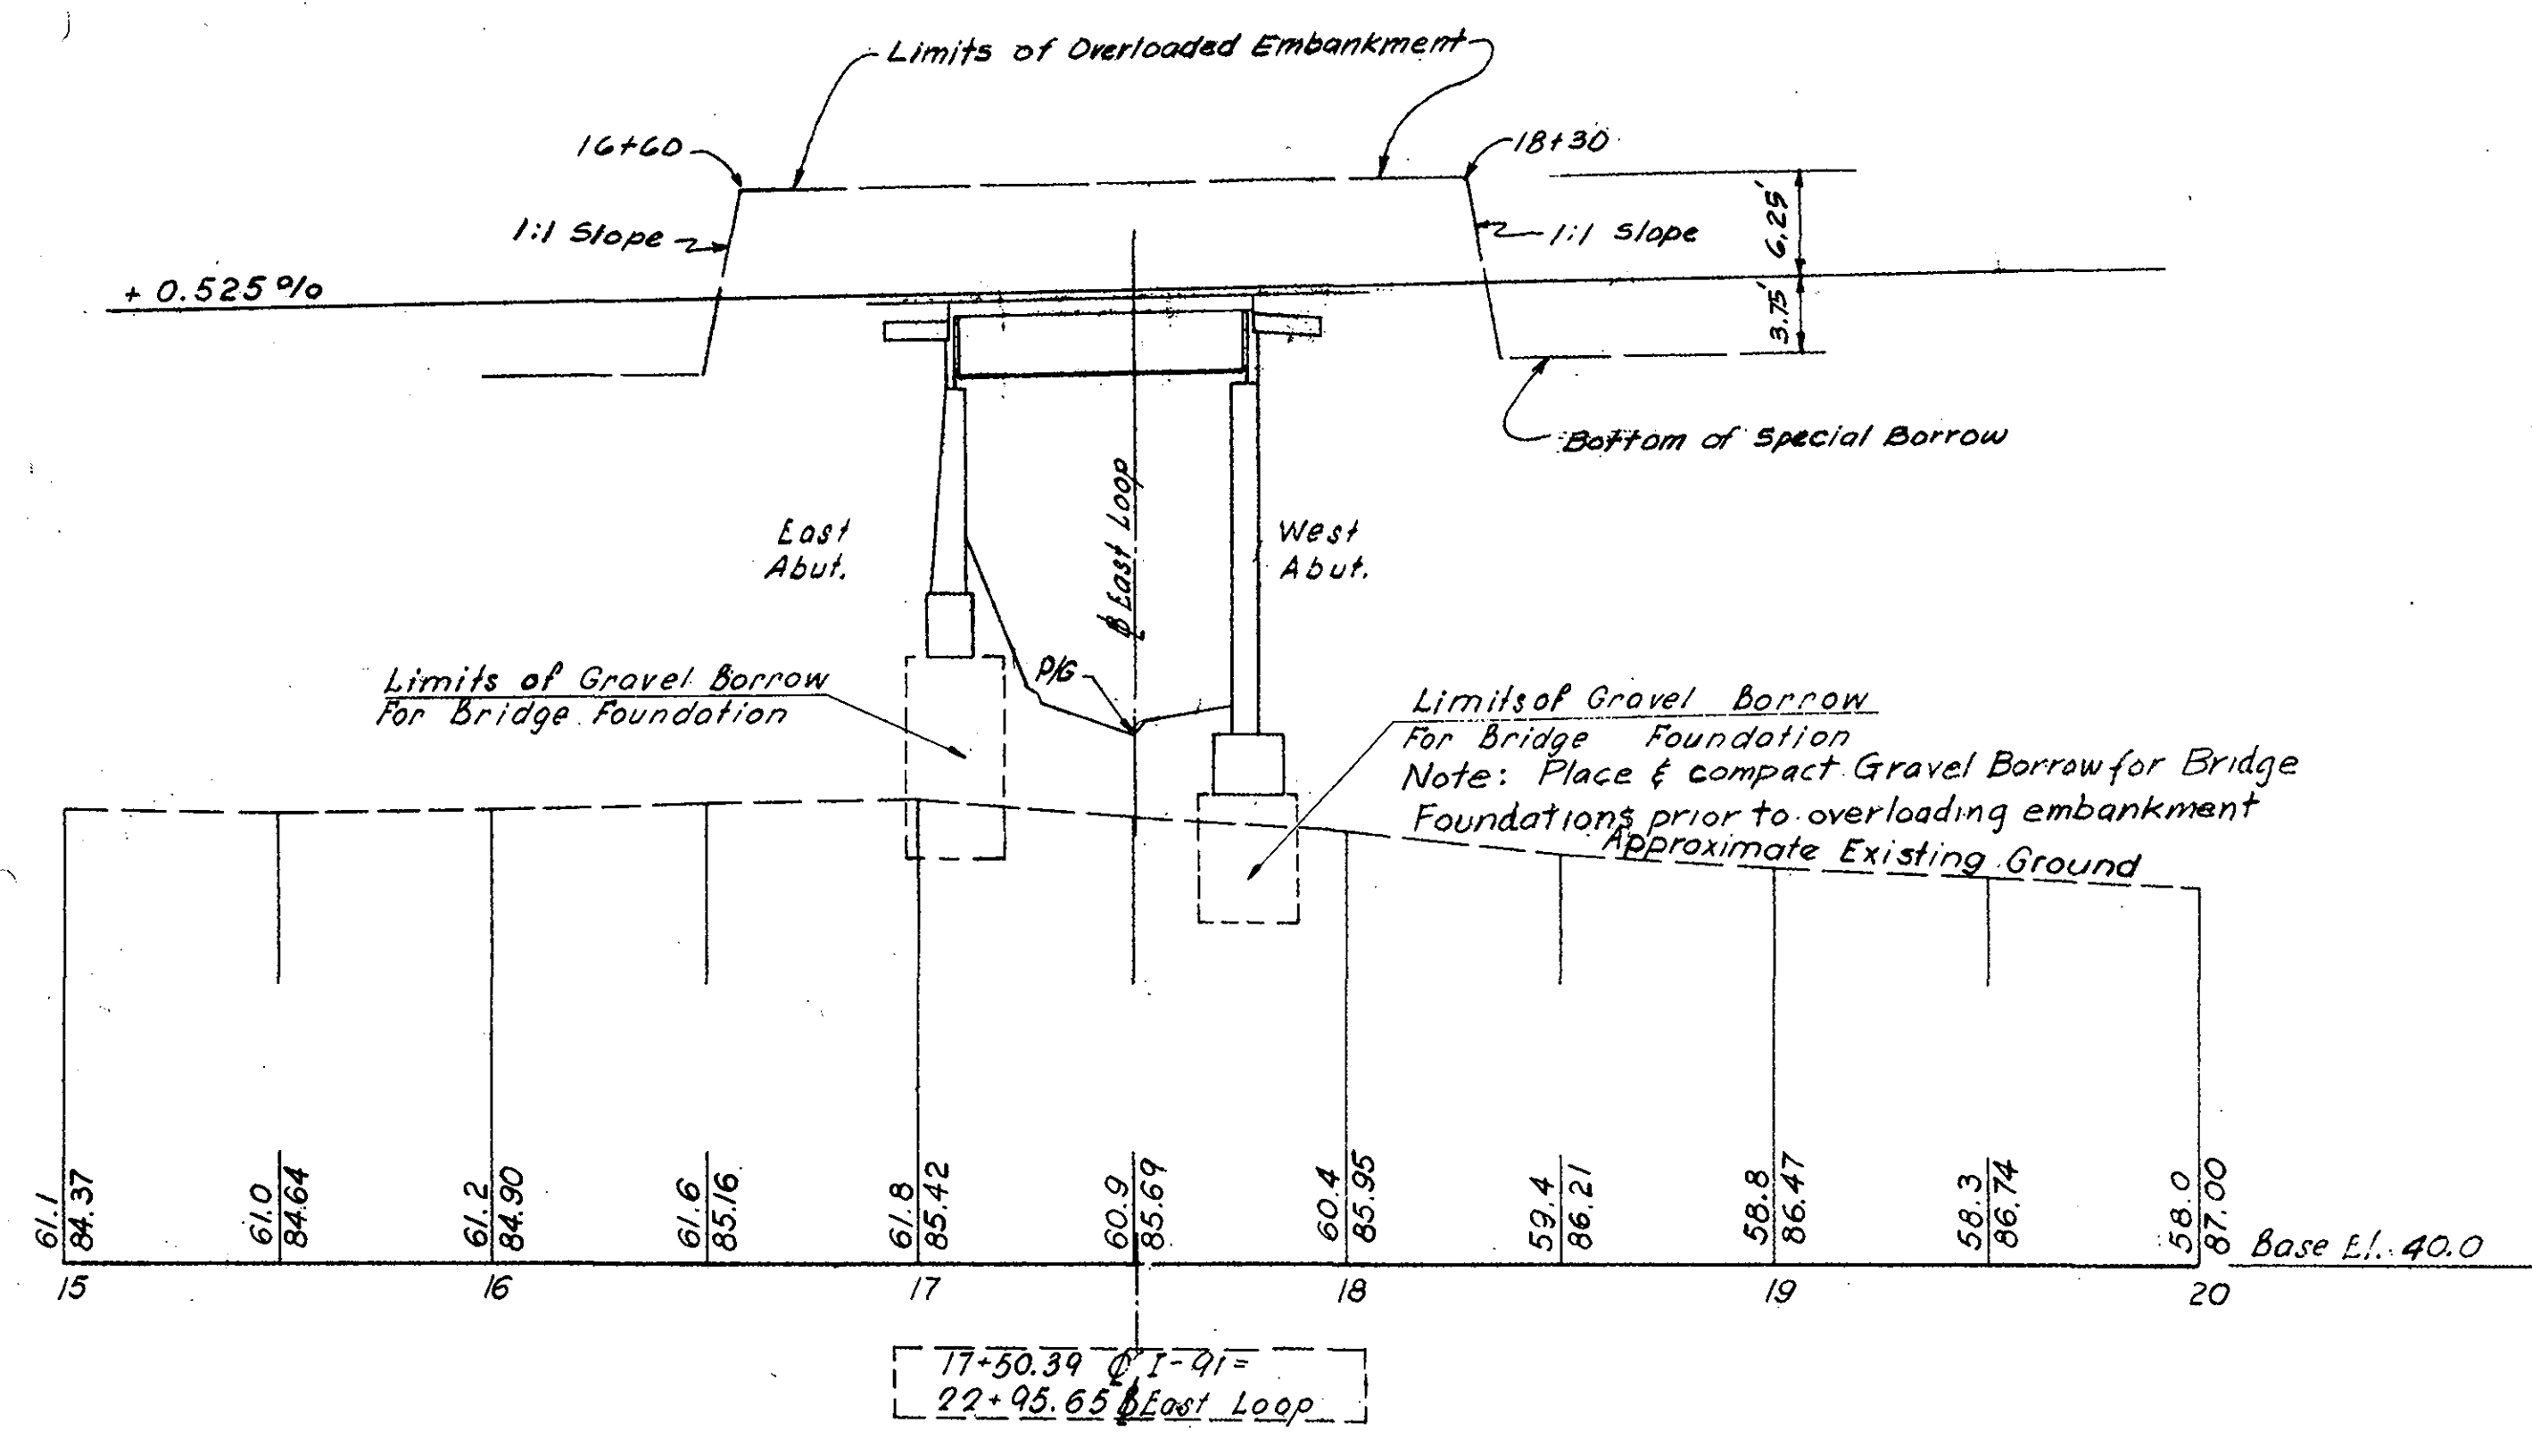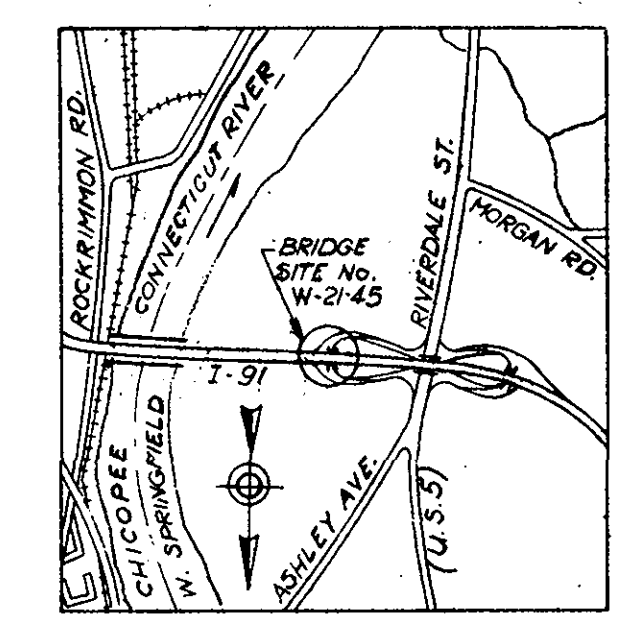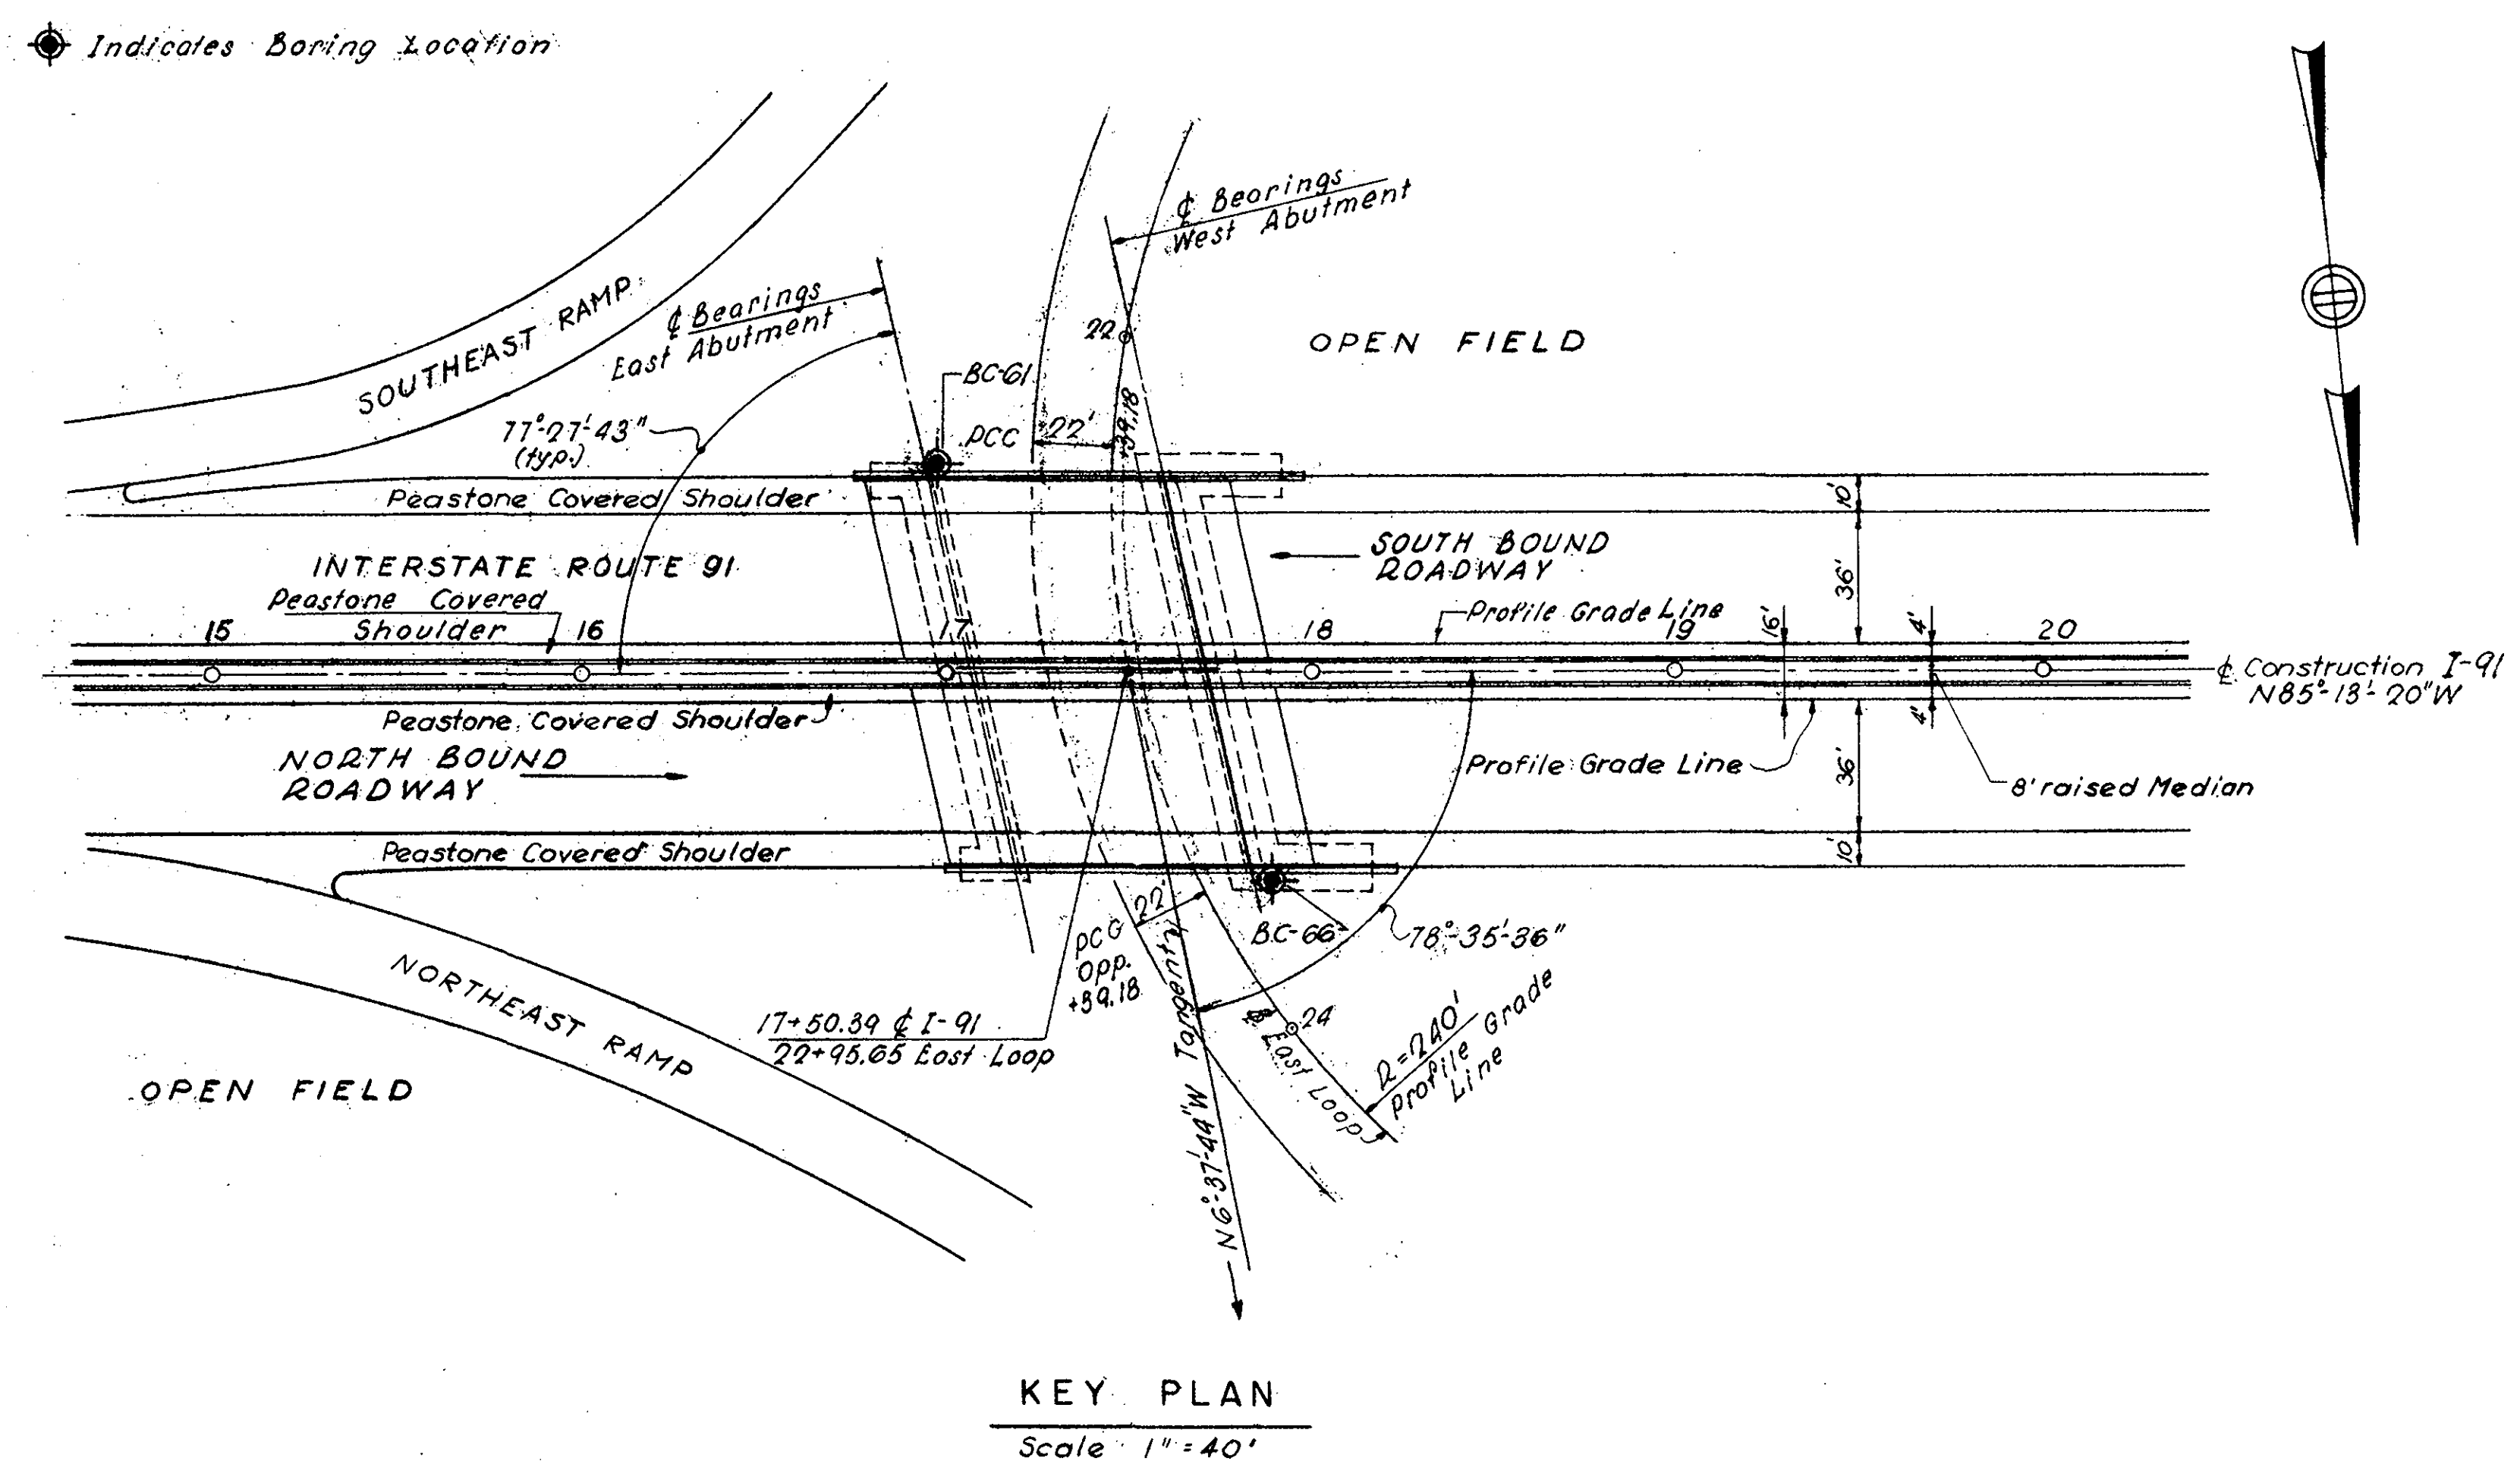

LOUIS BERGER & ASSOCIATES  
CONSULTING ENGINEER  
WELLESLEY HILLS, MASS.

DESIGNED BY Paul Carlino  
DRAWN BY [Signature]  
CHECKED BY [Signature]  
APPROVED FOR DESIGN [Signature]

APRIL 9, 1966 ISSUED FOR CONSTRUCTION.

THE COMMONWEALTH OF MASSACHUSETTS  
PROPOSED BRIDGE  
WEST SPRINGFIELD MASS  
INTERSTATE ROUTE 91  
INTERSTATE ROUTE 91 OVER EAST LOOP  
(AT ROUTE 5)  
SCALES AS NOTED

OFFICE OF  
DEPARTMENT OF PUBLIC WORKS  
100 NASHUA ST. BOSTON, MASS.  
APR 1966

BRIDGE ENGINEER [Signature] CHIEF ENGINEER [Signature]

BC-61  
5/19/65  
El. 62.1

El. 68.50' Batt. of Footing  
East Abutment


60

40

20

0

-20

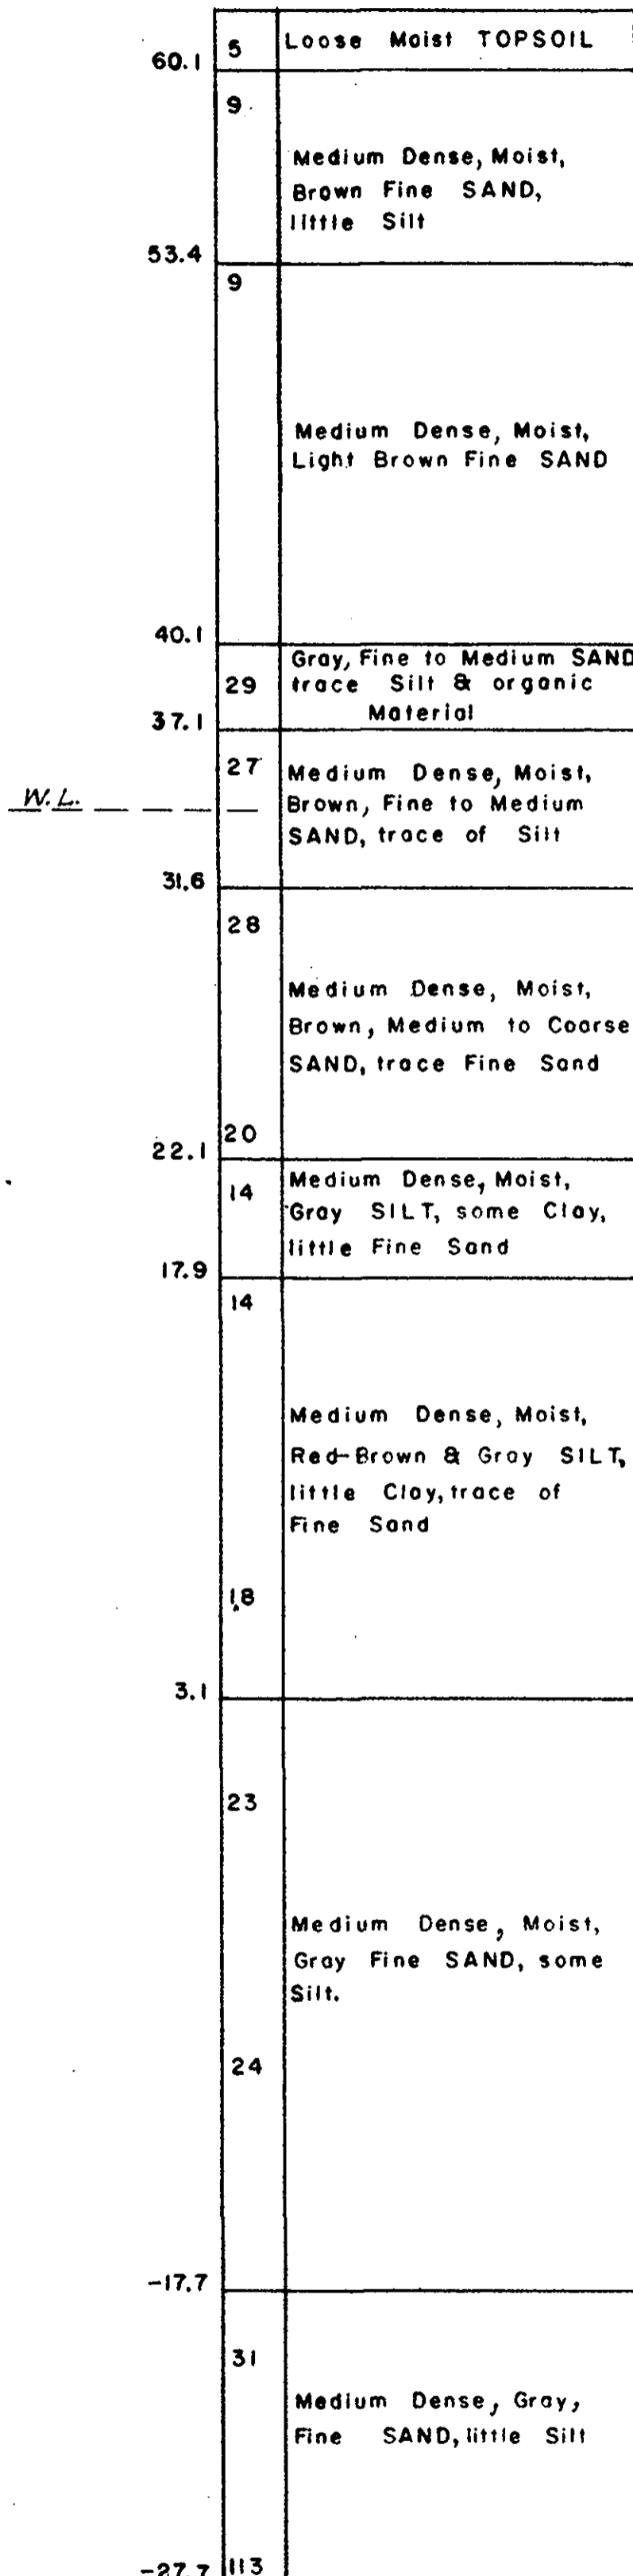

Bottom of Boring 89.8'  
Refusal  
Water El. 34.1

BORING DATA  
Scale: 3/8" = 1'0"

BC-66  
5/21/65  
EL 60.2

El. 62.00' Batt. of Footing  
West Abutment


57.2

23.2

4.2

-30.3

W.L. ---

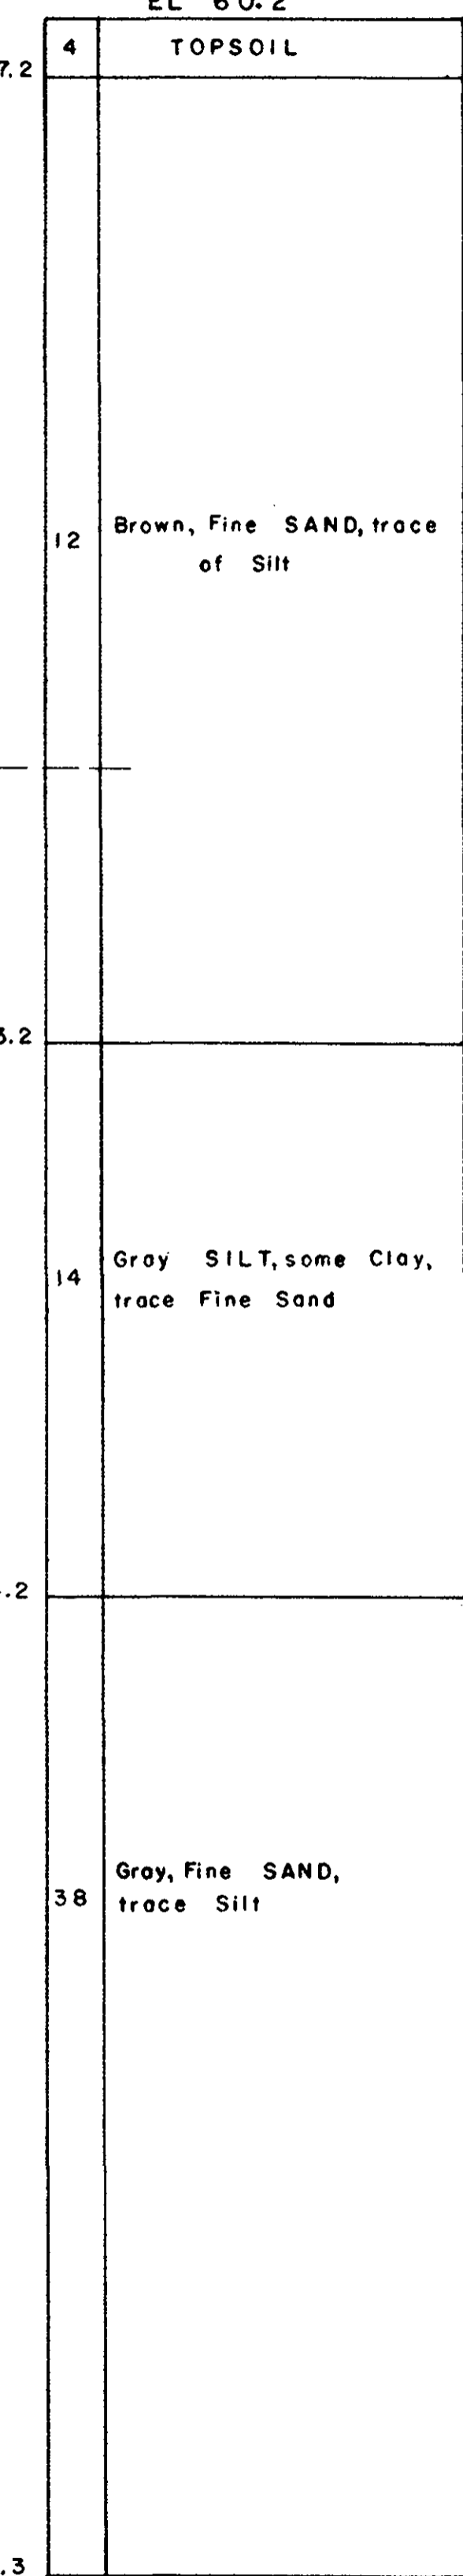








Bottom of Boring 90.5'  
Refusal  
Water El. 34.2

**BORING NOTES**

Location of Borings shown on Key Plan. Sheet 1 thus: BC-61. BC indicates a Bridge Core Boring. Borings taken for purpose of Design & show conditions at Boring Points only but do not necessarily show Nature of Material to be encountered during construction. Figures in left hand column indicate Number of Blows required to drive 2" O.D. Sampler 12" using 140lb. weight falling 30". Borings were made by Allstate Drilling Co. 227 Wampanoag Trail, Riverside, R.I., May 1965. Boring Samples may be seen at the Research and Material Division, 99 Worcester Street, Wellestey Hills, at the intersection of Route 9 and Route 128, by appointment only. Water levels shown on the Borings Logs were observed at the time of taking borings and do not necessarily show the true ground water level.

APRIL 9, 1966	ISSUED FOR CONSTRUCTION
DATE	DESCRIPTION
USE ONLY PRINTS OF LATEST DATE	



INTERSTATE ROUTE 91 WEST SPRINGFIELD					
PUB. NO.	STATE	FED. AID PROJ. NO.	FISCAL YEAR	SHEET NO.	TOTAL SHEETS
1	MASS.	1-91-1 (54)	19	59	188

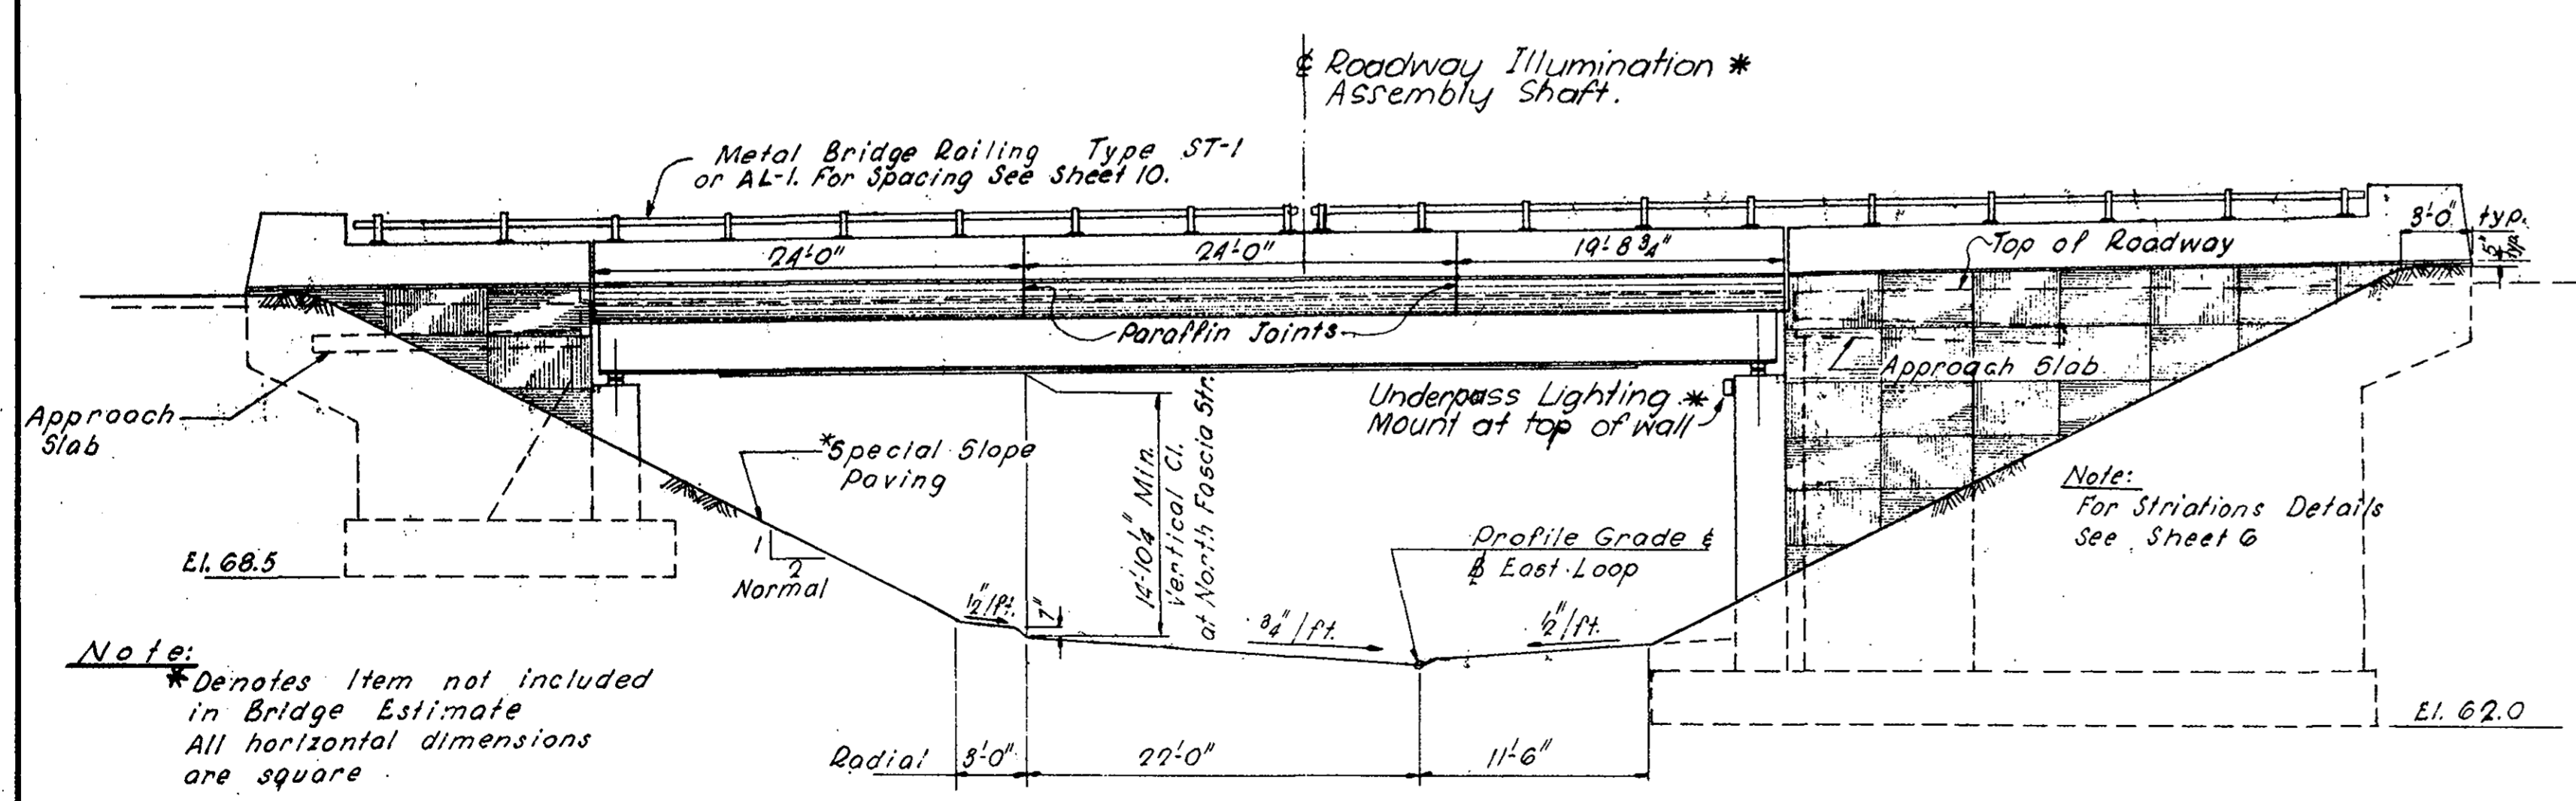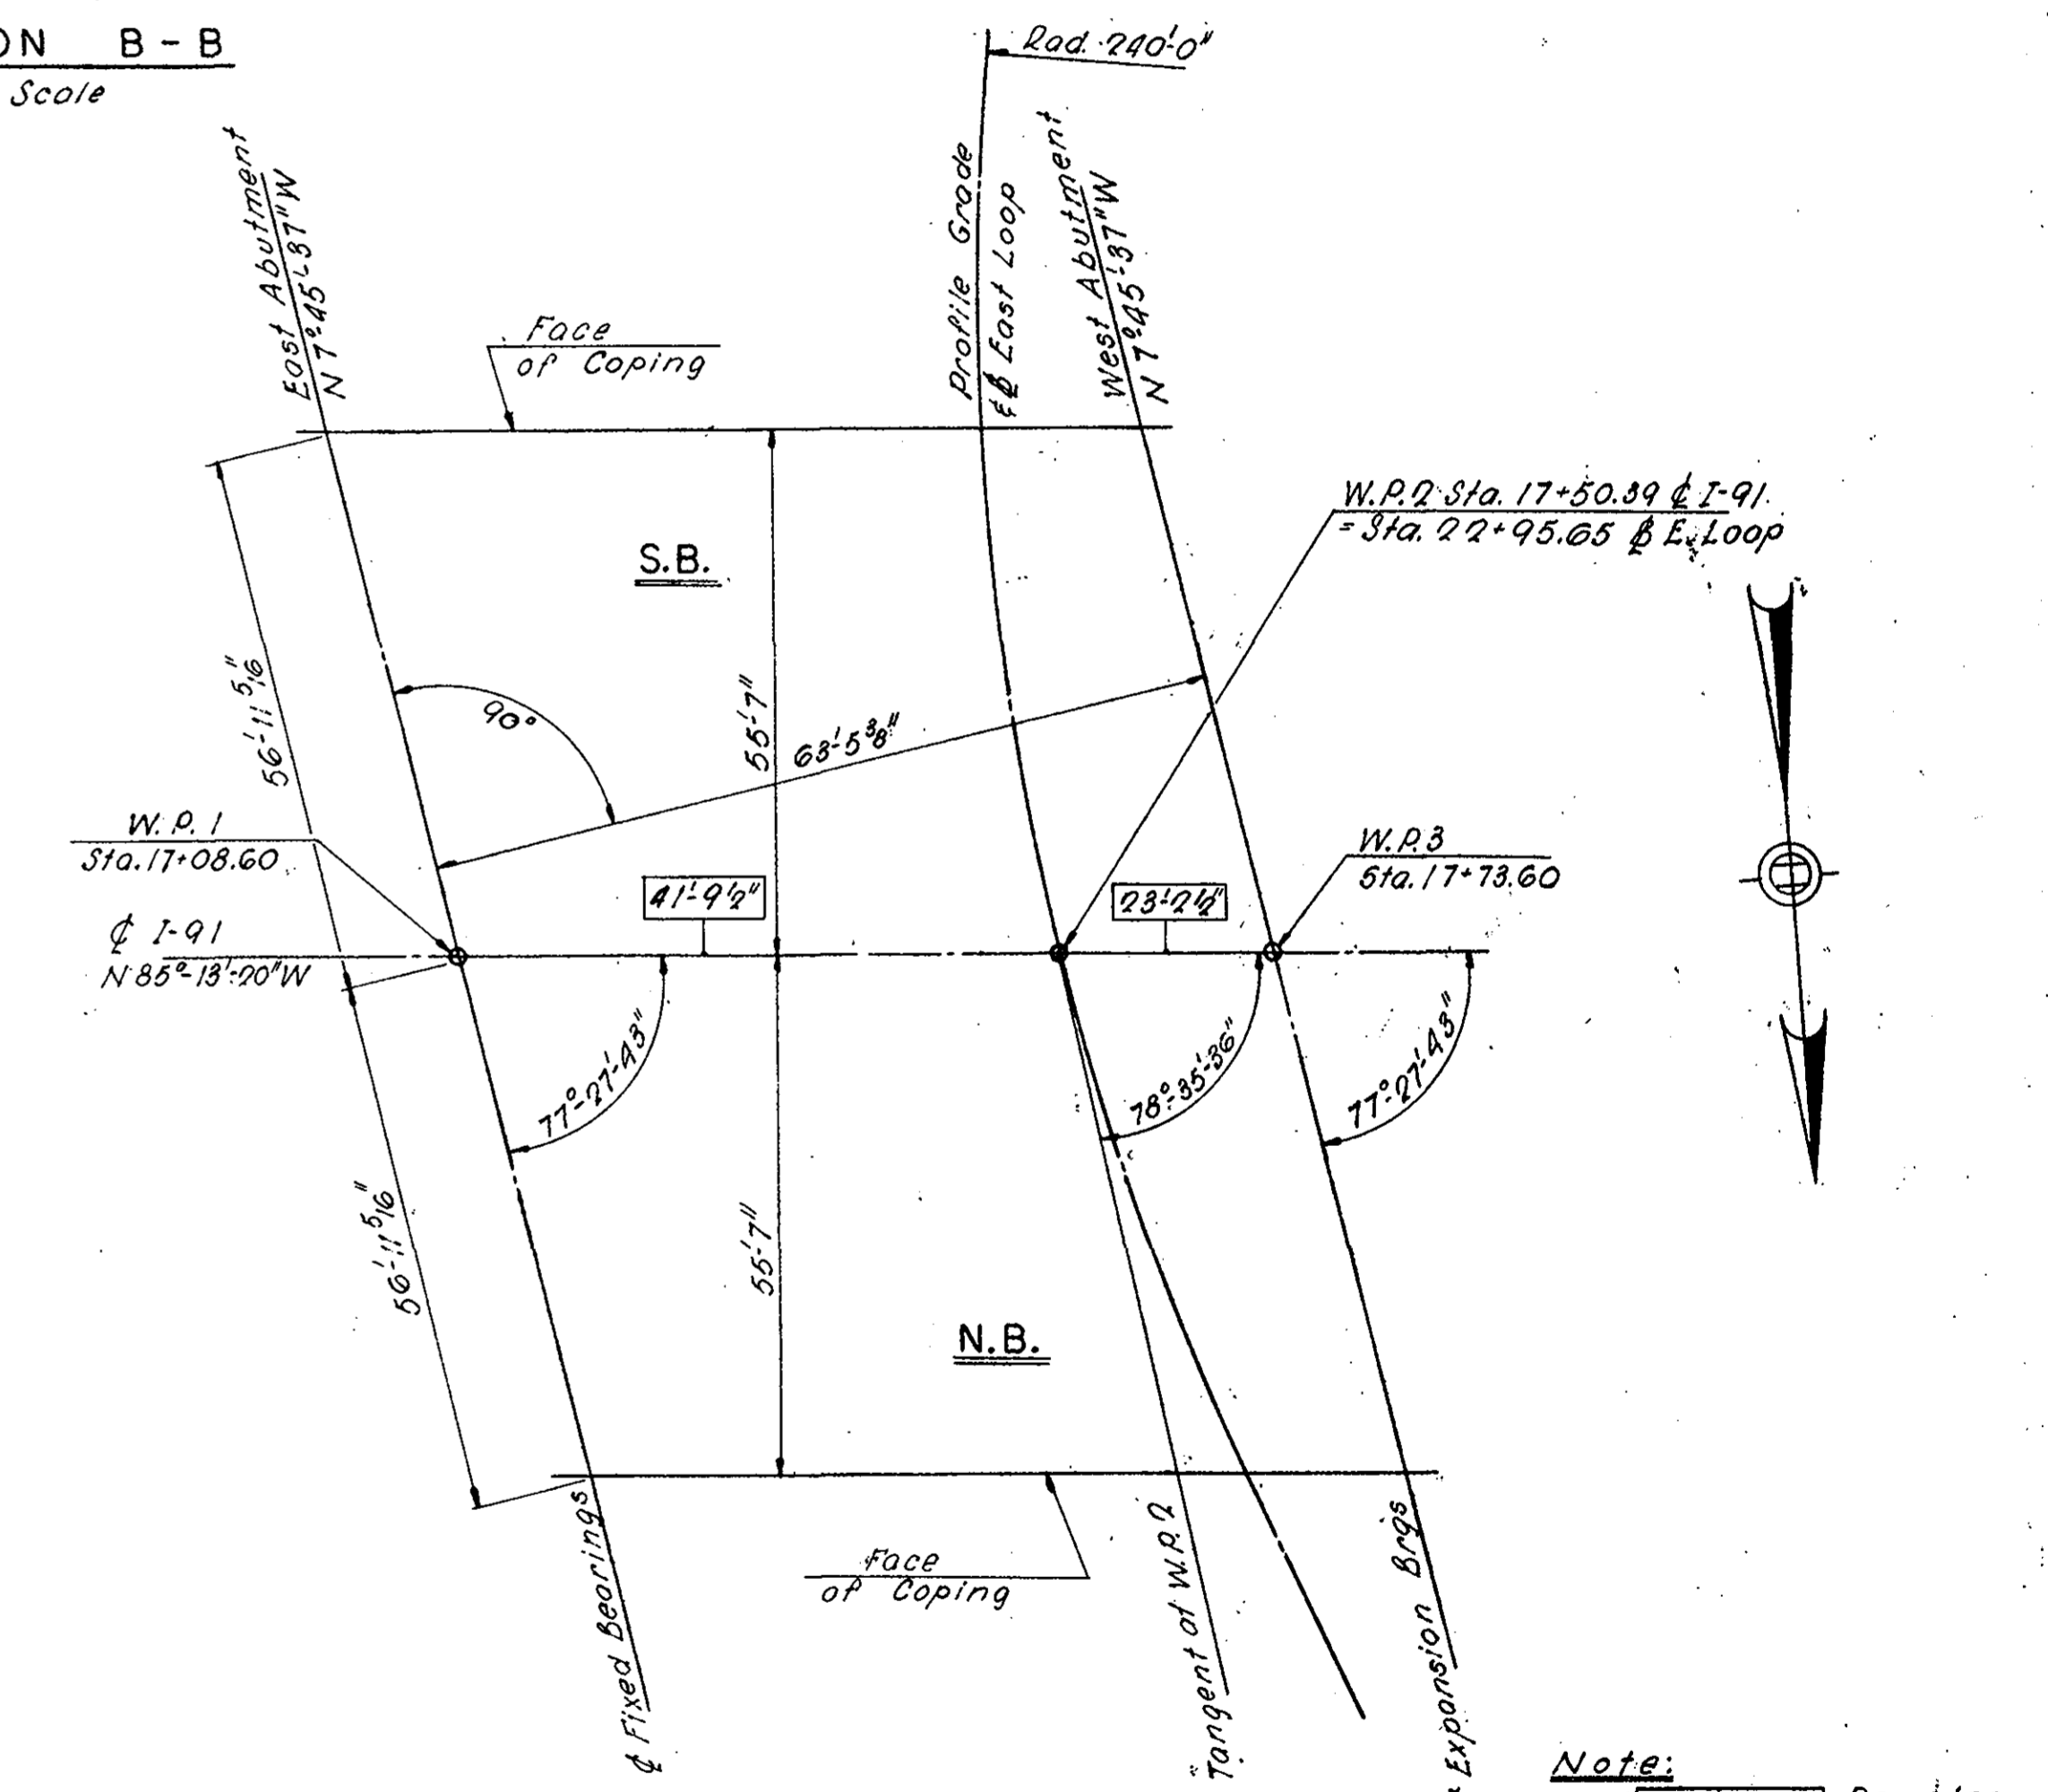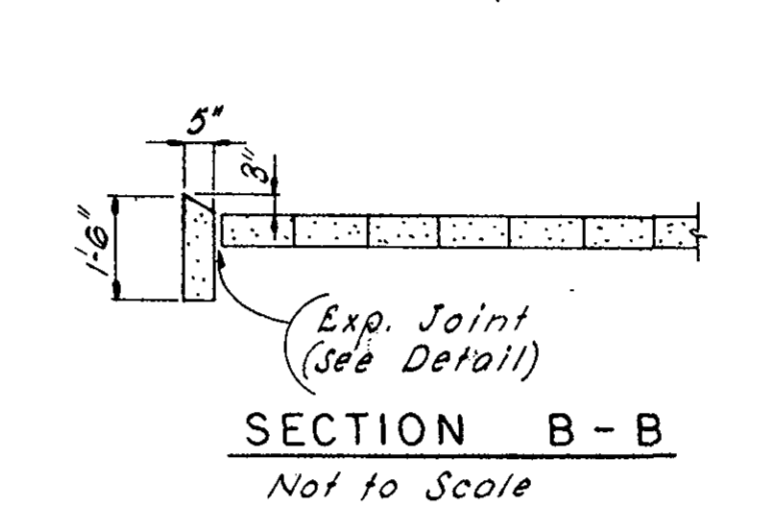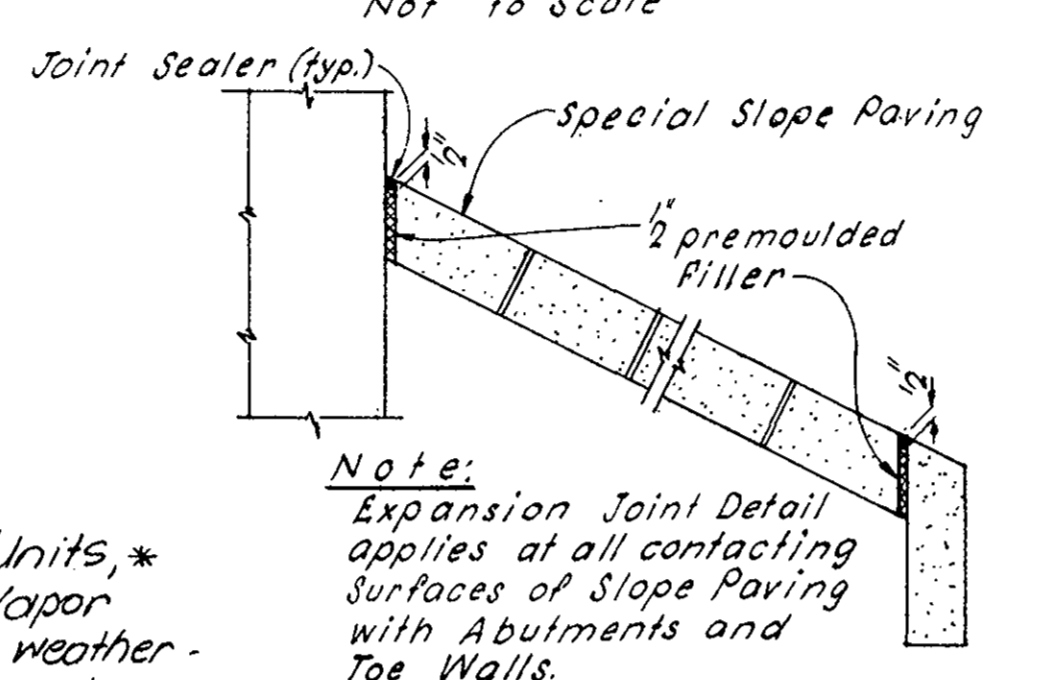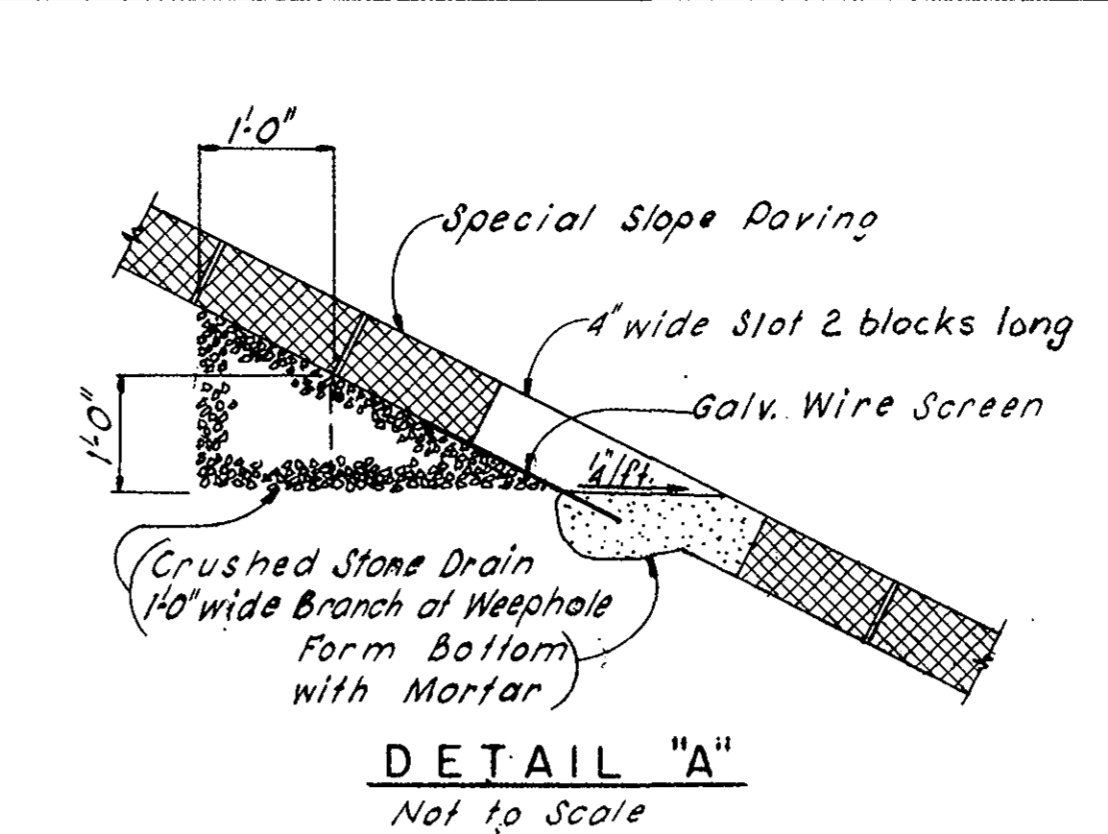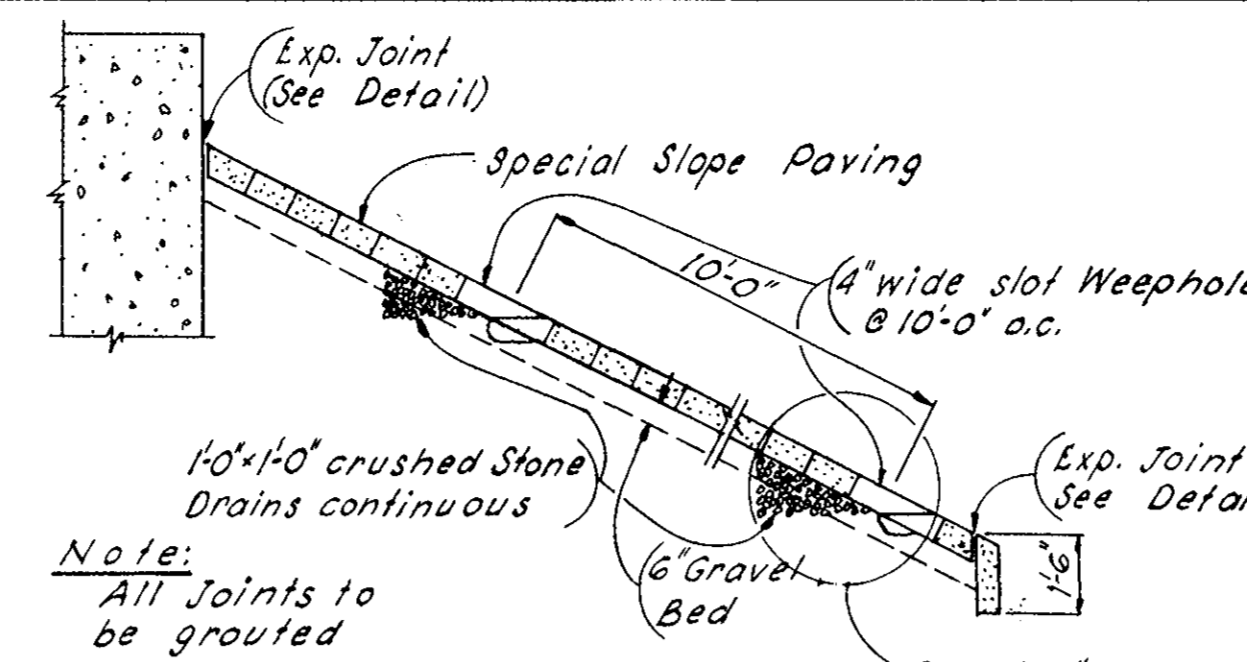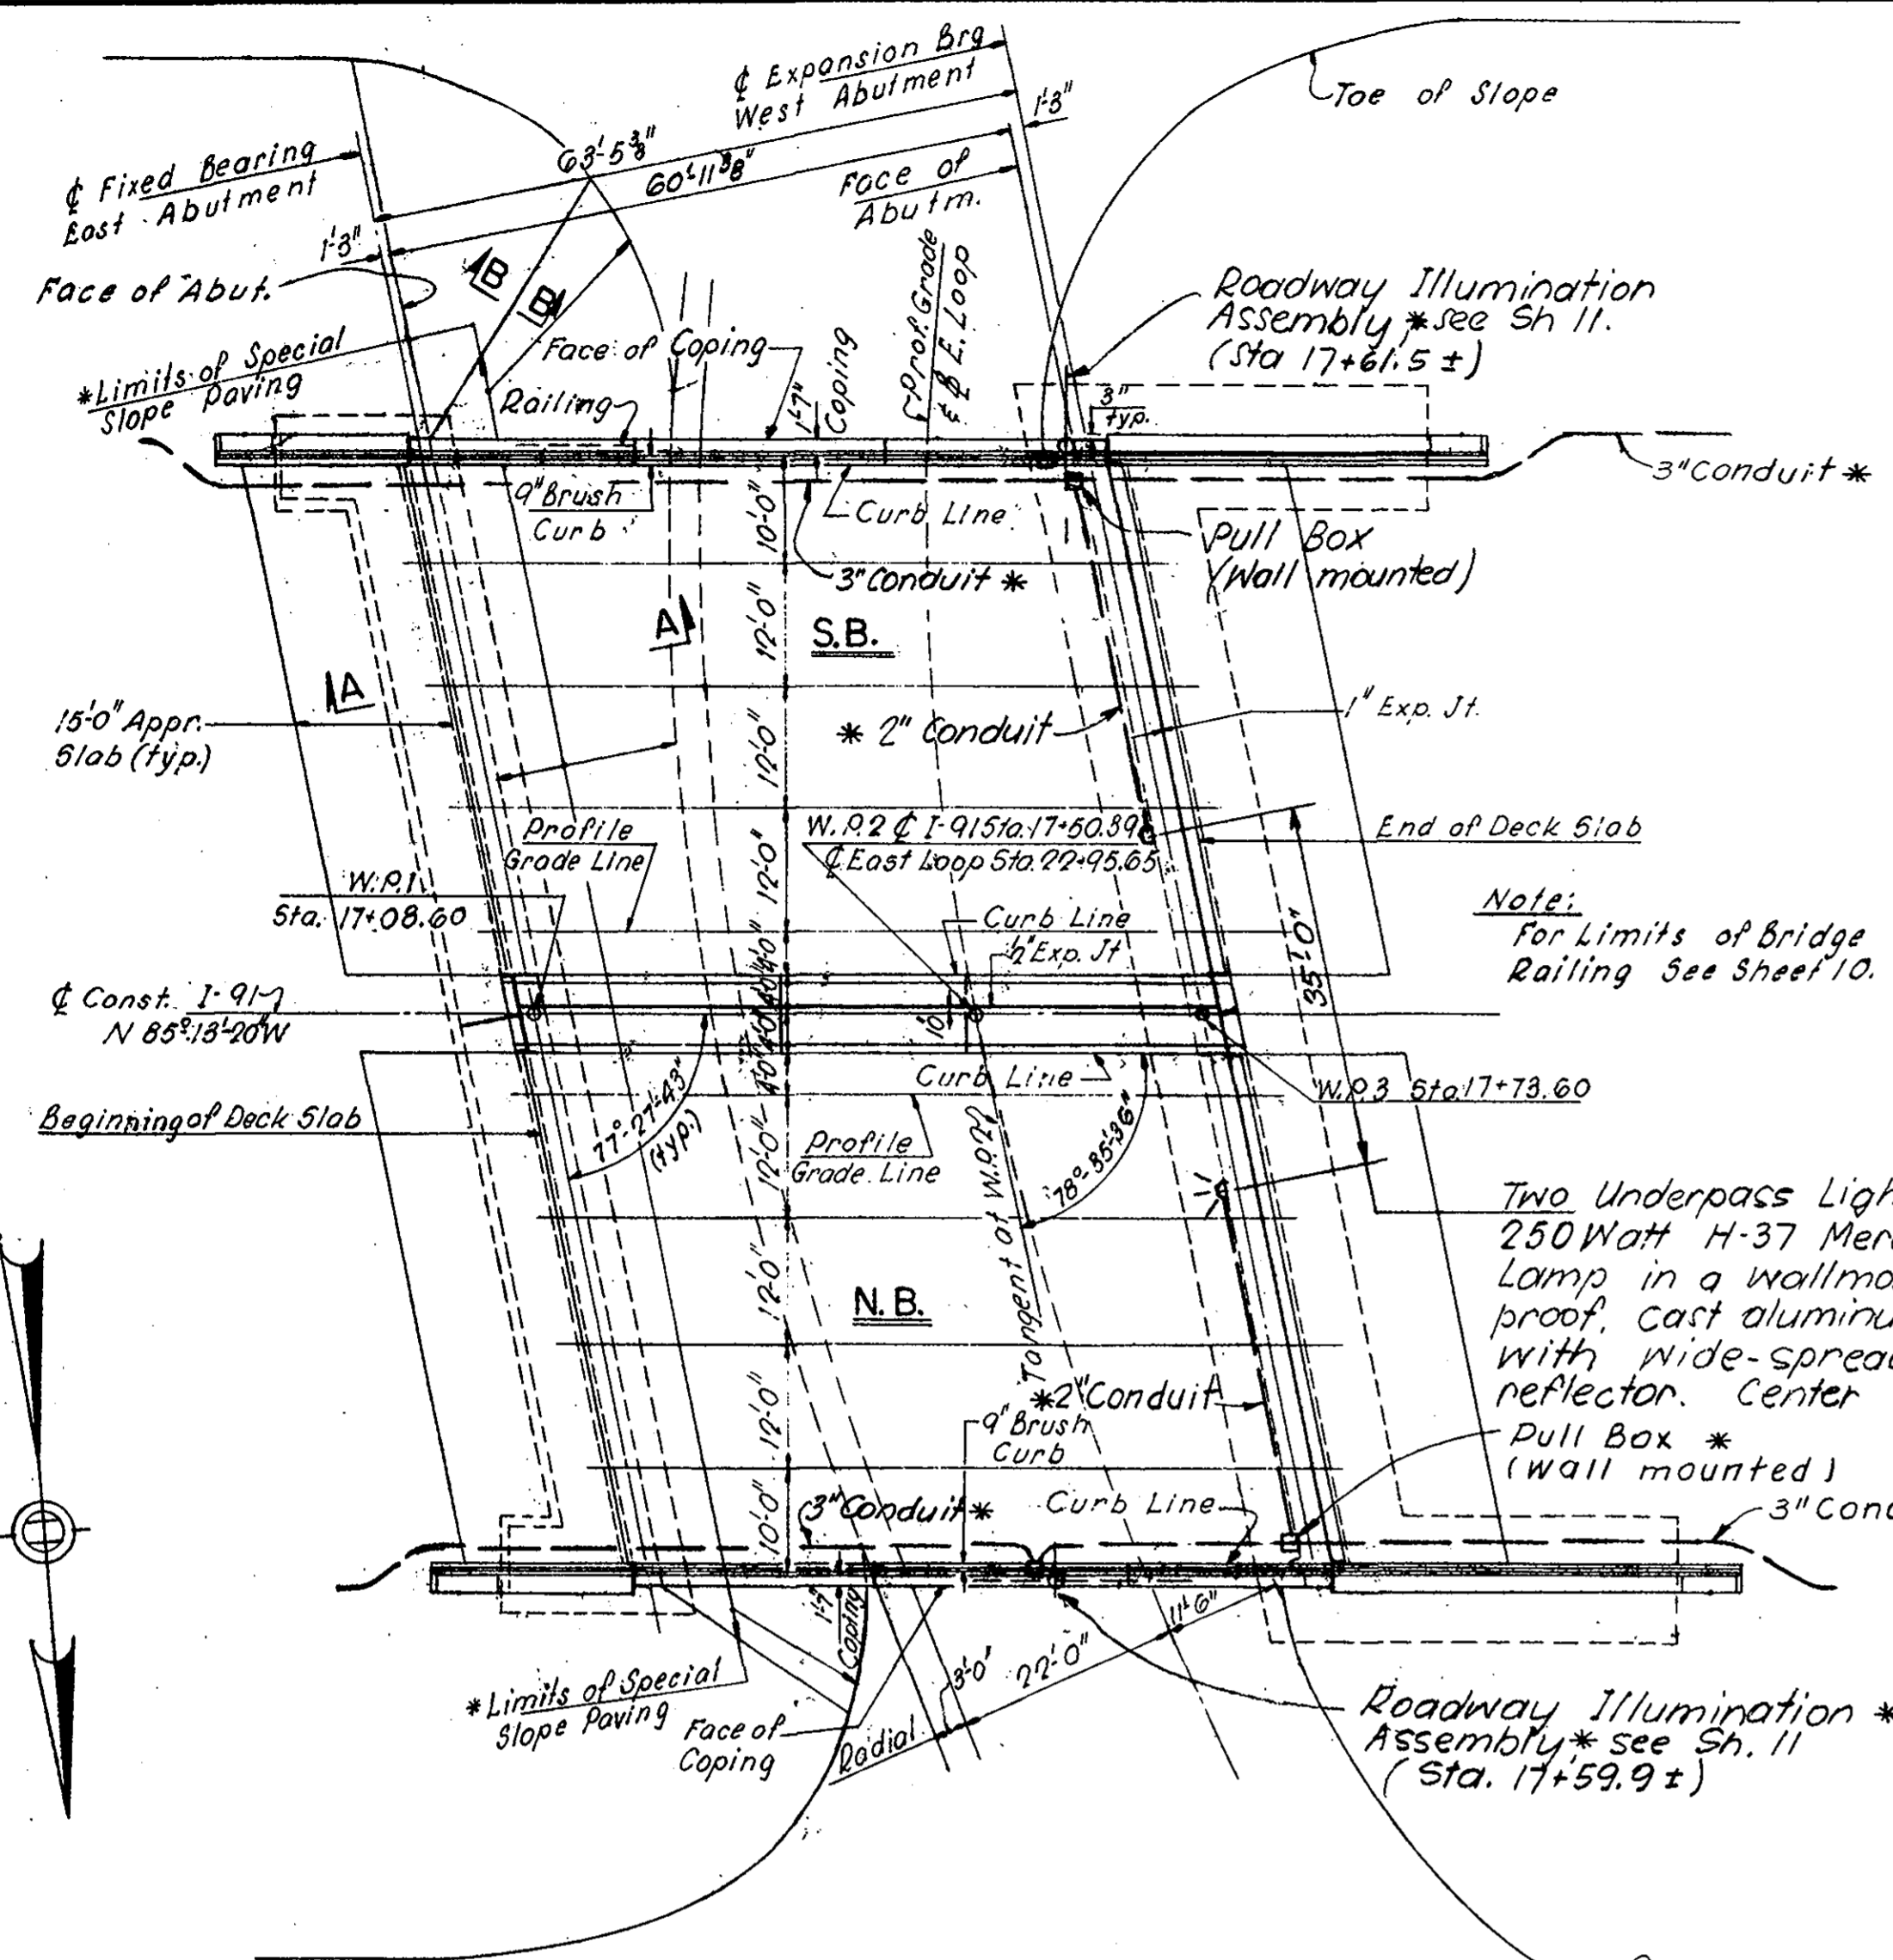


DATE	DESCRIPTION
APRIL 9, 1966	ISSUED FOR CONSTRUCTION
	USE ONLY PRINTS OF LATEST DATE




INTERSTATE ROUTE 91 WEST SPRINGFIELD					
PUB. NO.	STATE	FED. AID PROJ. NO.	FISCAL YEAR	SHEET NO.	TOTAL SHEETS
1	MASS.	I-91-1(54)9	19	61	188

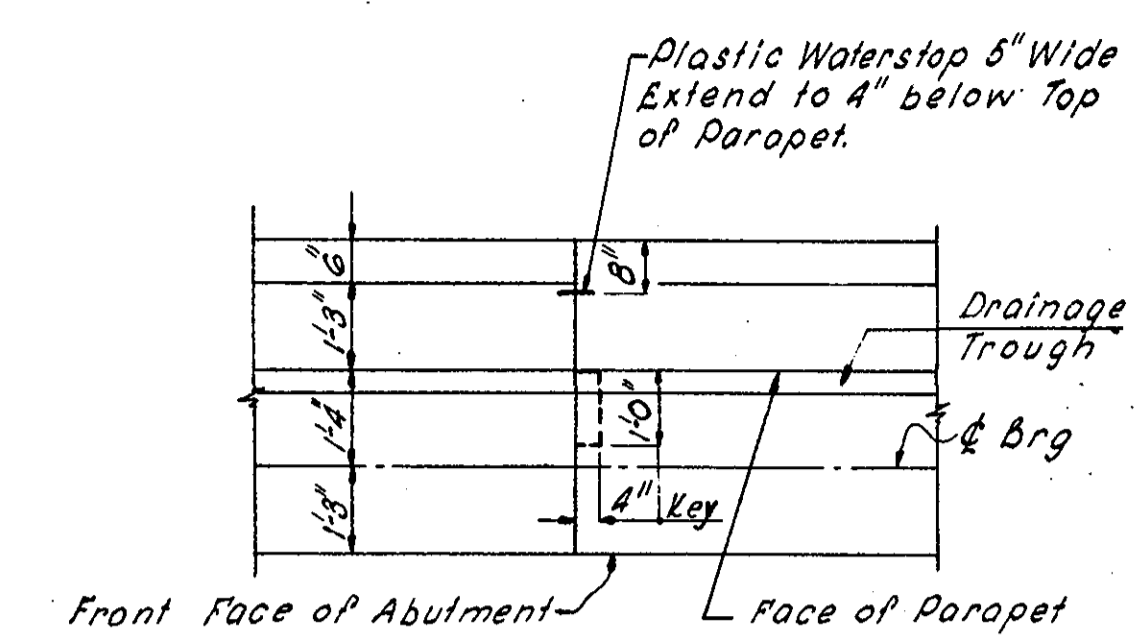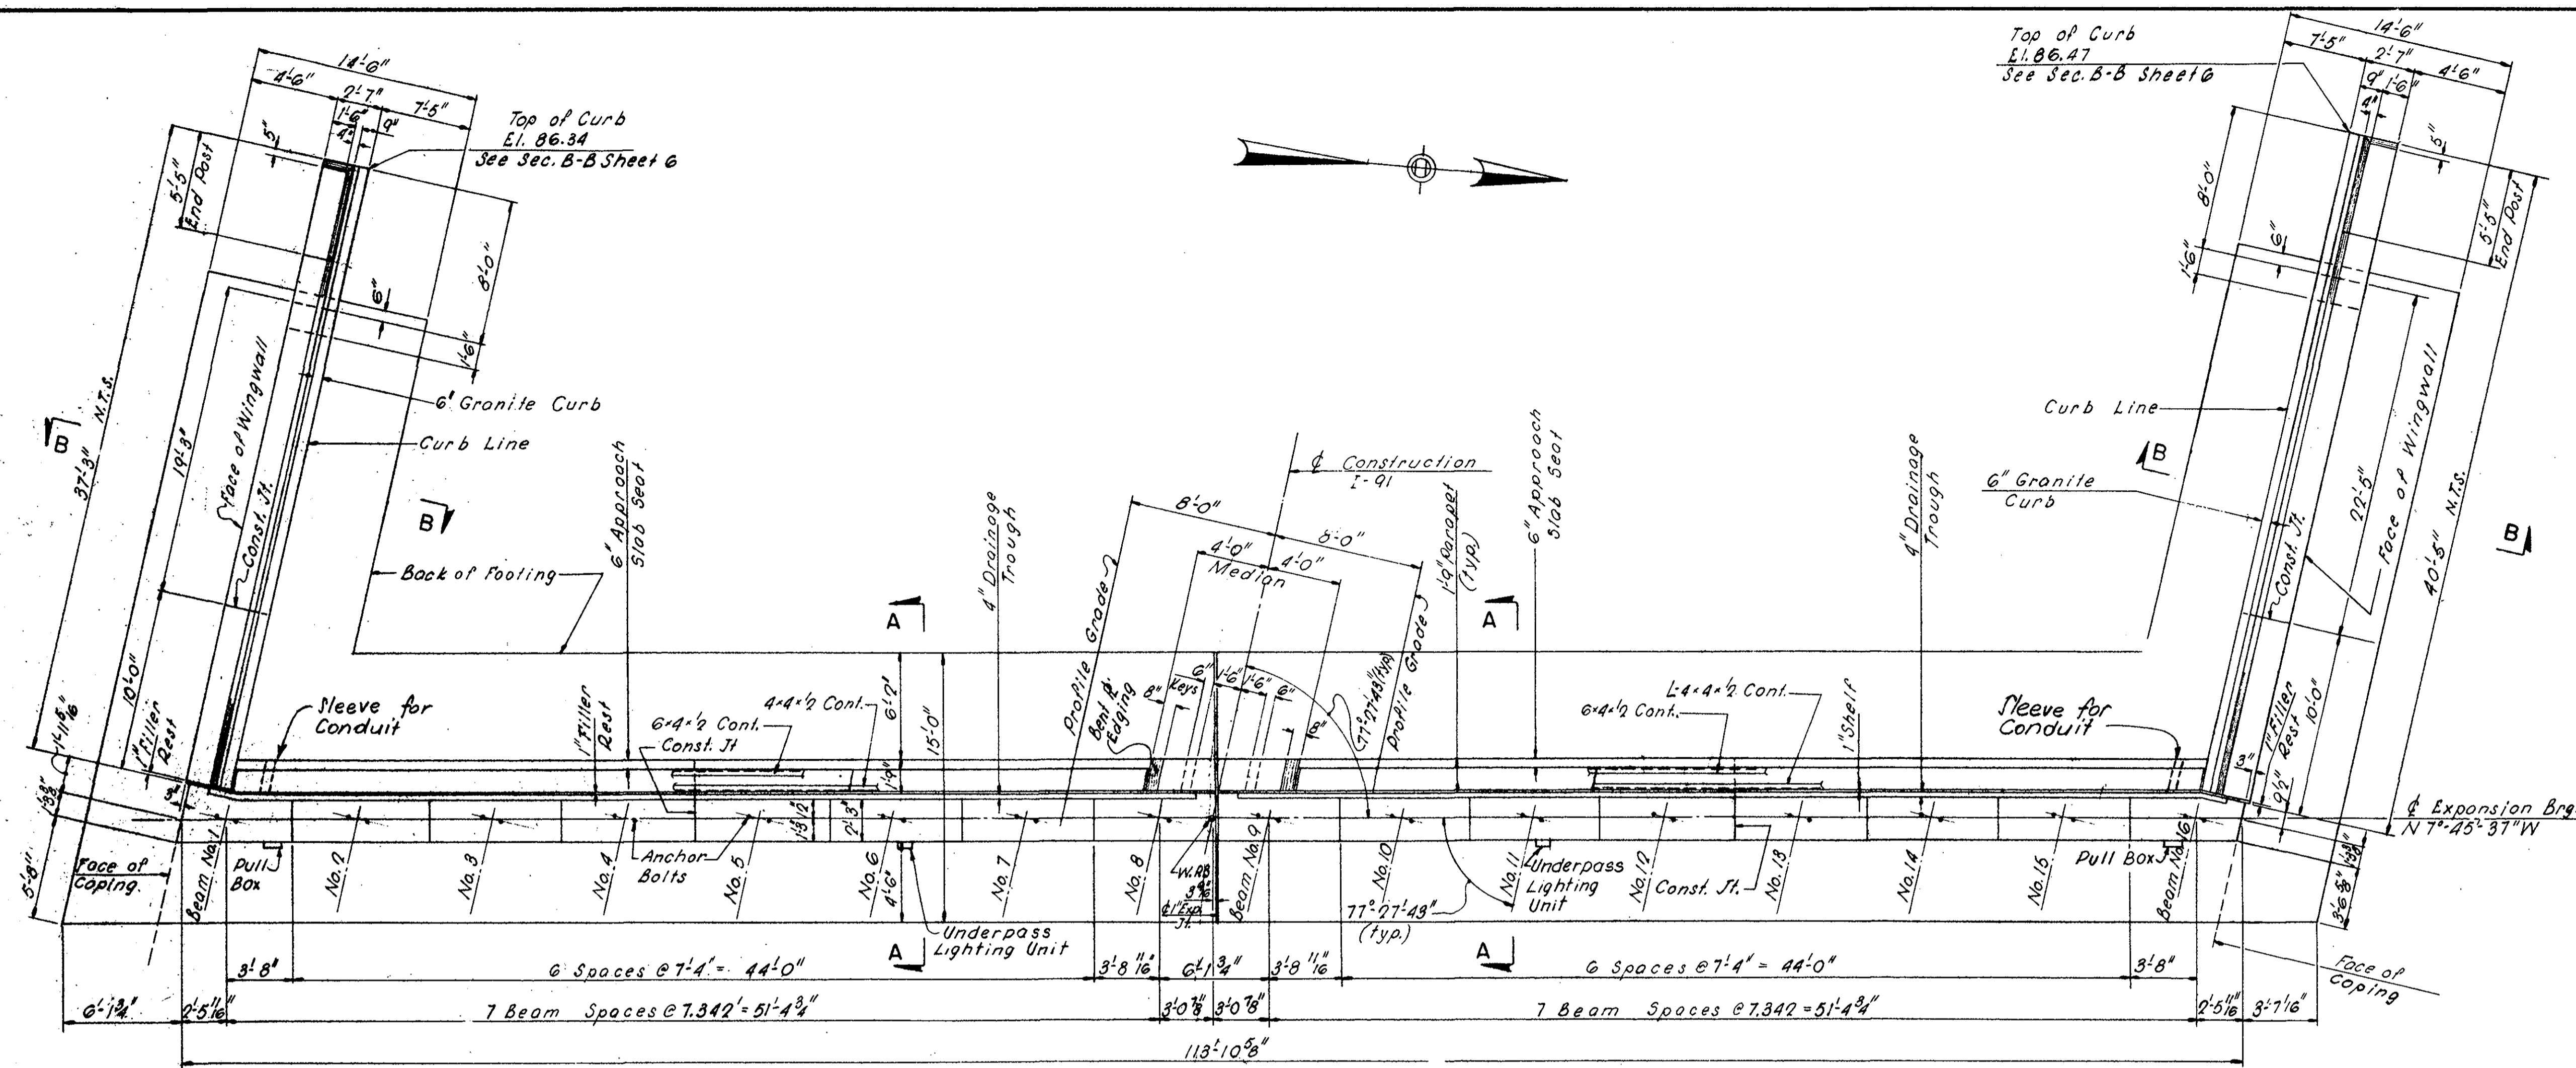

**CONSTRUCTION JOINT**  
Scale: 3/8" = 1'-0"

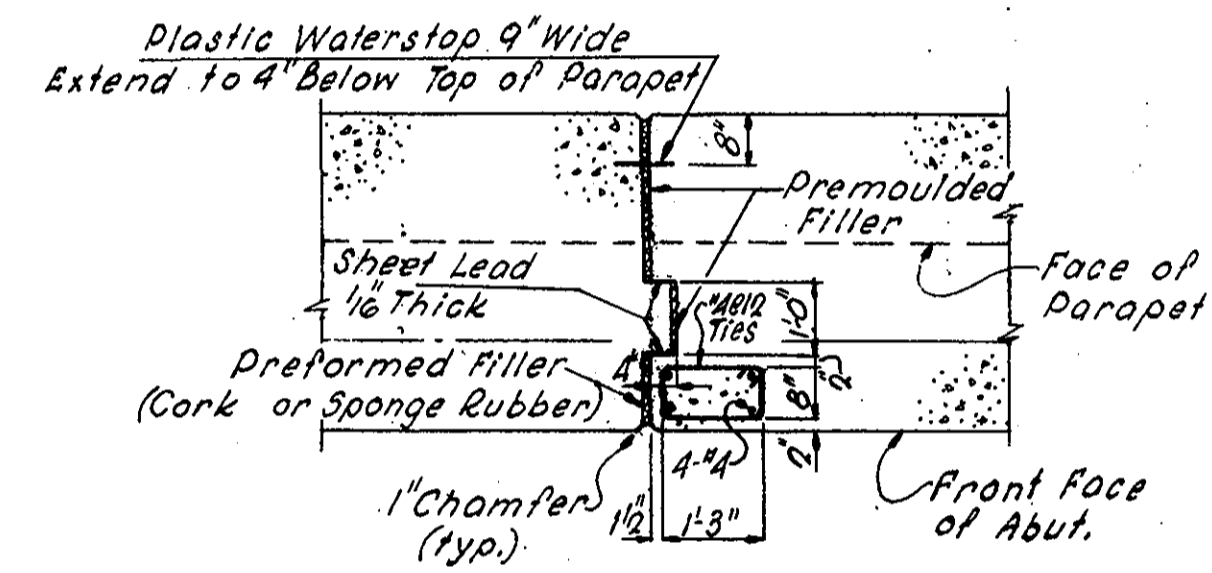

**EXPANSION JOINT**  
Scale: 3/8" = 1'-0"

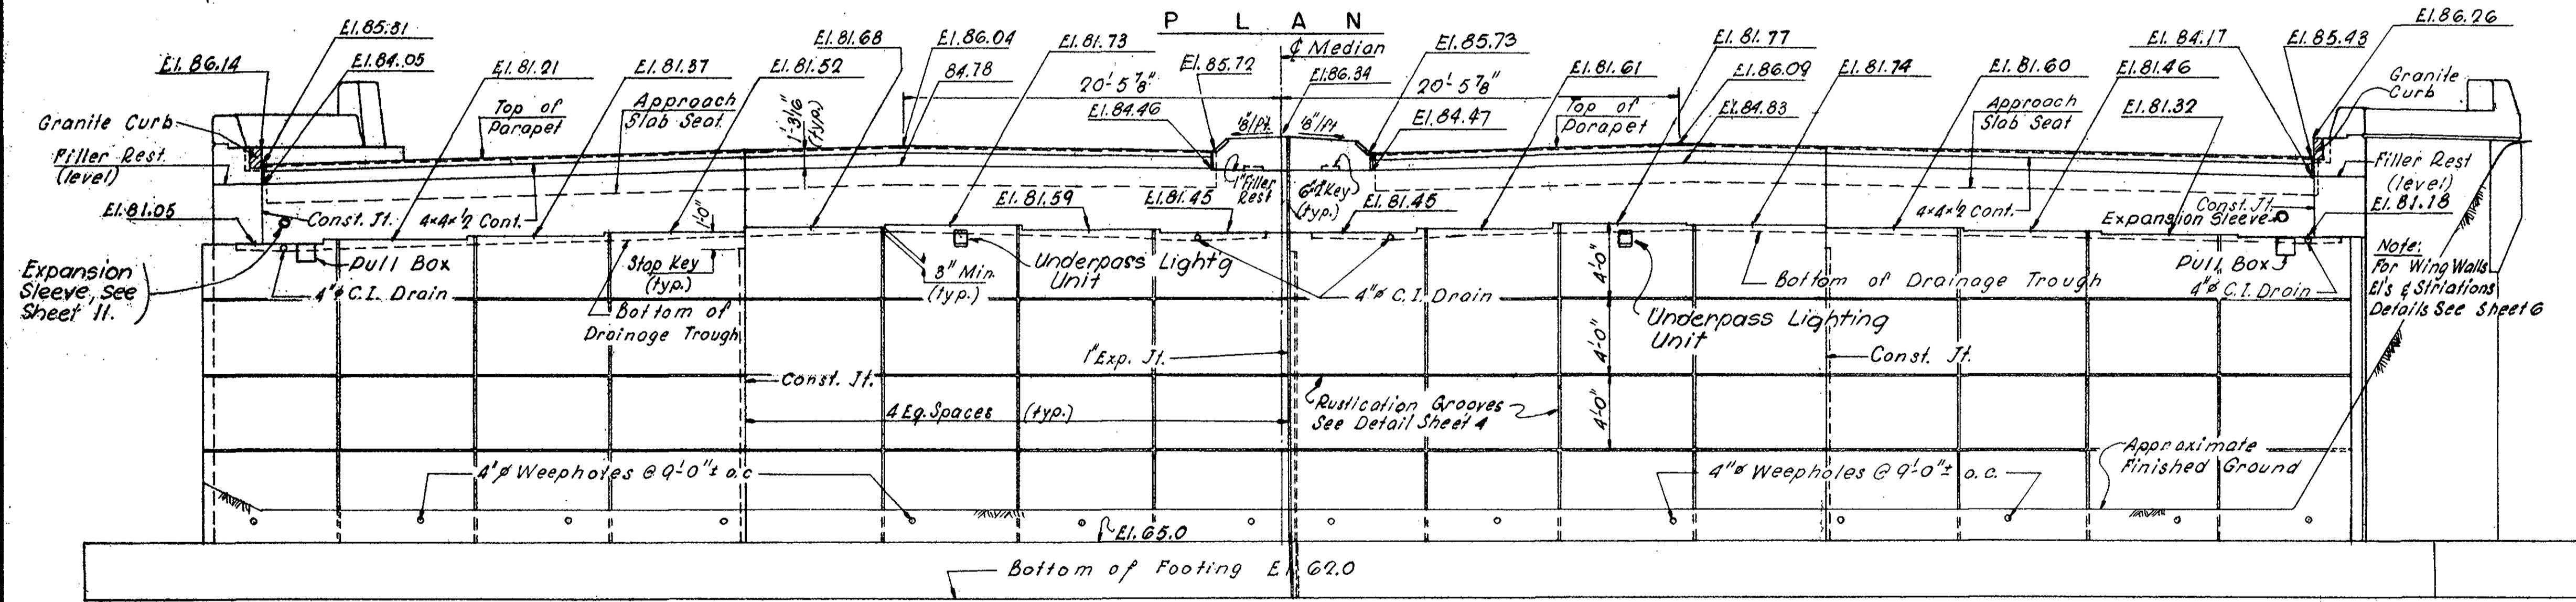

**ELEVATION  
WEST ABUTMENT**  
Scale: 3/16" = 1'-0"

Note: Lighting Conduit Omitted  
For Clarity See Sheet 3

- Notes:
1. For Sections A-A, B-B & Footing Layout See Sheet 6
  2. For Limits of Gravel Borrow See Sheet 4


APRIL 9, 1966	ISSUED FOR CONSTRUCTION
DATE	DESCRIPTION
	USE ONLY PRINTS OF LATEST DATE



**WINGWALL ELEVATIONS**


Wingwall	El. "A"	El. "B"	El. "C"
North East	86.08	85.99	68.50
South East	85.96	85.86	68.50
North West	86.43	86.64	67.00
South West	86.31	86.51	67.00

**Note:**  
Date & Seal to be located at the Inside Face of N.E. & S.W. Wingwalls.  
Fill shall be placed and thoroughly compacted to the Grade of the Bottom of the Wings; or Where no Fill is required below the Wings, the Concrete shall be placed upon undisturbed Soil.

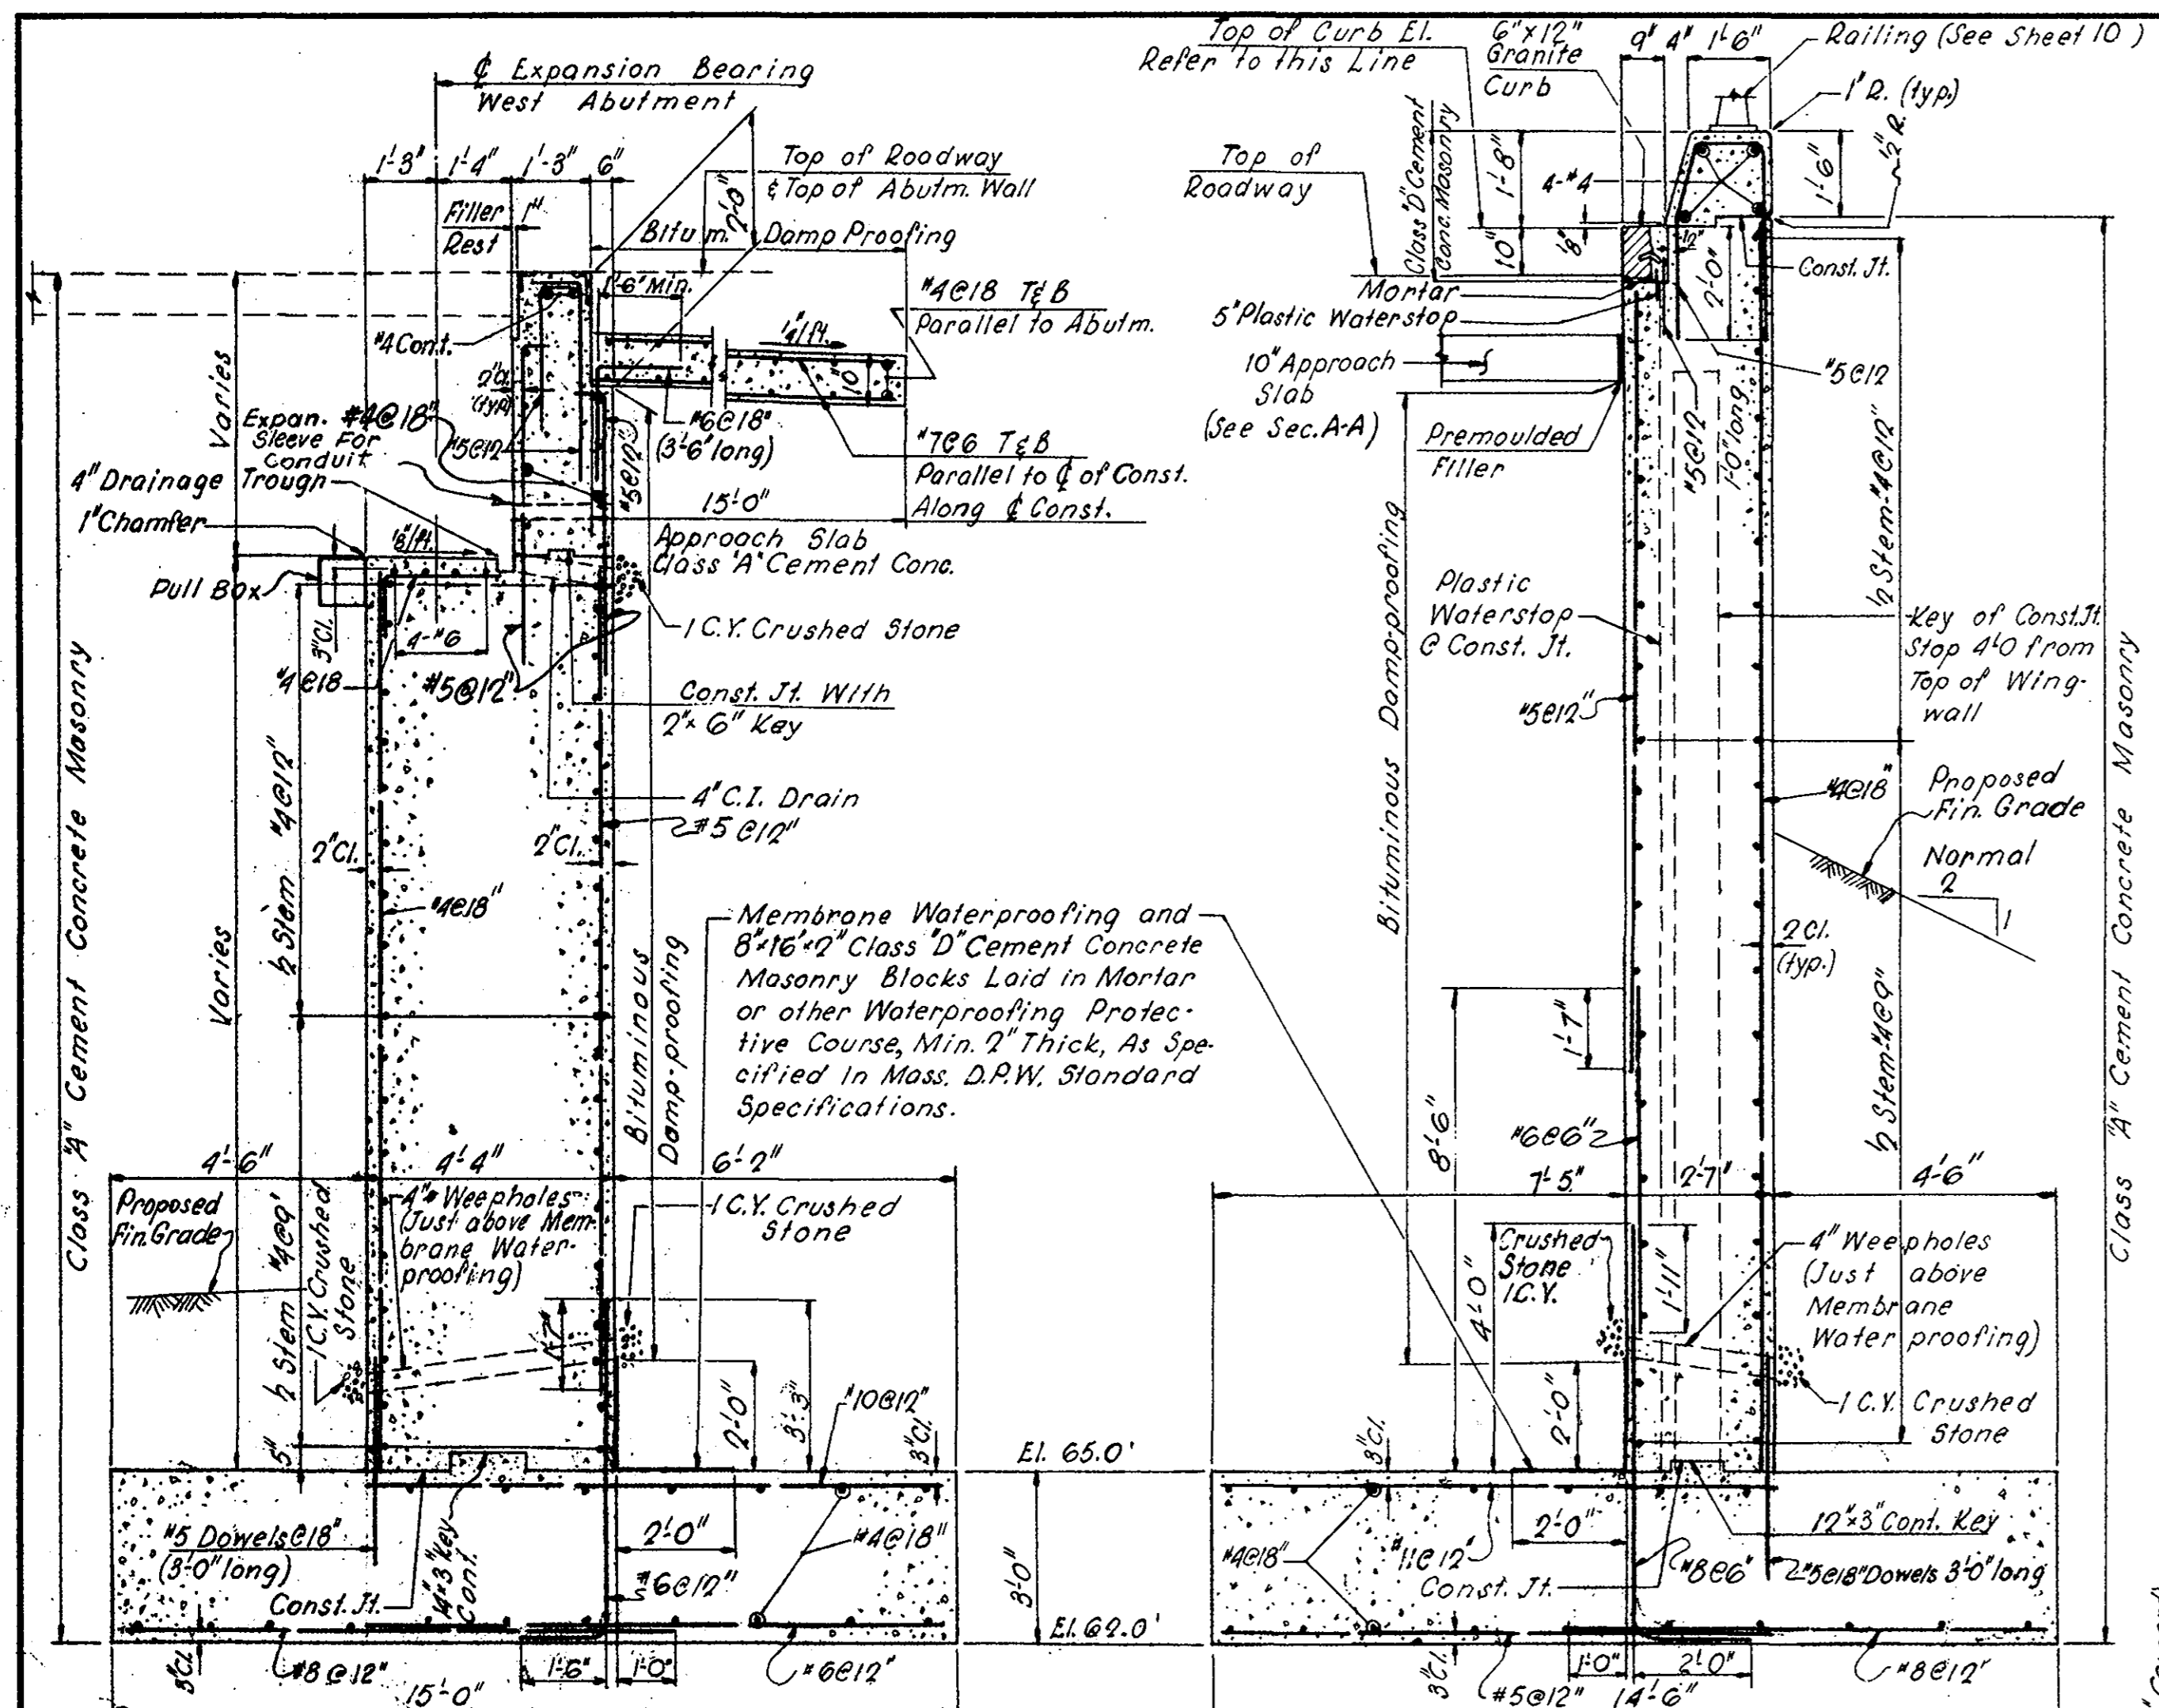


**SECTION A-A** Scale: 3/8" = 1'-0"  
Max. Toe Pressure = 3.72 K.S.F.


**SECTION B-B** Scale: 3/8" = 1'-0"  
Max. Toe Pressure = 3.88 K.S.F.

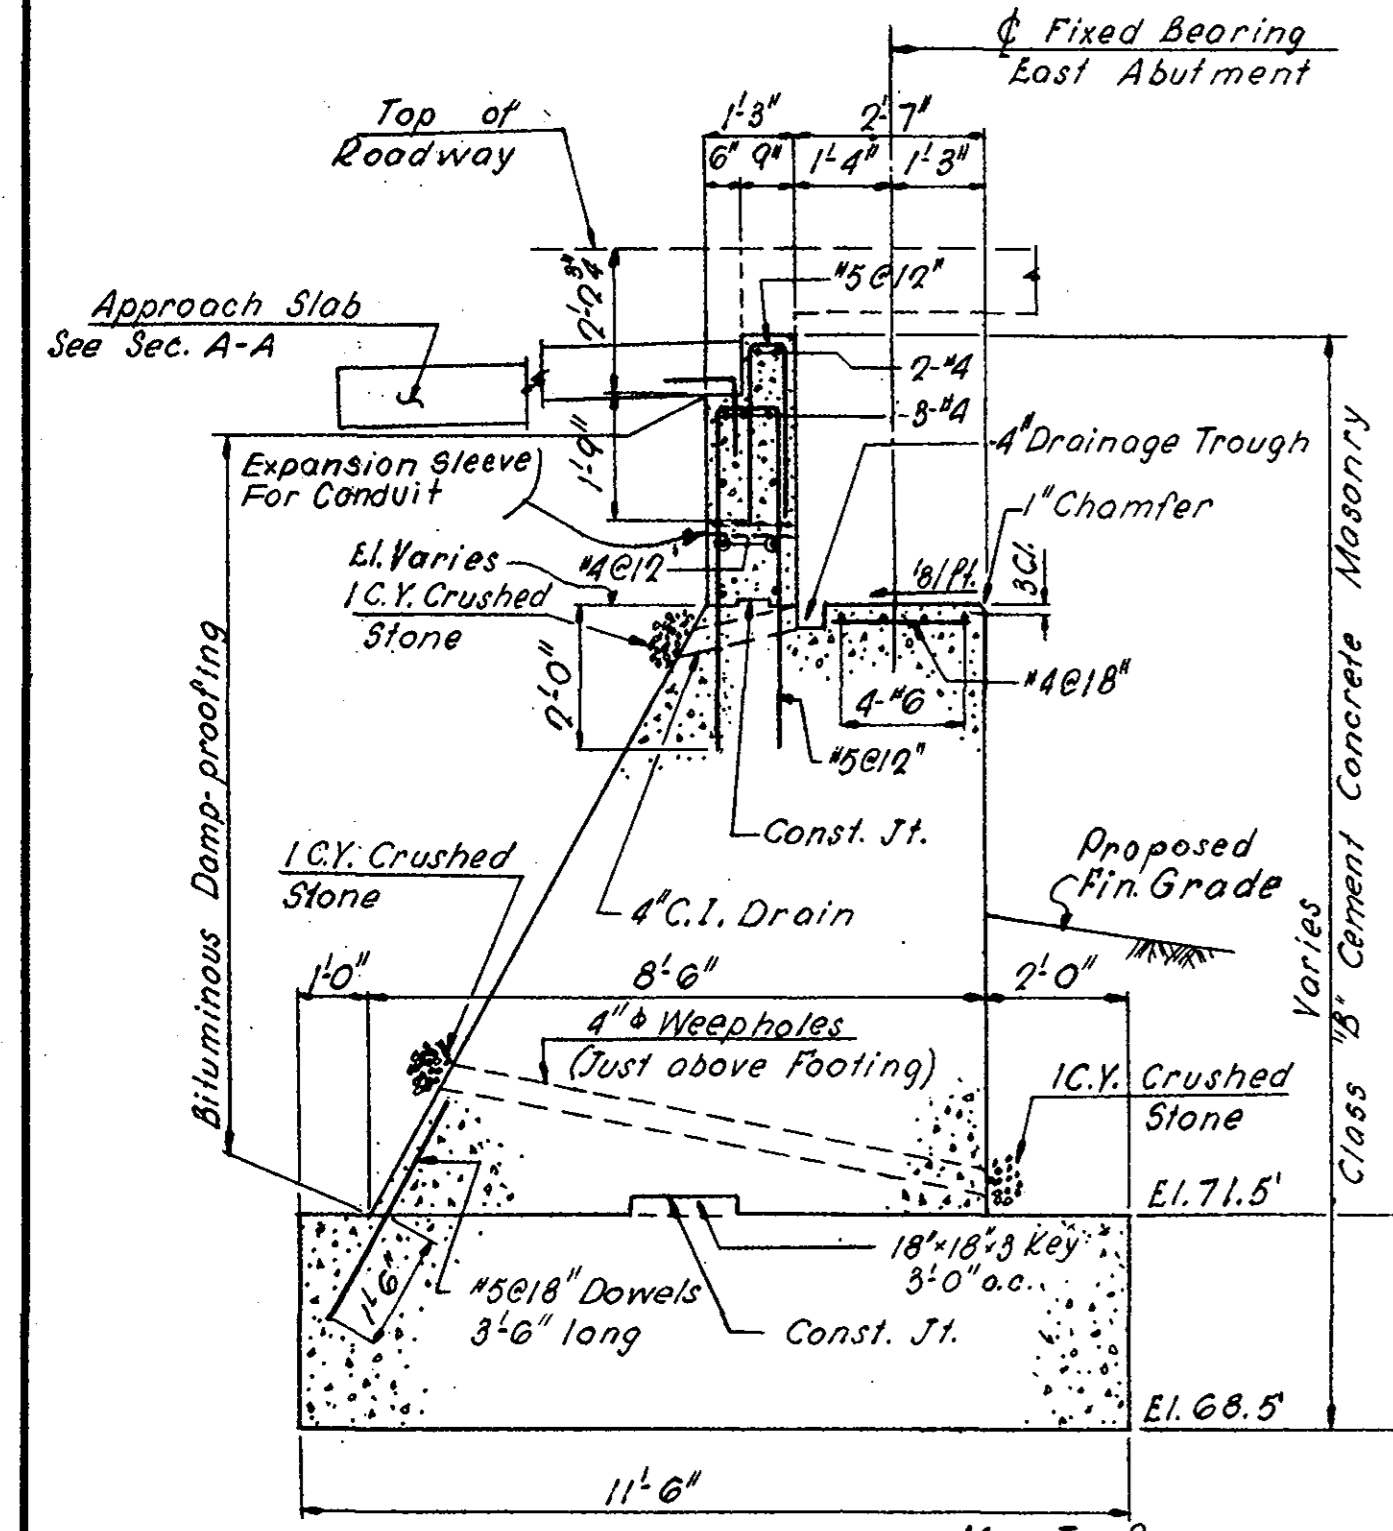


**SECTION C-C** Scale: 3/8" = 1'-0"  
Max. Toe Pressure = 3.75 K.S.F.

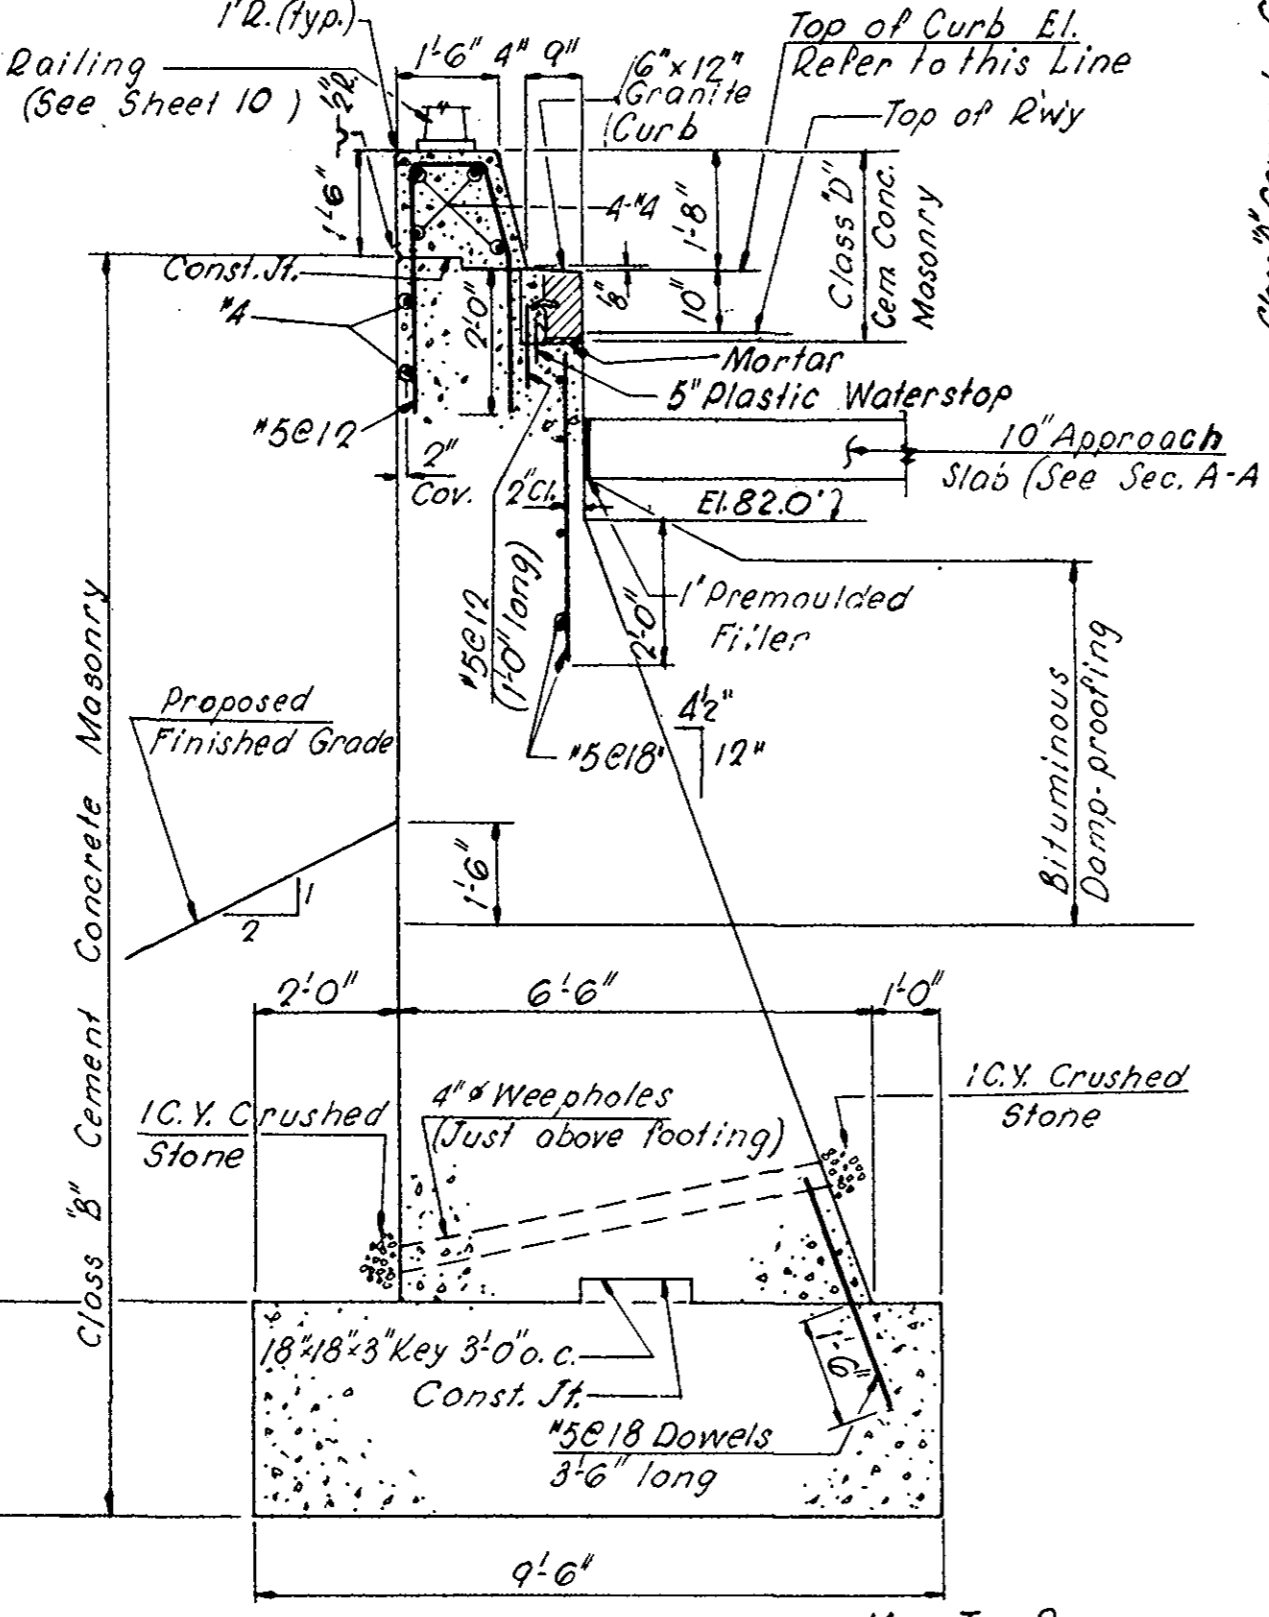


**SECTION D-D** Scale: 3/8" = 1'-0"  
Max. Toe Pressure = 2.90 K.S.F.

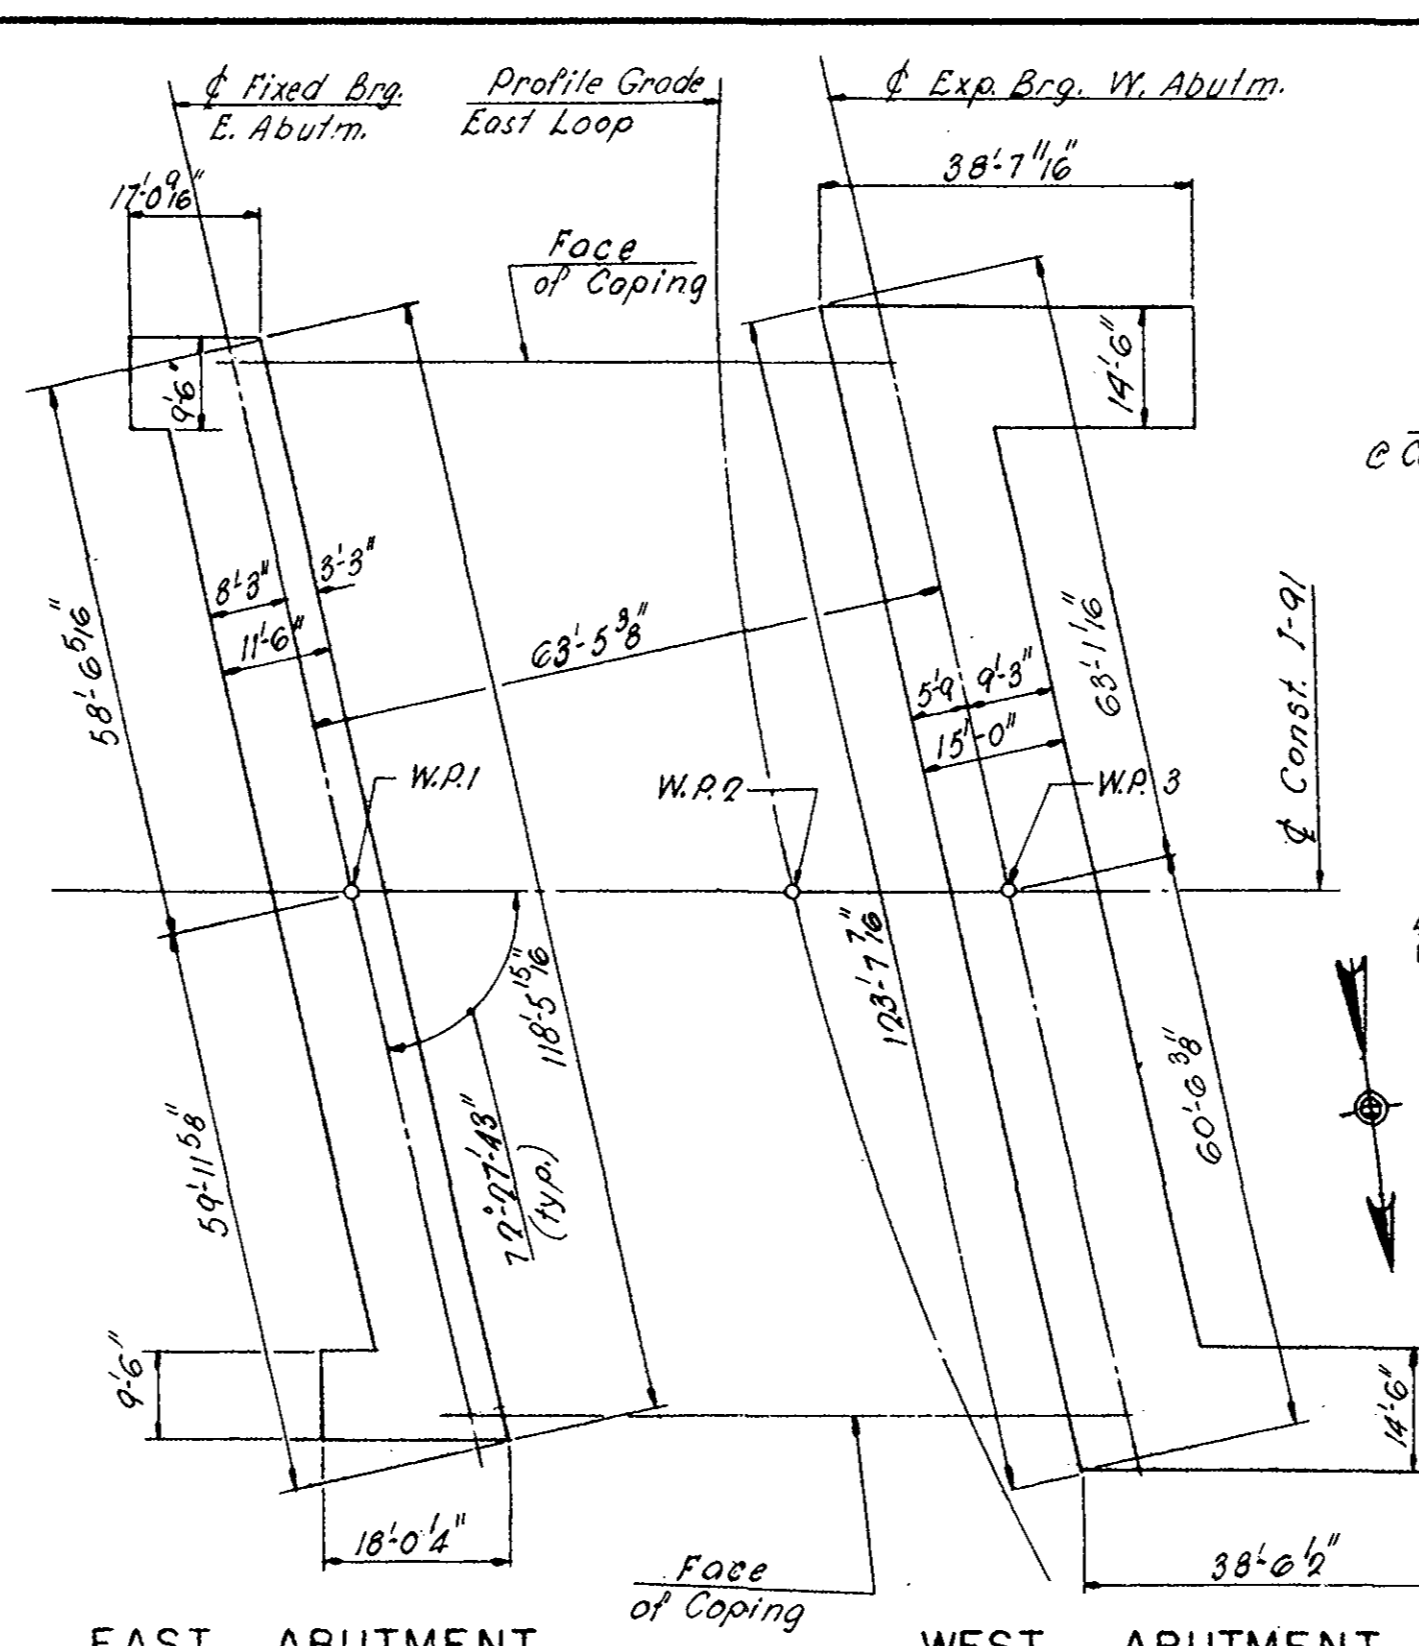


**EAST ABUTMENT FOOTING LAYOUT PLAN** Scale: 1" = 20'  
**WEST ABUTMENT FOOTING LAYOUT PLAN** Scale: 1" = 20'  
(For Stationing of W.R.'s See Diagram Sheet 3)

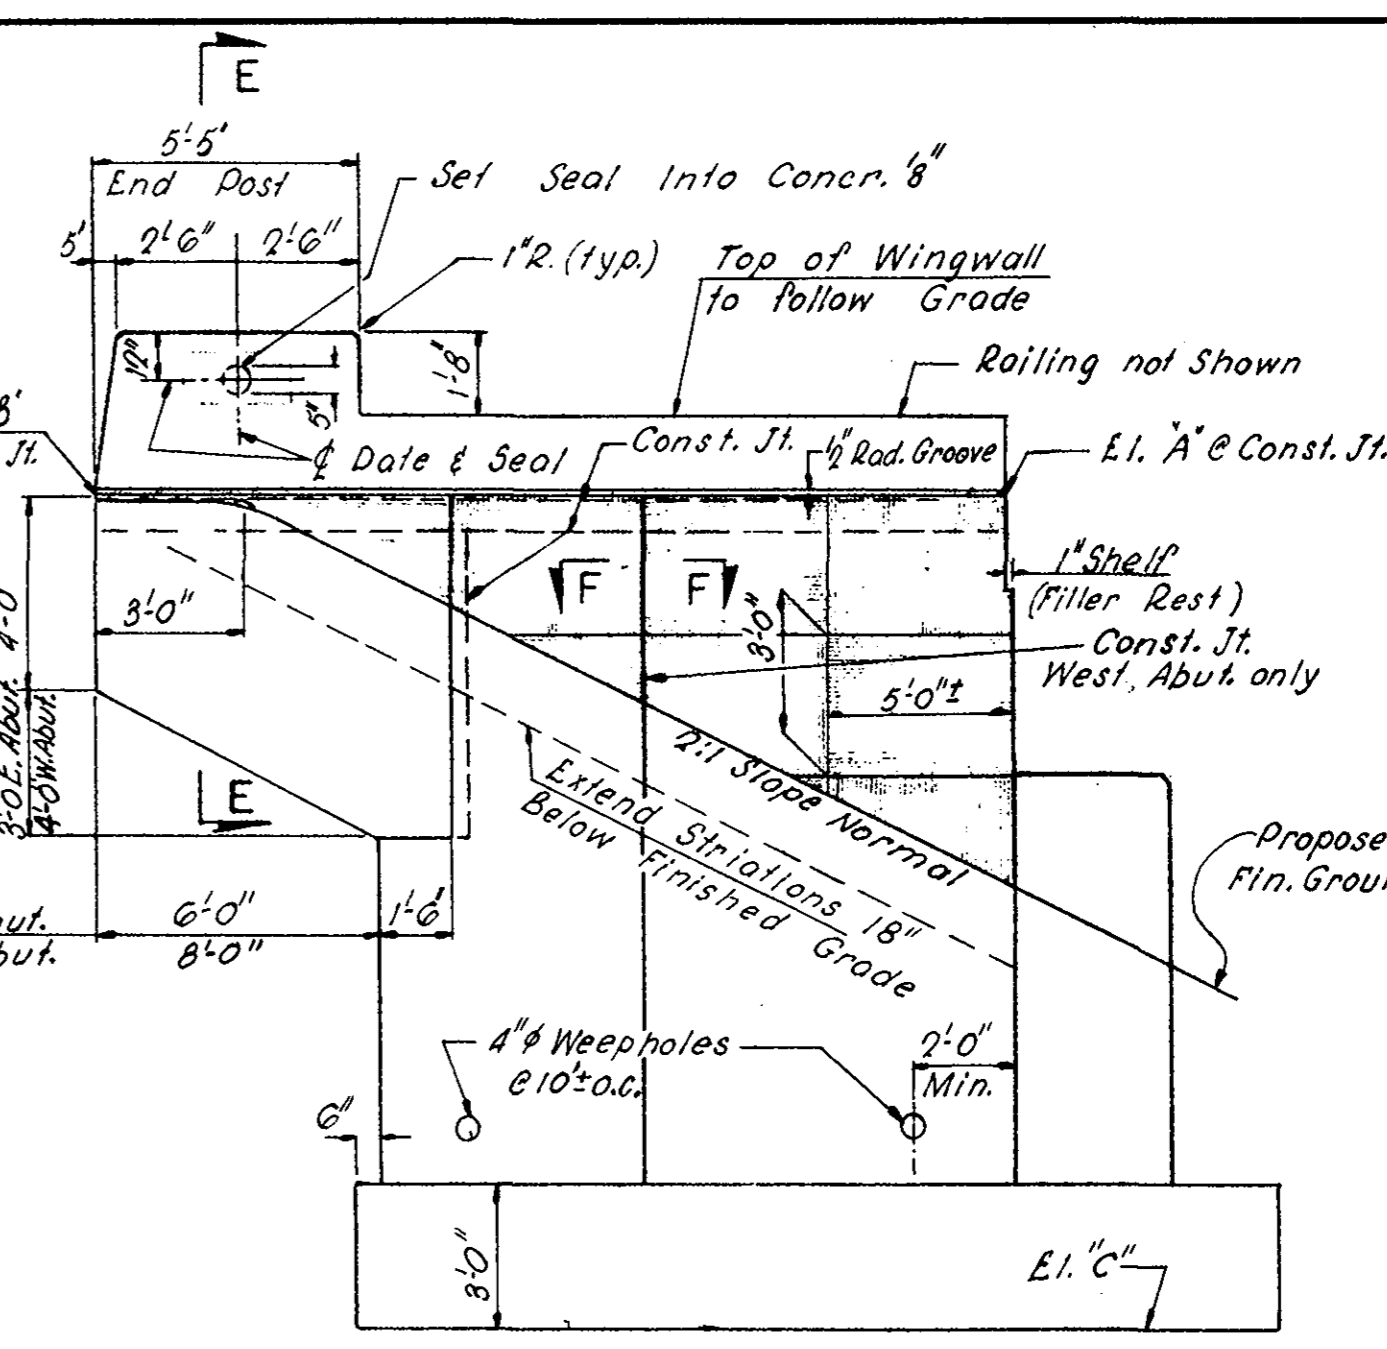


**TYPICAL WINGWALL ELEVATION** Scale: 1/4" = 1'-0"

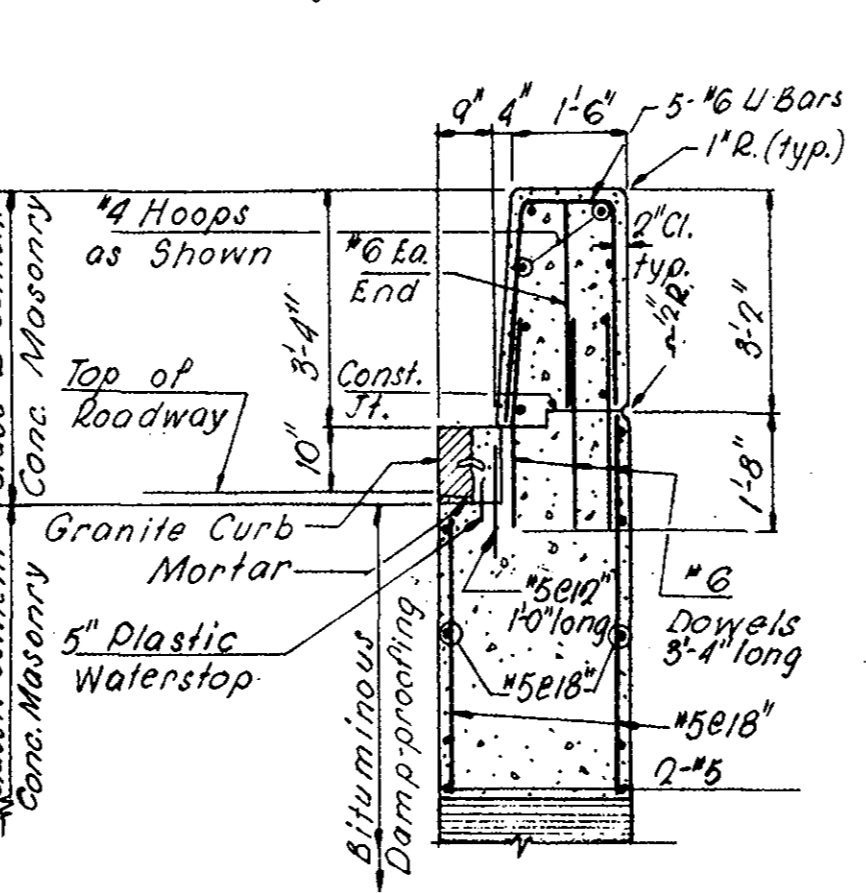


**SECTION E-E** Scale: 3/8" = 1'-0"

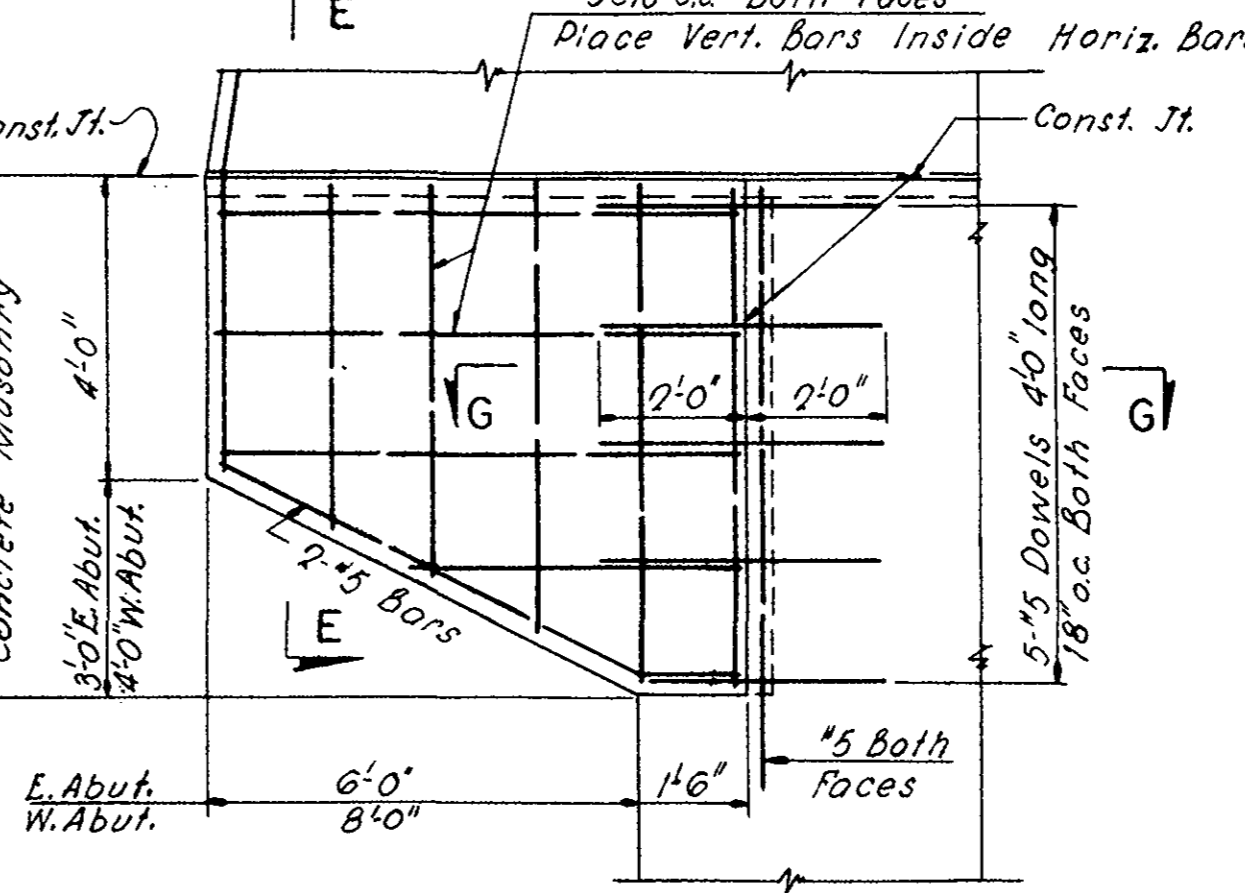


**FLYING WING REINFORCEMENT** Scale: 3/8" = 1'-0"

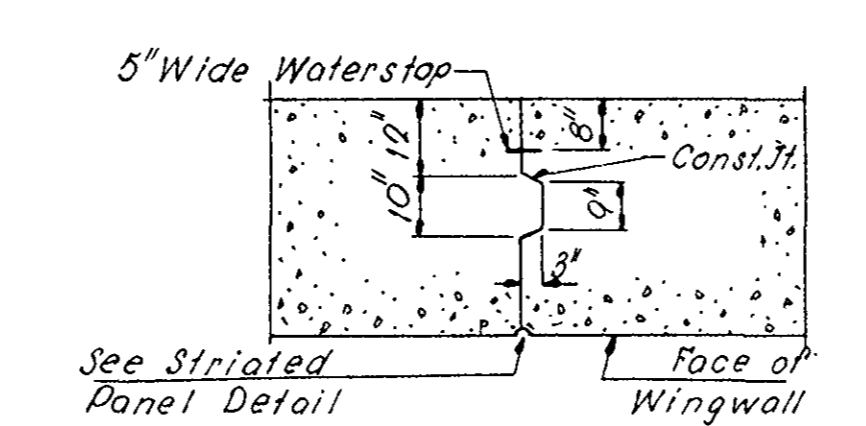

**SECTION F-F** Scale: 3/8" = 1'-0"

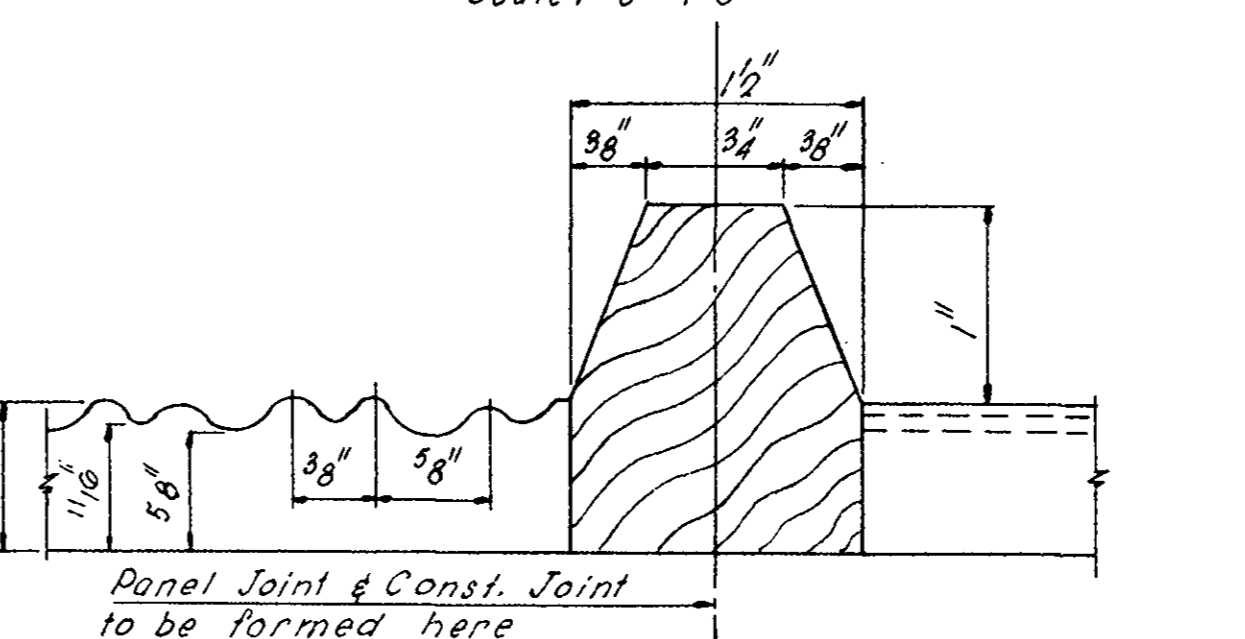

**TYPICAL STRIATED PANEL JOINT** Full Size

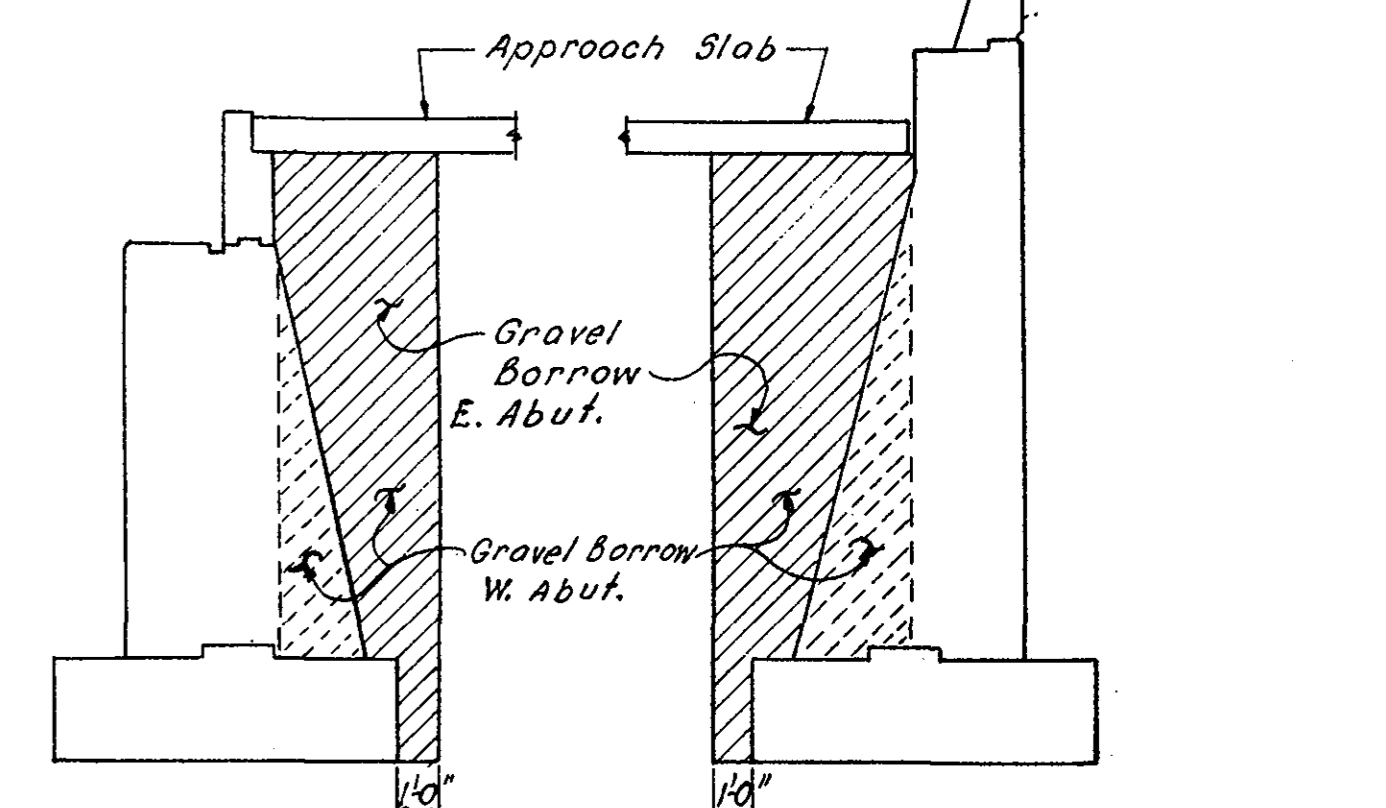



**ABUTMENT** **WINGWALL**

**SECTION SHOWING GRAVEL BORROW**  
EAST ABUTMENT AS SHOWN, WEST ABUTMENT AS NOTED.  
Scale: 3/16" = 1'-0"

APRIL 9, 1966	ISSUED FOR CONSTRUCTION
DATE	DESCRIPTION
	USE ONLY PRINTS OF LATEST DATE



PUB. NO.	STATE	FED. AID PROJ. NO.	FISCAL YEAR	SHEET NO.	TOTAL SHEETS
I	MASS.	1-91-1(54)9	19	64	188

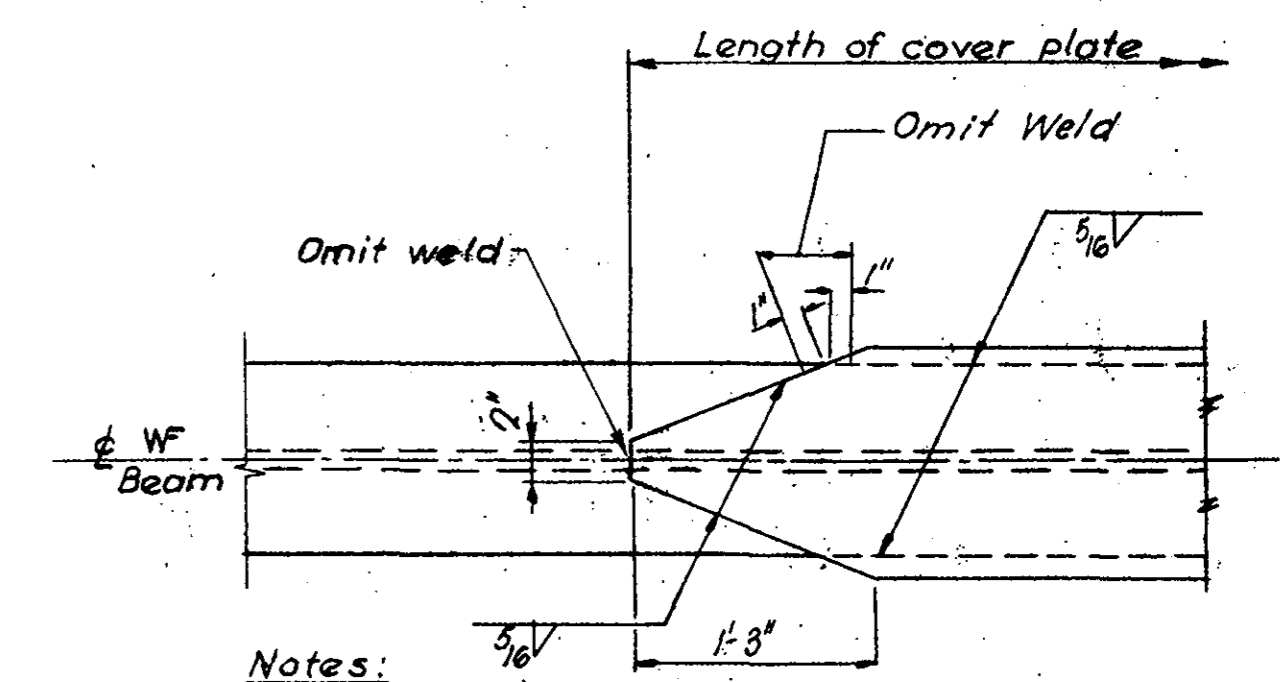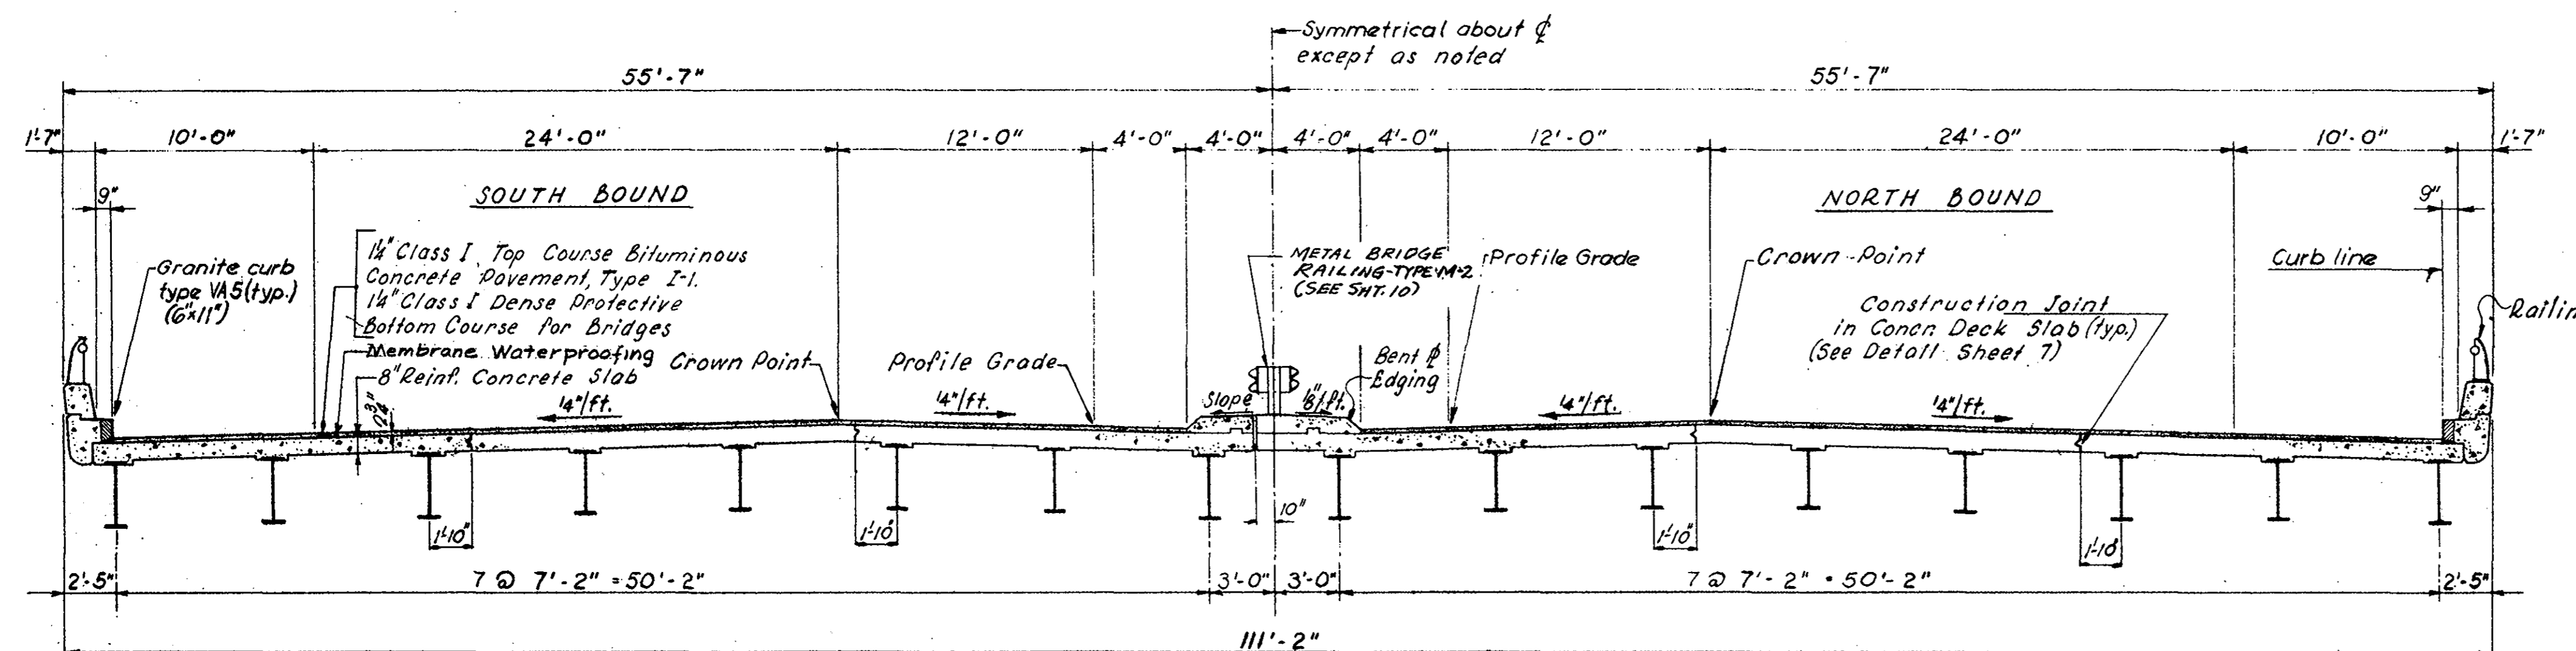

Notes:  
Preparation of material for welding shall conform to art. 402, A.W.S. 1963.  
Assembly of material for welding shall conform to art. 403, A.W.S. 1963.

COVER PLATE DETAIL


Not to Scale

Note:  
All Concrete to be Class "D" Cement Concrete Masonry

TYPICAL CROSS SECTION



Scale: 3/16" = 1'-0"

#4-10" Long - 2'-0" o.c. for Support of Waterstop, Fasten with Clips.

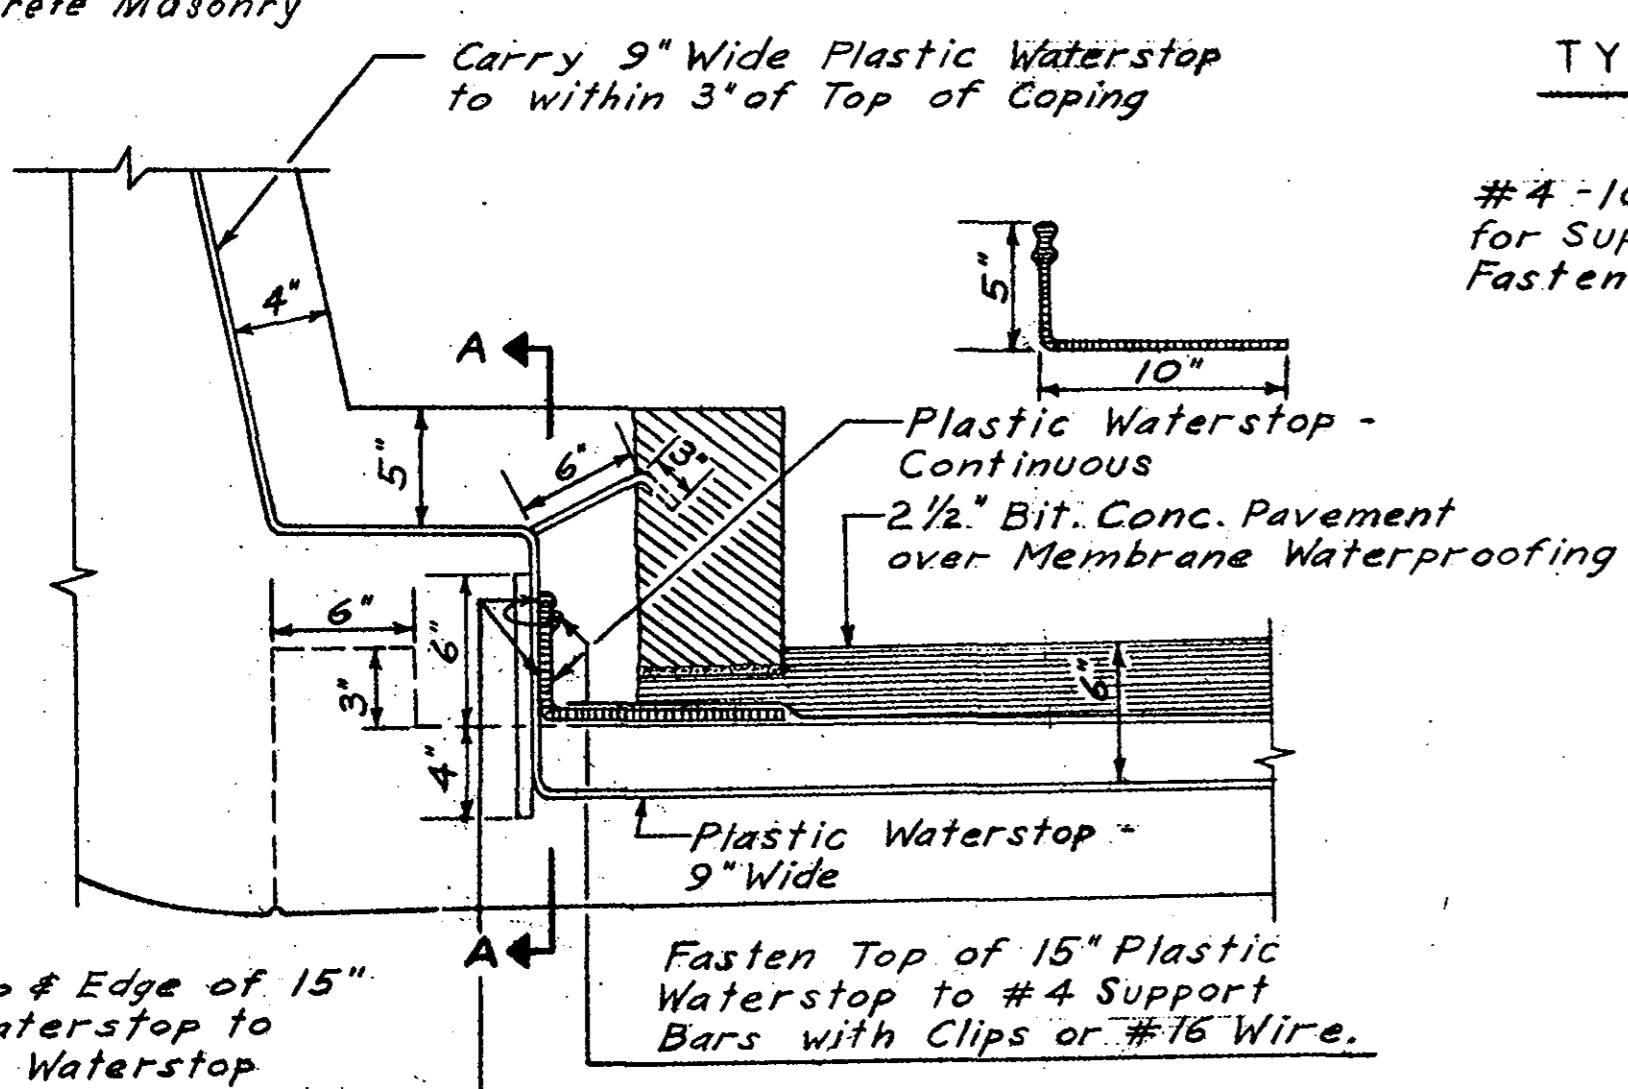

CURB DETAIL AT EXPANSION JOINT

Scale: 1/2" = 1'-0"

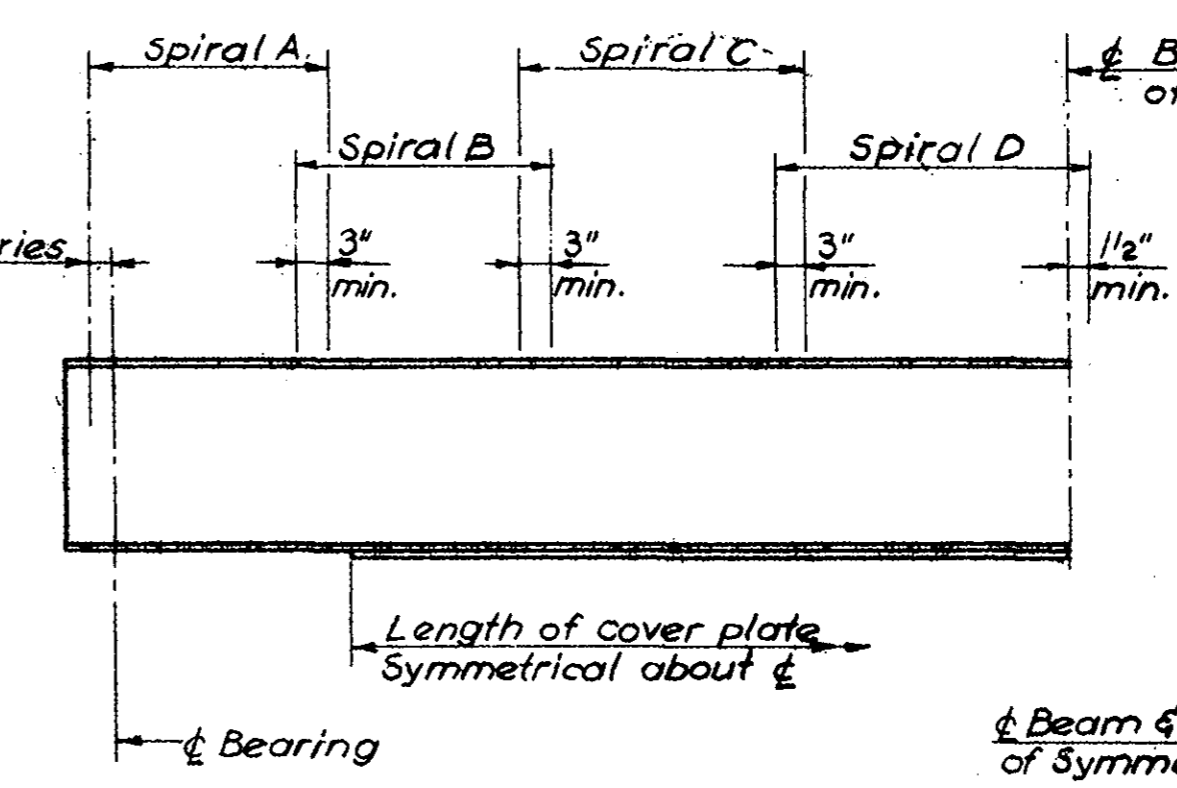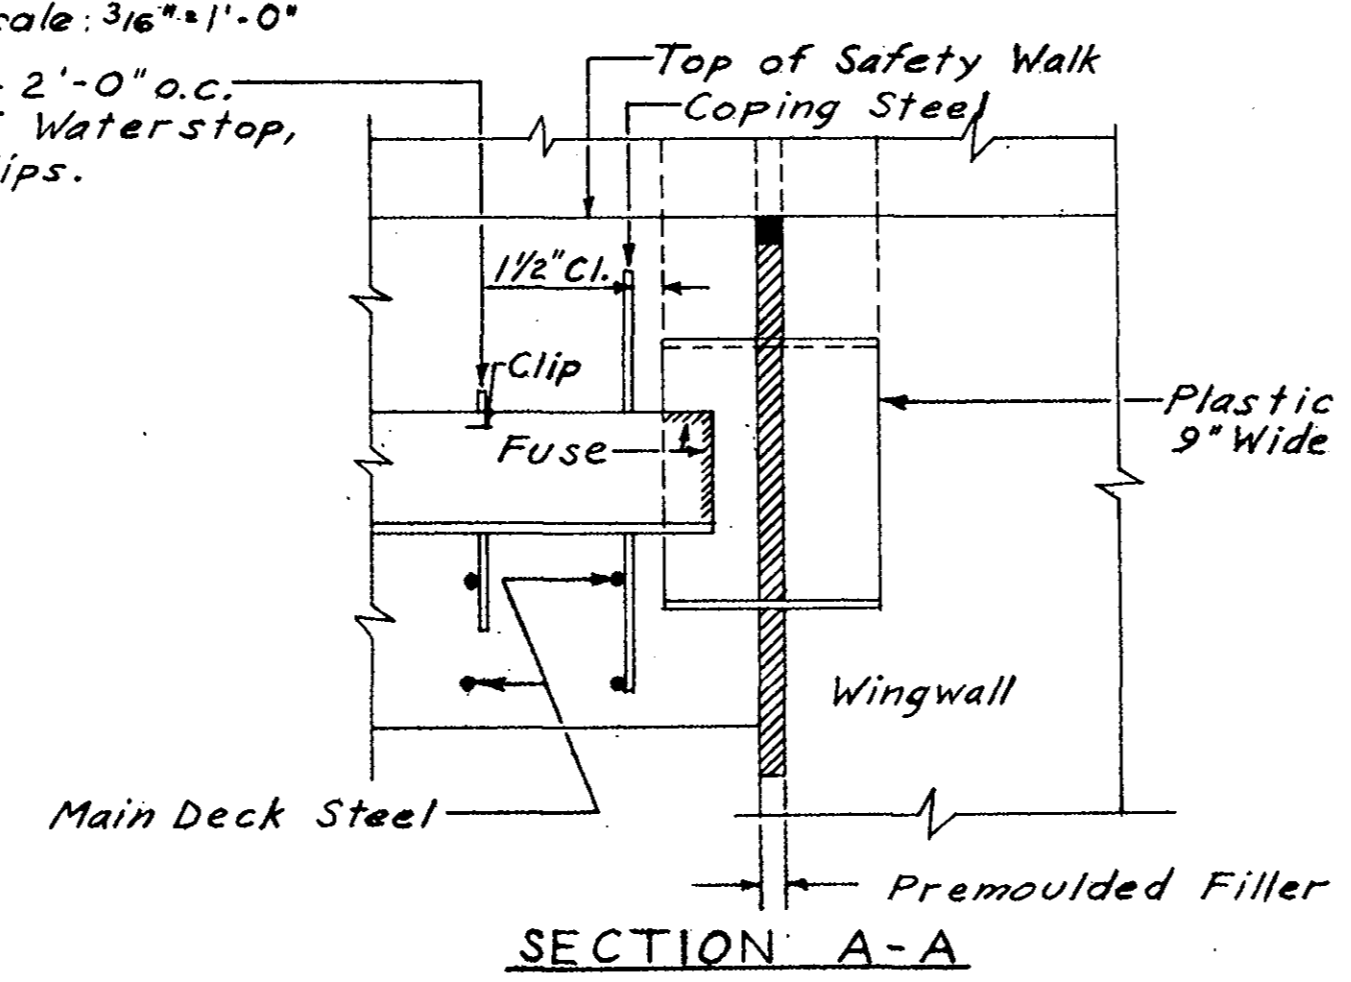

BEAM NO.	DEFLECTION DUE TO CONCRETE SLAB			TOTAL DEAD LOAD DEFLECTIONS			CAMBER AT MID SPAN
	1/4 SPAN	1/2 SPAN	3/4 SPAN	1/4 SPAN	1/2 SPAN	3/4 SPAN	
1	1 1/16"	5/8"	7/16"	1"	1 3/8"	1"	2 3/8"
2	1 1/16"	5/8"	7/16"	1 1/8"	1 1/2"	1 1/8"	2 3/8"
3							
4							
5							
6							
7	1 1/16"	5/8"	7/16"	1 1/8"	1 1/2"	1 1/8"	2 3/8"
8	1 1/16"	5/8"	7/16"	1"	1 3/8"	1"	2 1/4"
9	3/4"	5/8"	3/4"	1 1/8"	1 1/2"	1 1/8"	2 3/8"
10	1 1/16"	5/8"	7/16"	1 1/8"	1 1/2"	1 1/8"	2 3/8"
11							
12							
13							
14	1 1/16"	5/8"	7/16"	1 1/8"	1 1/2"	1 1/8"	2 3/8"
15	1 1/16"	5/8"	7/16"	1"	1 3/8"	1"	2 3/8"
16	1 1/16"	5/8"	7/16"	1"	1 3/8"	1"	2 3/8"

EAST BEARING	DESIGN ELEVATIONS ALONG TOP FLANGE				WEST BEARING
	1/4 SPAN	1/2 SPAN	3/4 SPAN		
83.94	84.15	84.27	84.32	84.28	
84.10	84.31	84.44	84.48	84.44	
84.26	84.47	84.60	84.64	84.60	
84.41	84.63	84.75	84.80	84.75	
84.57	84.78	84.91	84.95	84.91	
84.62	84.83	84.96	85.00	84.96	
84.48	84.69	84.82	84.86	84.82	
84.34	84.54	84.67	84.71	84.68	
84.34	84.56	84.69	84.73	84.68	
84.50	84.71	84.84	84.88	84.84	
84.66	84.87	85.00	85.04	85.00	
84.63	84.84	84.97	85.01	84.97	
84.49	84.70	84.83	84.87	84.83	
84.35	84.56	84.69	84.73	84.69	
84.21	84.42	84.55	84.59	84.55	
84.06	84.27	84.40	84.44	84.41	

BEAM NO.	SIZE	LENGTH OF BEARINGS	BOTTOM COVER PLATE	2-5/8" SPIRAL SHEAR CONNECTORS				3-3/4" STUD SHEAR CONNECTORS											
				SPIRAL A		SPIRAL B		STUD A		STUD B		STUD C		STUD D					
				LENGTH	PITCH	LENGTH	PITCH	LENGTH	PITCH	LENGTH	PITCH	LENGTH	PITCH	LENGTH	PITCH				
1	33 WF 118	65'-0"	15" x 1/2" x 52'-6"	9'-4 1/2"	4 1/2"	8'-0"	6"	8'-8"	8"	7'-4"	11"	5'-0"	4"	6'-0"	4 1/2"	10'-0"	6"	9'-9"	9"
2-7			15" x 1/2" x 53'-6"									6'-0"		6'-4 1/2"				8'-3"	
8			15" x 3/4" x 52'-6"									5'-0"		6'-0"				9'-9"	
9			15" x 1/2" x 53'-6"									5'-0"		6'-0"				9'-9"	
10-15			15" x 1/2" x 53'-6"									6'-0"		6'-4 1/2"				8'-3"	
16	33 WF 118	65'-0"	15" x 1/2" x 52'-9"	9'-4 1/2"	4 1/2"	8'-0"	6"	8'-8"	8"	7'-4"	11"	6'-0"	4"	6'-4 1/2"	4 1/2"	10'-0"	6"	8'-3"	9"


† The deflection due to Concrete Slab is 80% of the theoretical value and is intended for the use of the Resident Engineer only.

Notes:  
1. Ends of all beams shall be fabricated so that under full dead load the ends will be plumb.  
2. The table of Design Elevations along top flange is for the use of the Resident Engineer in the field for comparison of:  
a) Elevations along top flange of stringers in place and  
b) the design elevations tabulated.  
3. Any Welded Joint Prequalified by American Welding Society Specifications for Welded Highway and Railway Bridges (1963 Edition), will be Acceptable in the Fabrication of the Structural Steel.

APRIL 9, 1966	ISSUED FOR CONSTRUCTION
DATE	DESCRIPTION
	USE ONLY PRINTS OF LATEST DATE




INTERSTATE ROUTE 91 WEST SPRINGFIELD					
PUR. NO. DIV. NO.	STATE	FED. AID PROJ. NO.	FISCAL YEAR	SHEET NO.	TOTAL SHEETS
1	MASS.	4-2-1 (54-33)	19	66	188

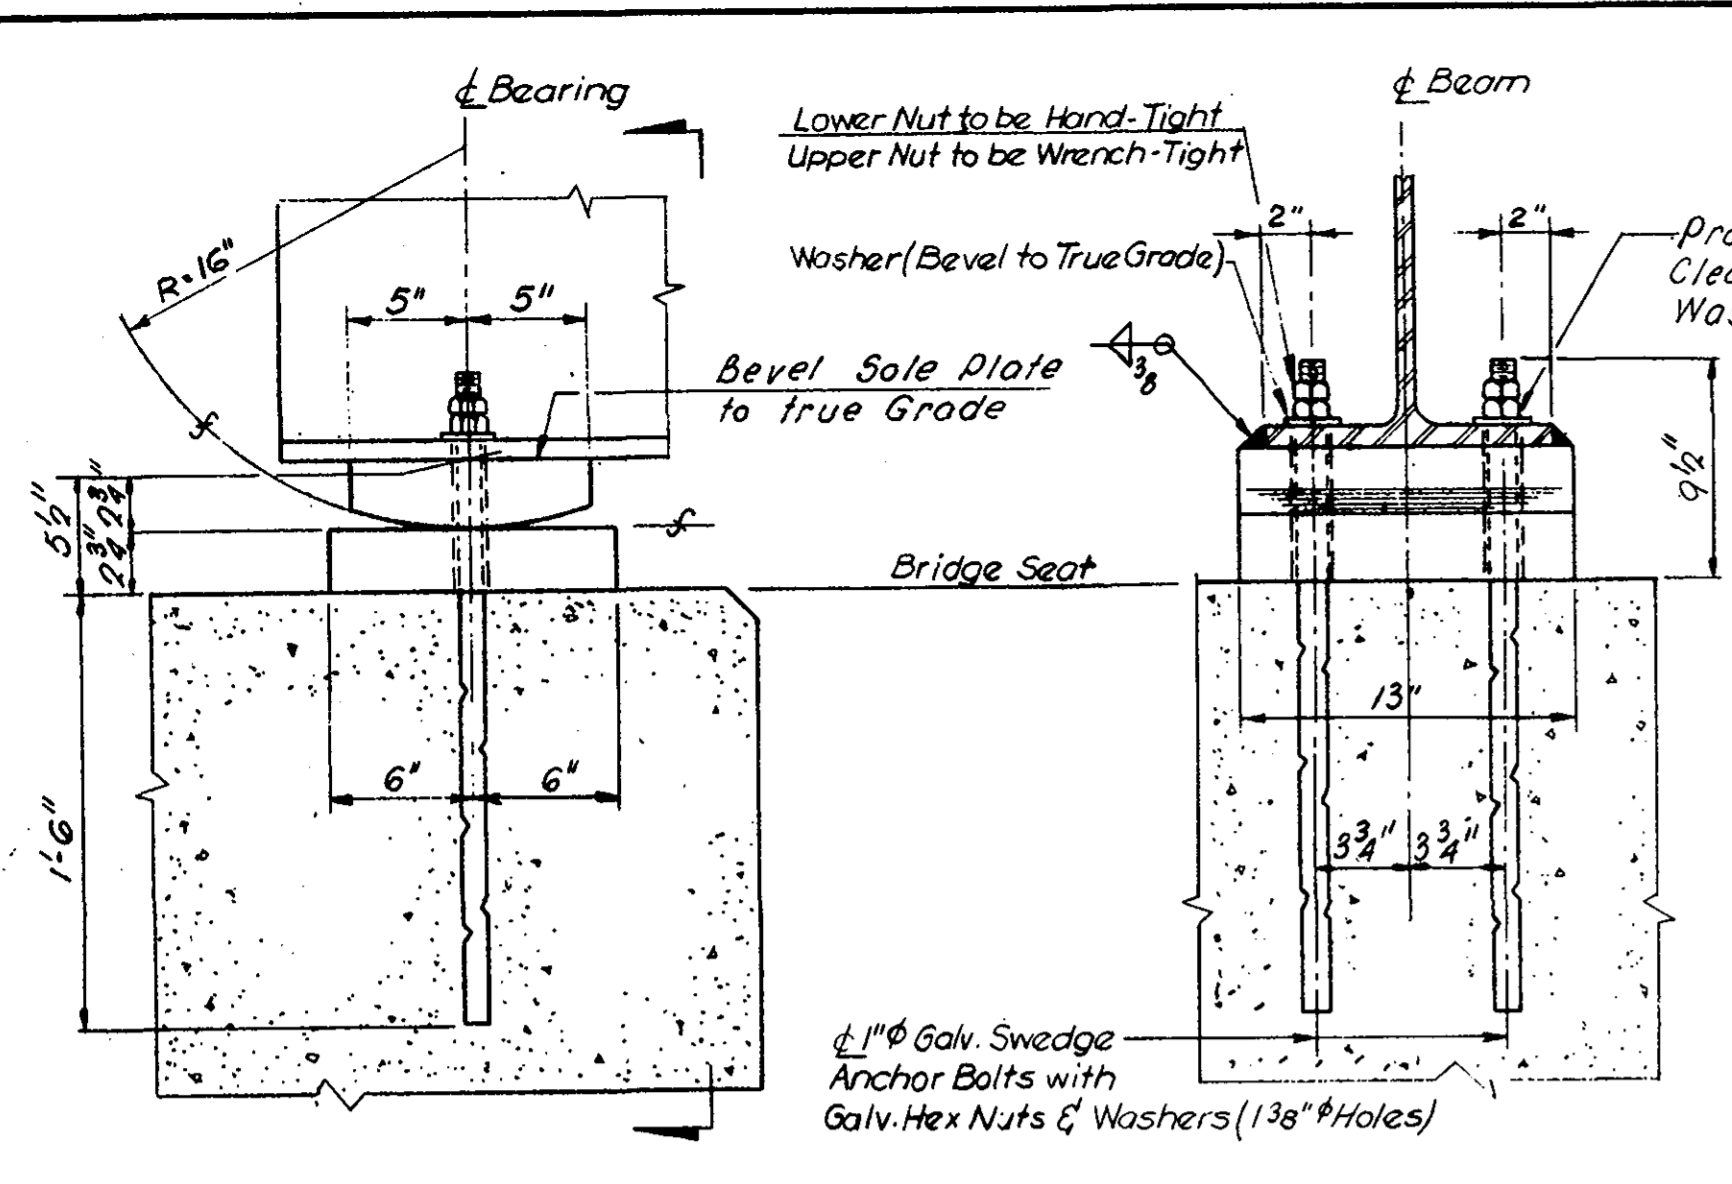


**FIXED BEARINGS**  
Scale 1/2"=1'-0"


- Notes**
- Masonry Plates and Sole Plates to be ASTM A36 Steel.  $\phi$  denotes ASA 125 microinches or Finer.
  - The finished surfaces shall meet the American Standard's Association surface roughness requirements as defined in ASAB46, surface roughness, waviness and lay, Part 1.
  - Anchor Bolts to be set by template and placed before concrete is poured.
  - Masonry Plate to have full bearing and to be adjusted for level before placing the Stringers on Bearing Assembly.

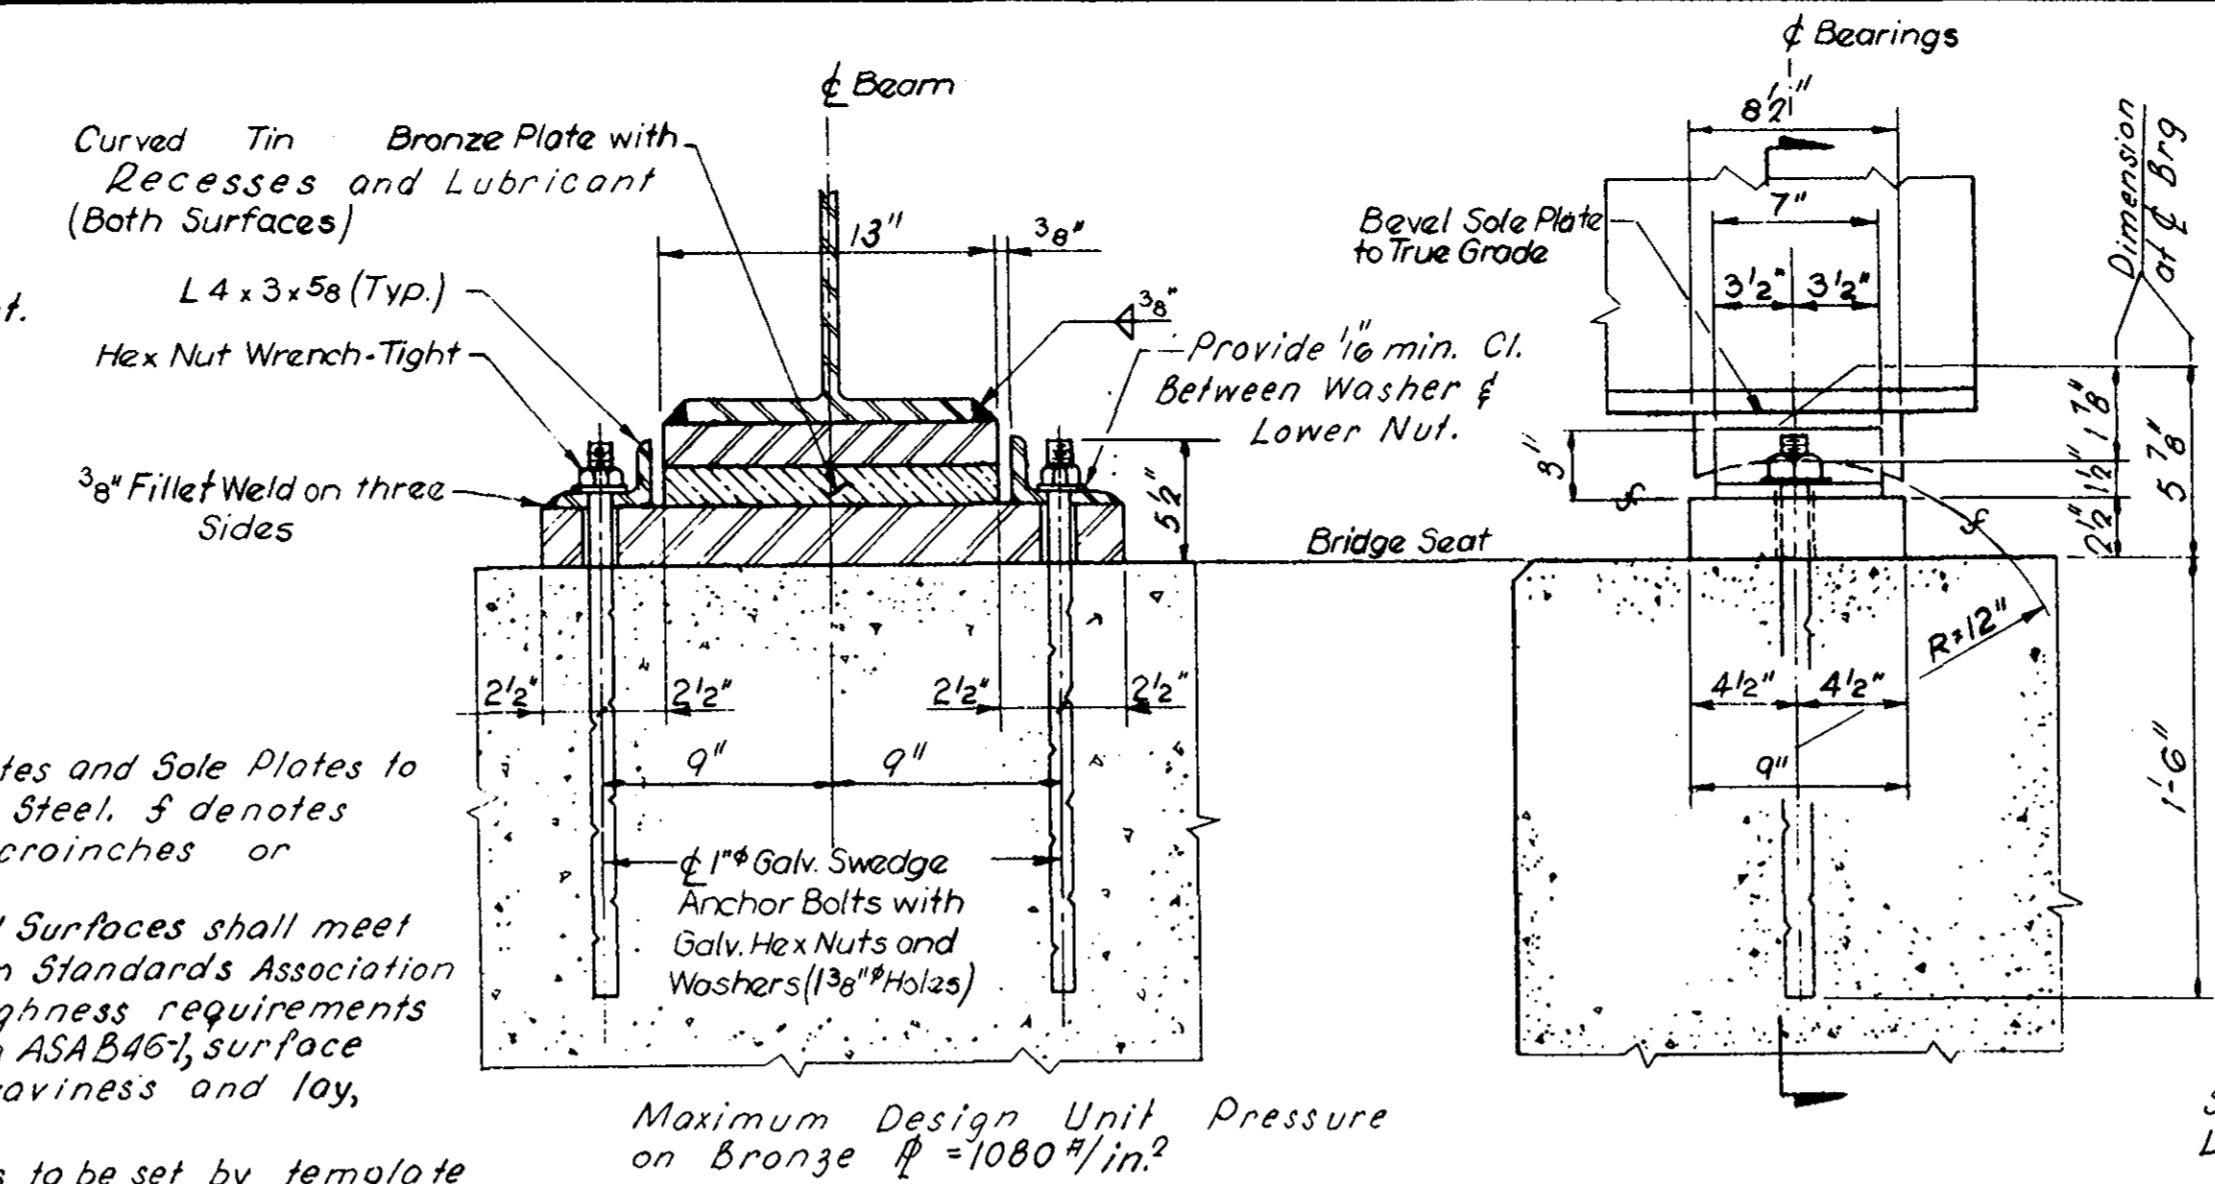


**EXPANSION BEARINGS**  
Scale 1/2"=1'-0"

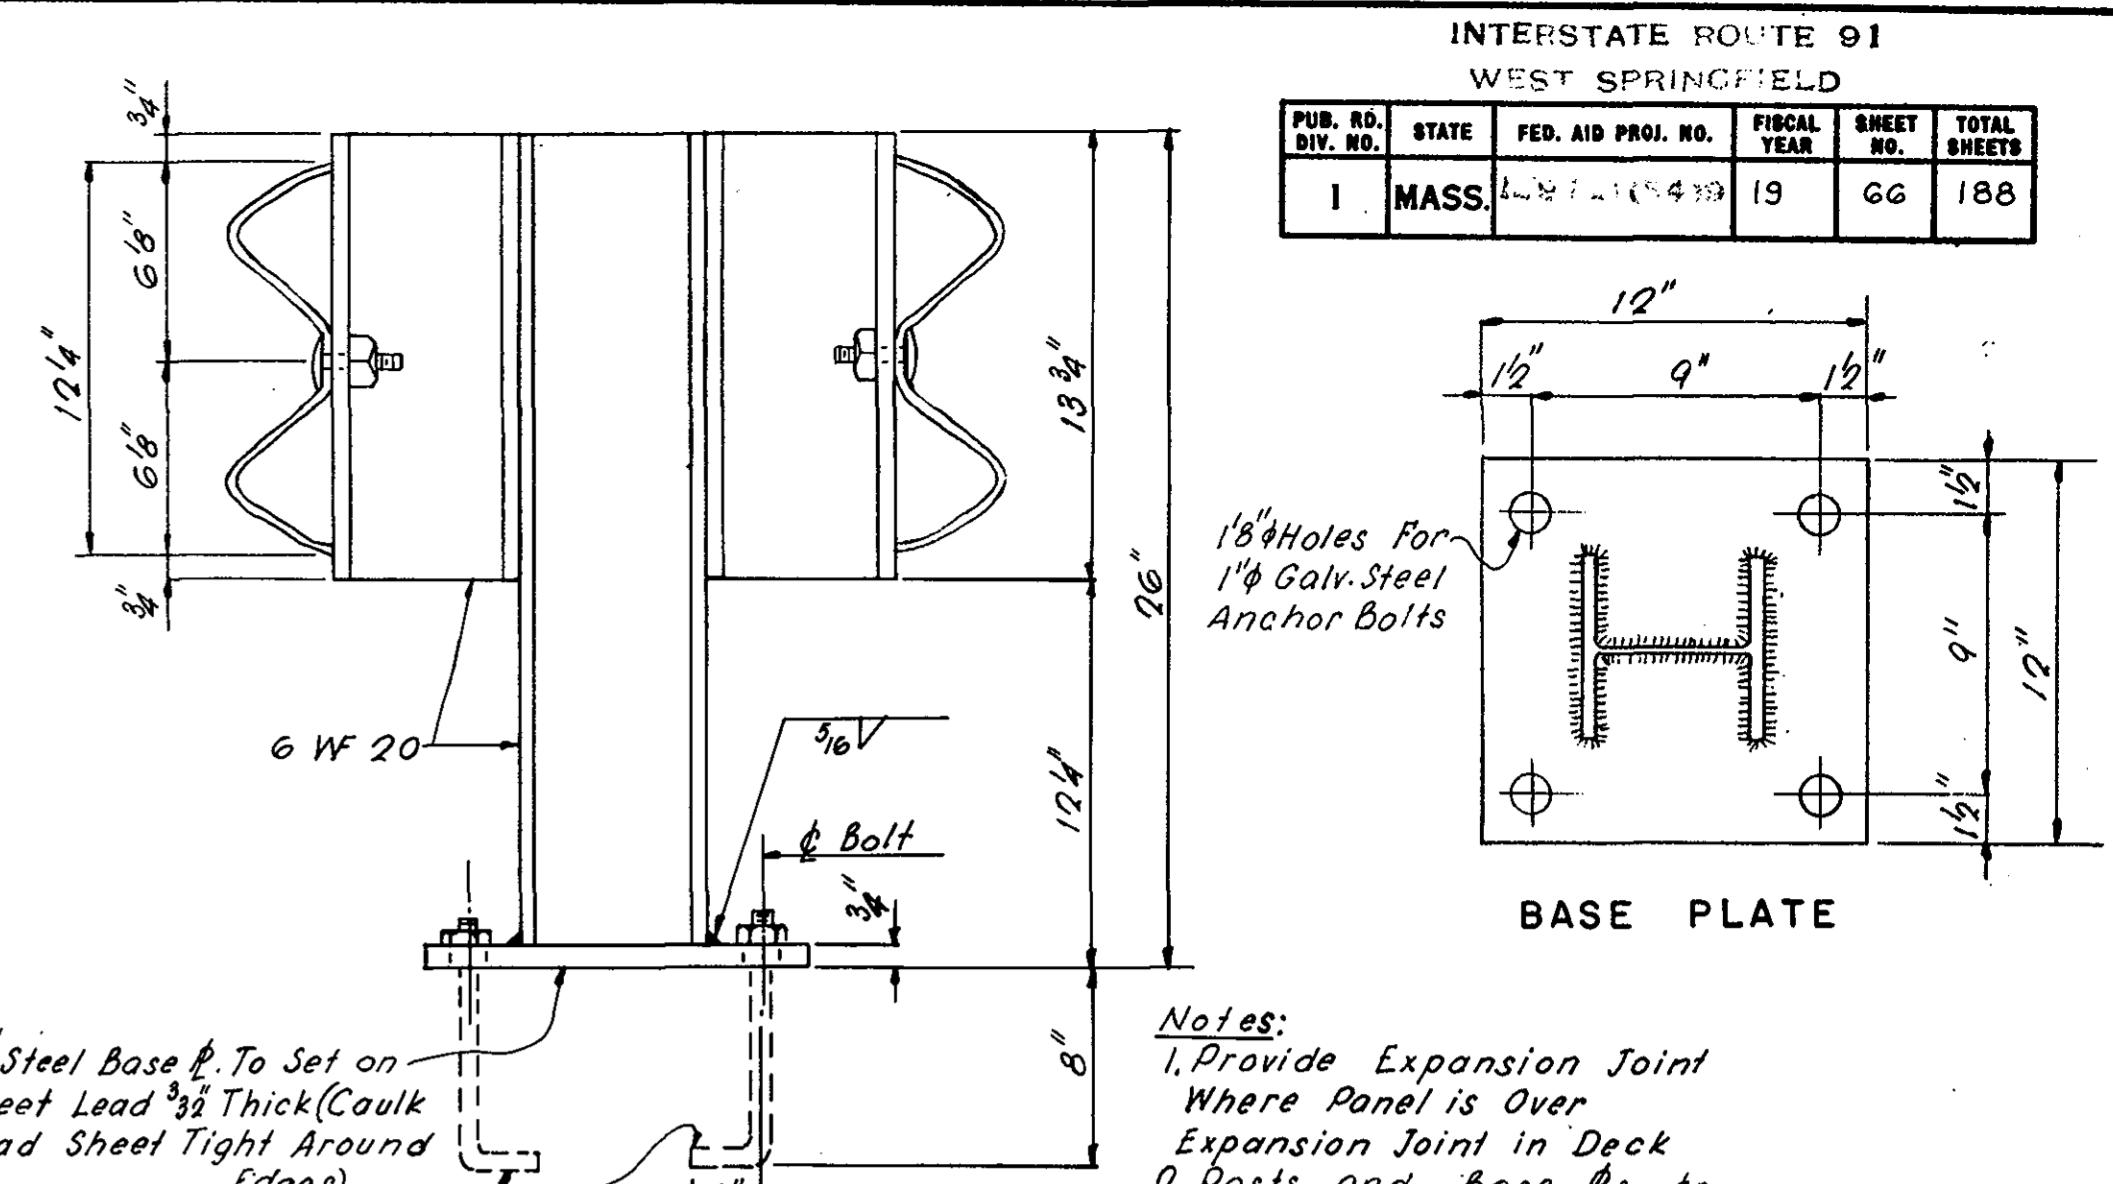


**ELEVATION OF POST METAL BRIDGE RAILING - TYPE M-2**  
Scale: 1"=0'-6"

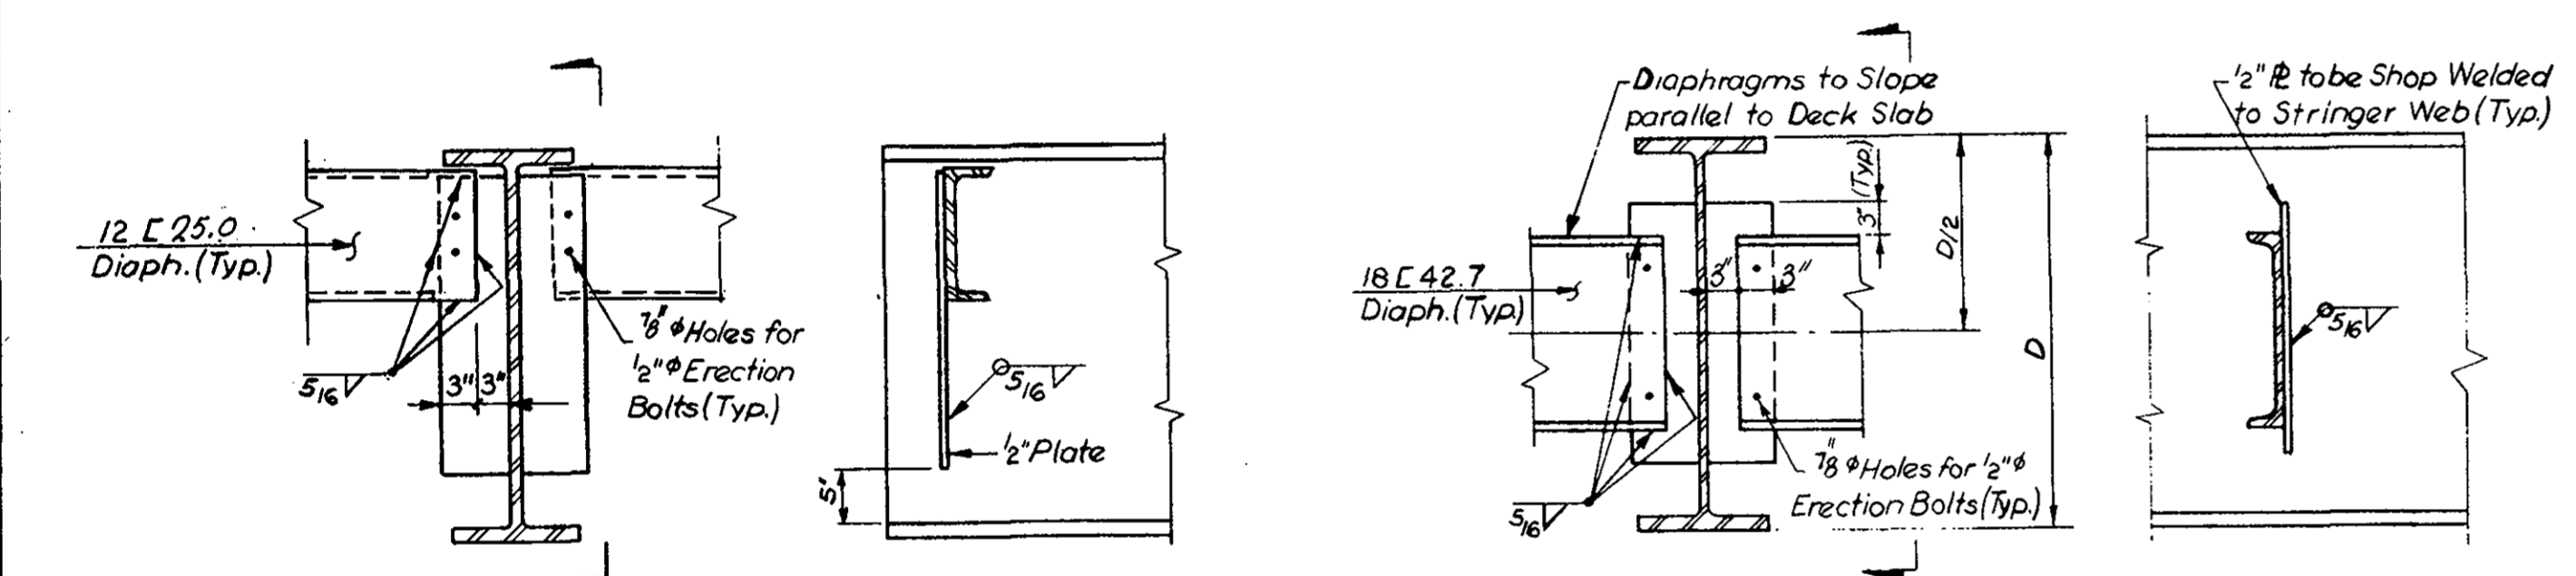


**TYPICAL DIAPHRAGM CONNECTIONS**  
Scale 3/4"=1'-0"

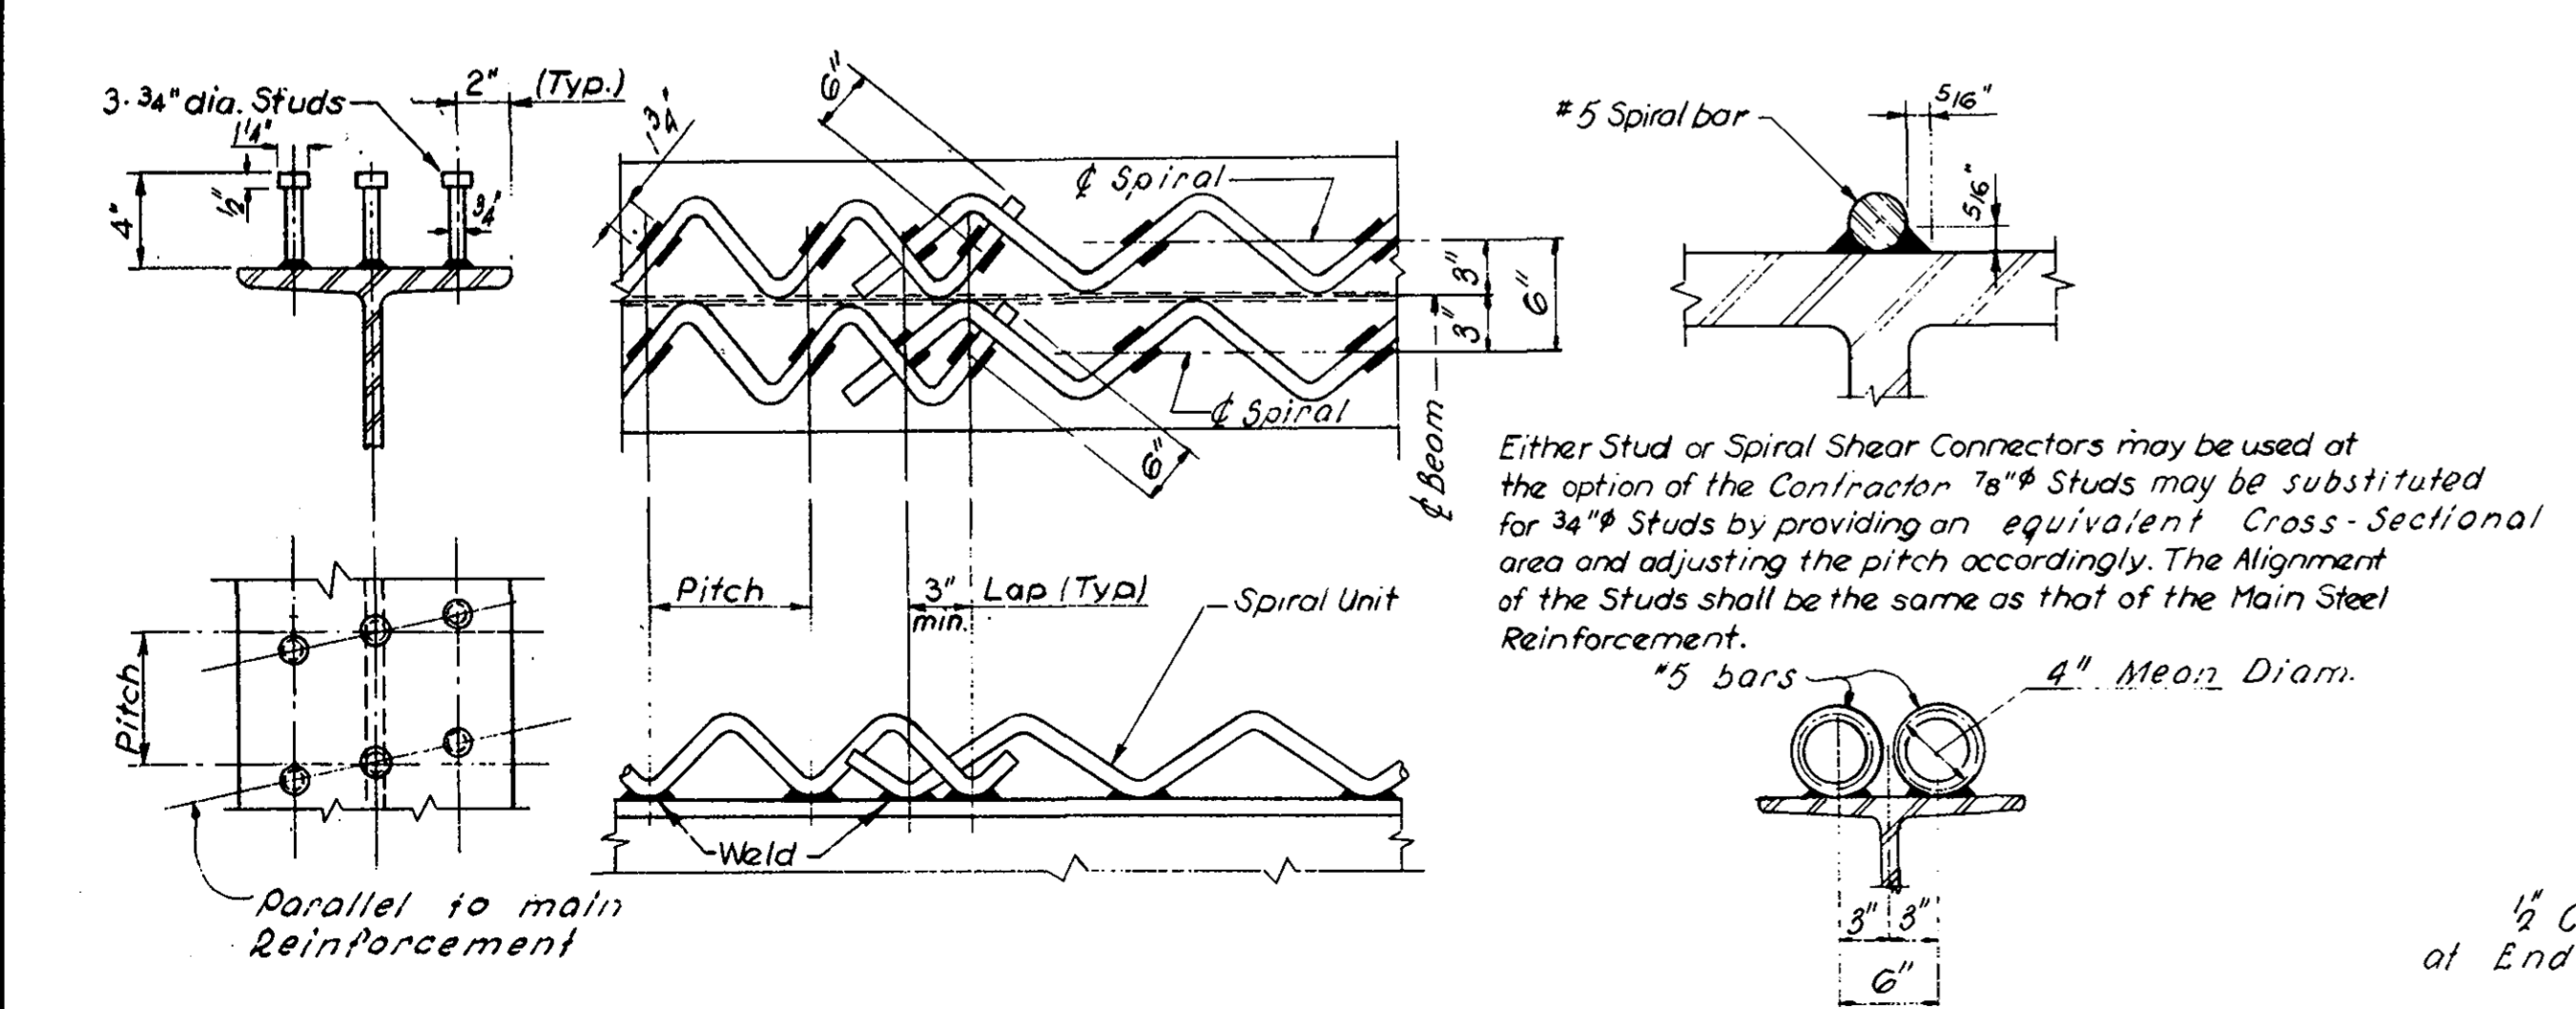

**SHEAR CONNECTOR DETAILS**  
No Scale

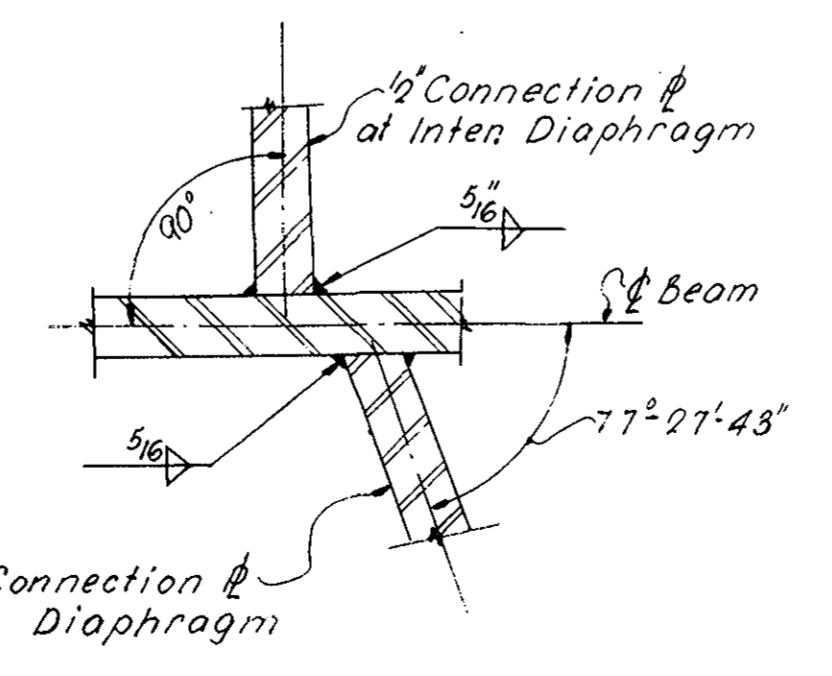


**CONNECTION PLATE DETAIL**

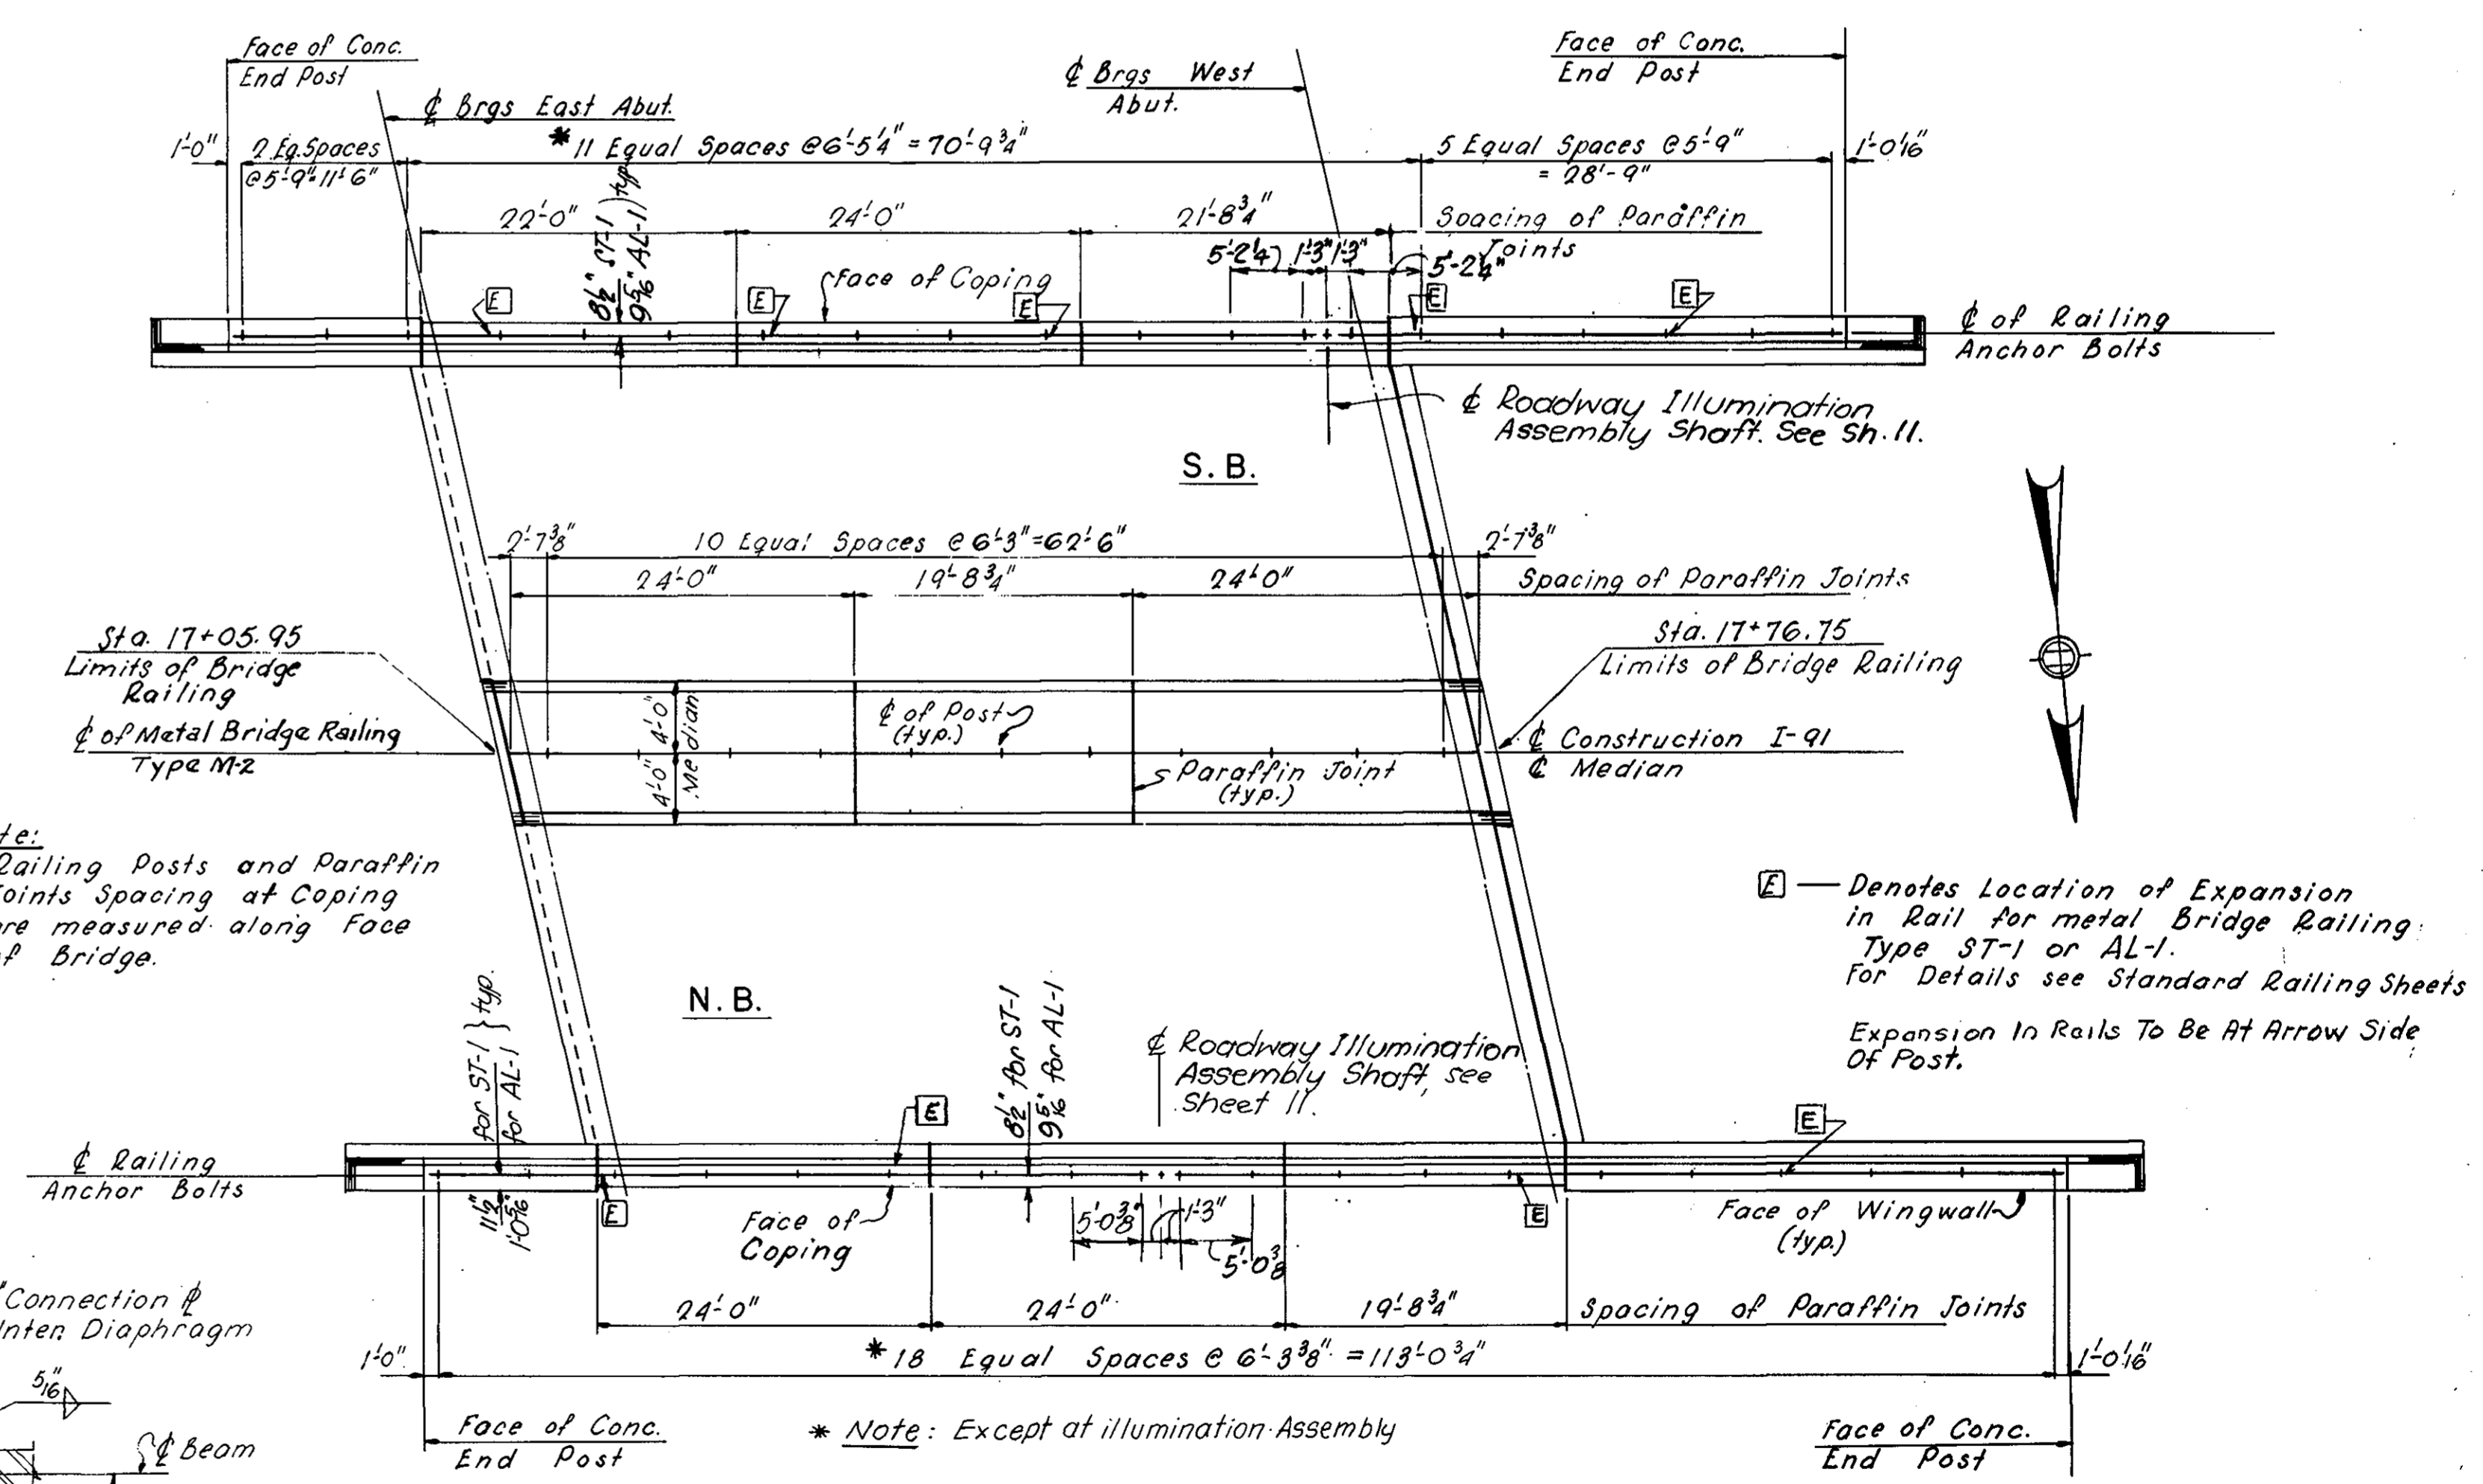


**RAILING POST & PARAFFIN JOINT LAYOUT PLAN**  
Not to scale

APRIL 9, 1966	ISSUED FOR CONSTRUCTION
DATE	DESCRIPTION
USE ONLY PRINTS OF LATEST DATE	


PUB. RD. DIV. NO.	STATE	FED. AID PROJ. NO.	FISCAL YEAR	SHEET NO.	TOTAL SHEETS
1	MASS.	I-91-1(54)9		67	188

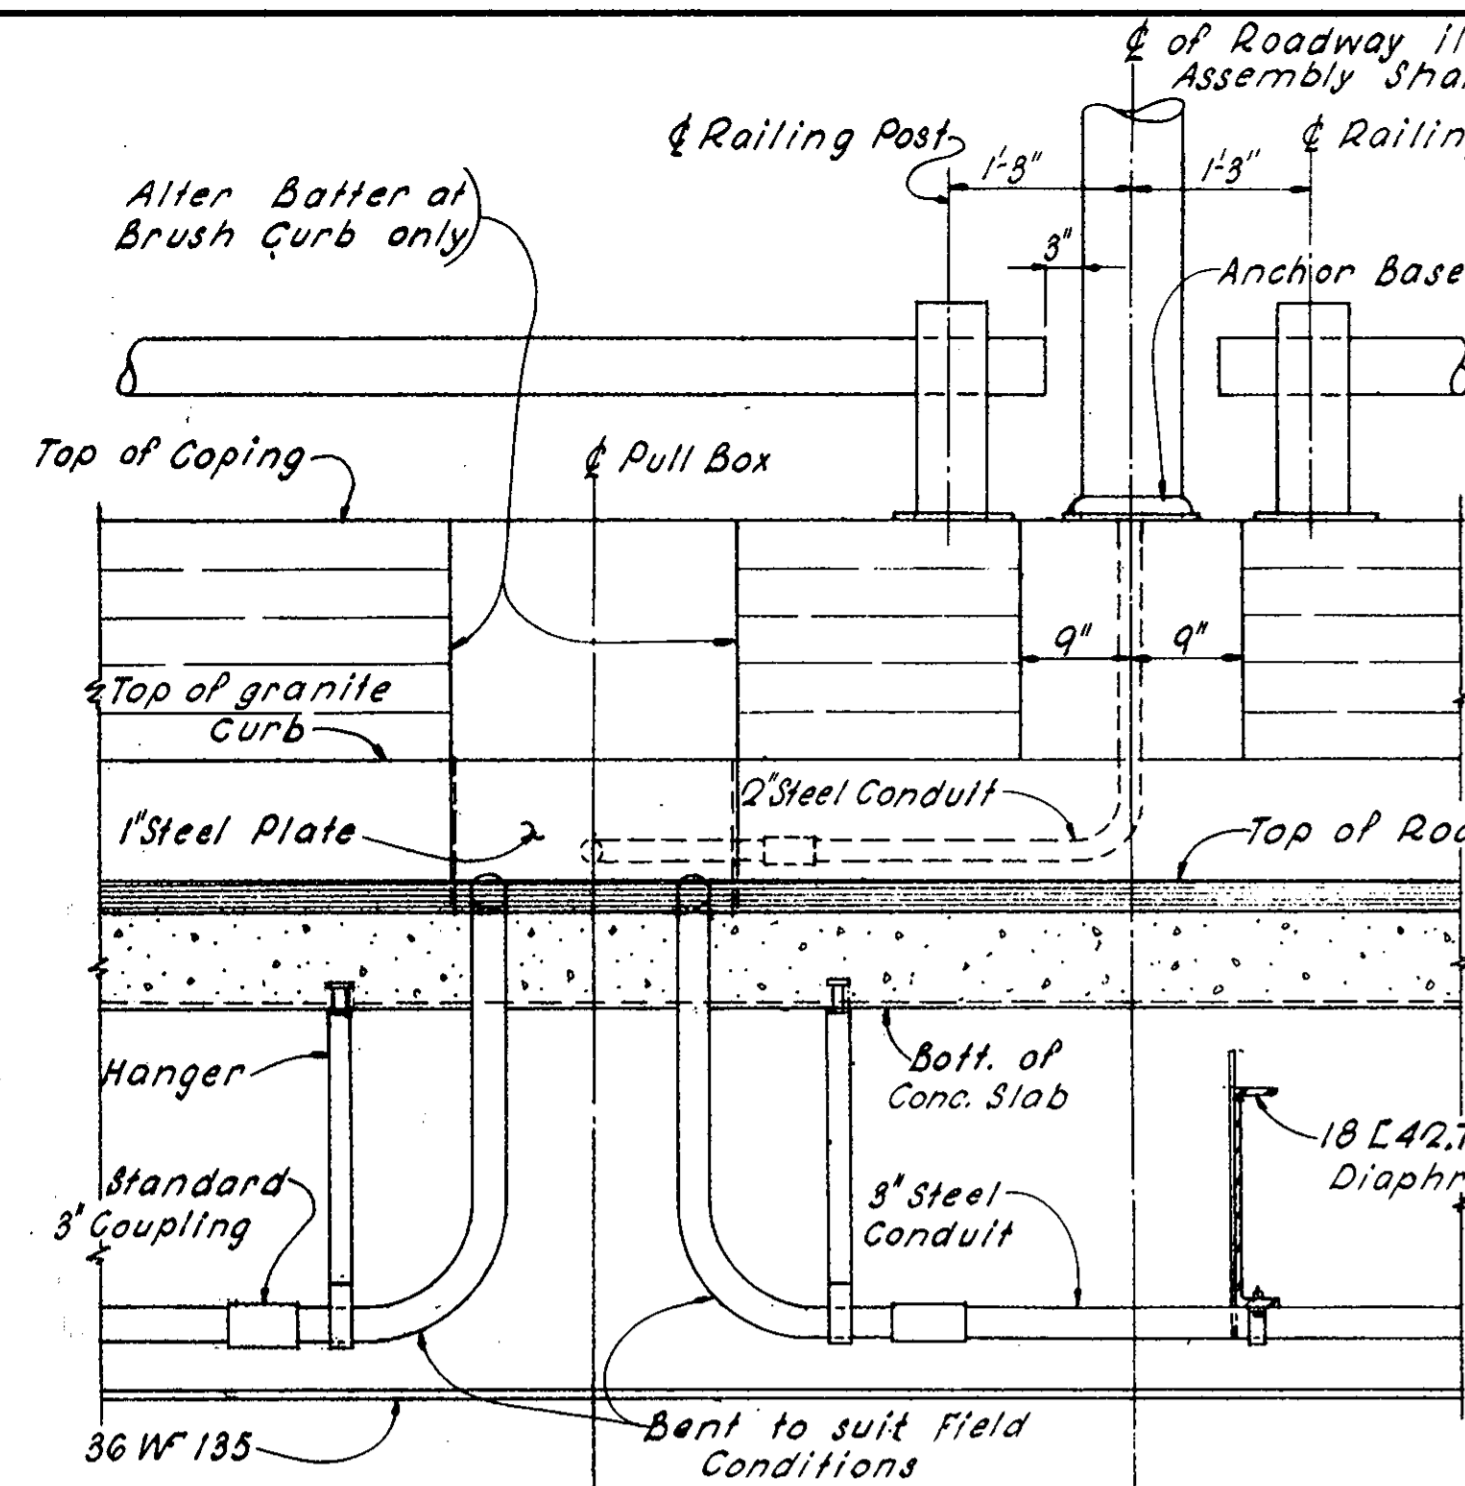


VIEW A-A

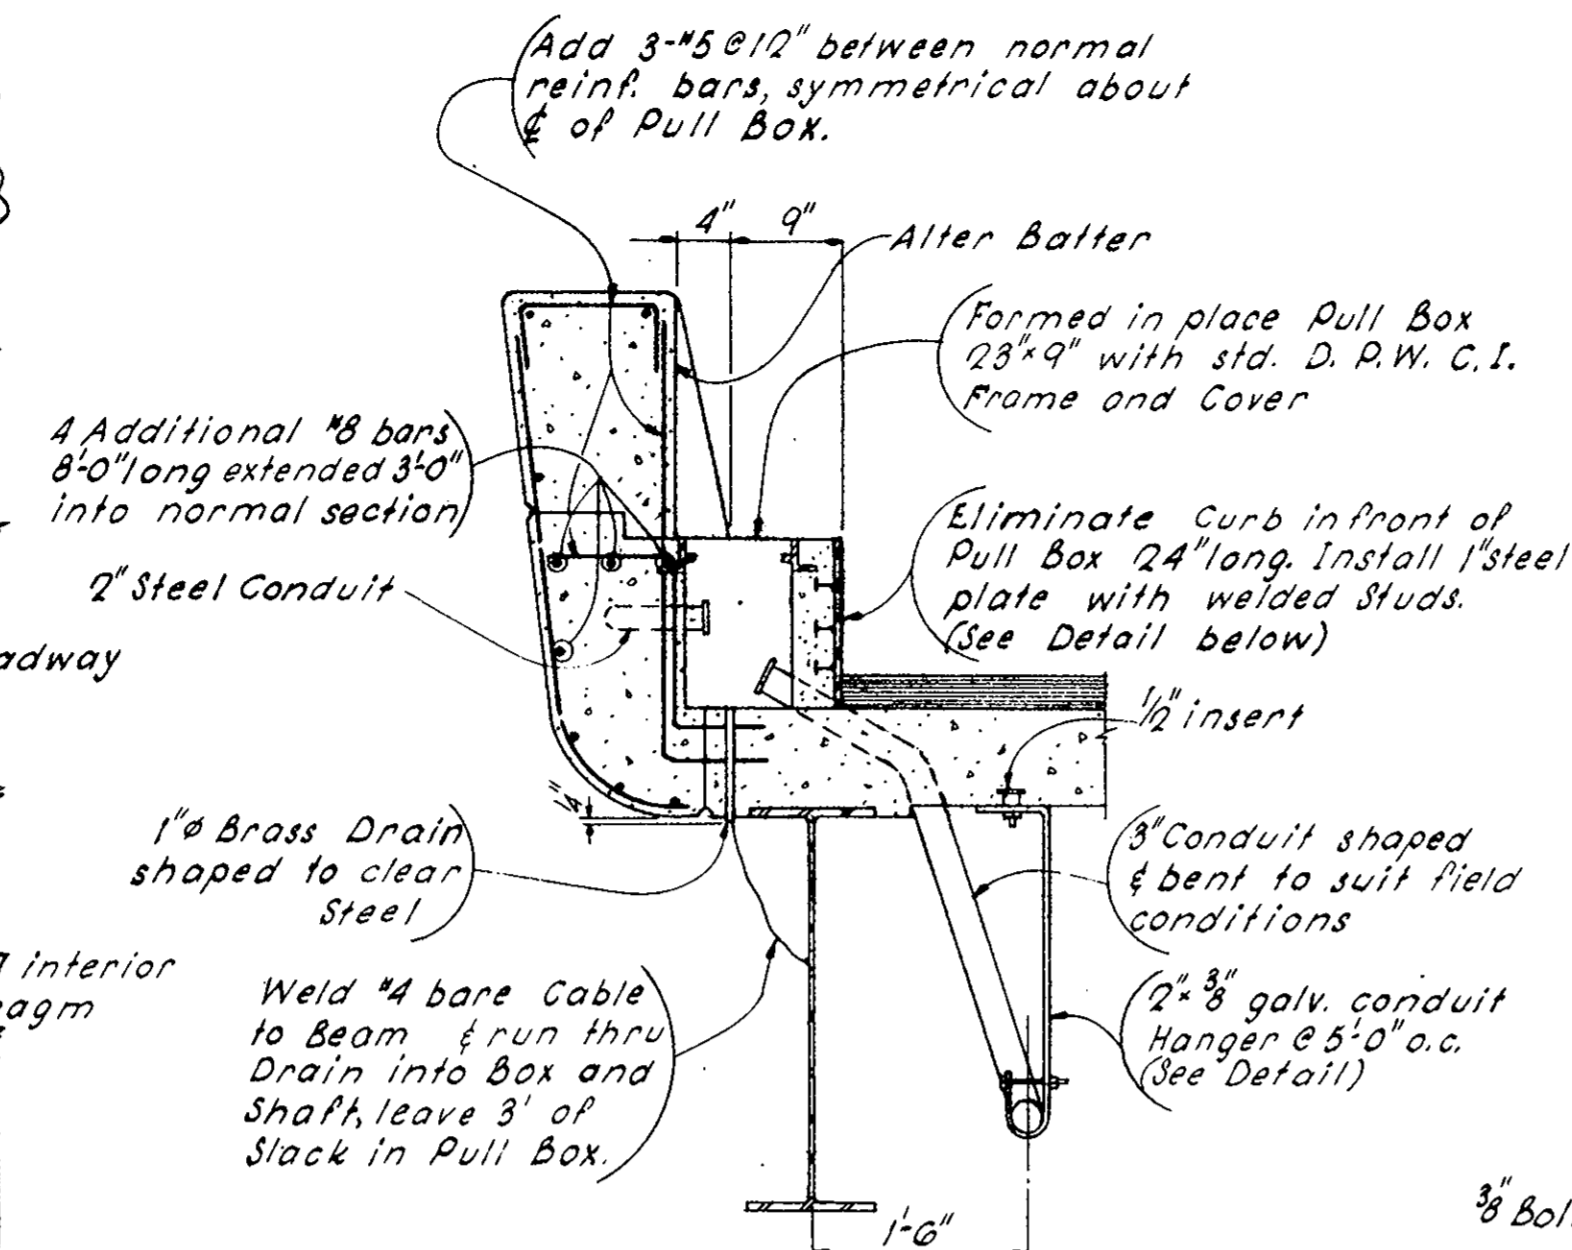


SECTION B-B

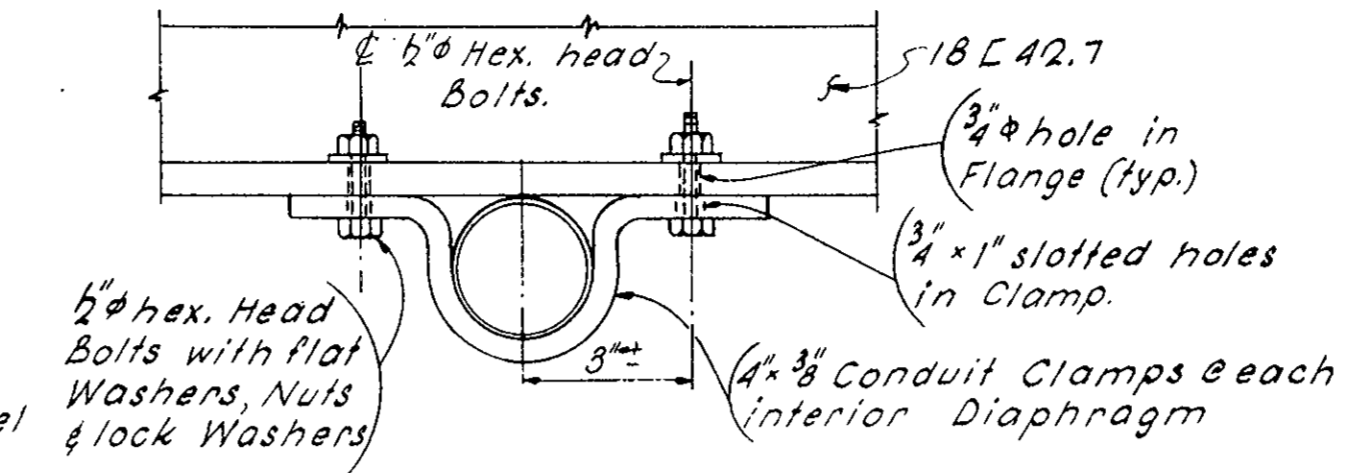


CONDUIT SUPPORT AT DIAPHRAGMS  
(No Scale)

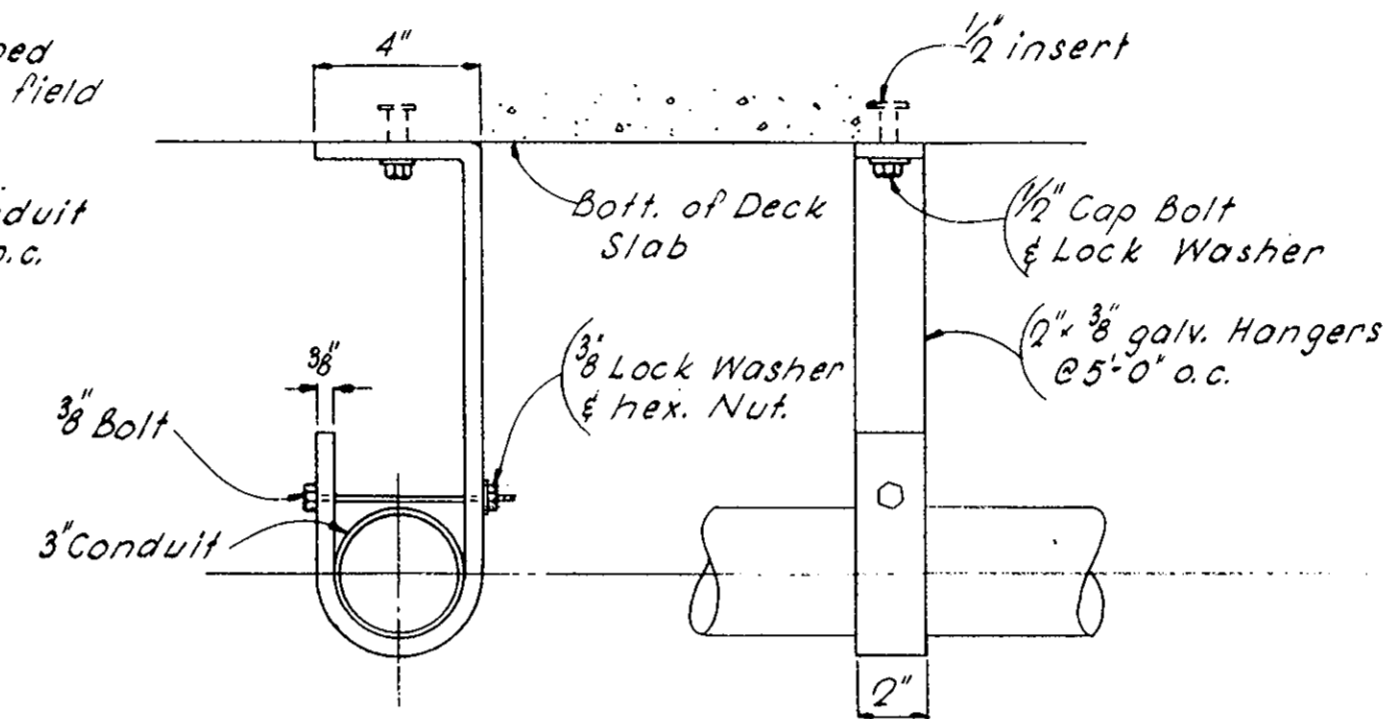


CONDUIT HANGER  
(No Scale)

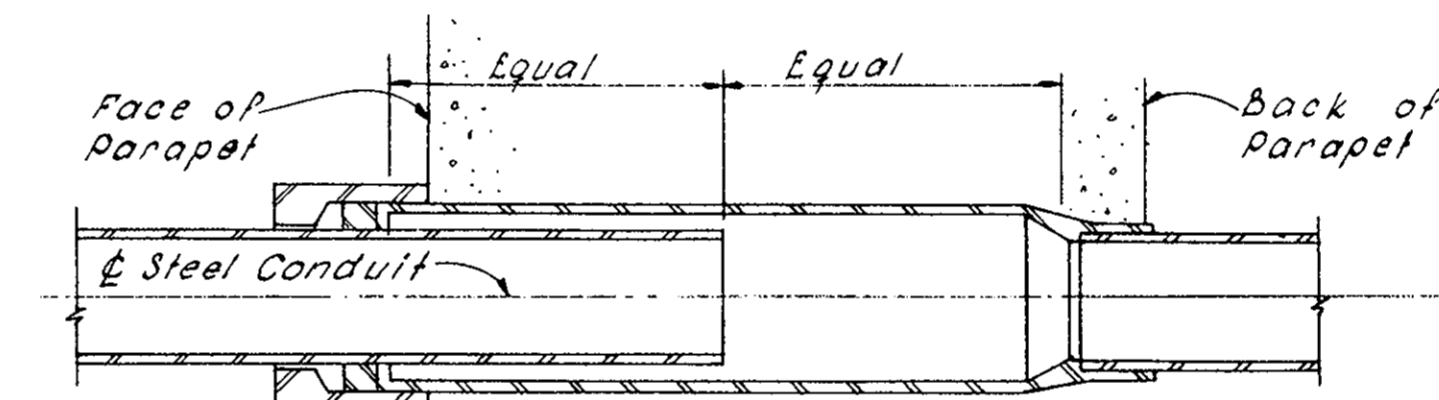


EXPANSION SLEEVE AT ABUTMENT  
(No Scale)

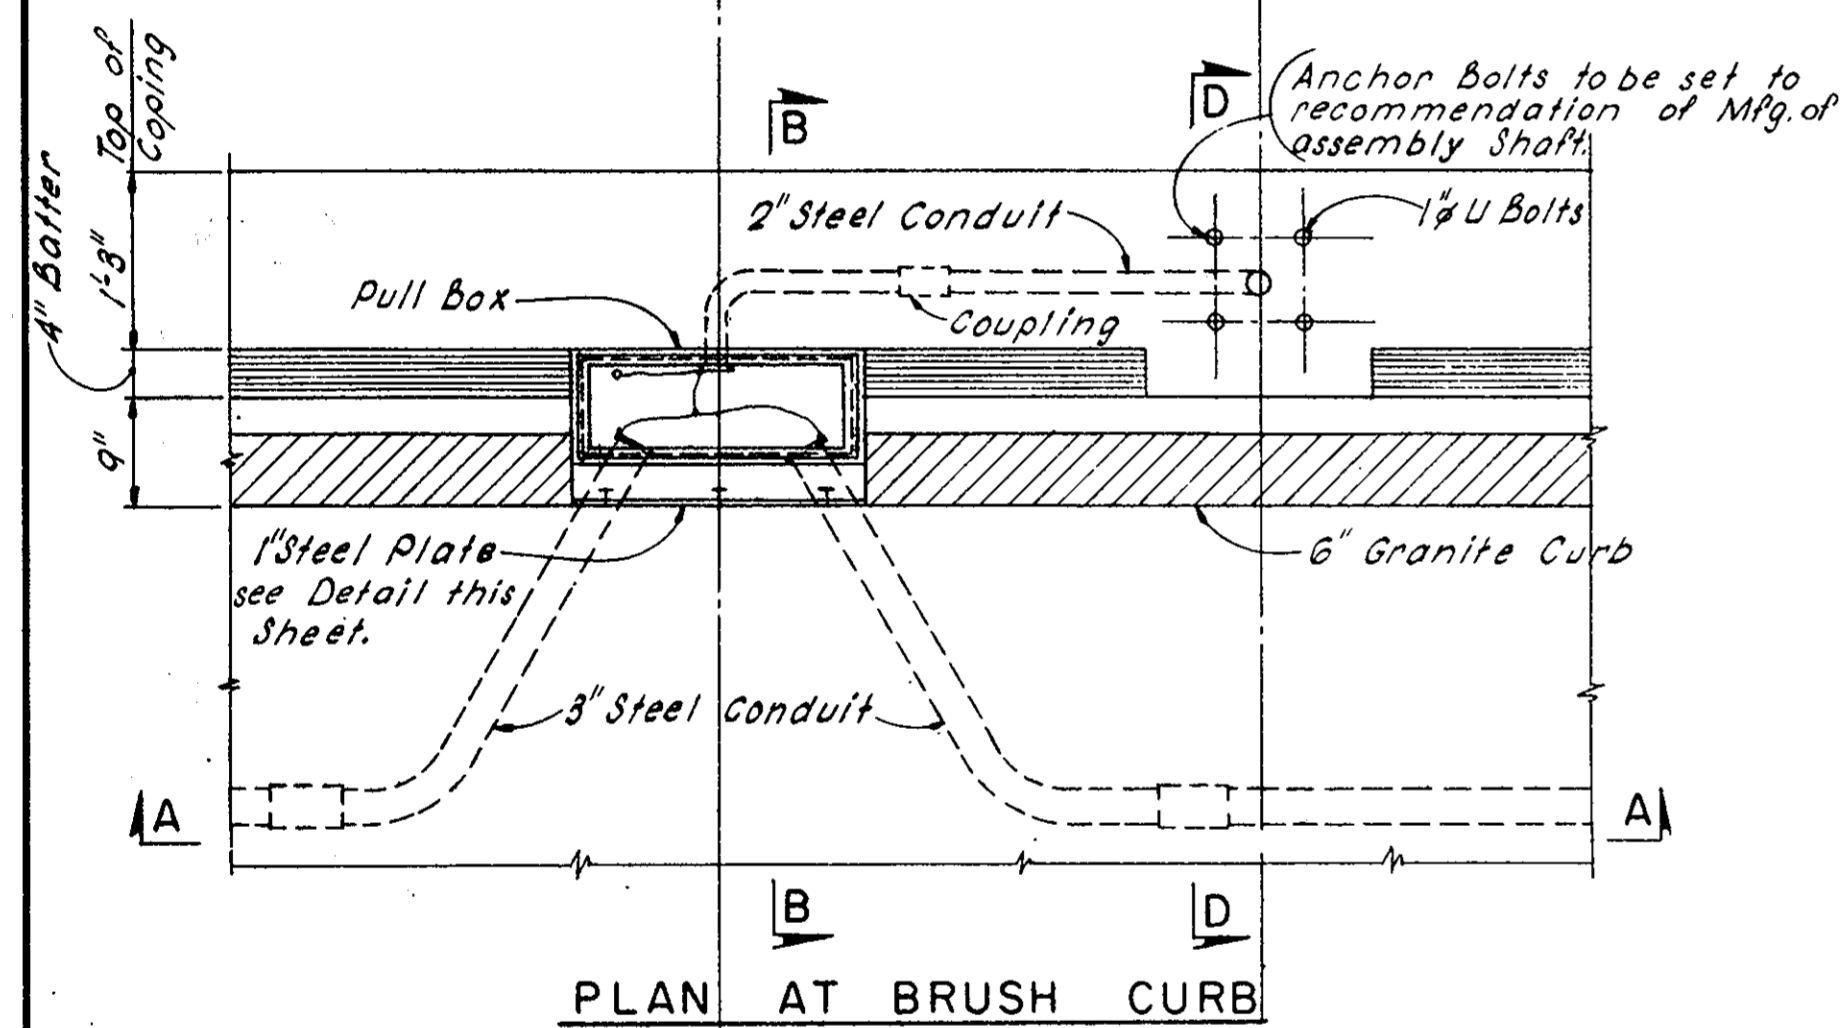

PLAN AT BRUSH CURB

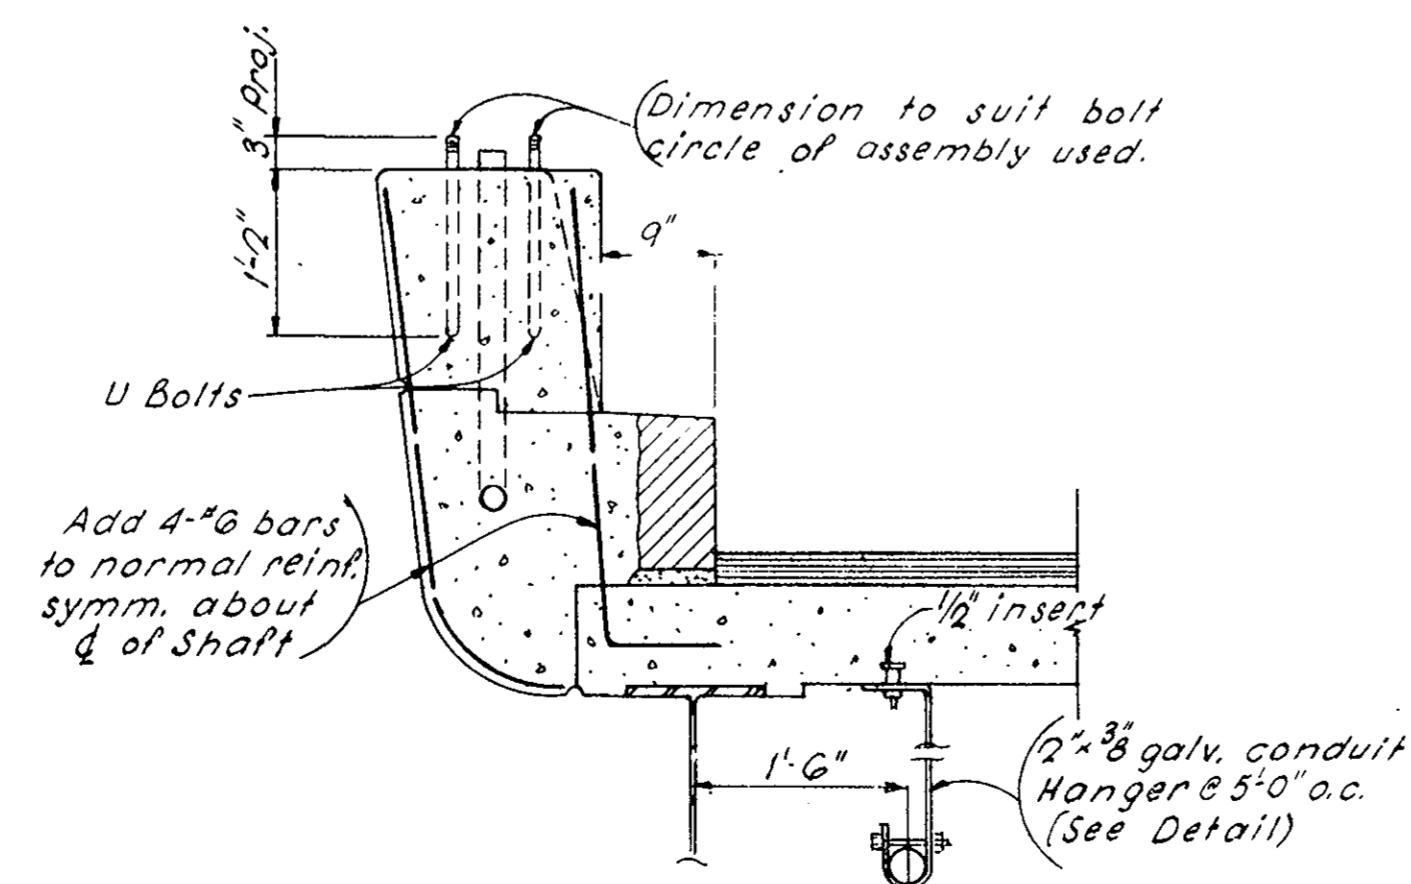

SECTION D-D

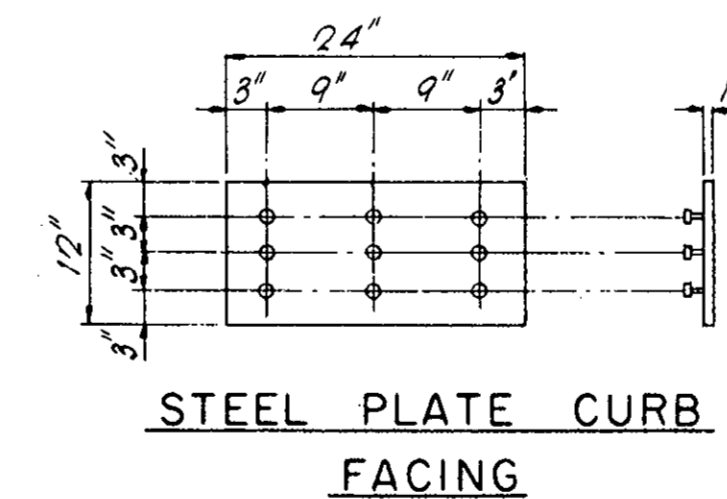

STEEL PLATE CURB FACING

DATE	DESCRIPTION
APRIL 9, 1966	ISSUED FOR CONSTRUCTION
	USE ONLY PRINTS OF LATEST DATE



STATE	FED. AID PROJ. NO.	SHEET NO.	TOTAL SHEETS
MA	NHP(NHS)-091S(305)X	34	39
PROJECT FILE NO.		608600	


**LIGHT SUPPORT DETAILS**

**NOTES:**

- FOR GENERAL NOTES, SEE SHEET 1 OF 2.
- PROPOSED BRIDGE RAILING SHALL BE REINSTALLED CONTINUOUS AT AREAS OF EXISTING LIGHT POLE REMOVAL. CONTRACTOR SHALL FIELD VERIFY RAILING SECTION LENGTHS, SPLICE LOCATIONS, AND POST LOCATIONS TO DETERMINE WHAT COMPONENTS AND LOCATIONS CAN BE REUSED. SHOP DRAWINGS SHALL BE SUBMITTED TO THE ENGINEER FOR APPROVAL OF MATERIALS AND PROPOSED LAYOUT PRIOR TO RAILING REINSTALLATION.


**LEGEND:**

 LIMITS OF DEMOLITION

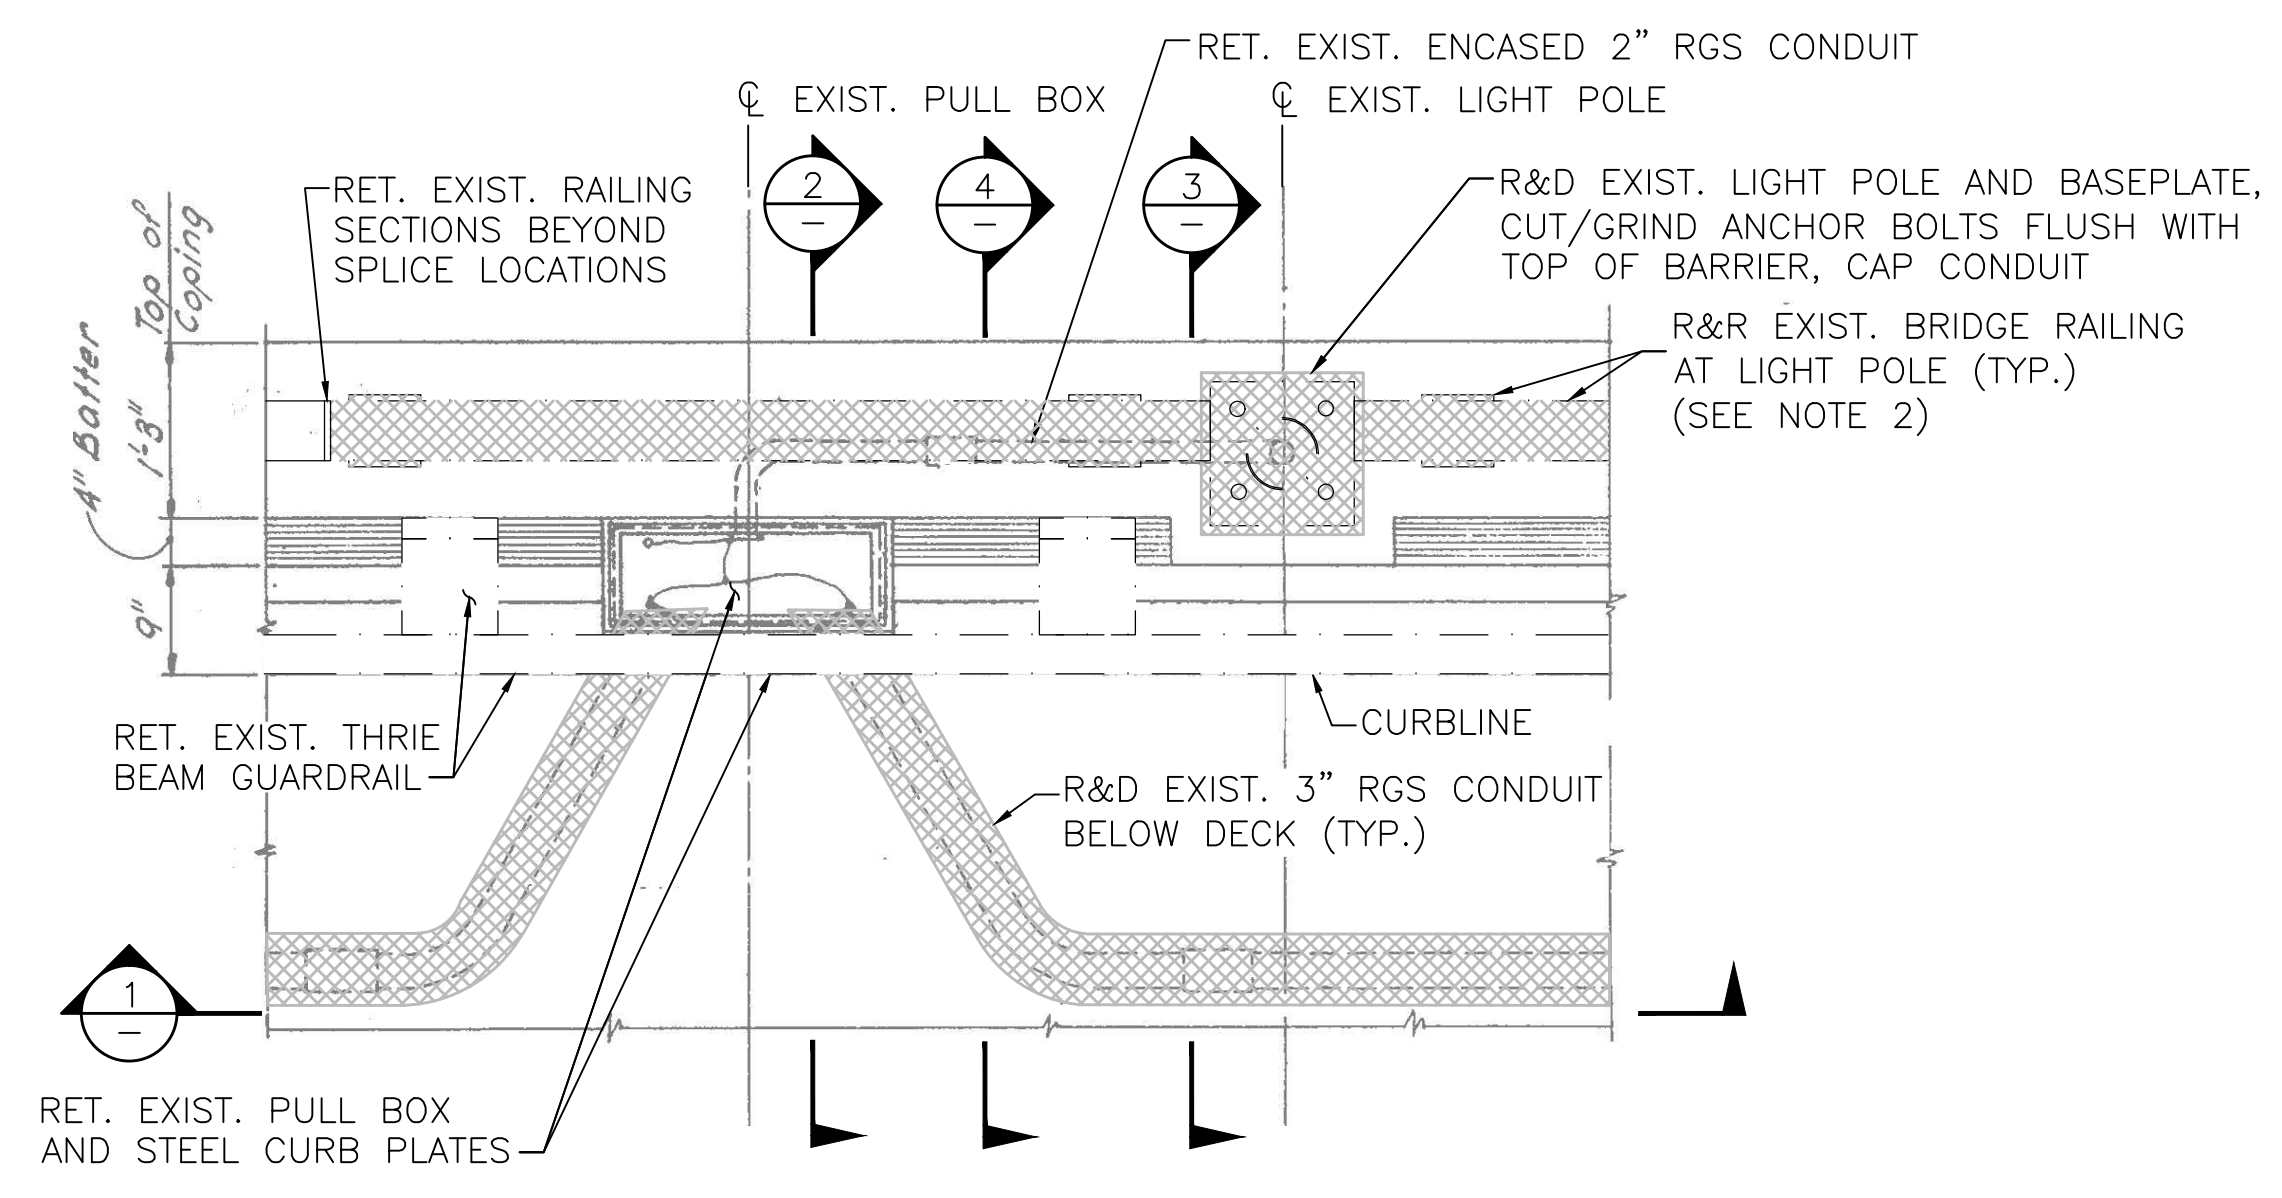


**PARTIAL PLAN AT EXISTING LIGHT POLE**

SCALE: 3/4" = 1'-0"

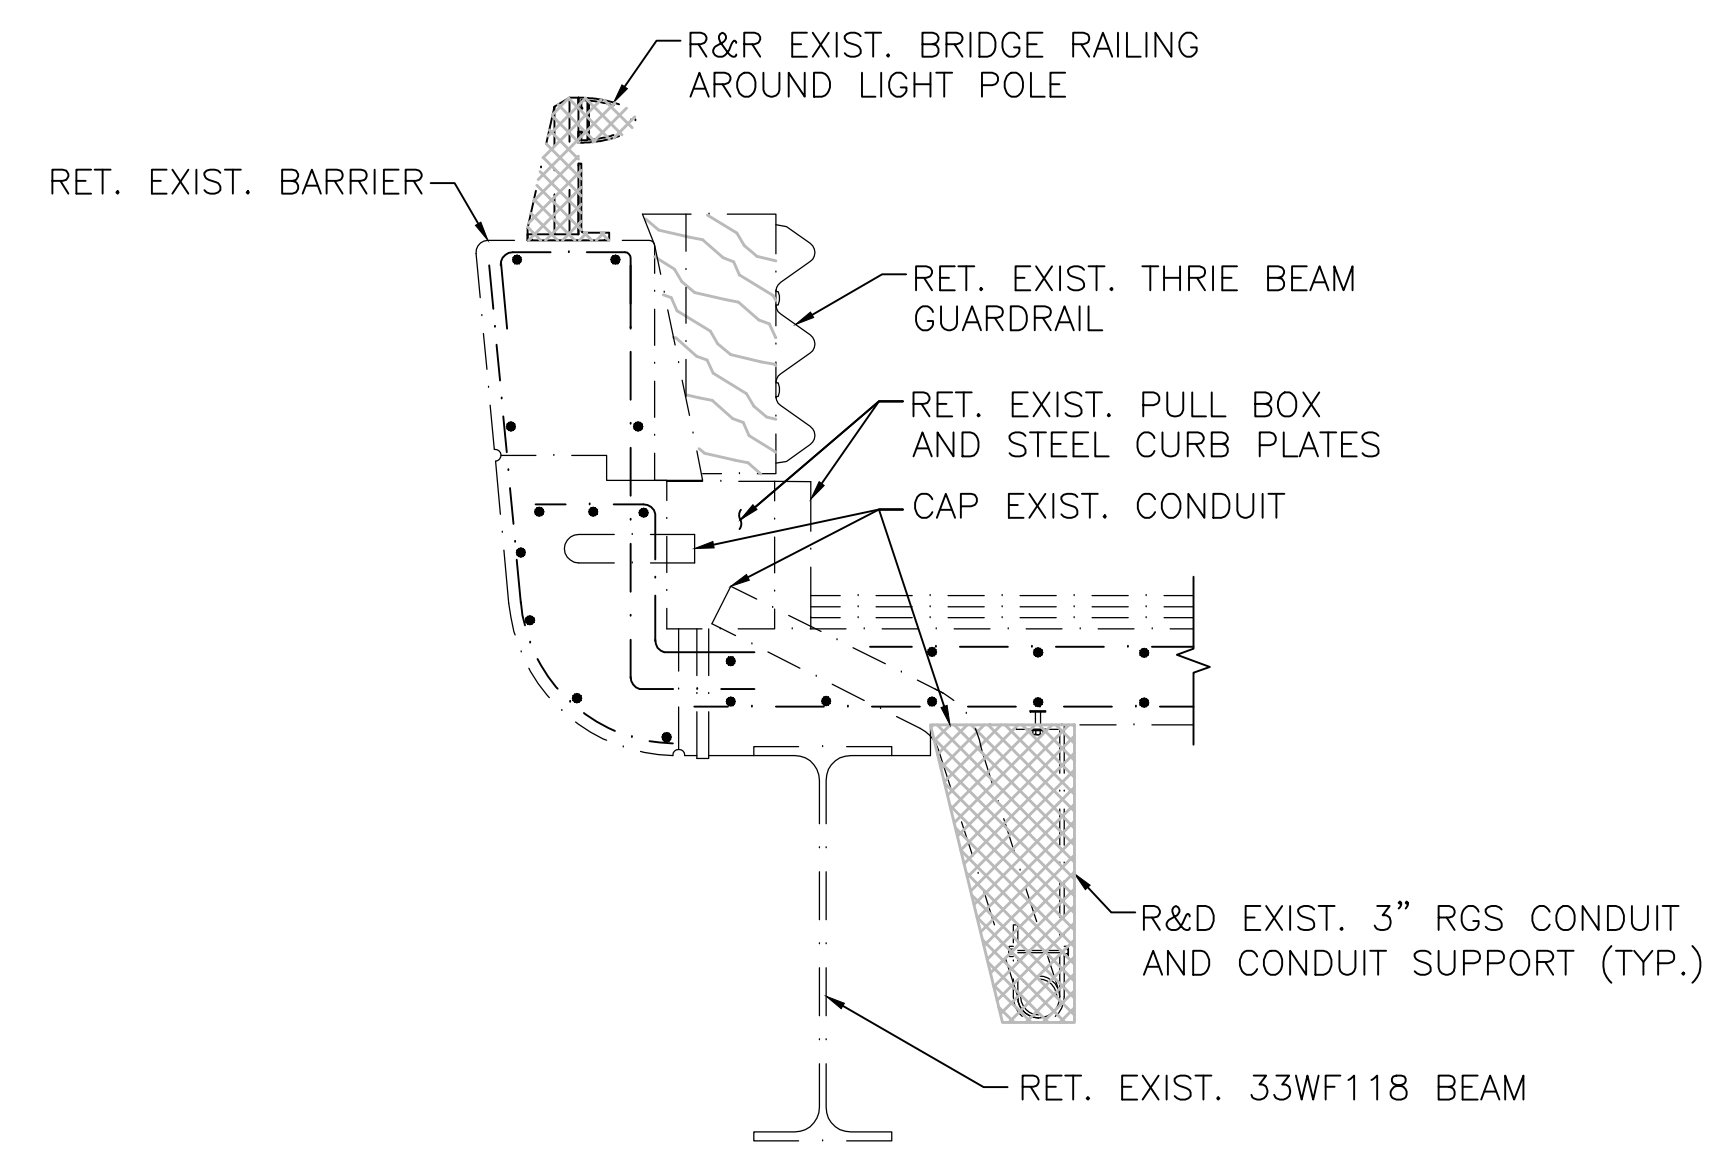

**SECTION AT EXISTING PULL BOX**


SCALE: 3/4" = 1'-0"

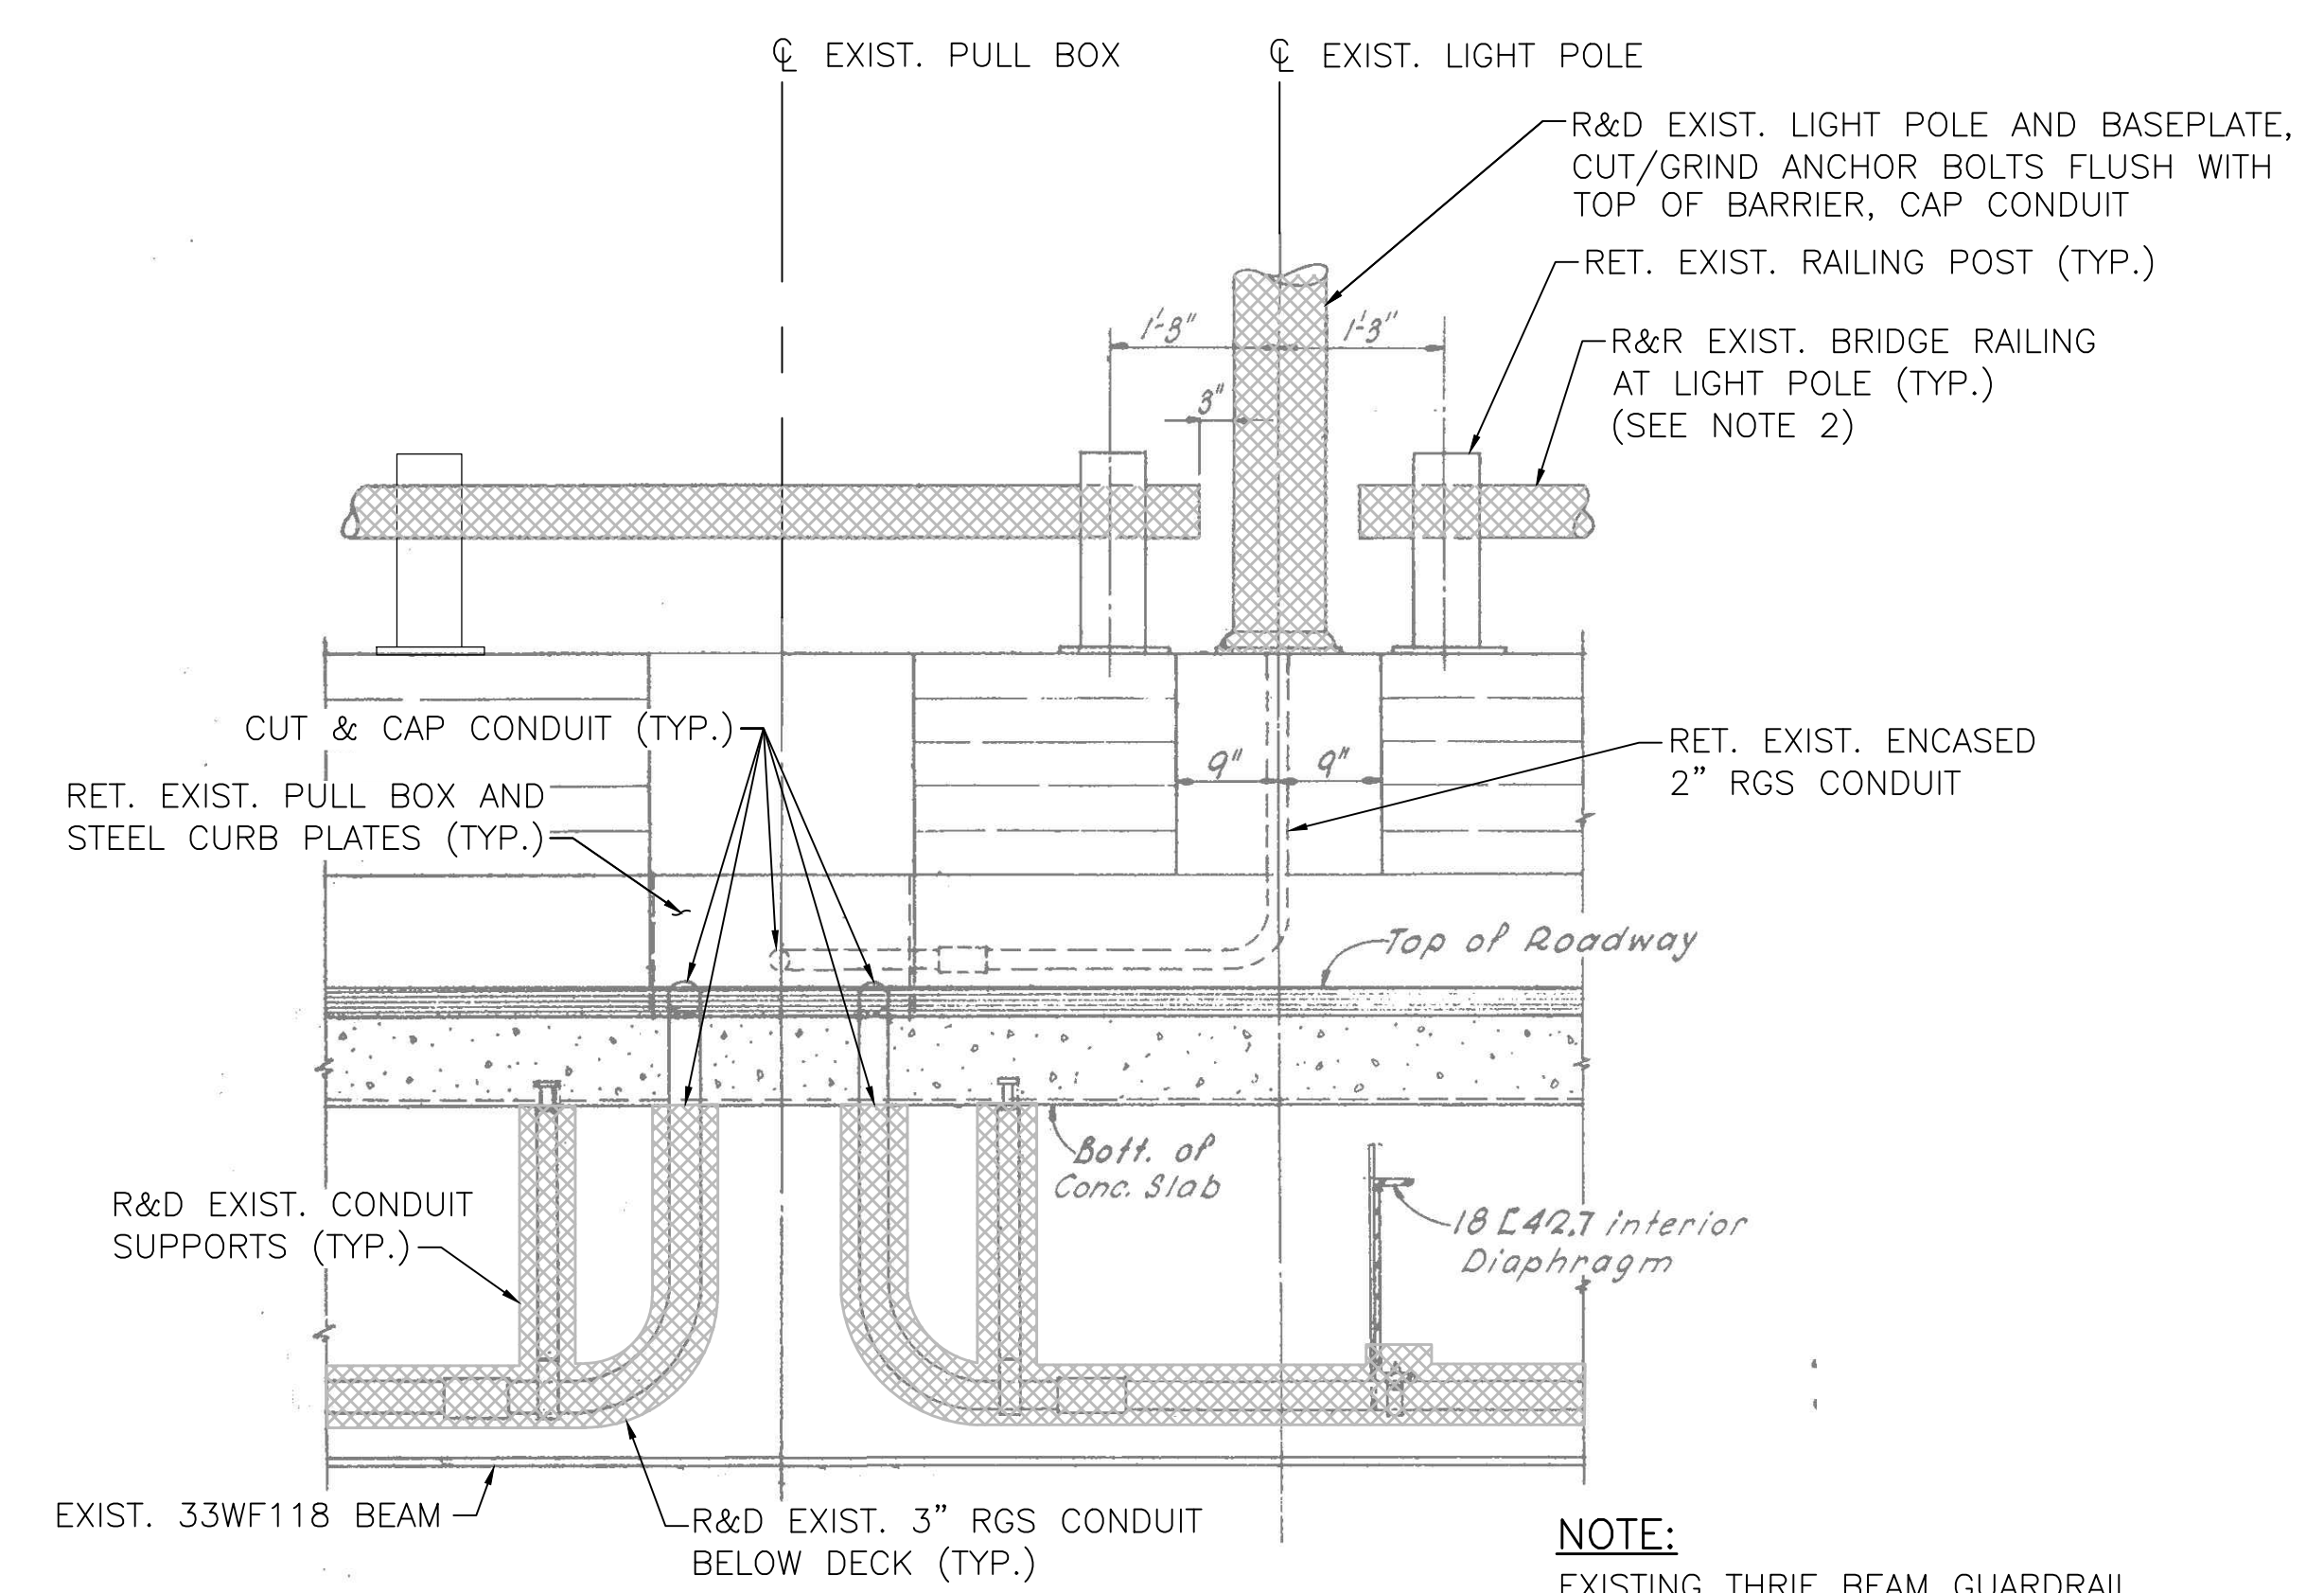

**SECTION AT EXISTING LIGHT POLE**


SCALE: 3/4" = 1'-0"

**NOTE:**  
EXISTING THRIE BEAM GUARDRAIL NOT SHOWN FOR CLARITY.

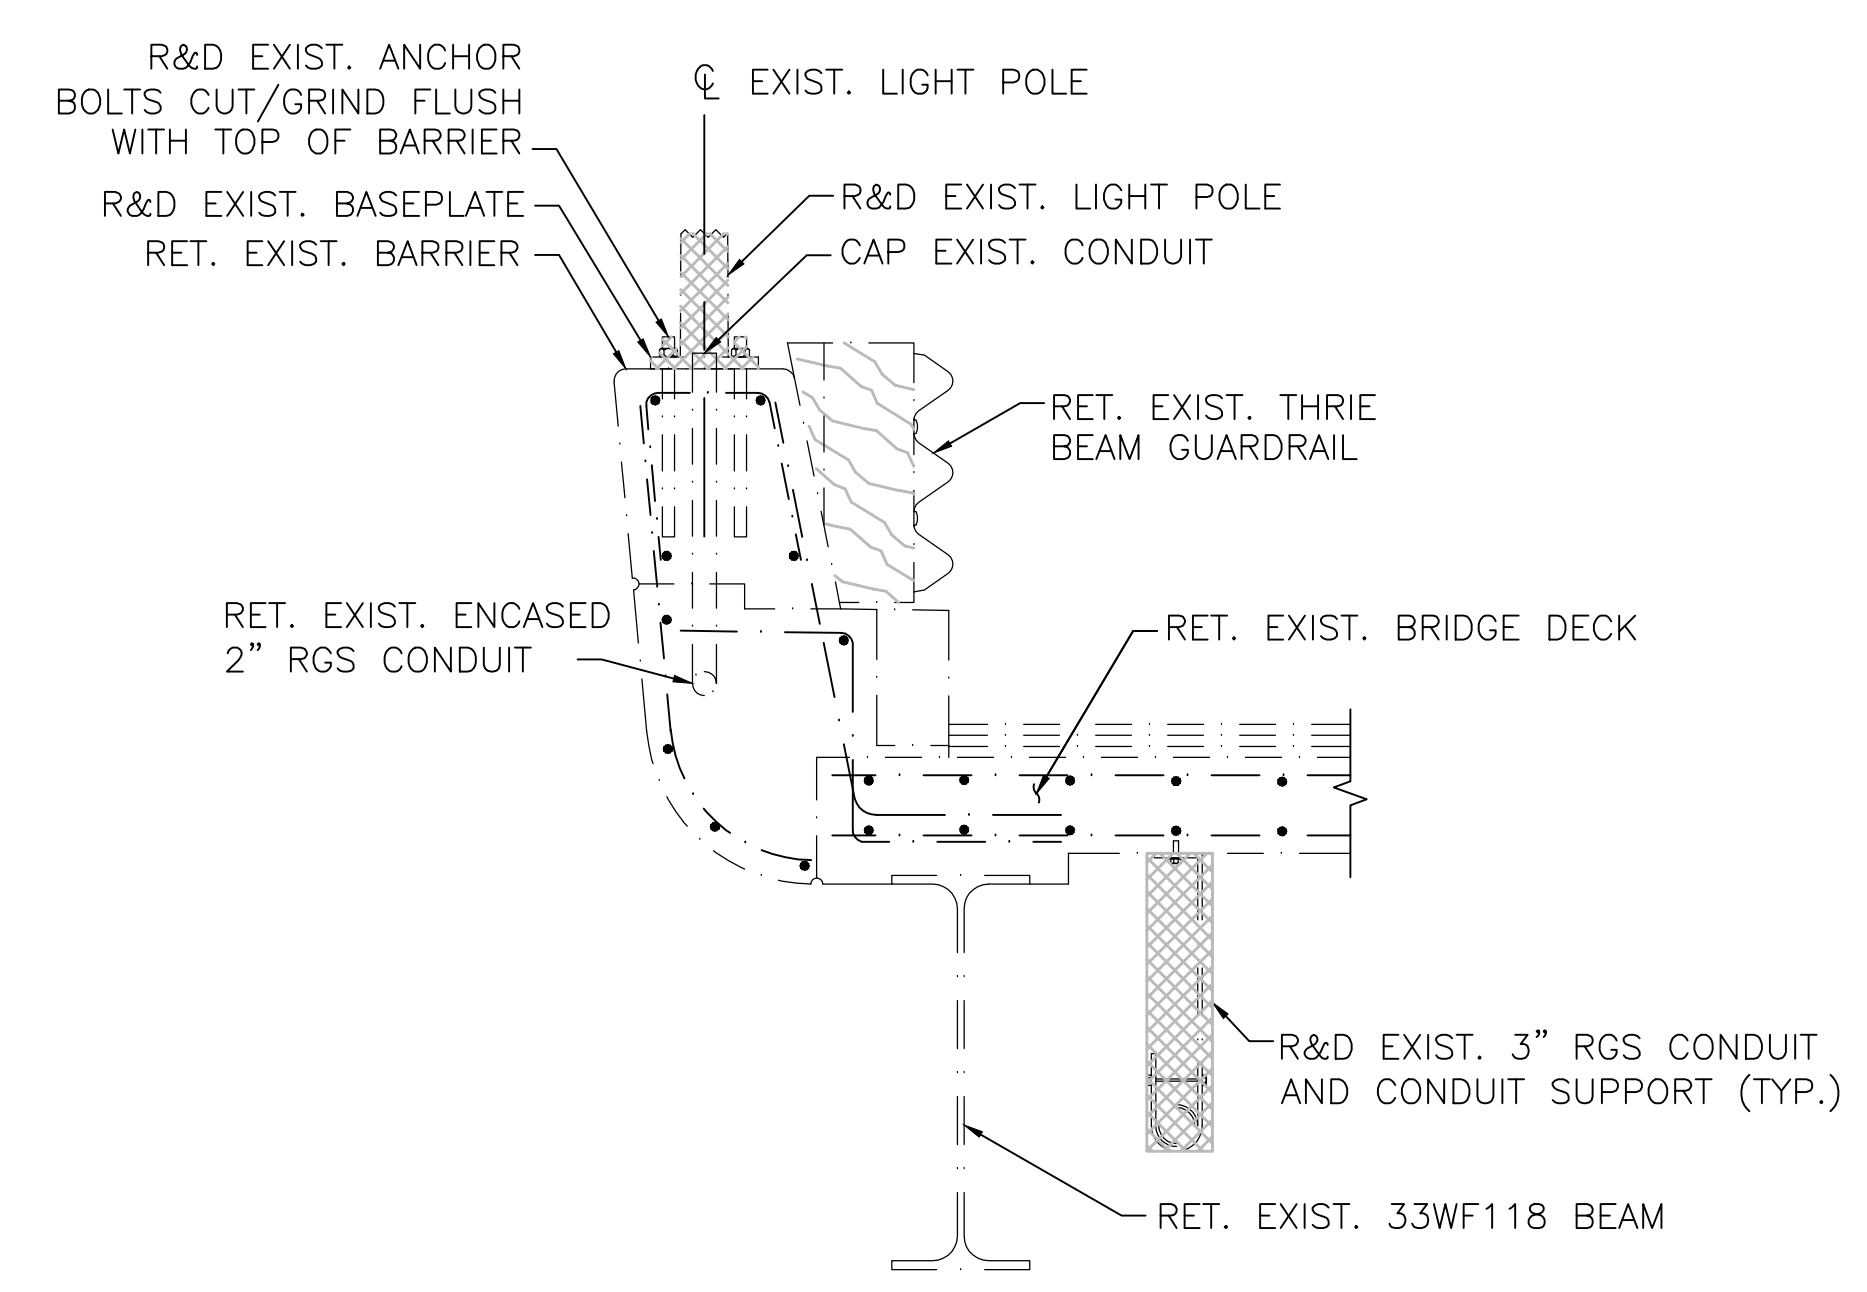

**SECTION AT EXISTING LIGHT POLE BASE**

SCALE: 3/4" = 1'-0"

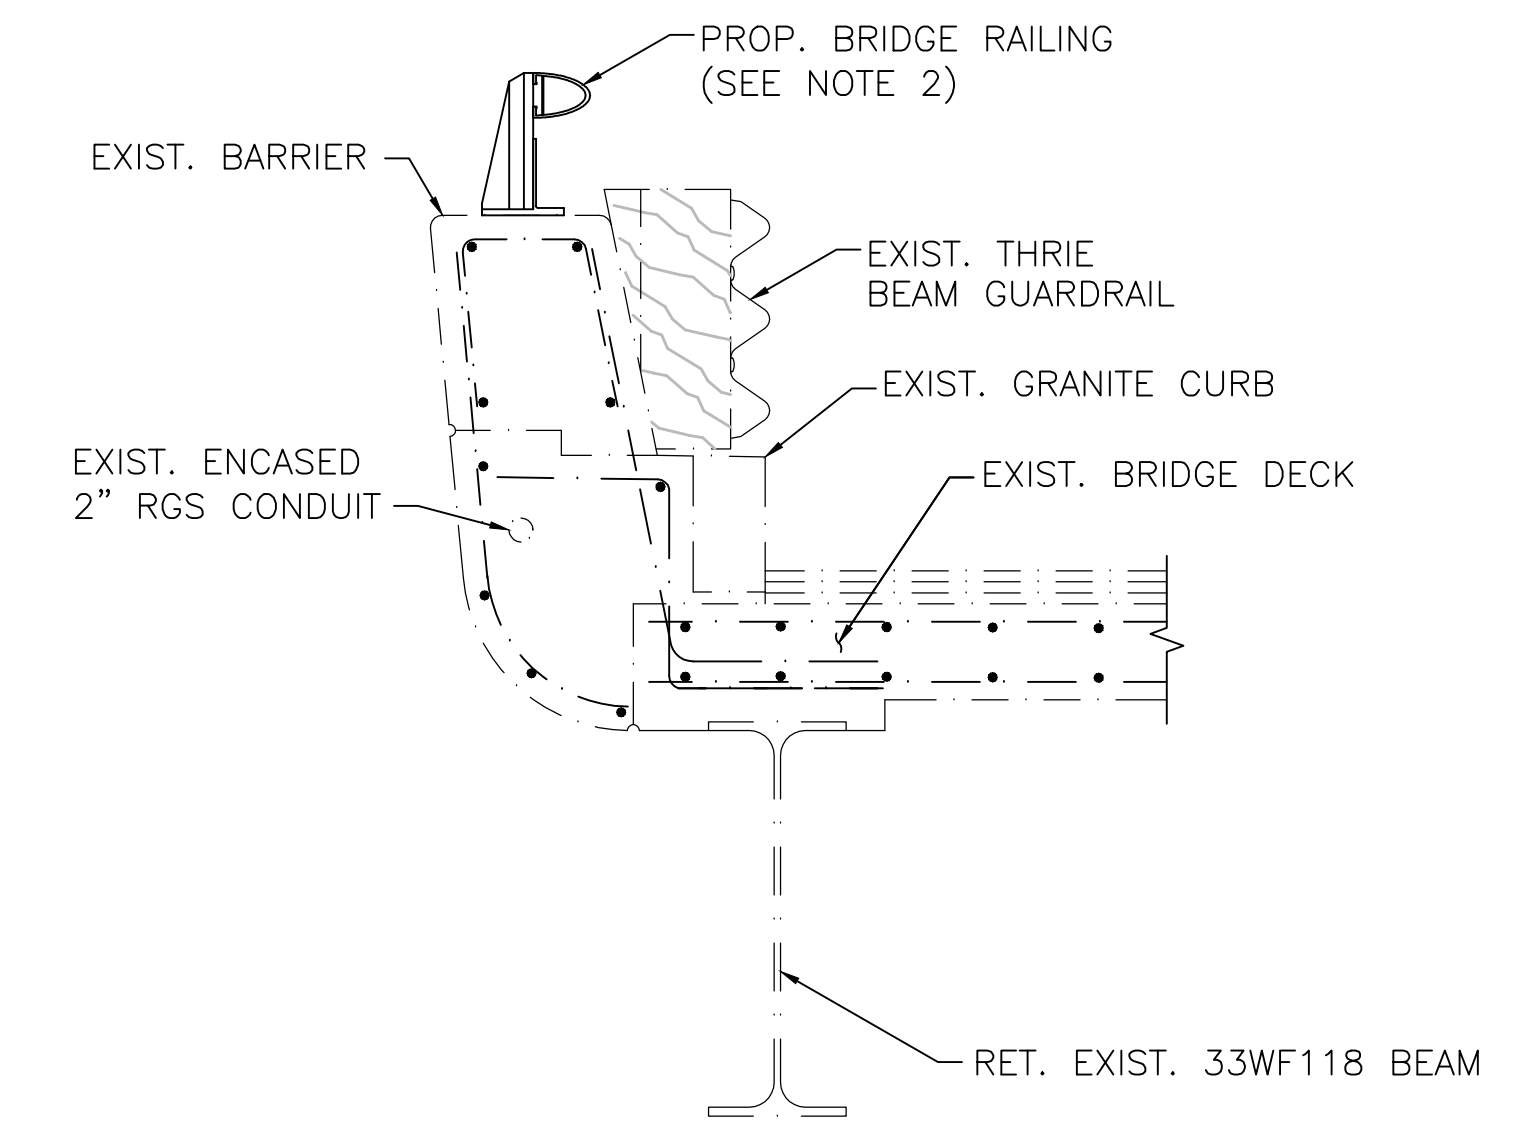

**PROPOSED SECTION**

SCALE: 3/4" = 1'-0"

DEC. 8, 2018	ISSUED FOR CONSTRUCTION
DATE	DESCRIPTION
	USE ONLY PRINTS OF LATEST DATE